




# ALTA CANYADA RD

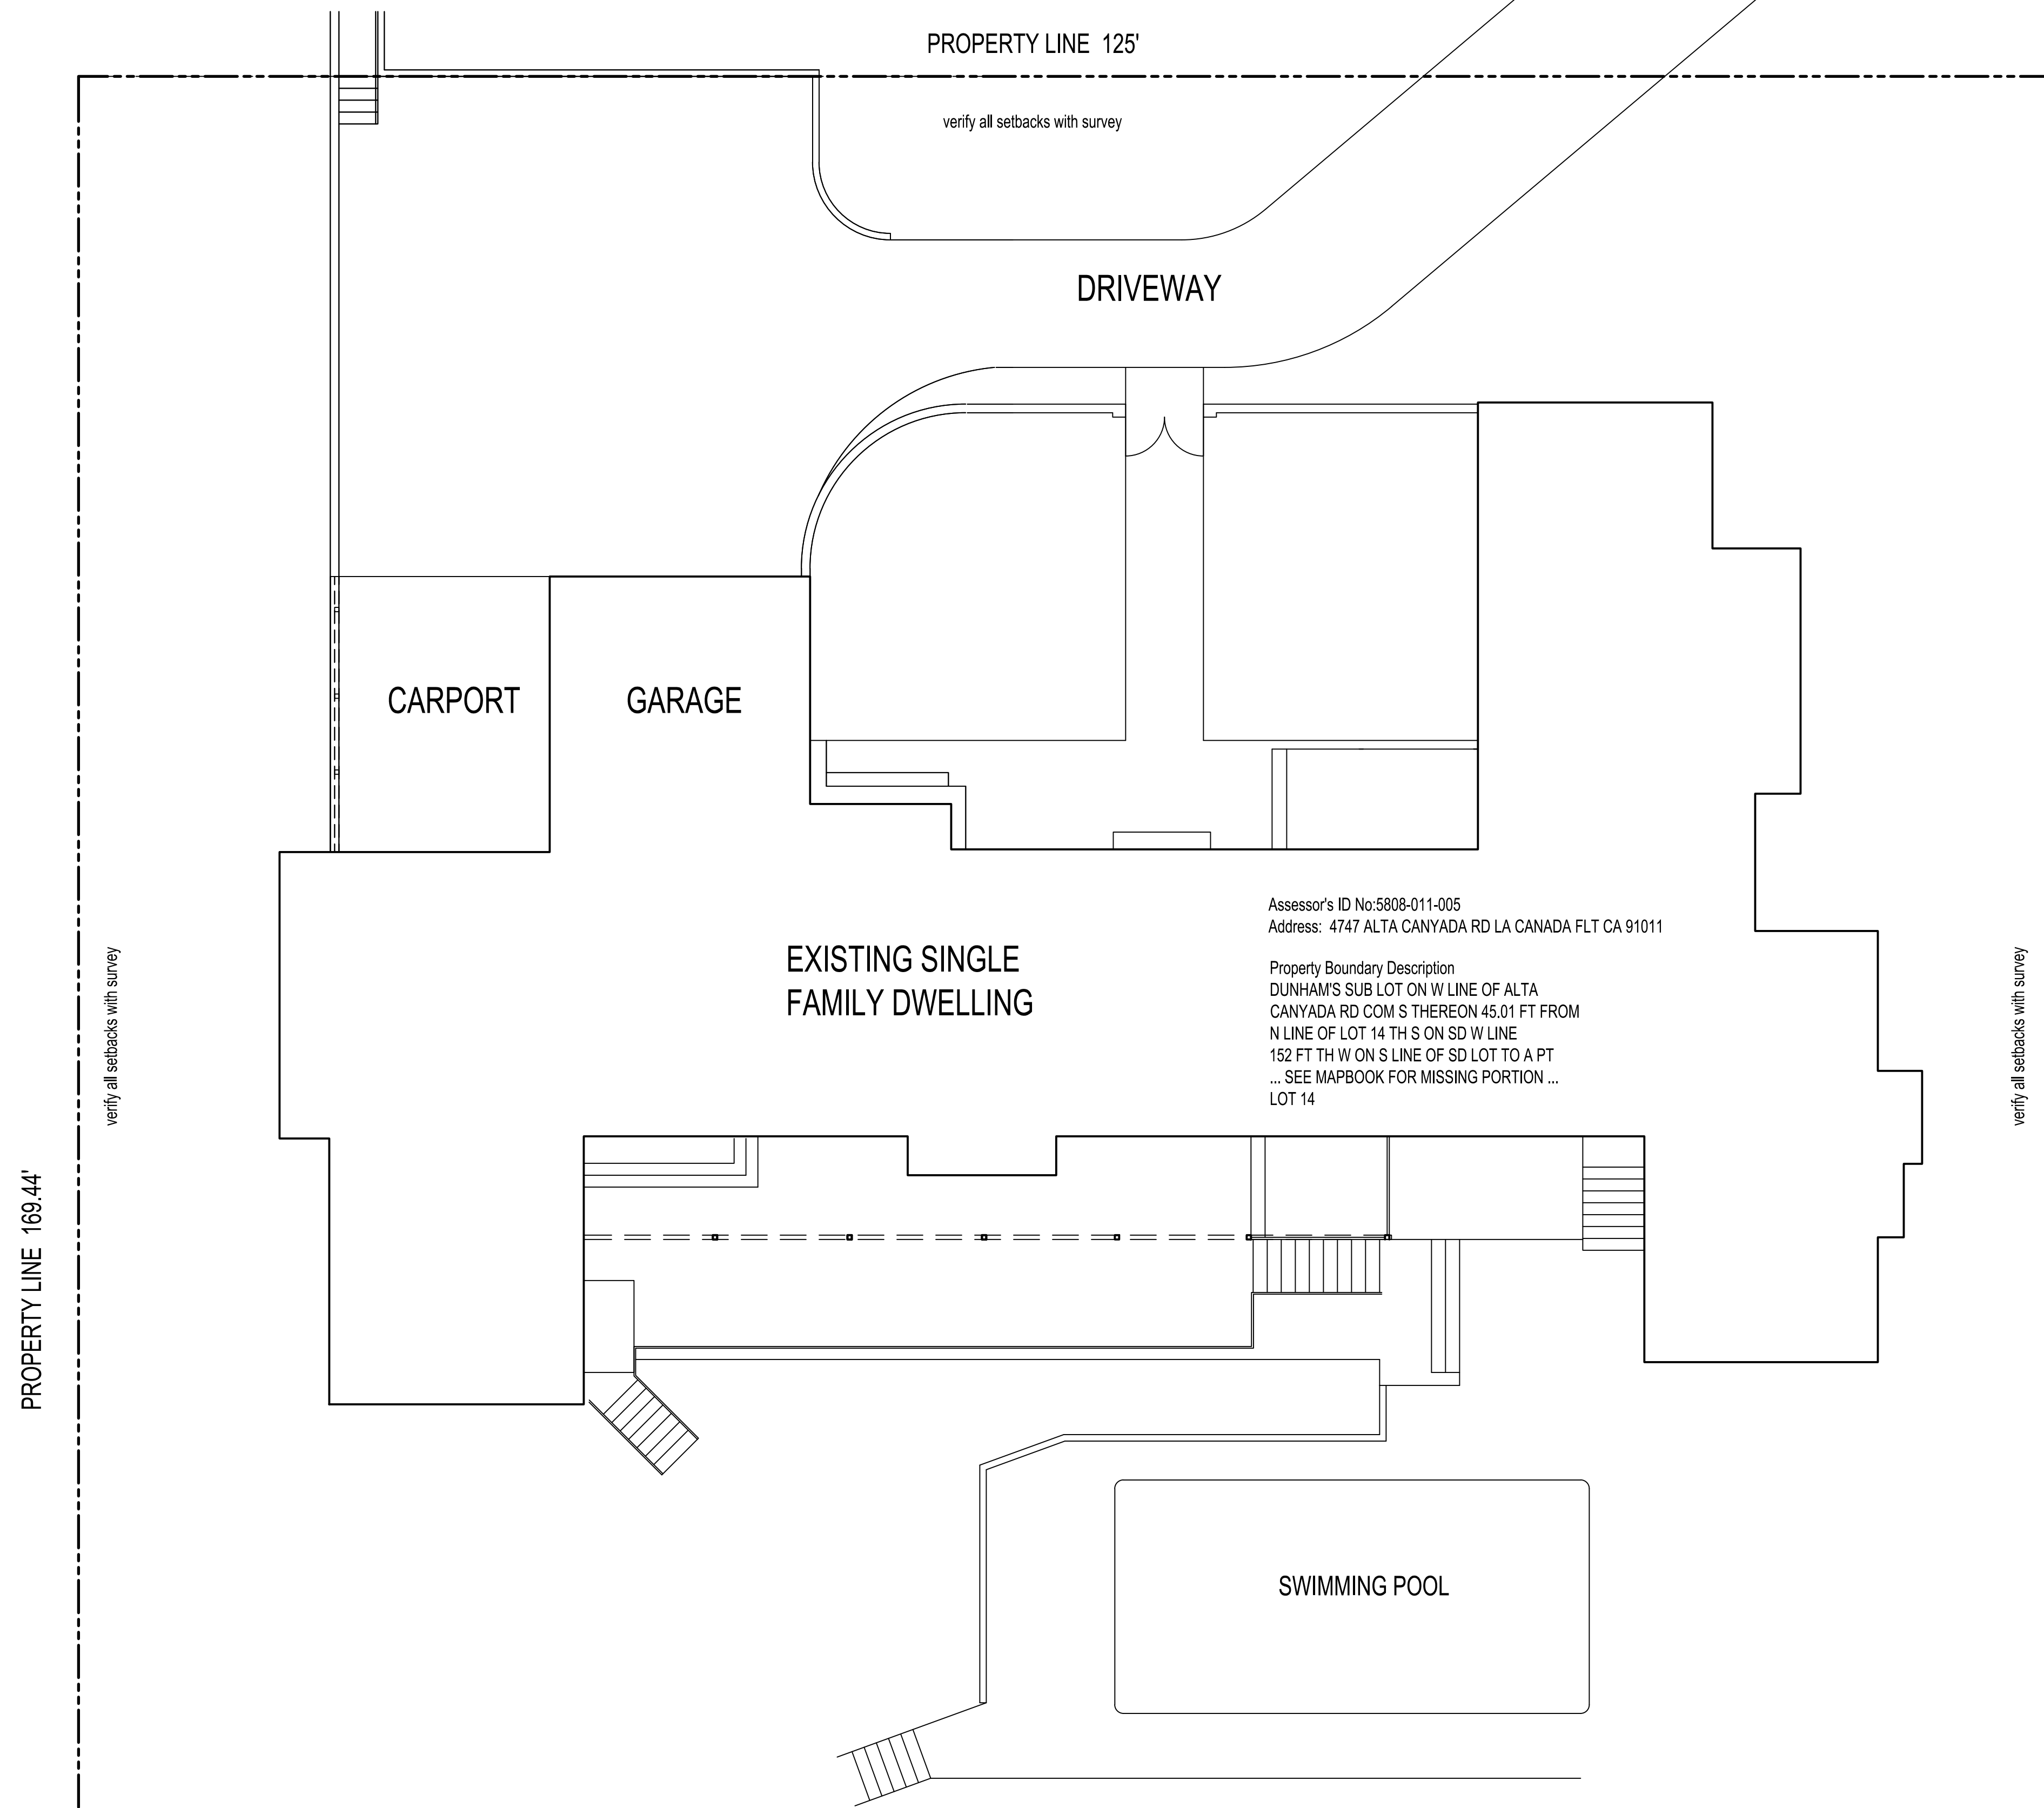

Assessor's ID No:5808-011-005  
Address: 4747 ALTA CANYADA RD LA CANADA FLT CA 91011

Property Boundary Description  
DUNHAM'S SUB LOT ON W LINE OF ALTA  
CANYADA RD COM S THEREON 45.01 FT FROM  
N LINE OF LOT 14 TH S ON SD W LINE  
152 FT TH W ON S LINE OF SD LOT TO A PT  
... SEE MAPBOOK FOR MISSING PORTION ...  
LOT 14

## PLOT PLAN

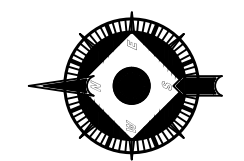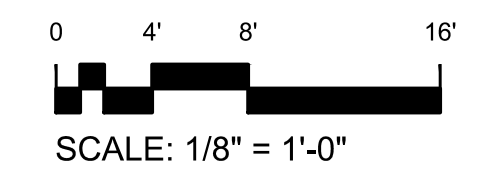

REVISIONS	BY

**AS-BUILT**  
LOS ANGELES

Sheet content : PLOT PLAN

Project : 4747 ALTA CANYADA RD  
LA CANADA FLT CA 91011

Owner:

Date

Scale


Drawn

Job



Sheet

**A-1**

08.28.13

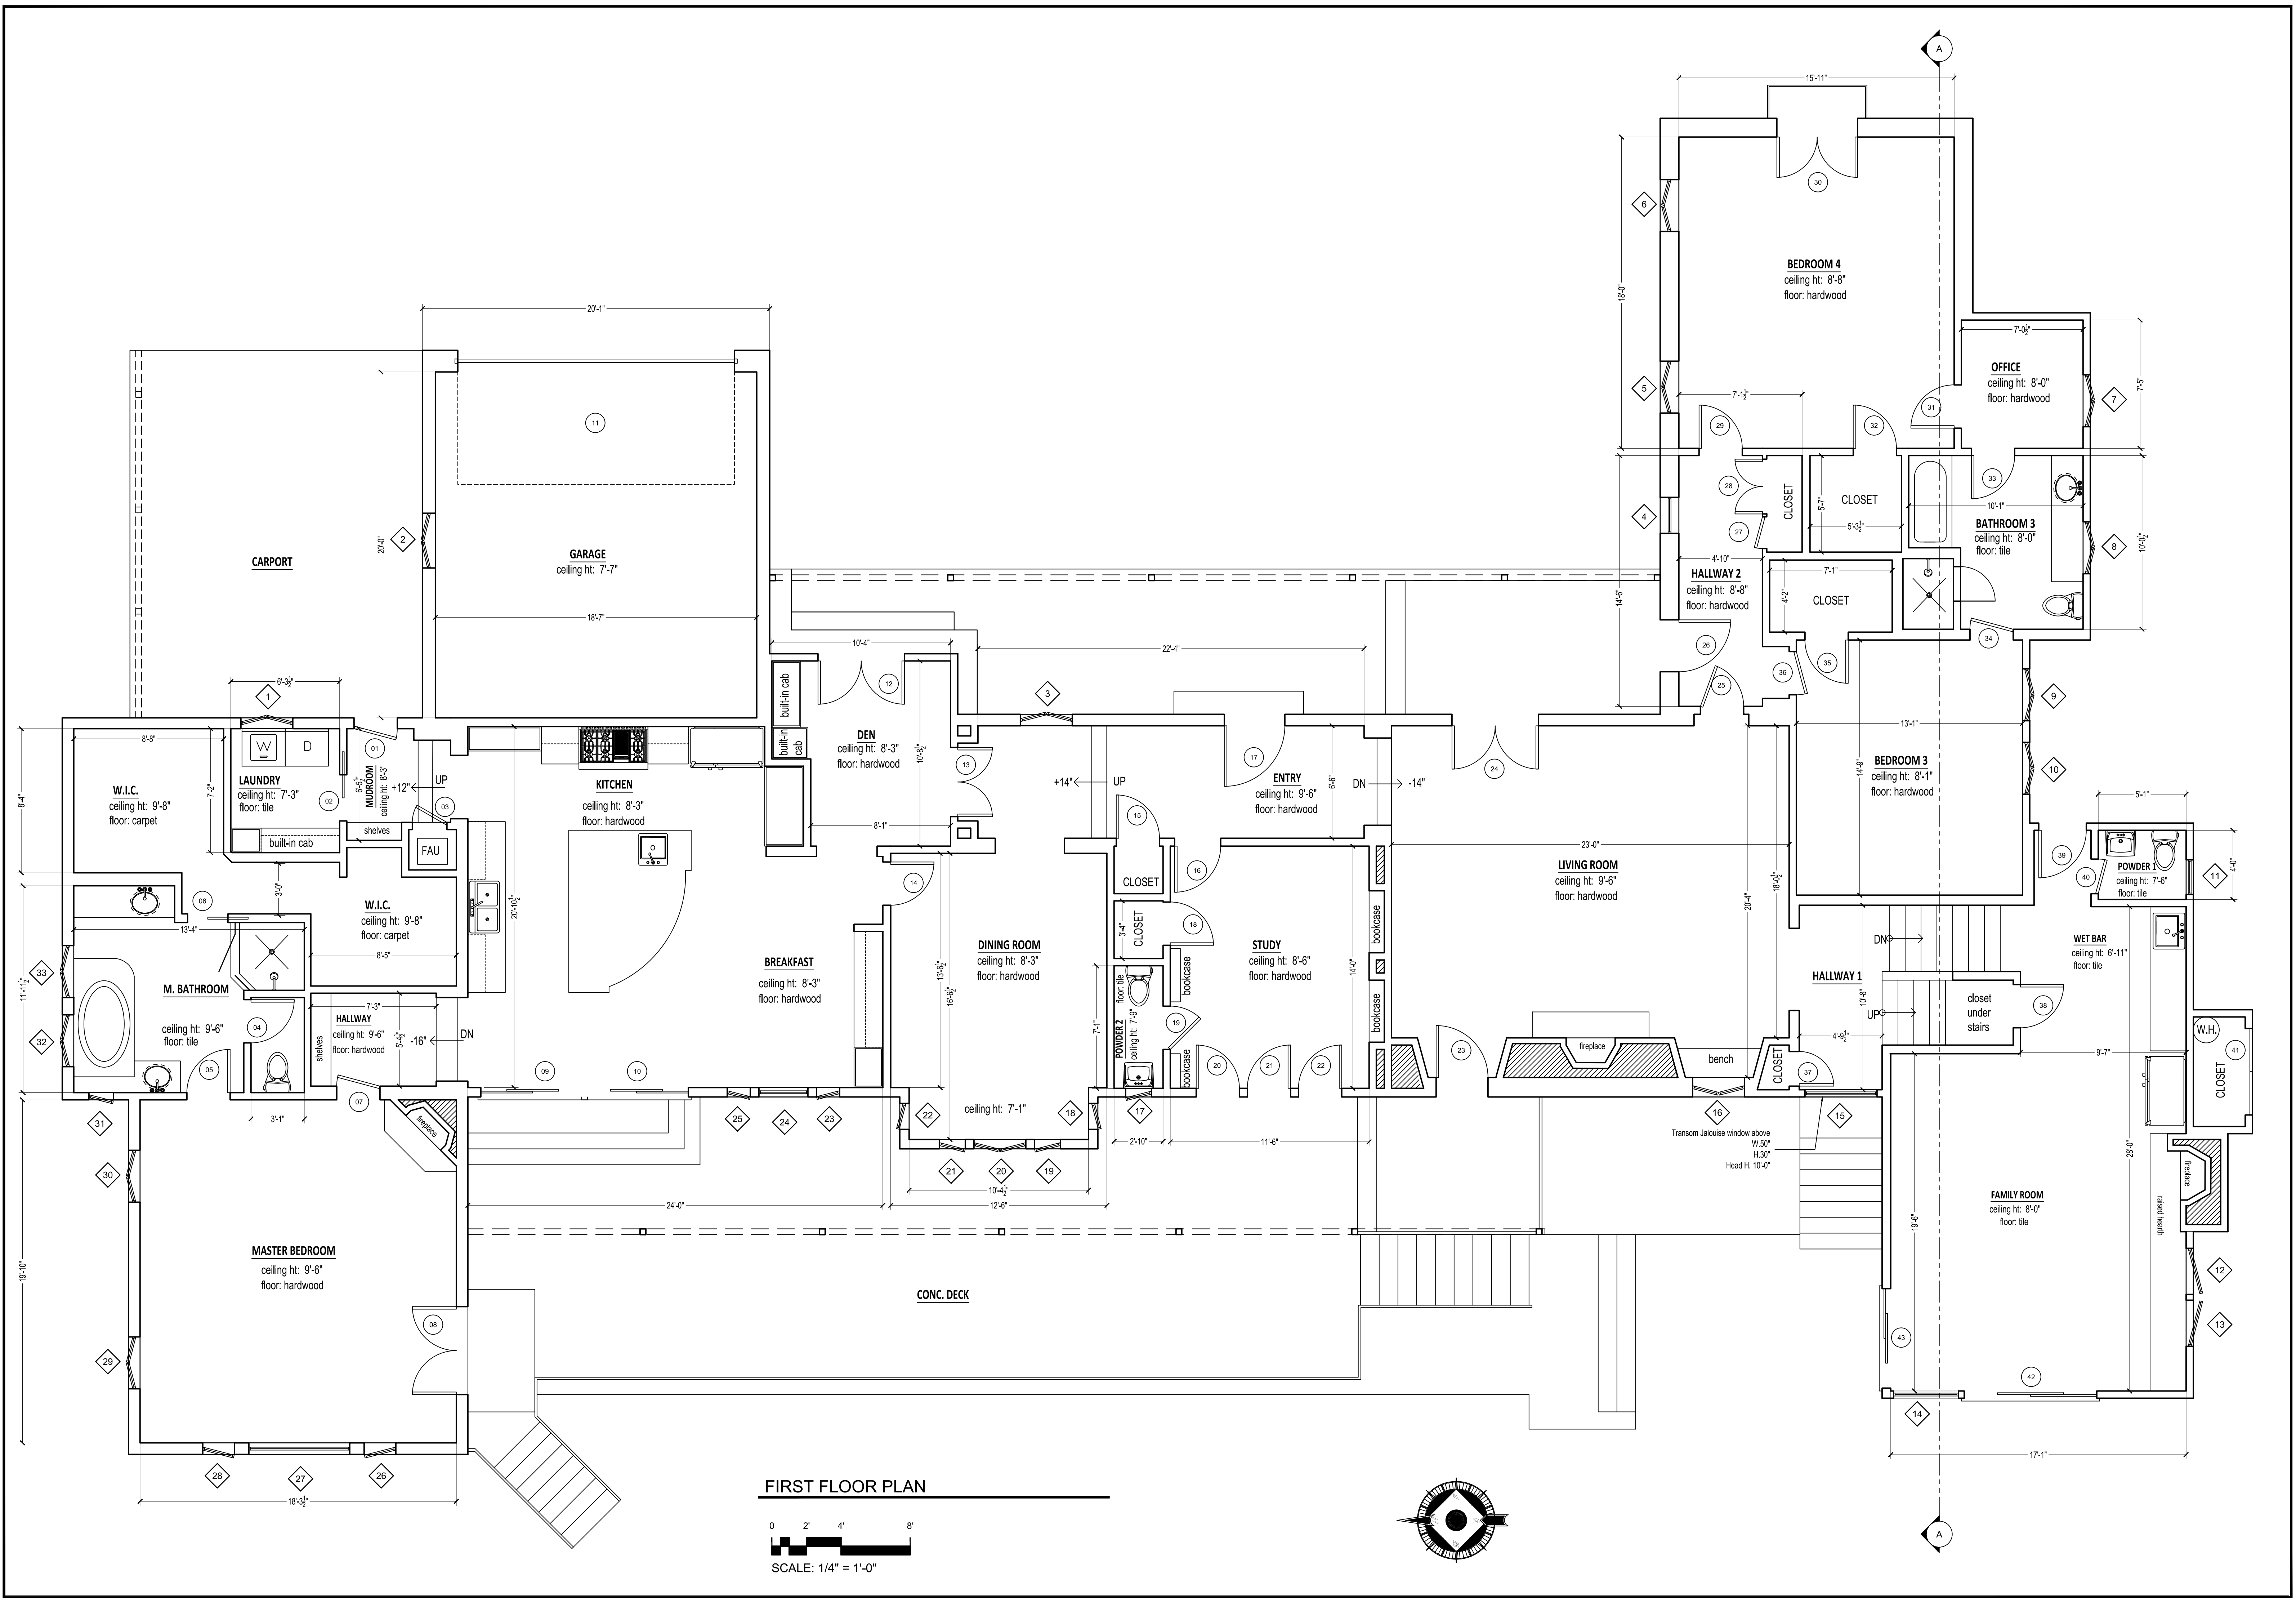


FIRST FLOOR PLAN

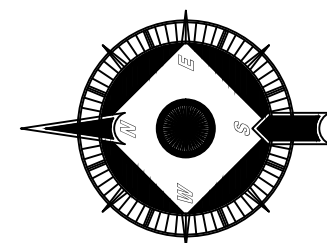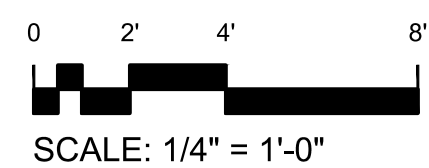



REVISIONS	BY
<b>AS-BUILT</b> LOS ANGELES	
FLOOR PLAN	
Sheet content :	
Project : 4747 ALTA CANYADA RD LA CANADA FLT CA 91011	
Owner :	
Date	
Scale	
Drawn	
Job	
Sheet	
<b>A-2</b>	

DOOR SCHEDULE				
MARK	DOOR SIZE		Type	NOTES
	WD	HGT		
1	2'-6"	6'-8"	SWING	---
2	2'-8"	6'-8"	POCKET	---
3	2'-0"	6'-8"	SWING	---
4	2'-6"	6'-8"	SWING	---
5	2'-6"	6'-8"	SWING	---
6	2'-4"	6'-8"	POCKET	---
7	2'-6"	6'-8"	SWING	---
8	5'-1"	6'-9"	FRENCH DOUBLE	---
9	6'-0"	6'-9"	SLIDING DOUBLE	---
10	6'-0"	6'-9"	SLIDING DOUBLE	---
11	16'-0"	7'-0"	GARAGE DOOR	---
12	5'-0"	6'-6"	FRENCH DOUBLE	---
13	4'-0"	6'-6"	FRENCH DOUBLE	---
14	2'-6"	6'-7"	SWING	---
15	2'-6"	6'-8"	SWING	---
16	2'-8"	6'-8"	SWING	---
17	3'-6"	6'-8"	SWING	---
18	2'-6"	6'-8"	SWING	---
19	2'-6"	6'-8"	SWING	---
20	2'-6"	6'-8"	FRENCH	---
21	2'-6"	6'-8"	FRENCH	---
22	2'-6"	6'-8"	FRENCH	---
23	3'-0"	6'-9"	FRENCH	---
24	5'-0"	6'-8"	FRENCH DOUBLE	---
25	2'-6"	6'-8"	SWING	---
26	3'-0"	6'-9"	SWING	---
27	1'-10"	7'-0"	SWING	---
28	3'-2"	7'-0"	SWING DOUBLE	---
29	2'-6"	6'-8"	SWING	---
30	4'-8"	6'-8"	FRENCH DOUBLE	---
31	2'-6"	6'-8"	SWING	---
32	2'-6"	6'-8"	SWING	---
33	2'-6"	6'-8"	SWING	---
34	2'-6"	6'-8"	SWING	---
35	2'-6"	6'-8"	SWING	---
36	2'-6"	6'-8"	SWING	---
37	2'-0"	6'-8"	SWING	---
38	2'-6"	6'-8"	SWING	---
39	2'-9"	6'-9"	SWING	---
40	2'-0"	6'-8"	SWING	---
41	5'-0"	6'-8"	SWING DOUBLE	---
42	7'-8"	6'-5"	SLIDING DOUBLE	---
43	5'-9"	6'-5"	SLIDING DOUBLE	---
44	2'-4"	6'-8"	POCKET	---
45	2'-0"	6'-9"	POCKET	---
46	5'-0"	6'-8"	SLIDING - DOUBLE	---
47	2'-8"	6'-8"	SWING	---
48	5'-0"	6'-8"	SLIDING - DOUBLE	---
49	4'-0"	6'-9"	SWING DOUBLE	---
50	2'-8"	6'-8"	SWING	---
51	3'-0"	6'-8"	SWING	---


WINDOW SCHEDULE					
MARK	SIZE		TYPE	Head Height	NOTES
	Width	HEIGHT			
1	3'-0"	3'-2"	DOUBLE CASEMENT	6'-6"	
2	3'-2"	3'-3"	DOUBLE CASEMENT	7'-1"	
3	3'-0"	3'-2"	DOUBLE CASEMENT	6'-8"	
4	2'-1"	2'-1"	FIXED	6'-4"	
5	3'-0"	3'-2"	DOUBLE CASEMENT	6'-9"	
6	3'-0"	3'-2"	DOUBLE CASEMENT	6'-9"	
7	3'-0"	3'-2"	DOUBLE CASEMENT	6'-8"	
8	3'-0"	3'-2"	DOUBLE CASEMENT	6'-8"	
9	3'-0"	4'-2"	DOUBLE CASEMENT	6'-8"	
10	3'-0"	4'-2"	DOUBLE CASEMENT	6'-8"	
11	2'-0"	3'-0"	FIXED	6'-8"	
12	2'-8"	2'-8"	CASEMENT	6'-9"	
13	2'-8"	2'-8"	CASEMENT	6'-9"	
14	3'-9"	6'-5"	FIXED	6'-5"	
15	4'-2"	5'-8"	FIXED	6'-8"	
16	3'-0"	4'-2"	DOUBLE CASEMENT	6'-9"	
17	1'-6"	3'-2"	CASEMENT	6'-8"	
18	1'-6"	4'-2"	CASEMENT	6'-6"	
19	1'-6"	4'-2"	CASEMENT	6'-6"	
20	3'-0"	4'-2"	DOUBLE CASEMENT	6'-6"	
21	1'-6"	4'-2"	CASEMENT	6'-6"	
22	1'-6"	4'-2"	CASEMENT	6'-6"	
23	1'-4"	3'-10"	CASEMENT	6'-10"	
24	2'-10"	3'-10"	FIXED	6'-10"	
25	1'-4"	3'-10"	CASEMENT	6'-10"	
26	1'-10"	6'-4"	CASEMENT	6'-10"	
27	5'-10"	6'-4"	FIXED	6'-10"	
28	1'-10"	6'-4"	CASEMENT	6'-10"	
29	3'-0"	3'-2"	DOUBLE CASEMENT	6'-6"	
30	3'-0"	3'-2"	DOUBLE CASEMENT	6'-6"	
31	1'-5"	3'-2"	CASEMENT	6'-11"	
32	3'-0"	3'-2"	DOUBLE CASEMENT	6'-11"	
33	3'-0"	3'-2"	DOUBLE CASEMENT	6'-11"	
34	2'-2"	10"	FIXED	7'-8"	
35	2'-2"	1'-2"	FIXED	7'-8"	
36	2'-2"	1'-8"	FIXED	7'-8"	
37	2'-2"	2'-4"	FIXED	7'-8"	
38	2'-0"	3'-0"	LOUVERED	6'-9"	
39	2'-8"	2'-8"	CASEMENT	6'-6"	
40	2'-8"	2'-8"	CASEMENT	6'-6"	
41	2'-8"	2'-8"	CASEMENT	6'-6"	
42	2'-8"	2'-8"	FIXED	6'-6"	
43	2'-8"	2'-8"	FIXED	6'-6"	
44	2'-8"	2'-8"	CASEMENT	6'-6"	
45	2'-8"	2'-8"	CASEMENT	6'-6"	
46	2'-8"	2'-8"	CASEMENT	6'-6"	
47	3'-0"	3'-2"	DOUBLE CASEMENT	6'-11"	
48	3'-0"	4'-3"	DOUBLE CASEMENT	6'-8"	

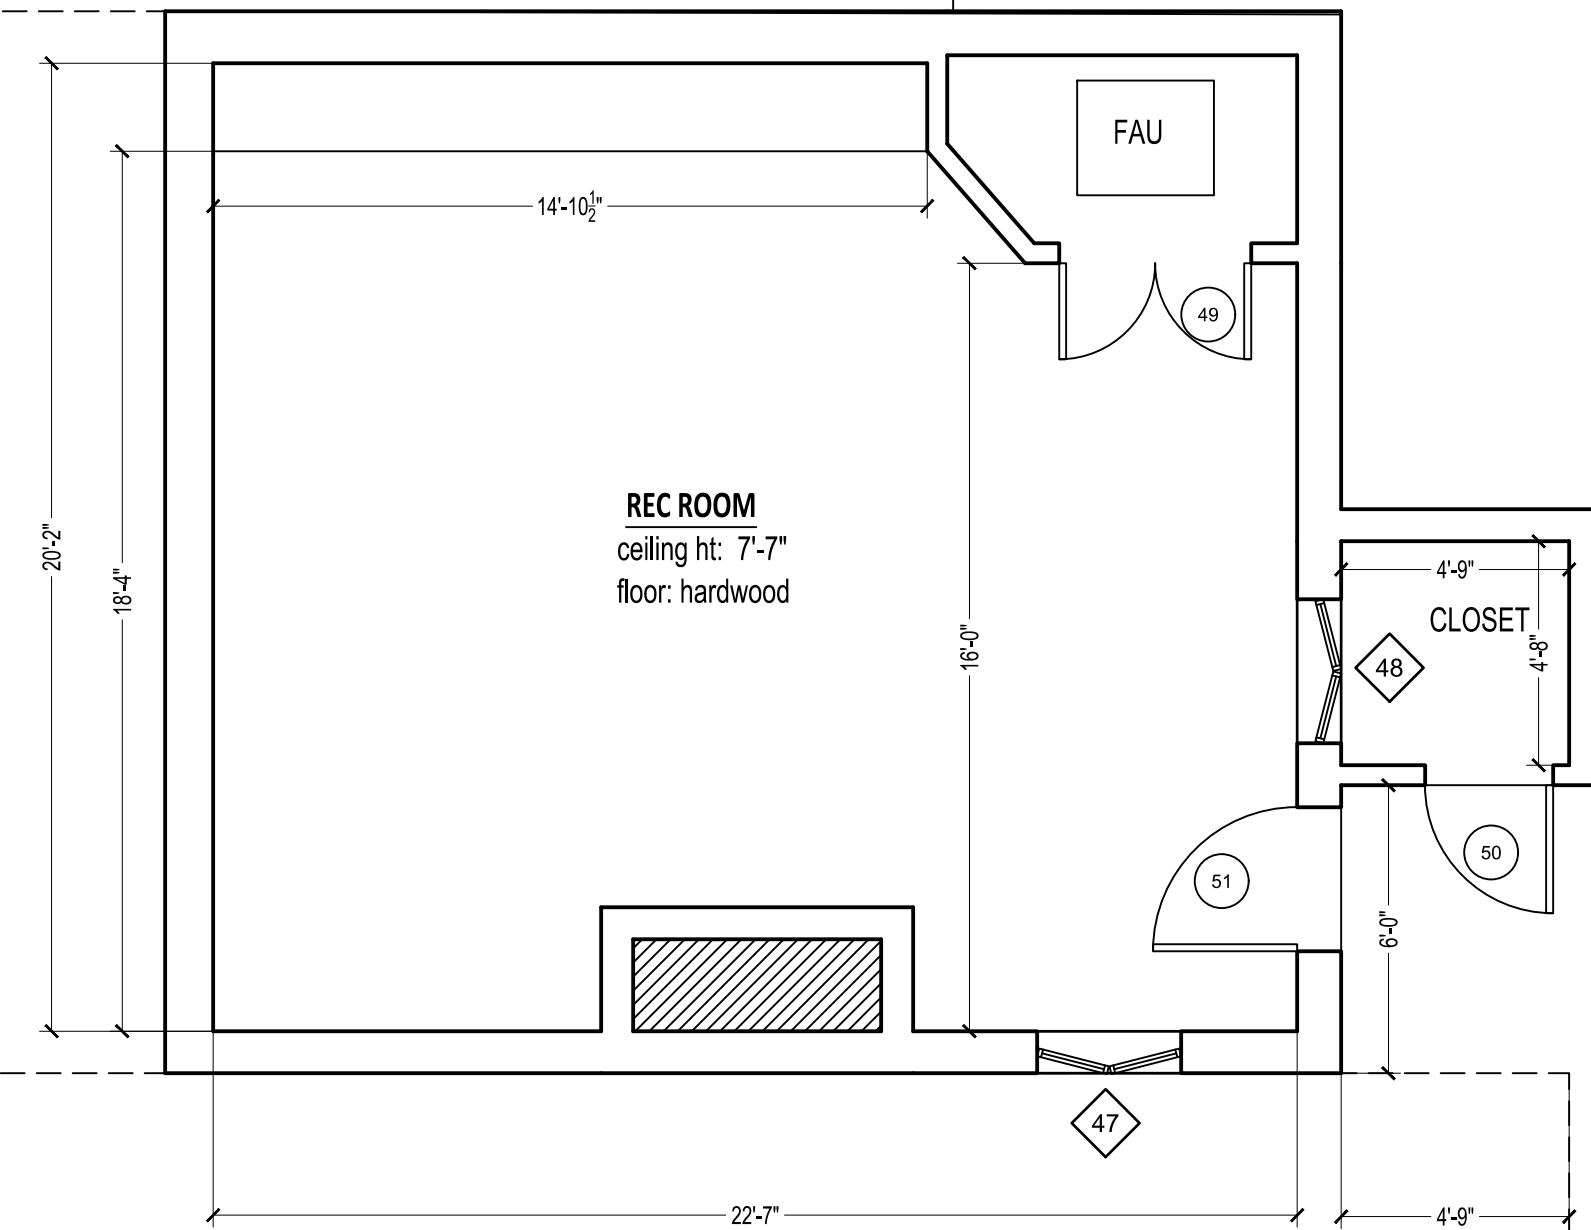

BASEMENT FLOOR PLAN

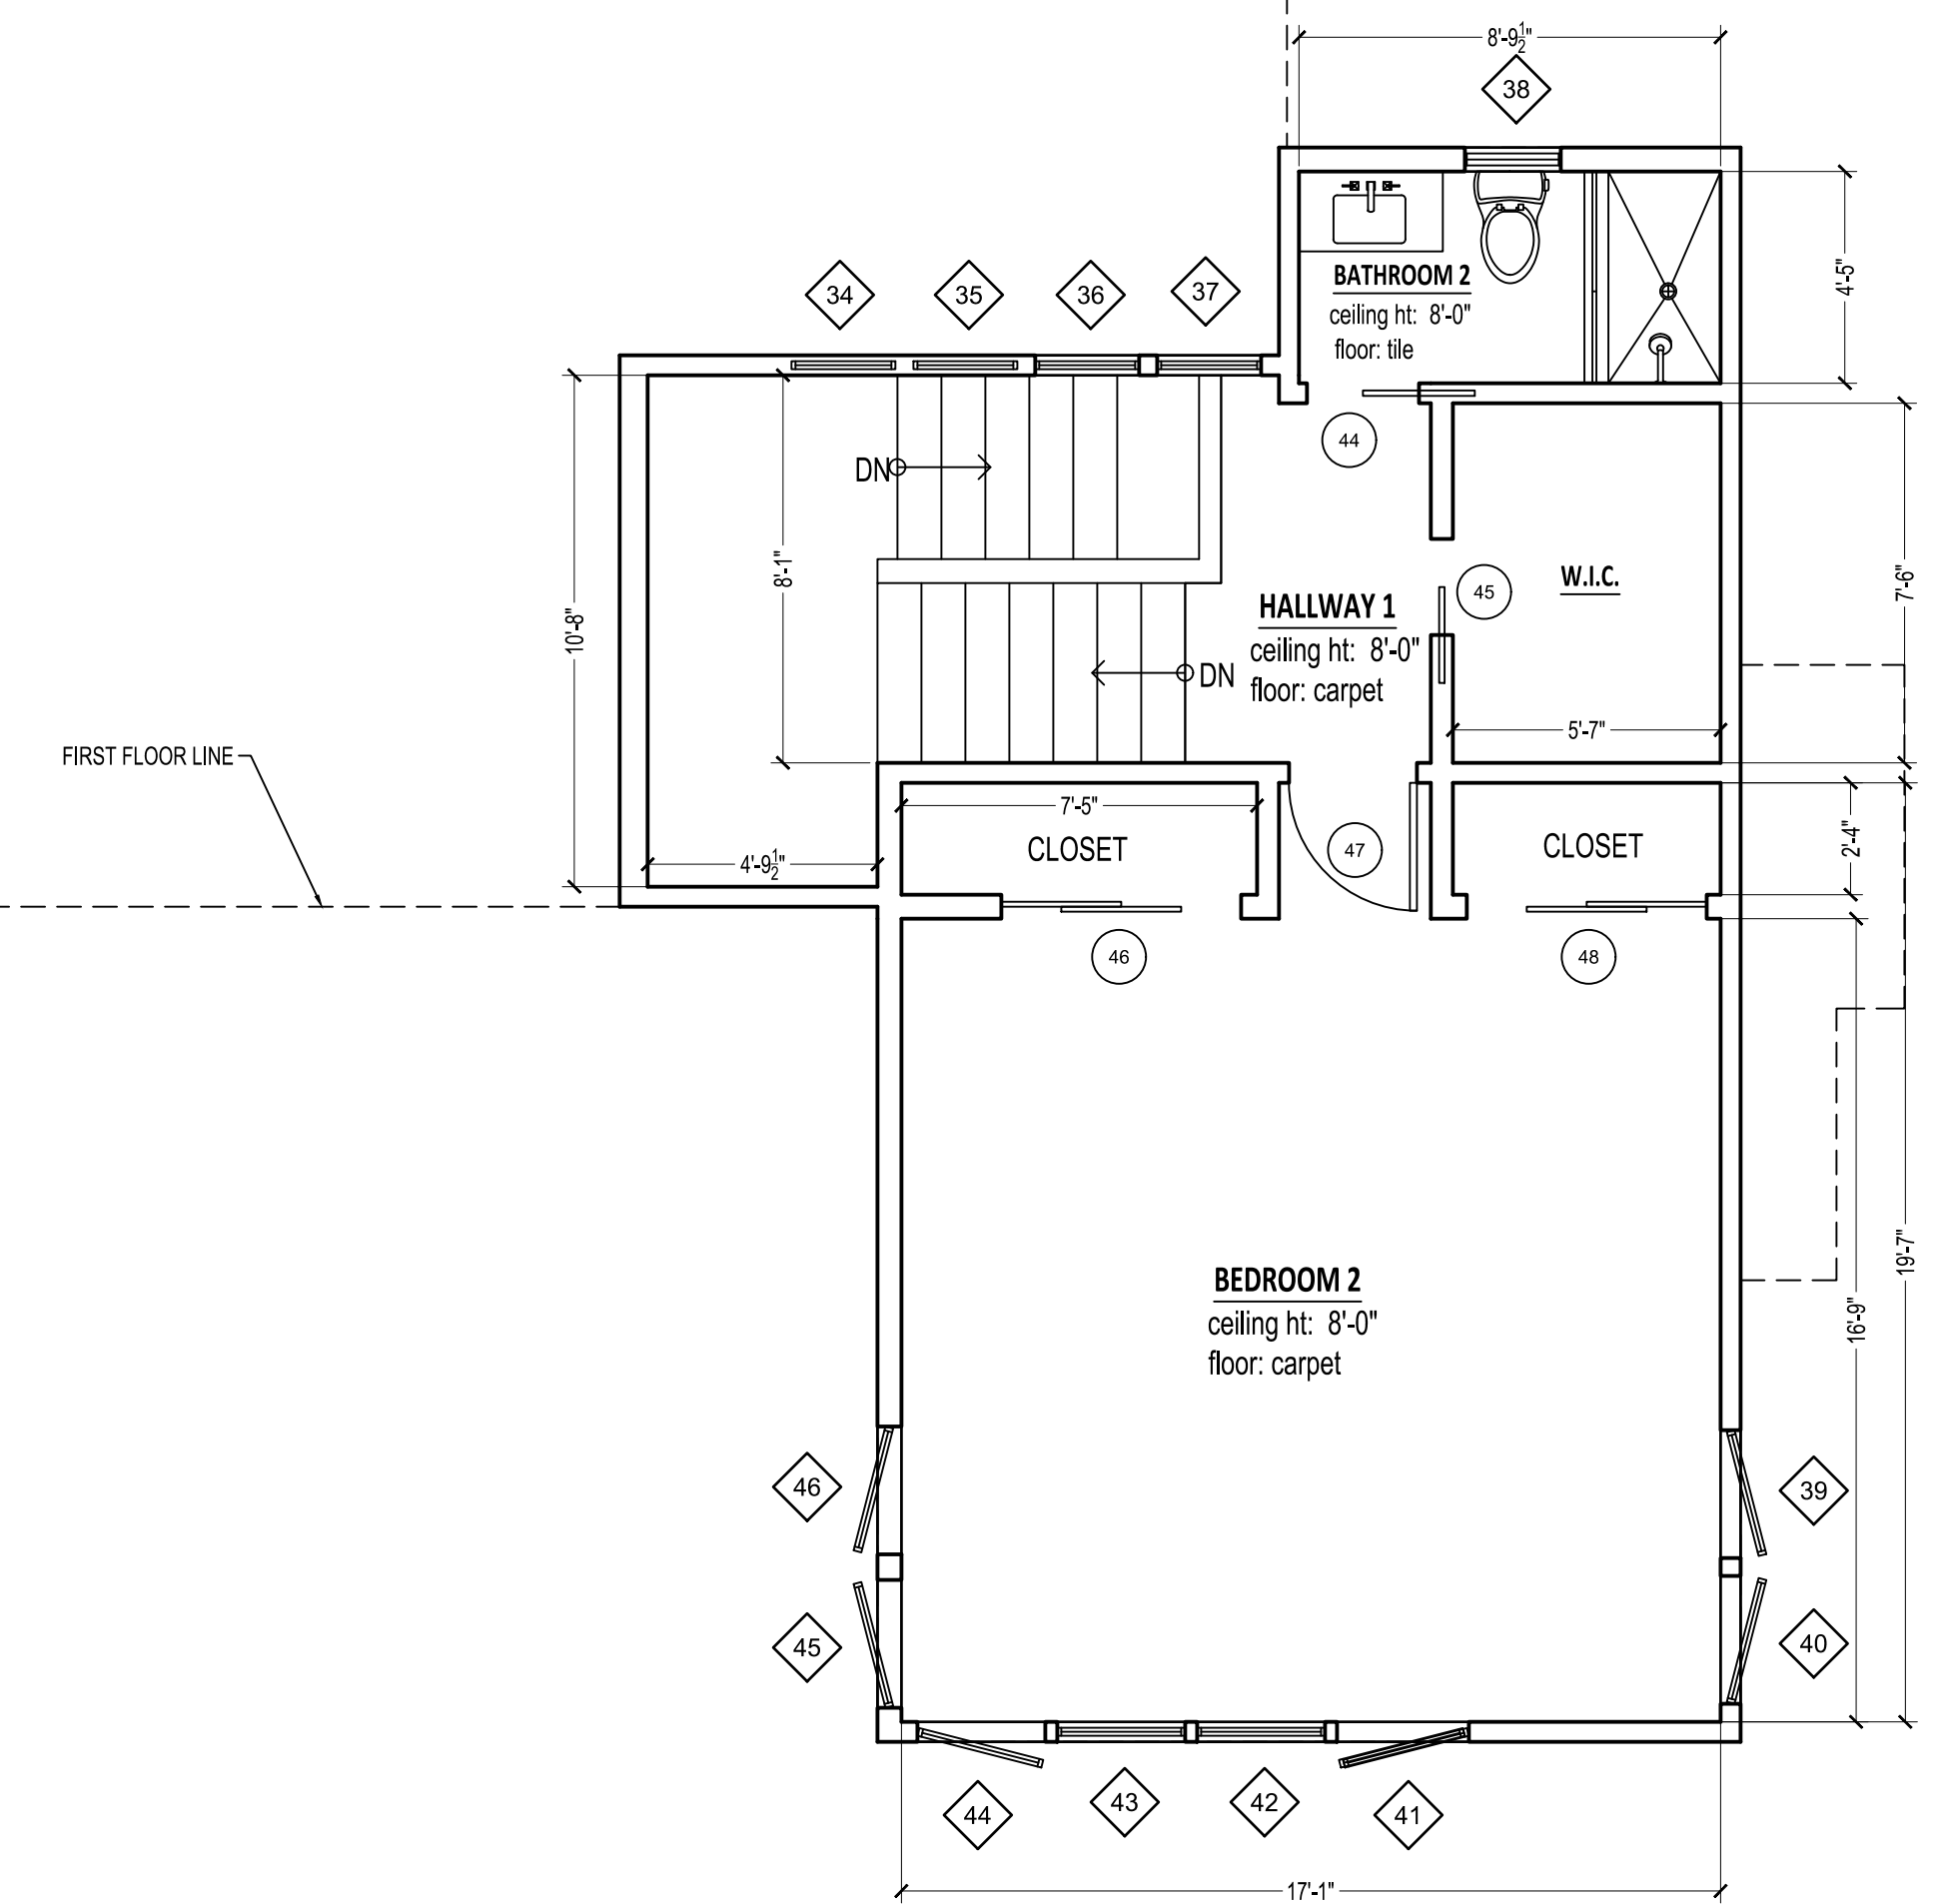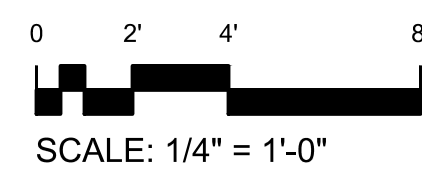

SECOND FLOOR PLAN

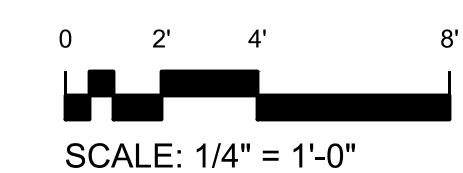

REVISIONS	BY

**AS-BUILT**  
LOS ANGELES

FLOOR PLANS

Sheet content :


Project : 4747 ALTA CANYADA RD  
LA CANADA FLT CA 91011

Owner :

Date  
Scale  
Drawn  
Job  
Sheet


**A-3**

08.08.13

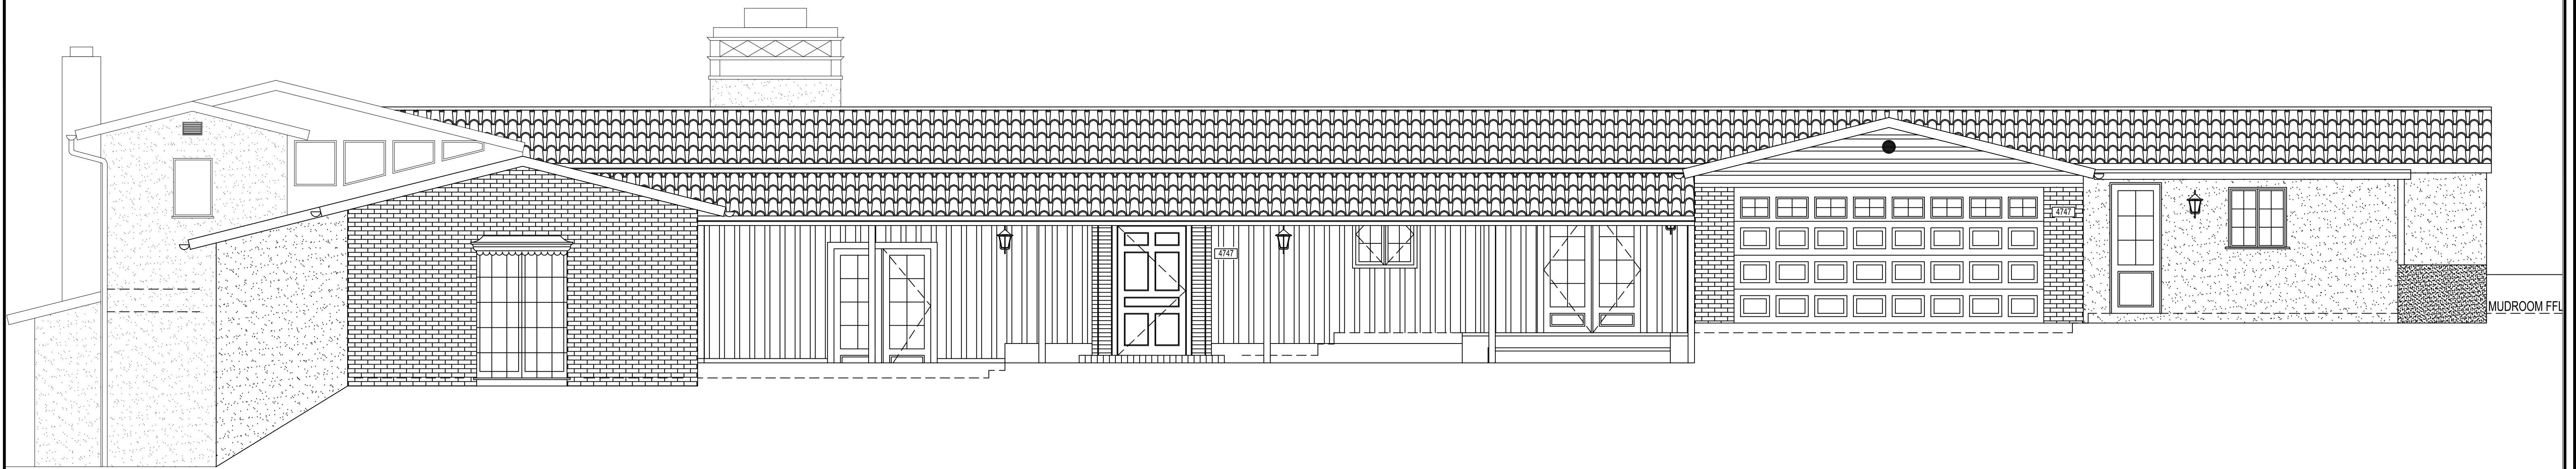

1 E. ELEVATION

SCALE: 1/4" = 1'-0"

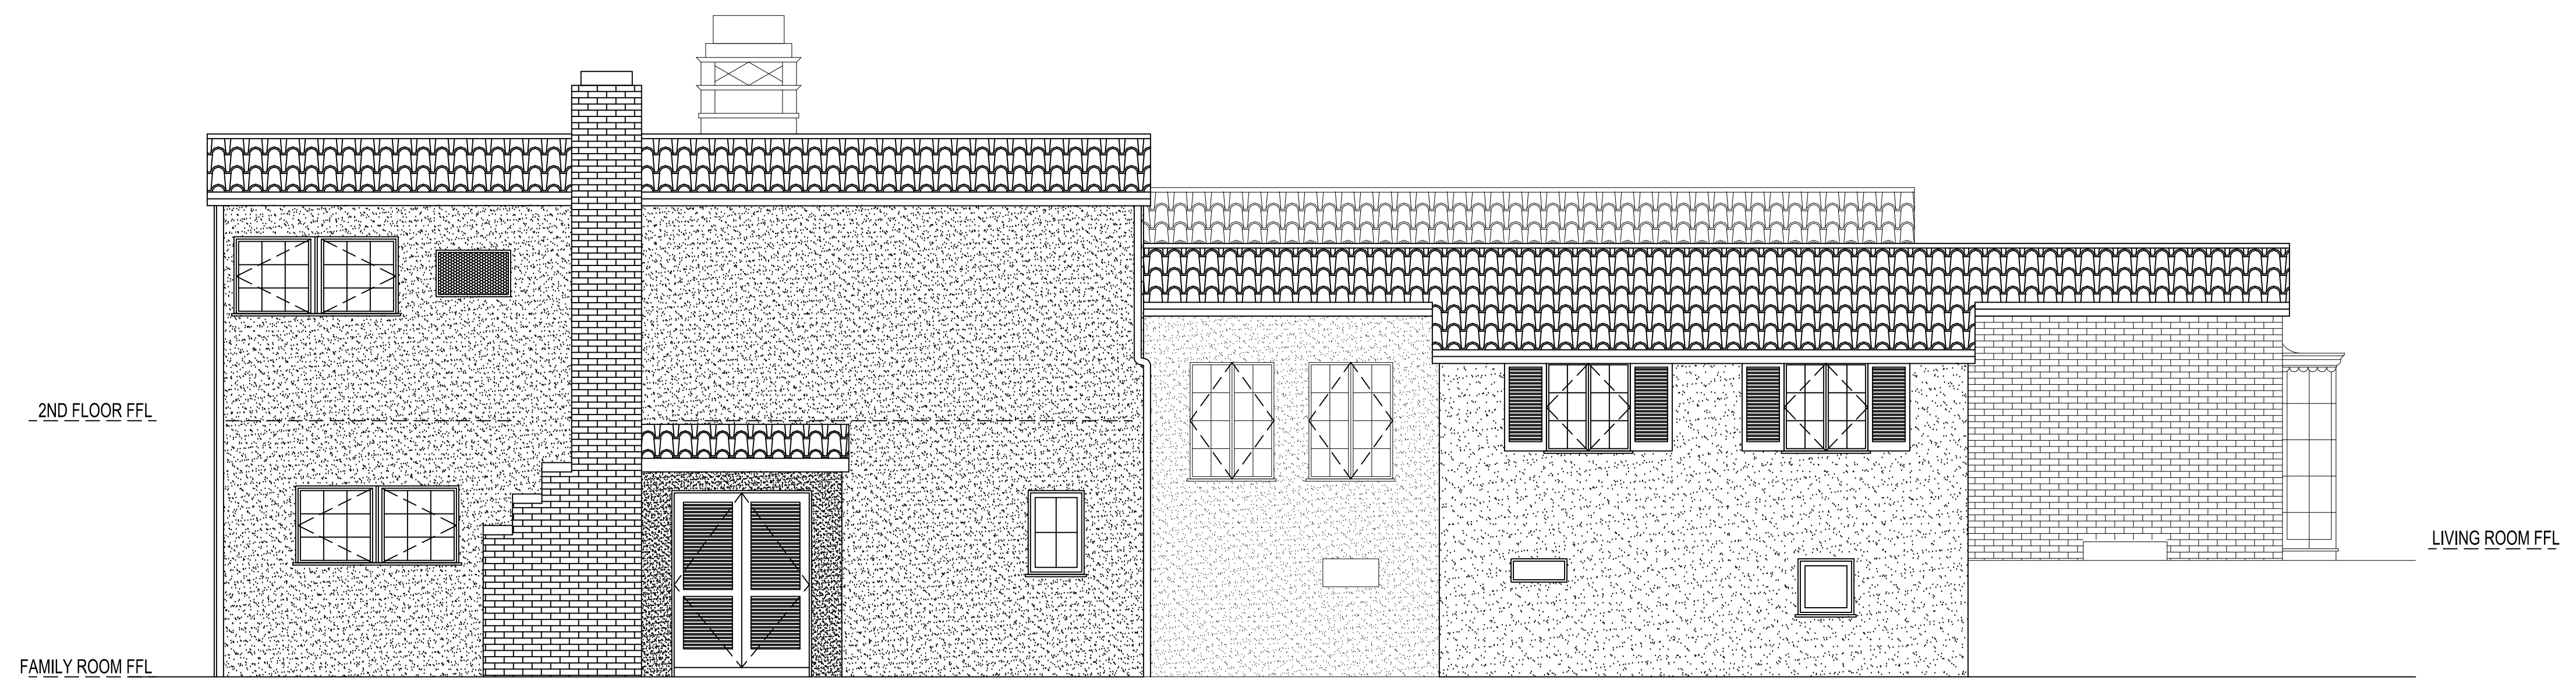

2ND FLOOR FFL

FAMILY ROOM FFL

LIVING ROOM FFL

2 S. ELEVATION

SCALE: 1/4" = 1'-0"

REVISIONS	BY


**AS-BUILT**  
LOS ANGELES

Sheet content :  
ELEVATIONS


Project :  
4747 ALTA CANYADA RD  
LA CANADA FLT CA 91011

Owner:  
Date  
Scale  
Drawn  
Job  
Sheet


A-4

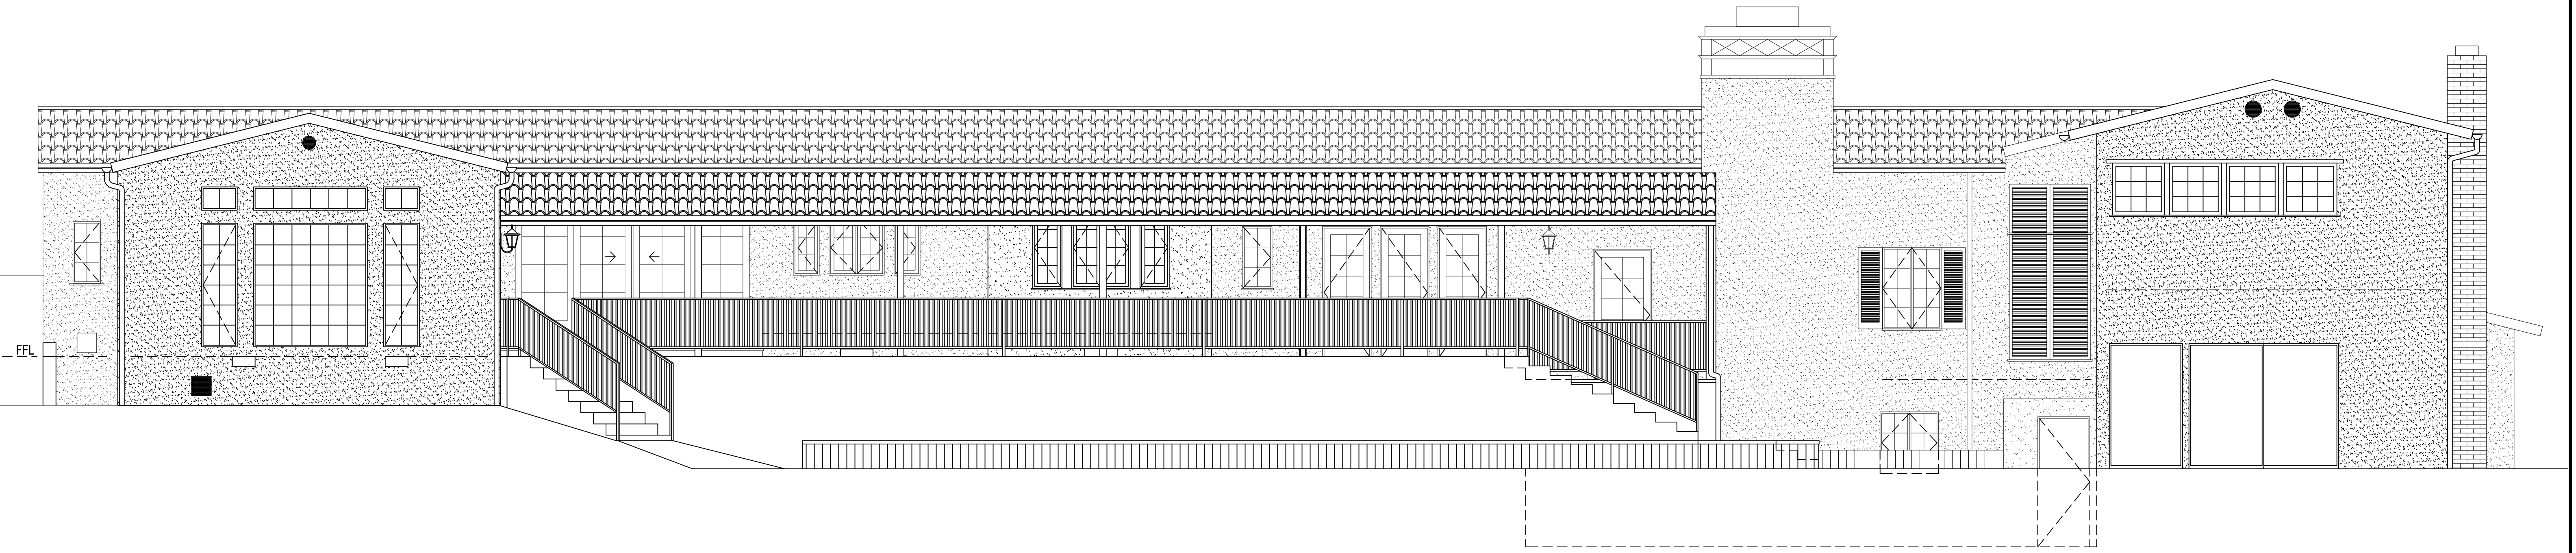


3 W. ELEVATION  
 0 2' 4' 8'  
 SCALE: 1/4" = 1'-0"

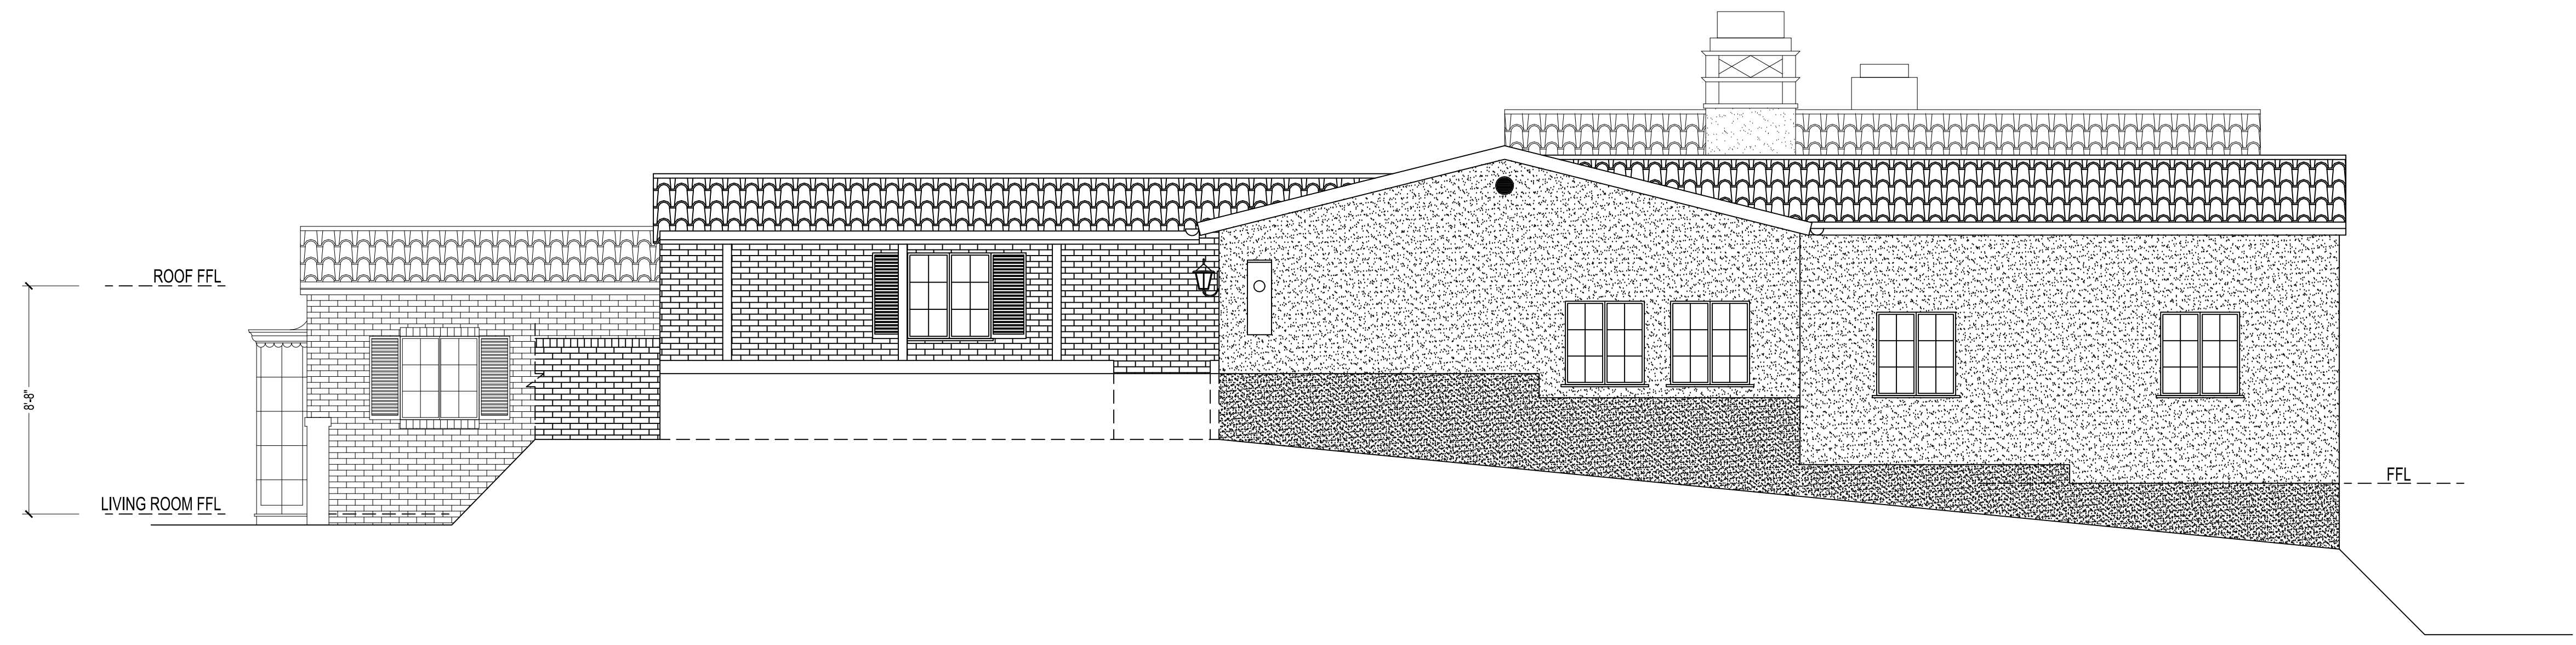

4 N. ELEVATION  
 0 2' 4' 8'  
 SCALE: 1/4" = 1'-0"

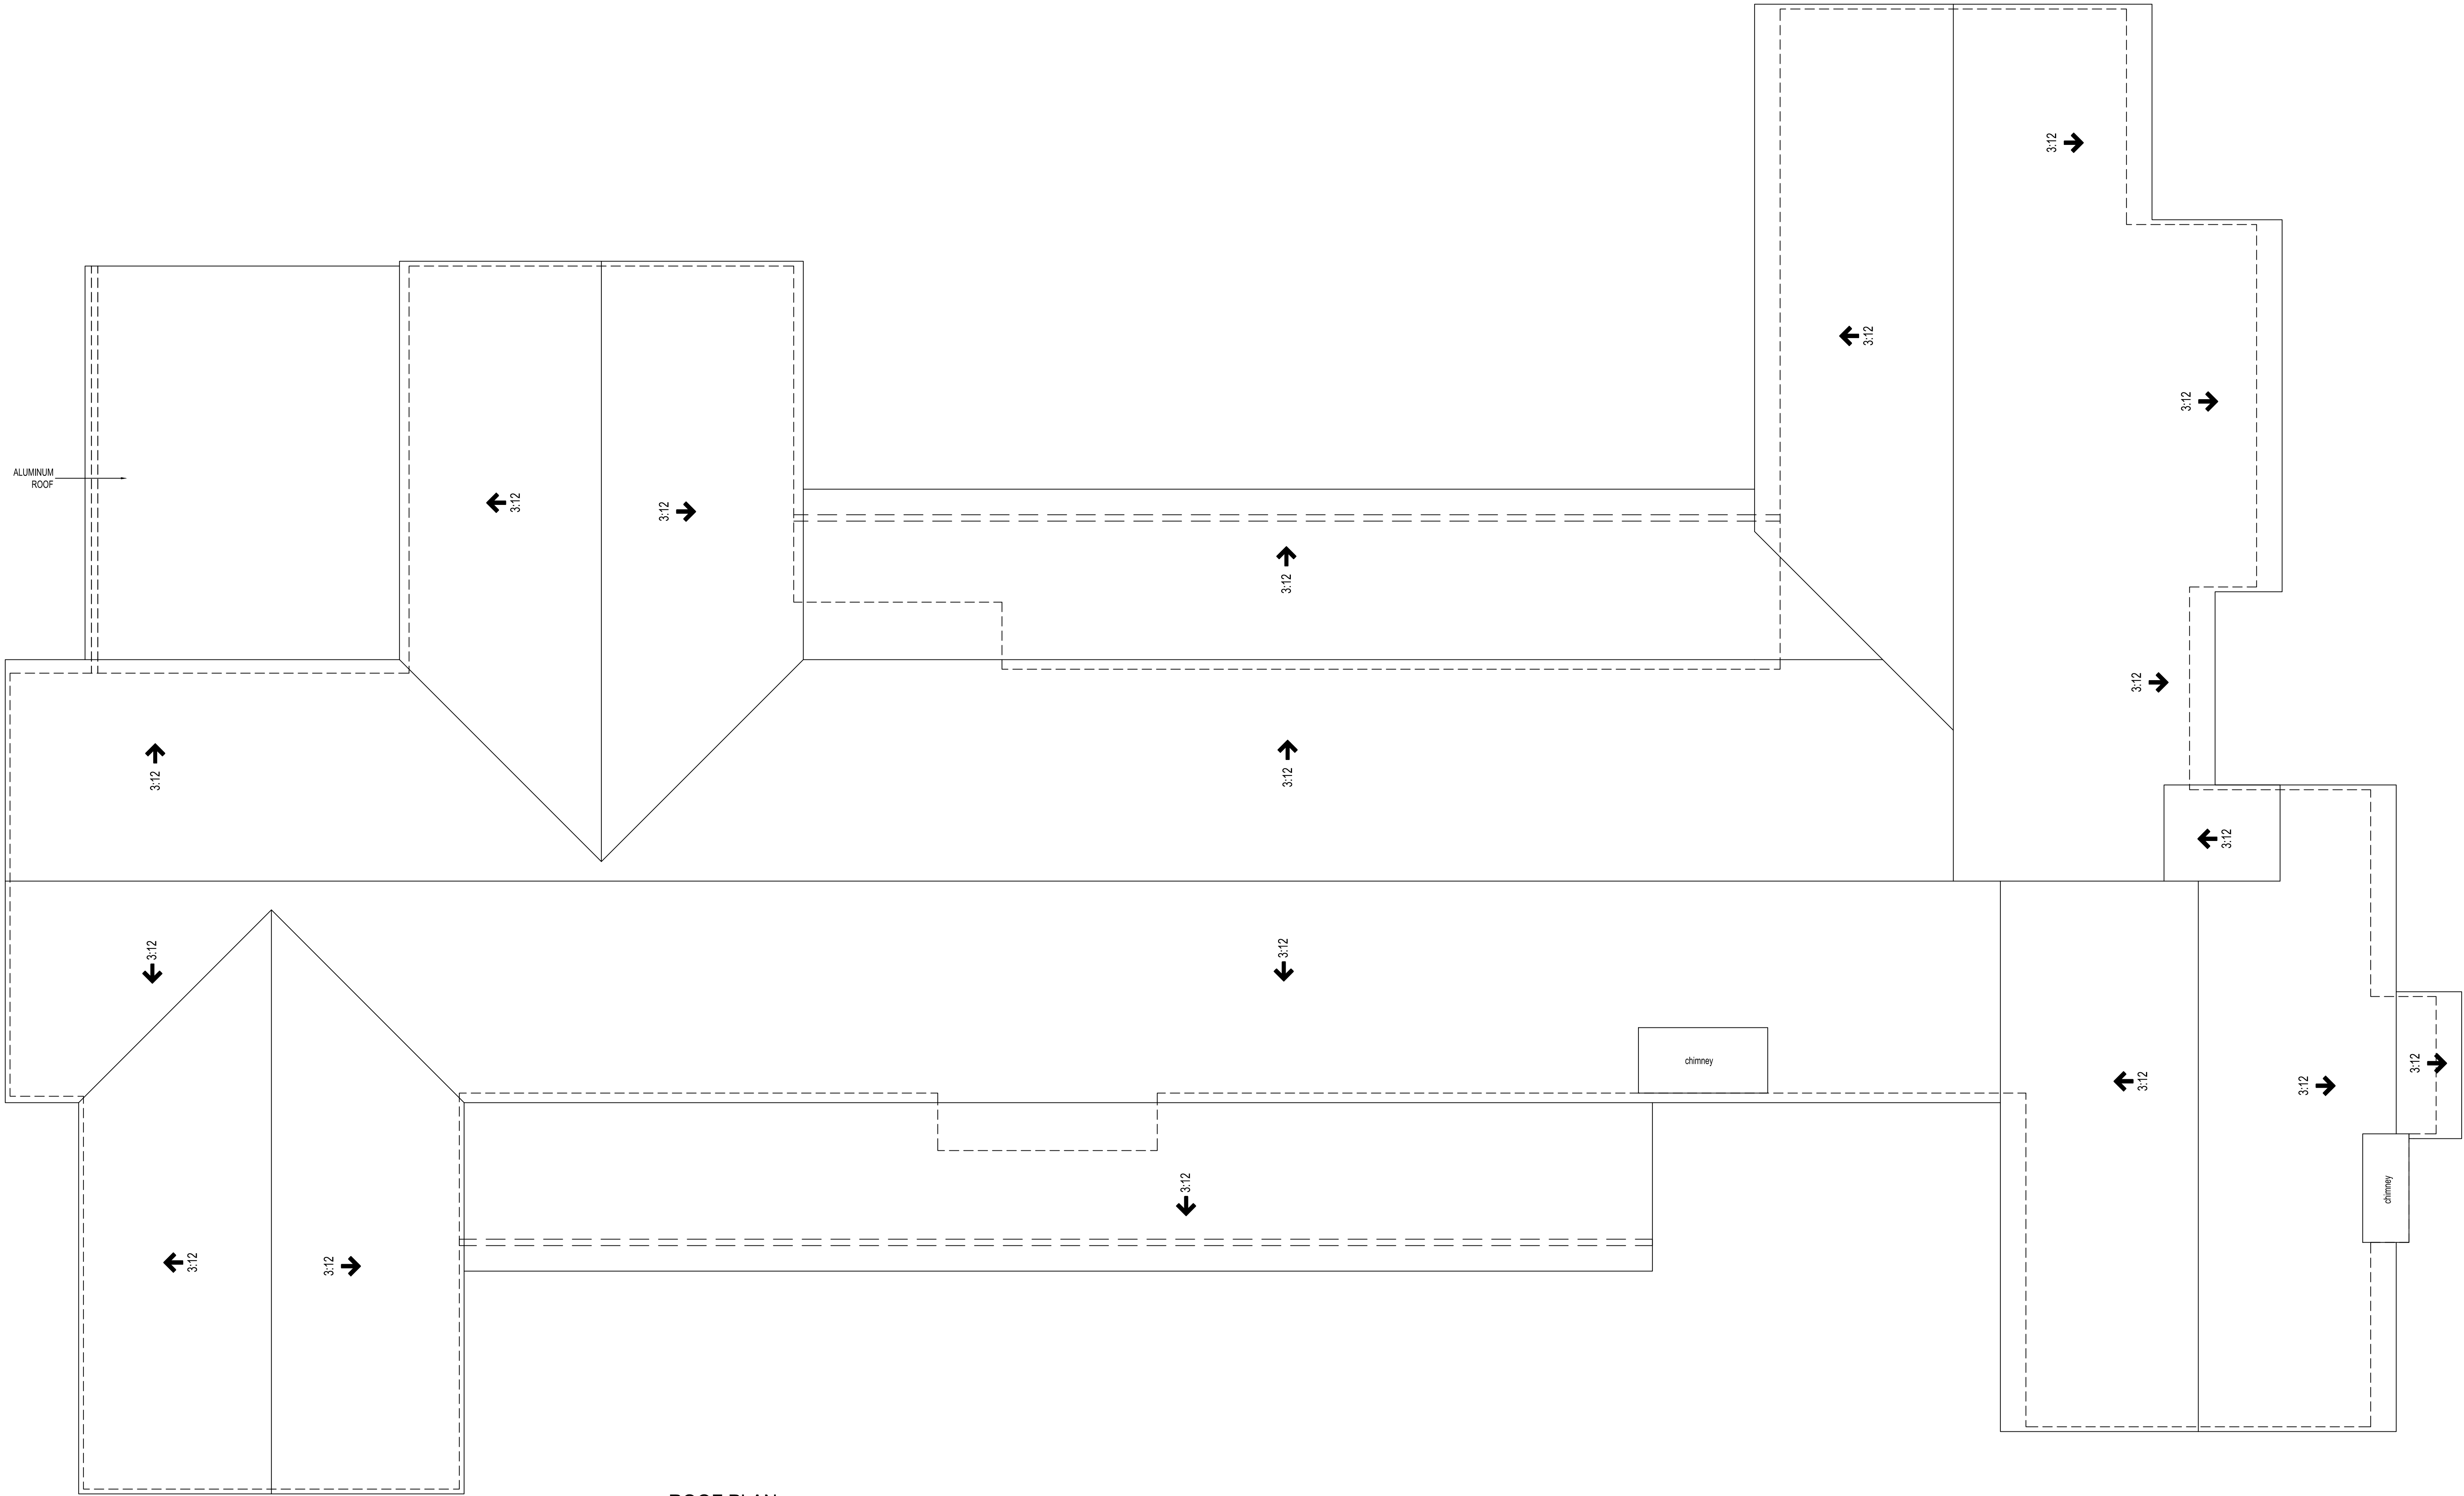

ROOF PLAN

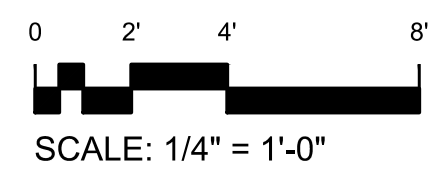

REVISIONS	BY

**AS-BUILT**  
LOS ANGELES

Sheet content :  
ROOF PLAN

Project :  
4747 ALTA CANYADA RD  
LA CANADA FLT CA 91011

Owner:

Date

Scale

Drawn


Job

Sheet

**A-6**

REVISIONS	BY

**AS-BUILT**  
LOS ANGELES

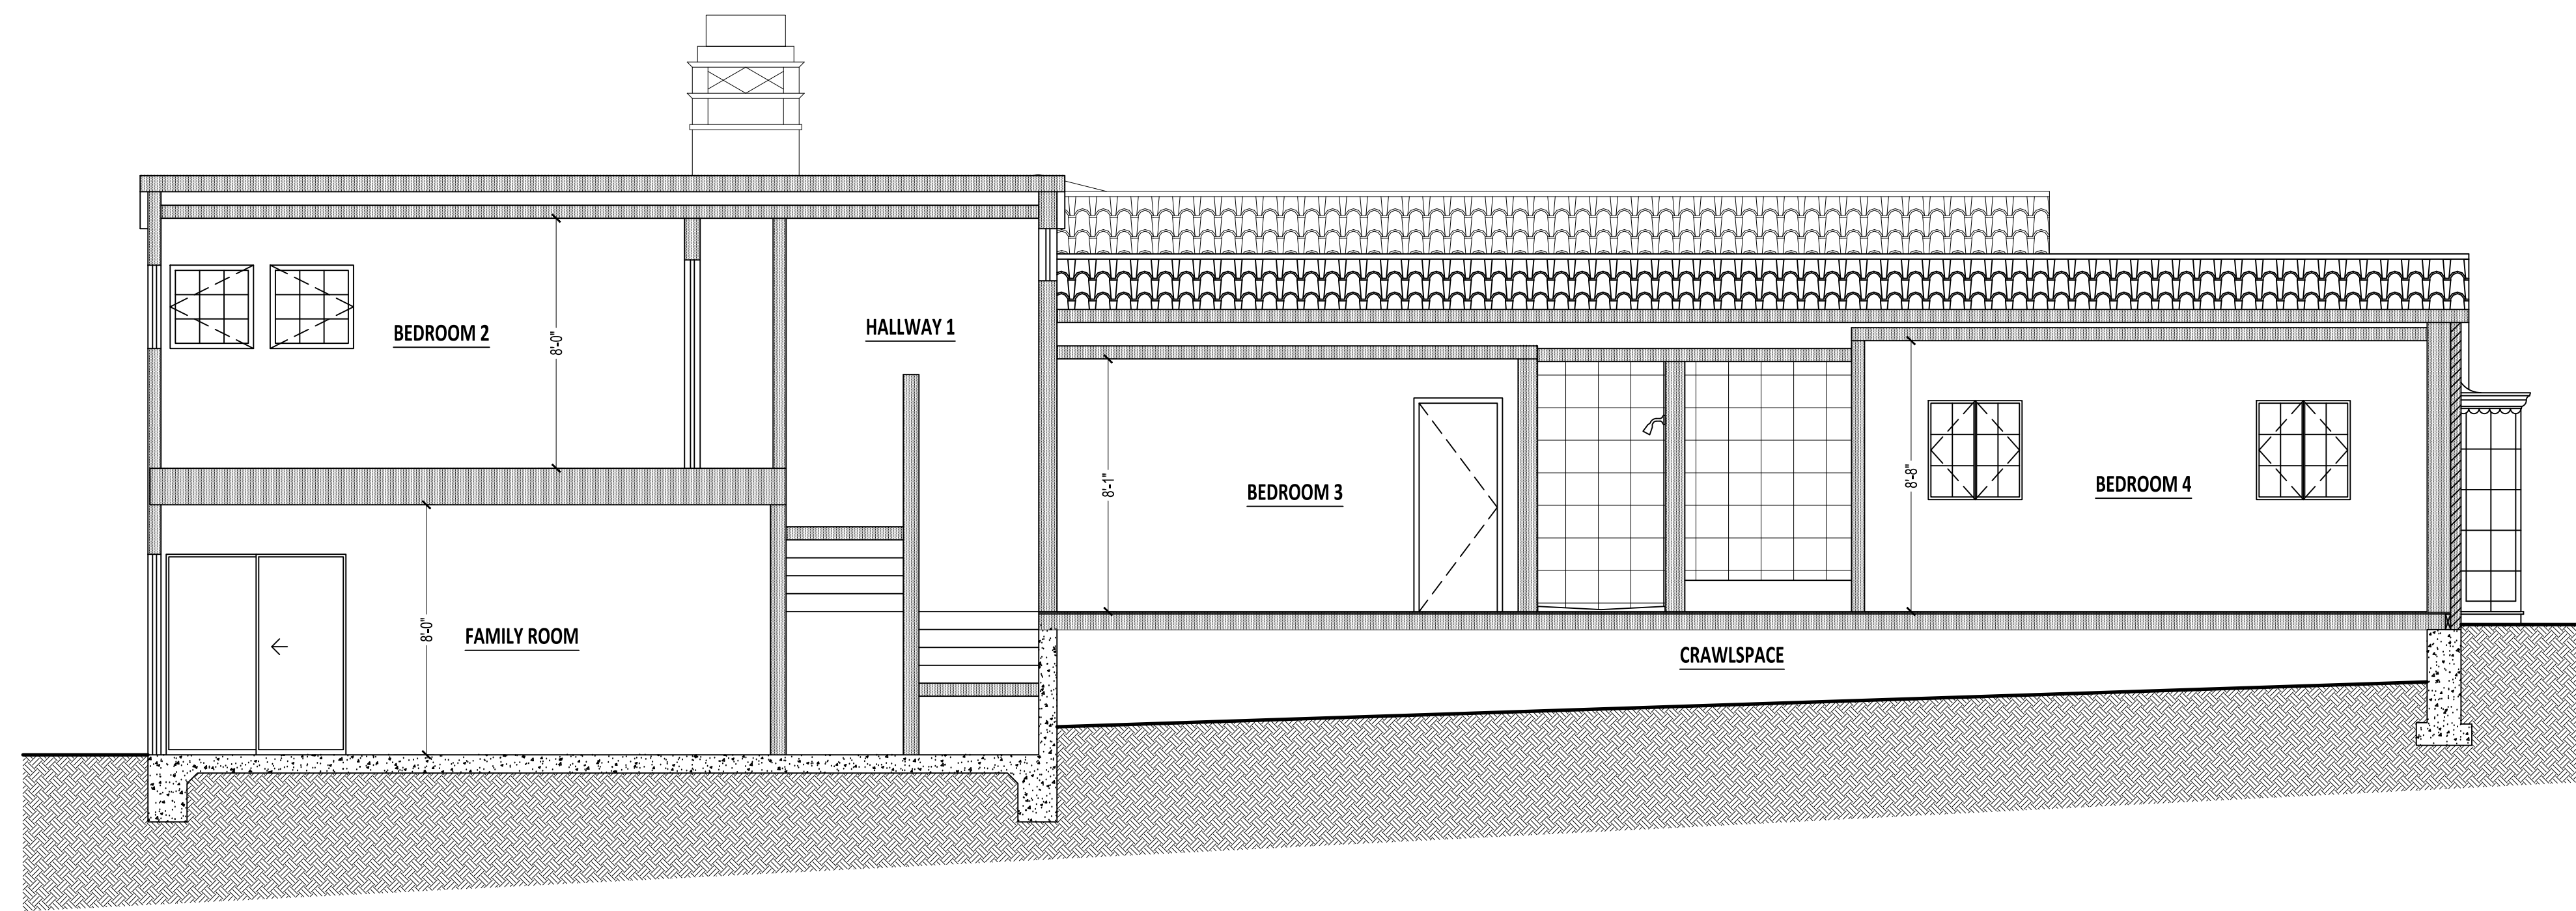

**SECTION A-A**

SCALE: 1/4" = 1'-0"

Sheet content :  
**SECTION A-A**

Project :  
4747 ALTA CANYADA RD  
LA CANADA FLT CA 91011

Owner:

Date

Scale

Drawn

Job

Sheet

**A-7**

