

REVISIONS	BY

AS-BUILT
LOS ANGELES

Sheet content :
PLOT PLAN

Project :
**1953 ERIN WAY
GLENDALE CA 91206**

Owner:

Date

Scale


Drawn

Job

Sheet


A-1

08.06.13

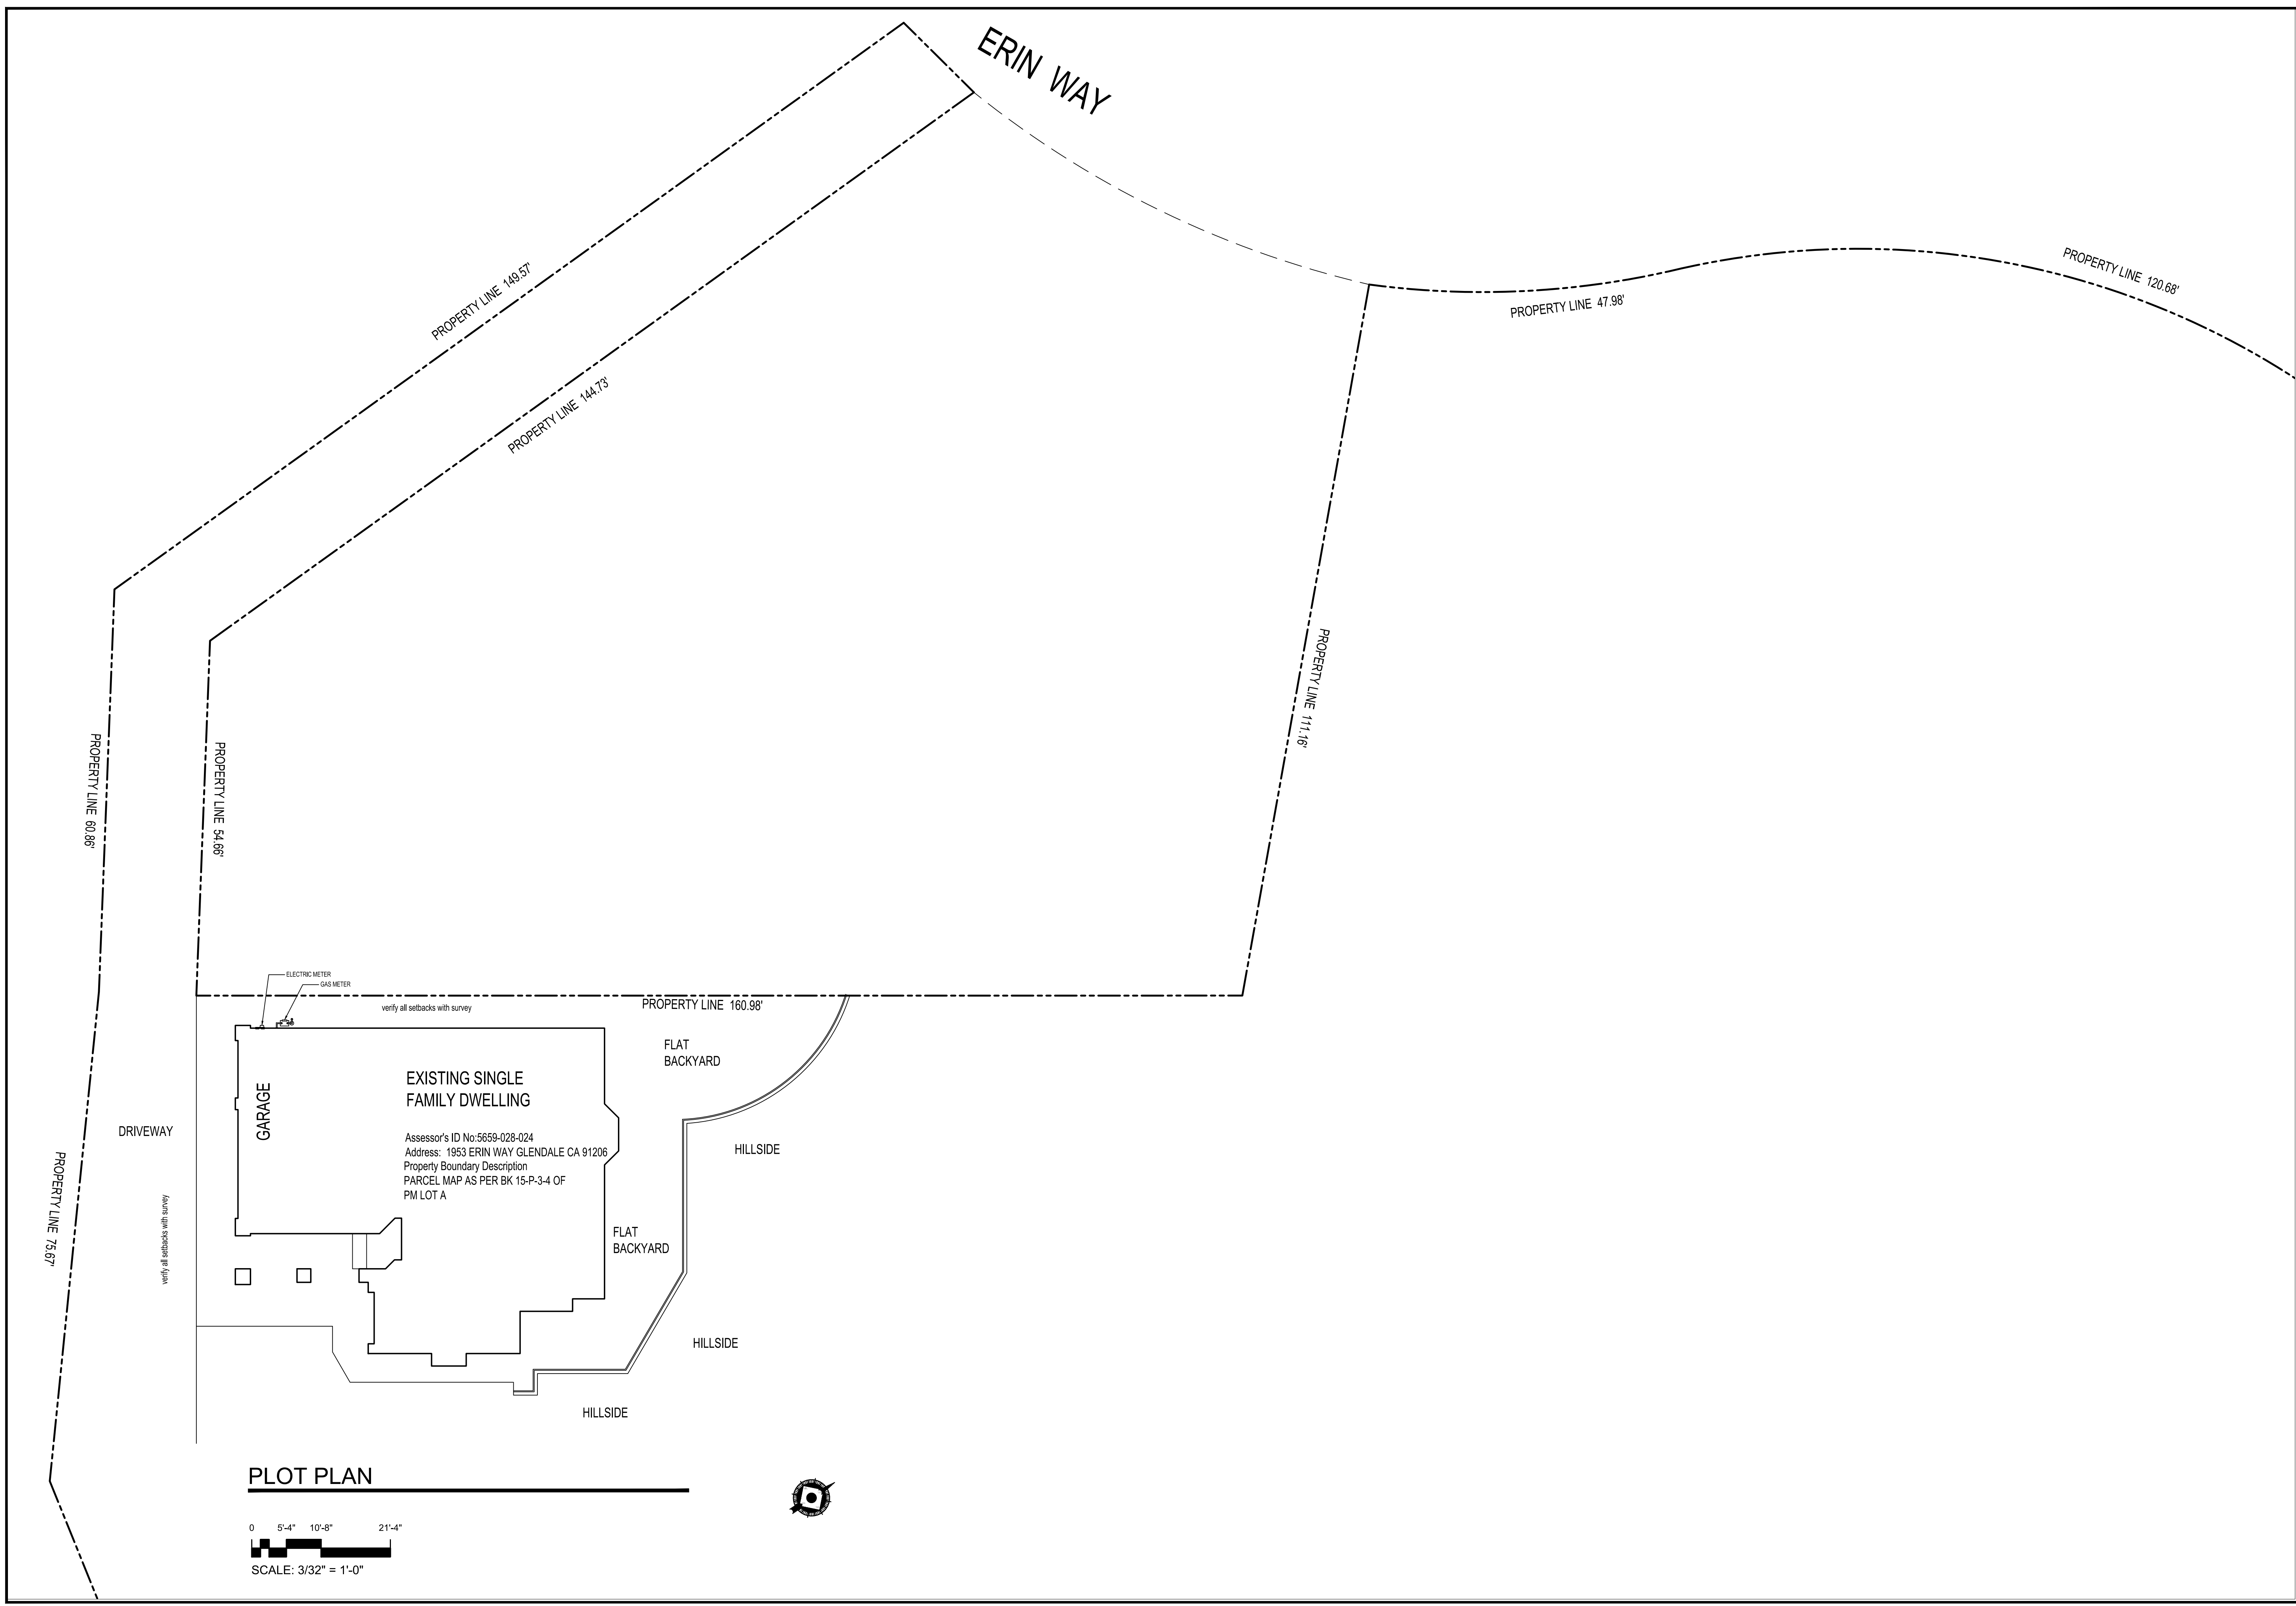


PLOT PLAN

0 5'-4" 10'-8" 21'-4"
SCALE: 3/32" = 1'-0"

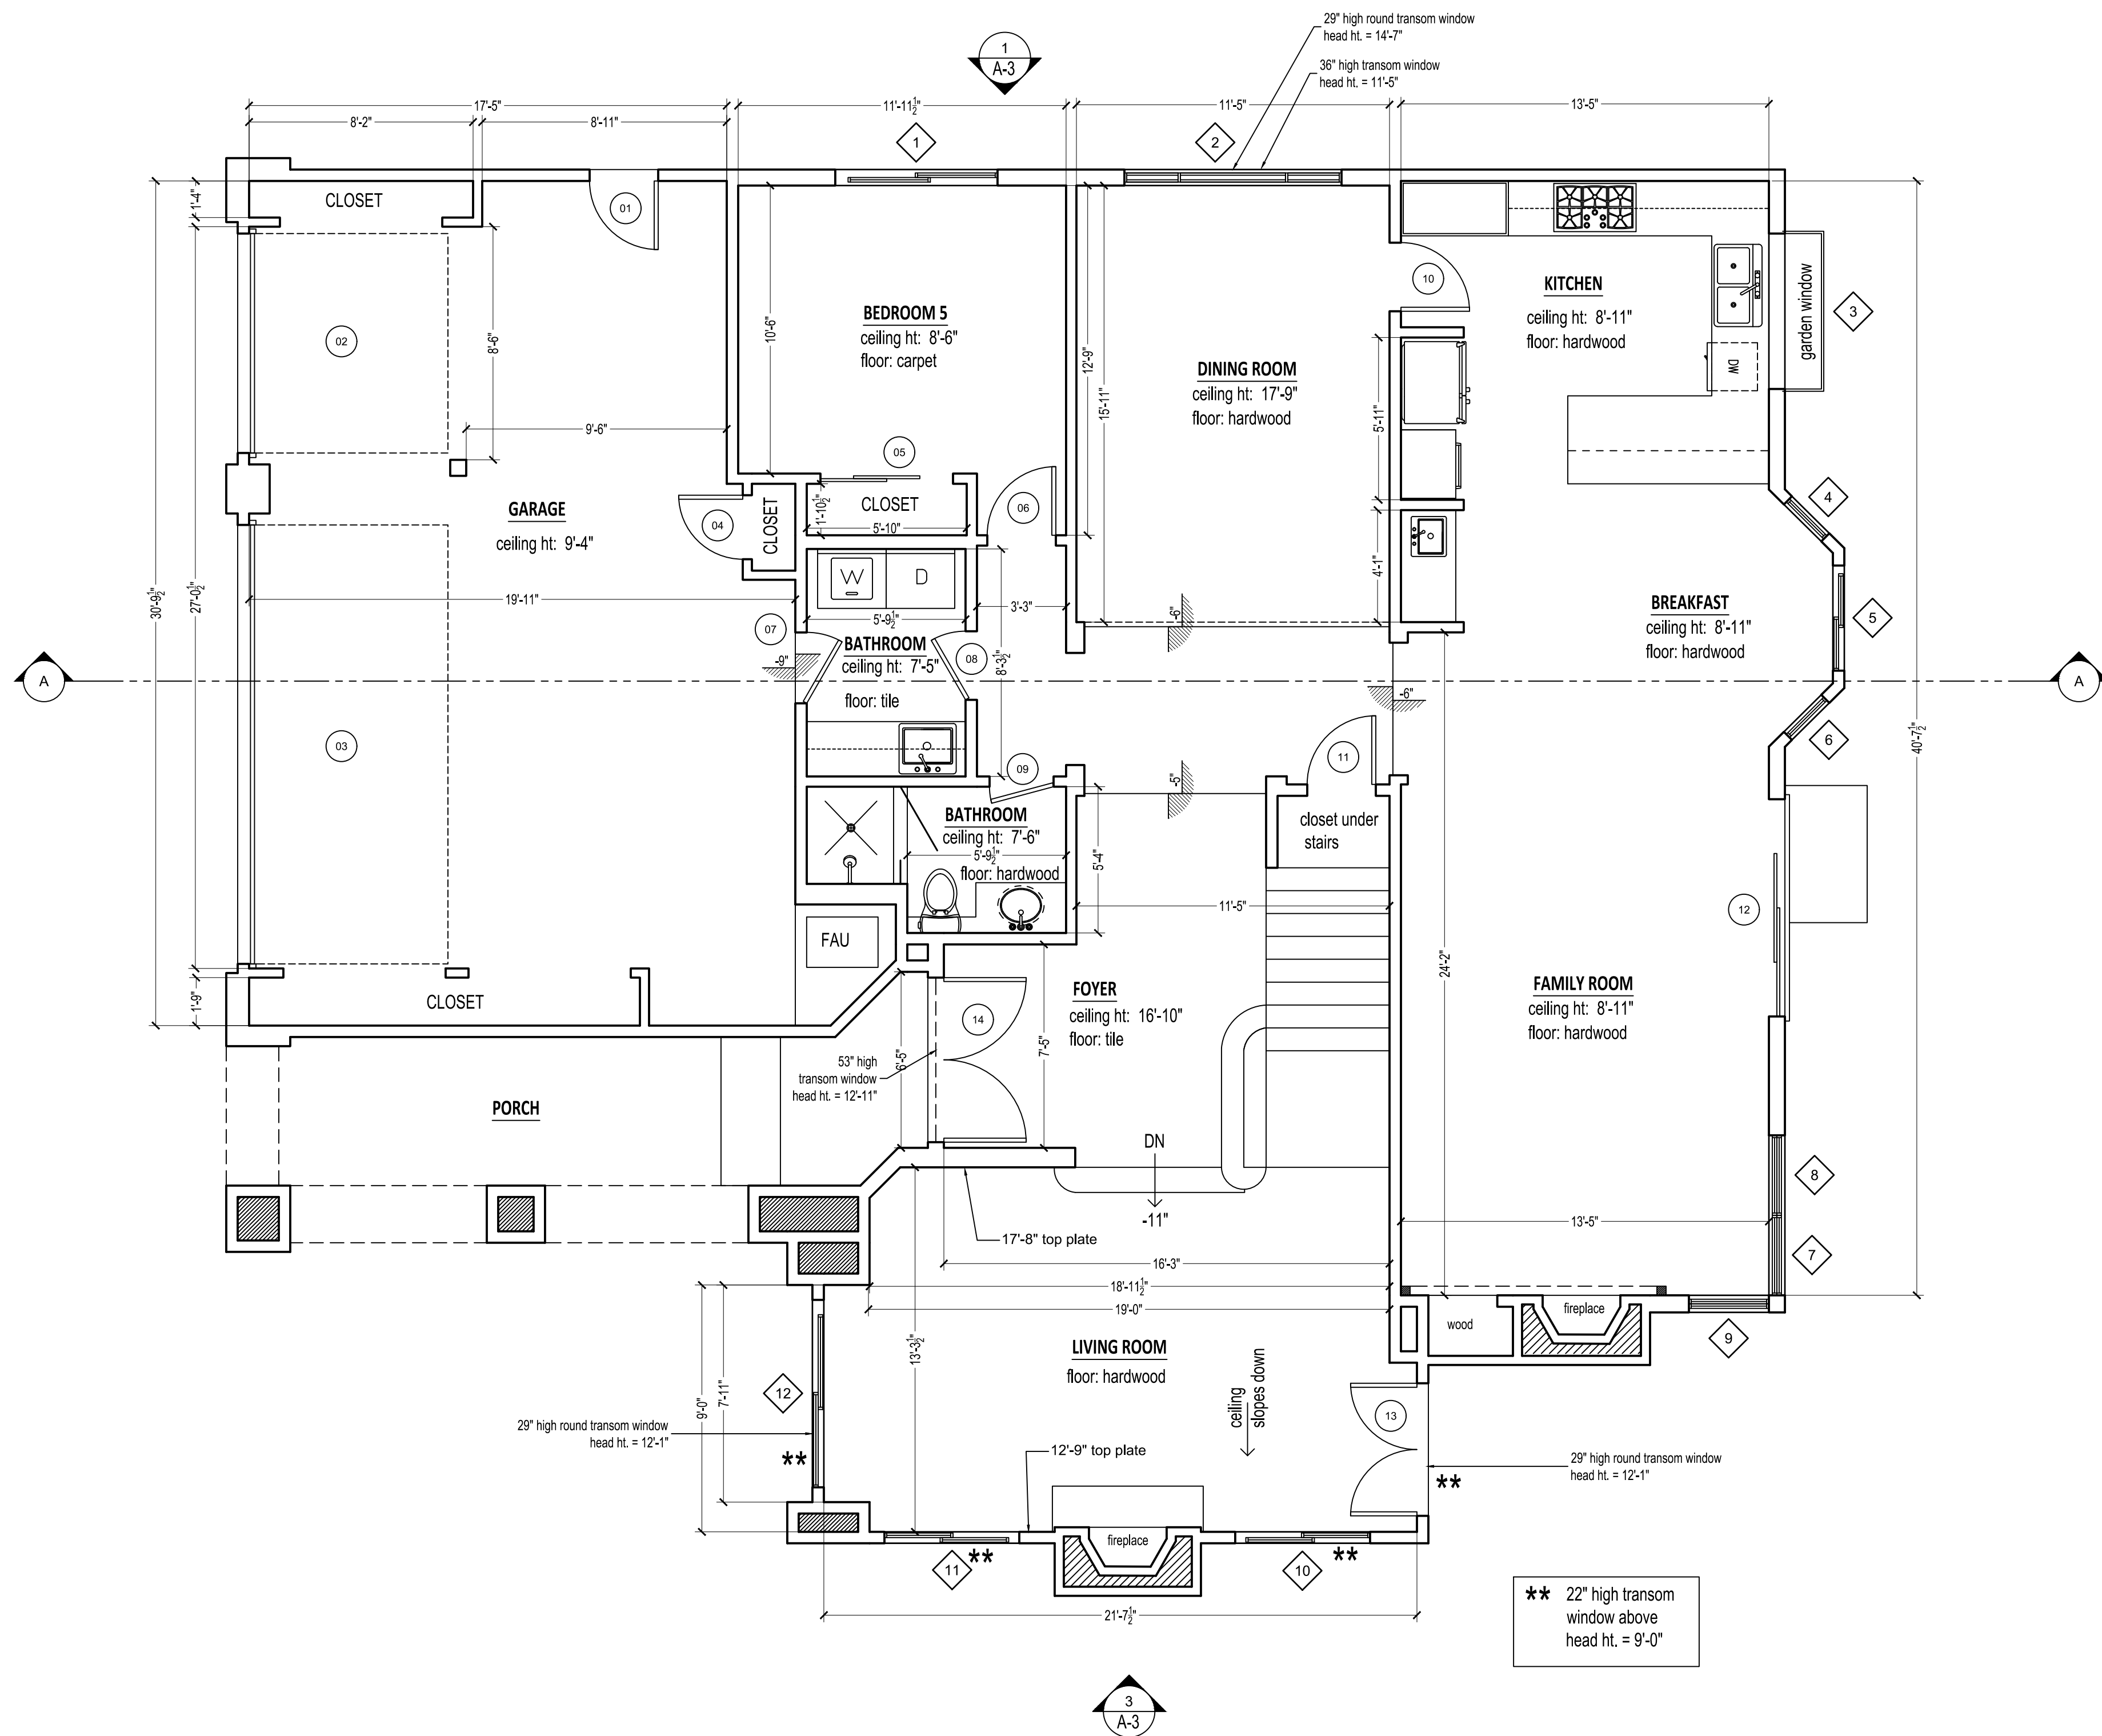

FIRST FLOOR PLAN

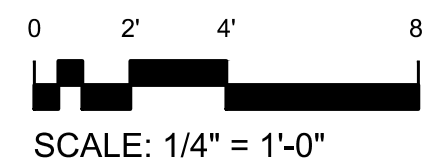

WINDOW SCHEDULE					
MARK	SIZE		TYPE	Head Height	NOTES
	Width	HEIGHT			
1	5'-11"	4'-10"	SLIDING	6'-8"	--
2	7'-11"	4'-10"	XOX SLIDING	7'-10"	--
3	5'-8"	4'-4"	PASS THROUGH	7'-4"	--
4	1'-11"	4'-10"	FIXED	7'-10"	--
5	3'-10"	4'-10"	SLIDING	7'-10"	--
6	1'-11"	4'-10"	FIXED	7'-10"	--
7	2'-11"	5'-10"	SINGLE HUNG	7'-10"	--
8	2'-11"	5'-10"	SINGLE HUNG	7'-10"	--
9	2'-11"	5'-10"	SINGLE HUNG	7'-10"	--
10	4'-11"	4'-11"	SLIDING	6'-8"	--
11	4'-11"	4'-11"	SLIDING	6'-8"	--
12	6'-10"	4'-11"	SLIDING	6'-8"	--
13	4'-10"	4'-10"	SLIDING	6'-8"	--
14	7'-11"	3'-10"	XOX SLIDING	6'-8"	--
15	5'-11"	3'-10"	SLIDING	6'-8"	--
16	3'-11"	3'-10"	SLIDING	6'-8"	--
17	1'-11"	4'-10"	FIXED	6'-8"	--
18	6'-11"	4'-10"	SLIDING	6'-8"	--
19	1'-11"	4'-10"	FIXED	6'-8"	--
20	6'-11"	4'-10"	SLIDING	6'-8"	--
21	3'-11"	4'-4"	SLIDING	6'-8"	--
22	3'-11"	4'-4"	SLIDING	6'-8"	--
23	6'-0"	4'-5"	FIXED	12'-11"	--

DOOR SCHEDULE				
MARK	DOOR SIZE		Type	NOTES
	WD	HGT		
1	2'-6"	6'-8"	SWING	--
2	8'-0"	7'-0"	GARAGE DOOR	--
3	16'-0"	7'-0"	GARAGE DOOR	--
4	2'-4"	6'-8"	SWING	--
5	4'-10"	6'-8"	SLIDING - DOUBLE	--
6	2'-9"	6'-8"	SWING	--
7	2'-7"	6'-8"	SWING	--
8	2'-6"	6'-8"	SWING	--
9	2'-4"	6'-8"	SWING	--
10	2'-6"	6'-8"	SWING	--
11	2'-6"	6'-8"	SWING	--
12	2'-11"	7'-11"	SLIDING DOUBLE	--
13	4'-10"	6'-8"	FRENCH DOUBLE	--
14	6'-0"	7'-11"	SWING DOUBLE	--
15	4'-6"	6'-8"	SLIDING - DOUBLE	--
16	4'-8"	6'-8"	SWING DOUBLE	--
17	2'-6"	6'-8"	SWING	--
18	5'-10"	6'-8"	SLIDING - DOUBLE	--
19	2'-6"	6'-8"	SWING	--
20	3'-10"	6'-8"	SLIDING - DOUBLE	--
21	2'-4"	6'-8"	SWING	--
22	2'-4"	6'-8"	SWING	--
23	4'-8"	6'-8"	SWING DOUBLE	--
24	2'-10"	6'-8"	SWING	--
25	7'-10"	6'-8"	SLIDING - DOUBLE	--
26	3'-10"	6'-8"	SLIDING - DOUBLE	--
27	2'-4"	6'-8"	SWING	--

REVISIONS	BY
AS-BUILT LOS ANGELES	
Sheet content : FLOOR PLAN	
Project : 1953 ERIN WAY GLENDALE CA 91206	
Owner:	
Date	
Scale	
Drawn	
Job	
Sheet	A-2

REVISIONS	BY


AS-BUILT
LOS ANGELES

Sheet content :
SECOND FLOOR PLAN


Project :
1953 ERIN WAY
GLENDALE CA 91206


Owner:
Date
Scale
Drawn
Job
Sheet

A-3

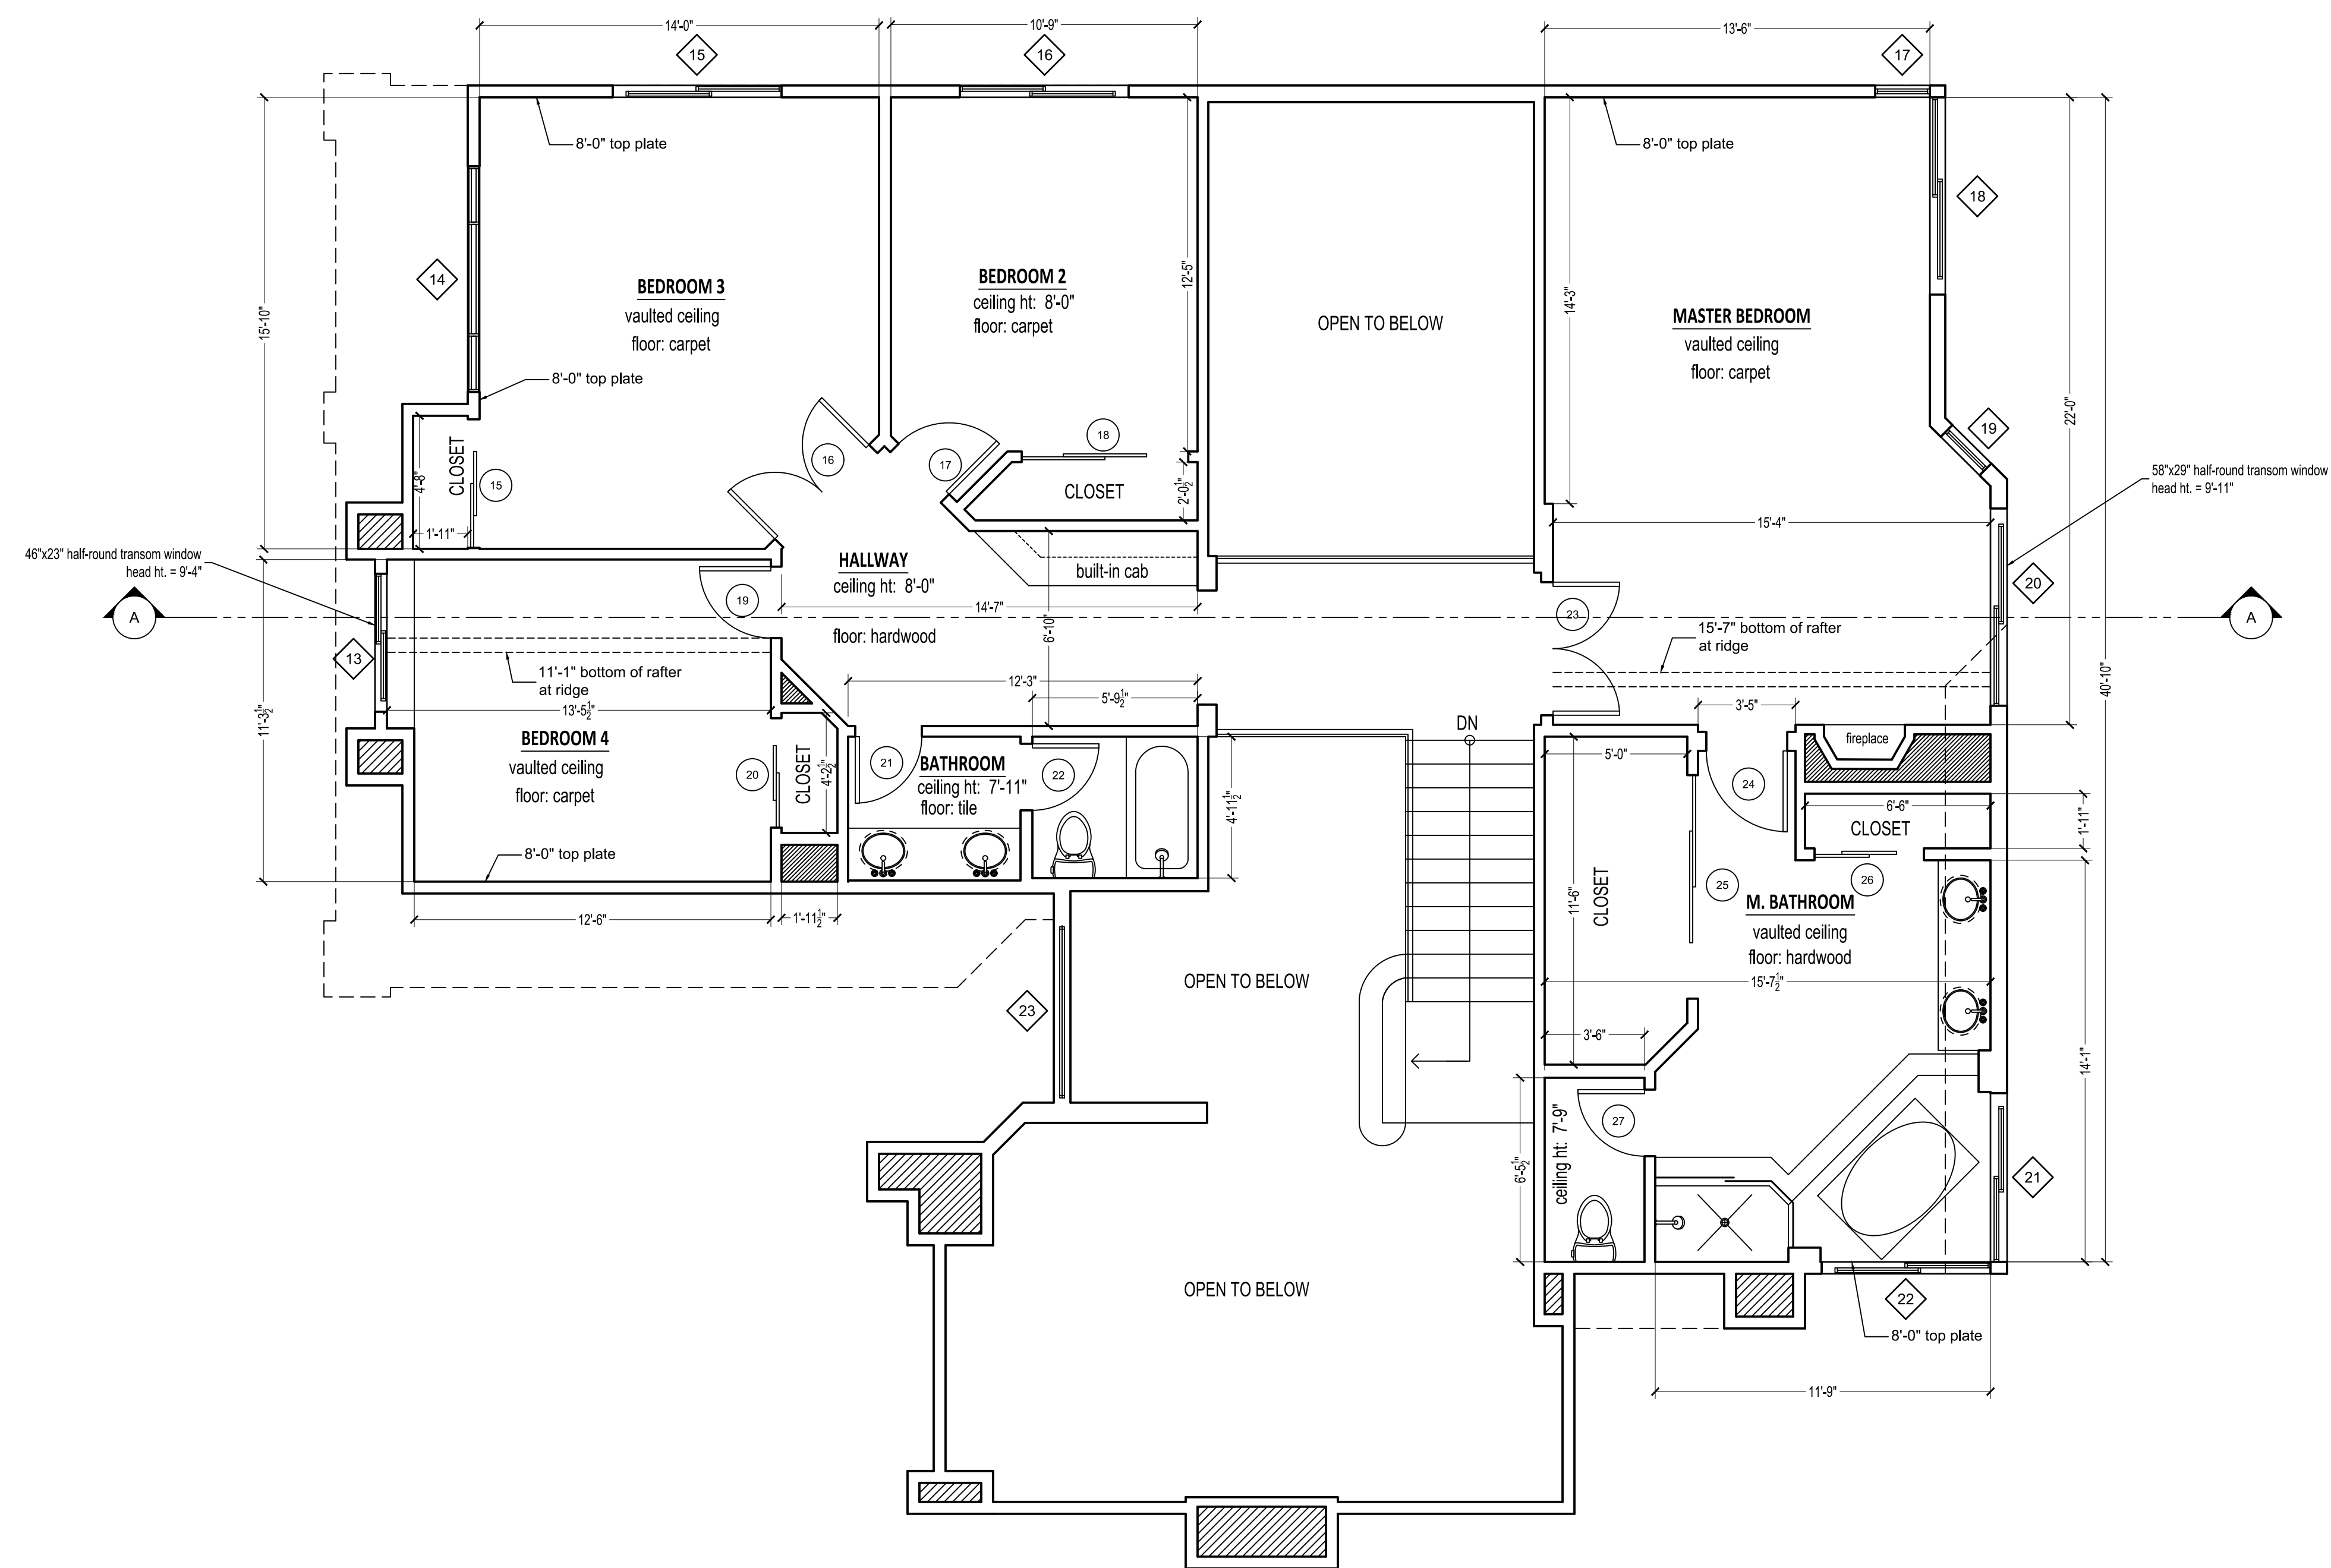

SECOND FLOOR PLAN

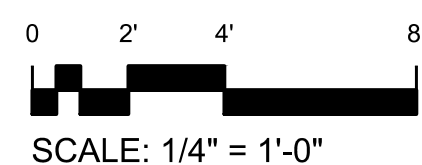

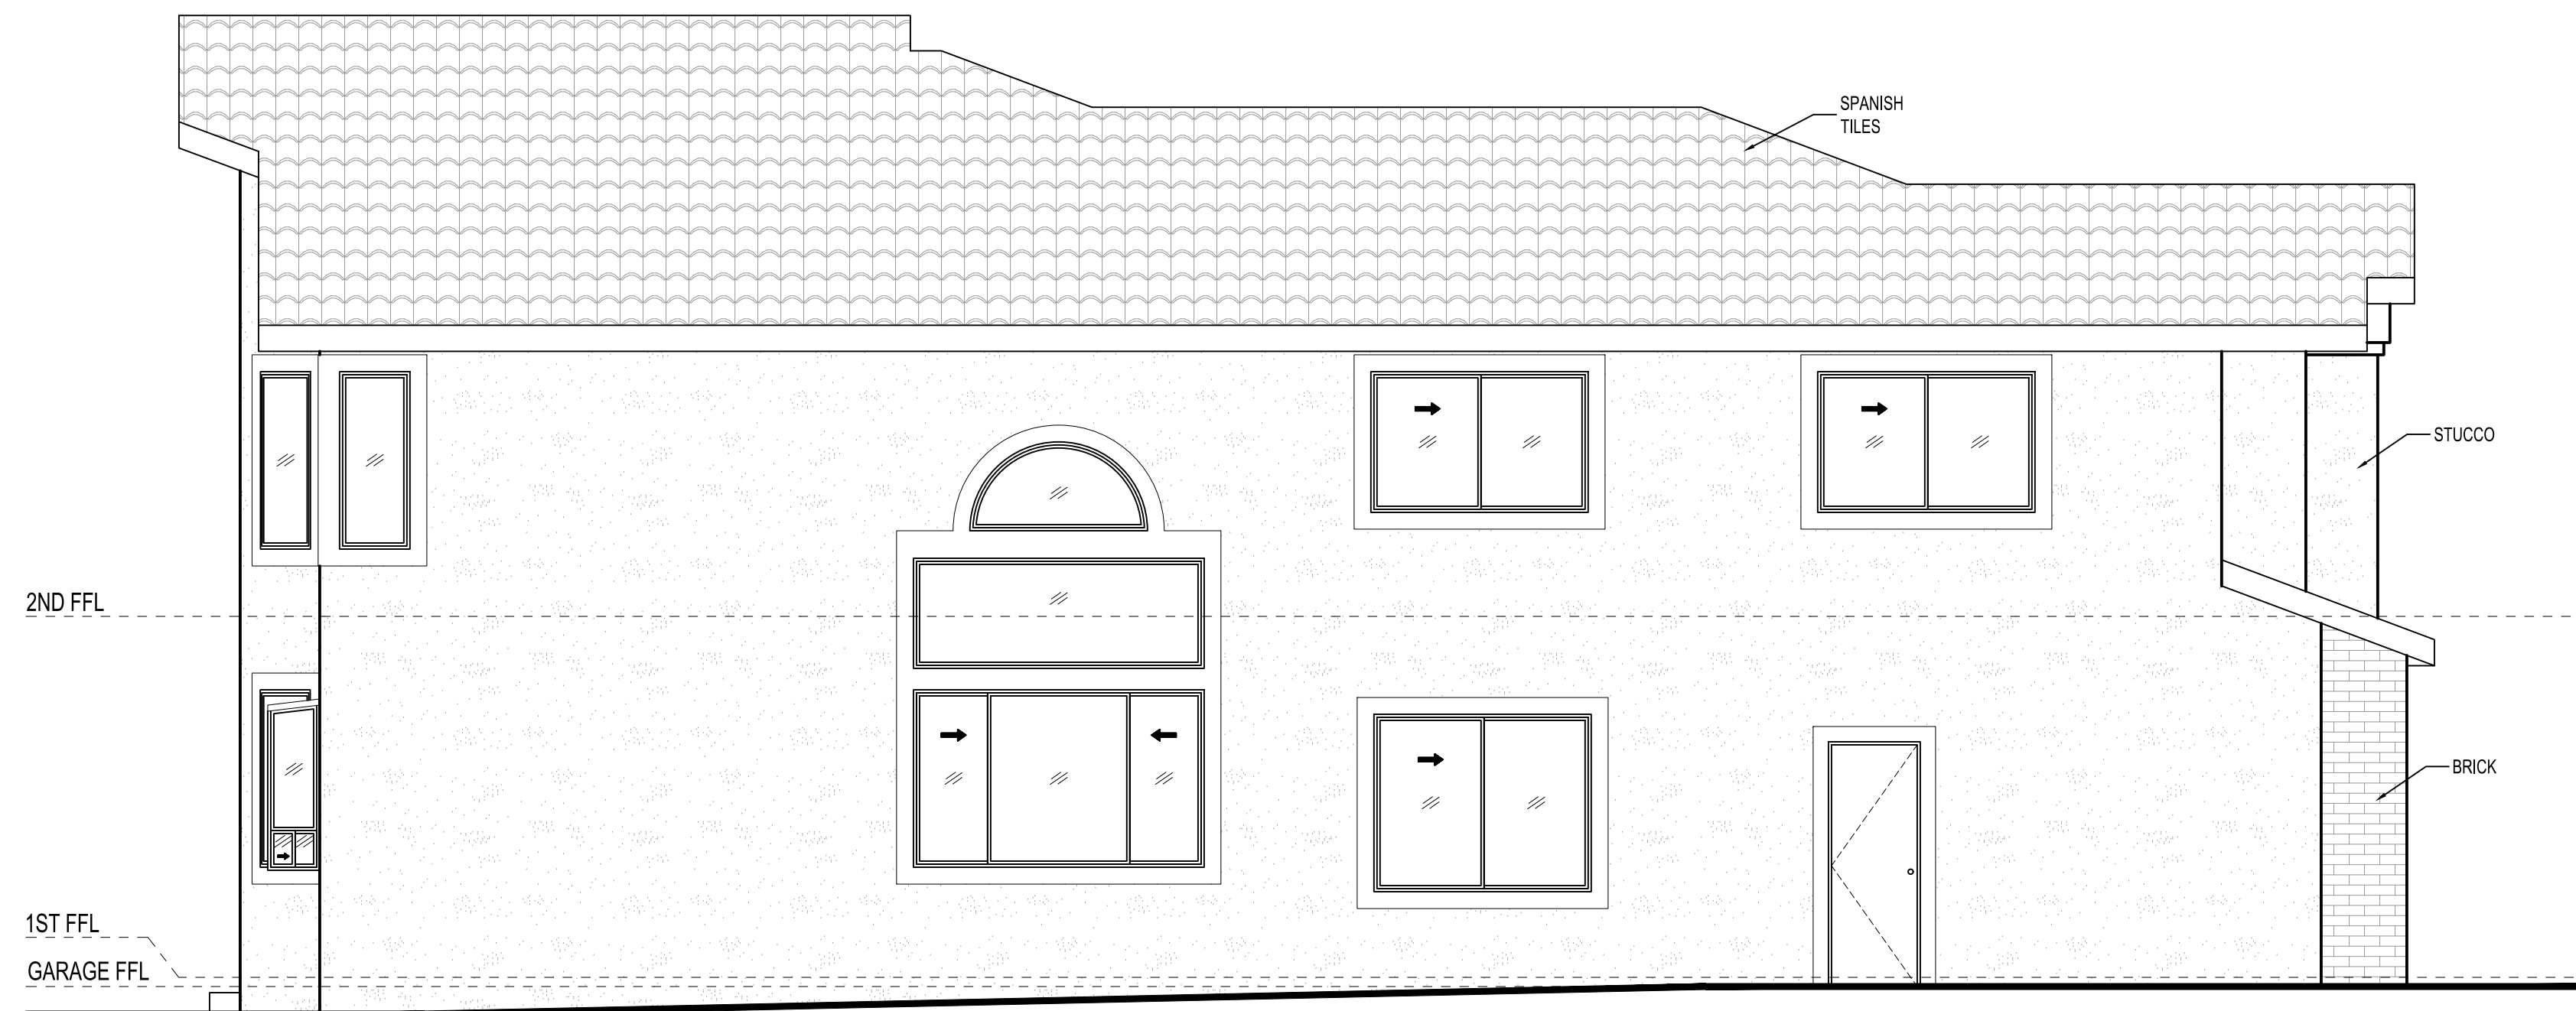

1 N. W. ELEVATION
0 2' 4' 8'
SCALE: 1/4" = 1'-0"




2 N. E. ELEVATION
0 2' 4' 8'
SCALE: 1/4" = 1'-0"



3 S. E. ELEVATION
0 2' 4' 8'
SCALE: 1/4" = 1'-0"



4 S. W. ELEVATION
 0 2' 4' 8'
 SCALE: 1/4" = 1'-0"

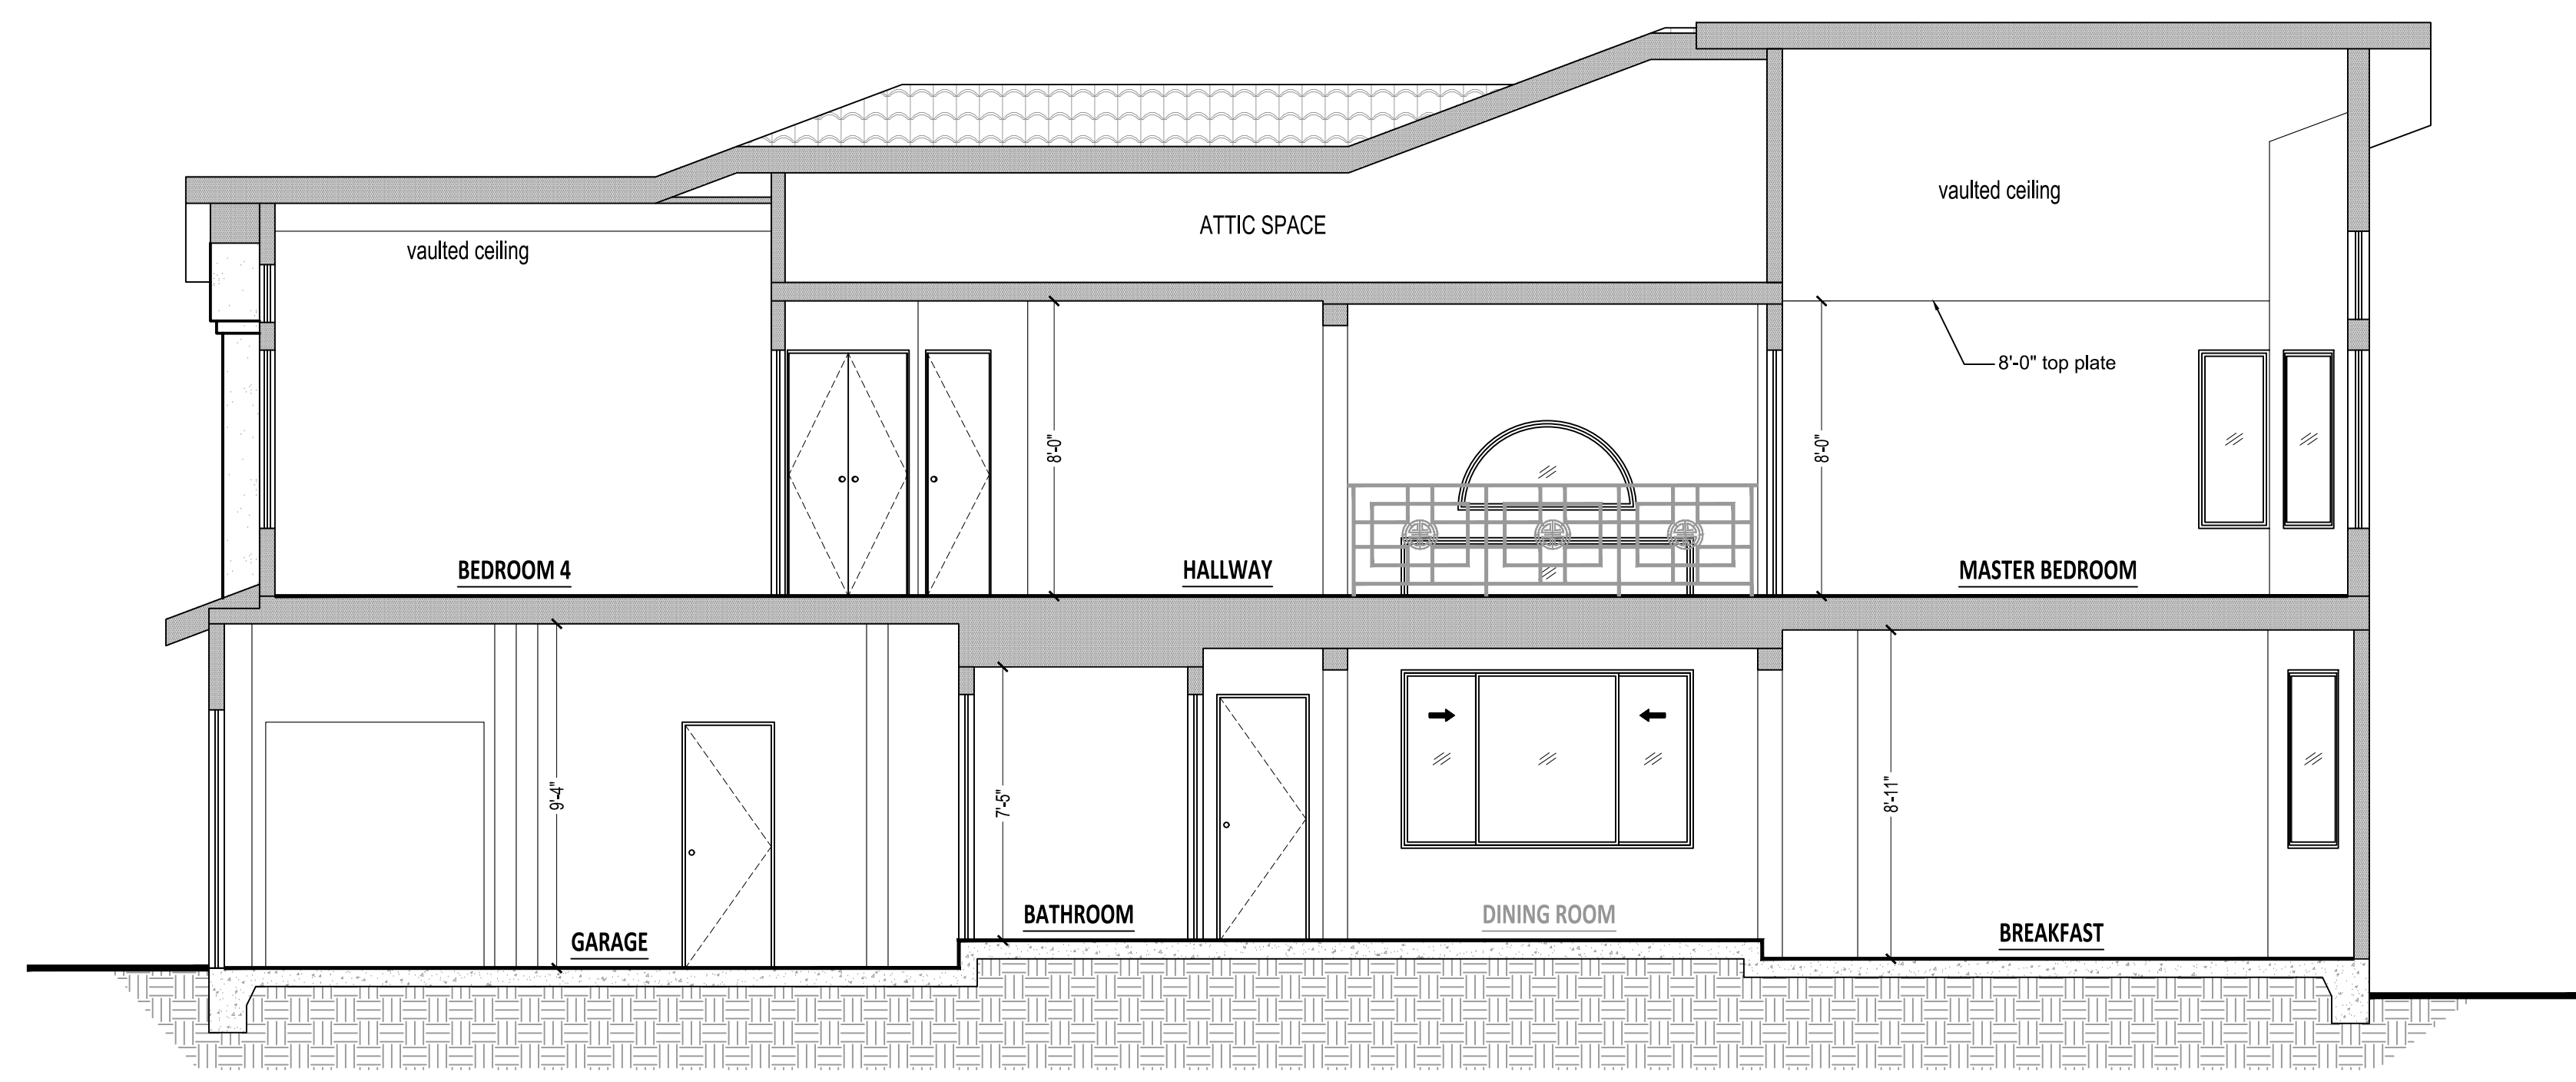


SECTION A-A
 0 2' 4' 8'
 SCALE: 1/4" = 1'-0"

REVISIONS	BY
AS-BUILT LOS ANGELES	
SECTION A-A ELEVATION	
Sheet content :	
Project : 1953 ERIN WAY GLENDALE CA 91206	
Owner:	
Date	
Scale	
Drawn	
Job	
Sheet	
A-5	

REVISIONS	BY

AS-BUILT
LOS ANGELES

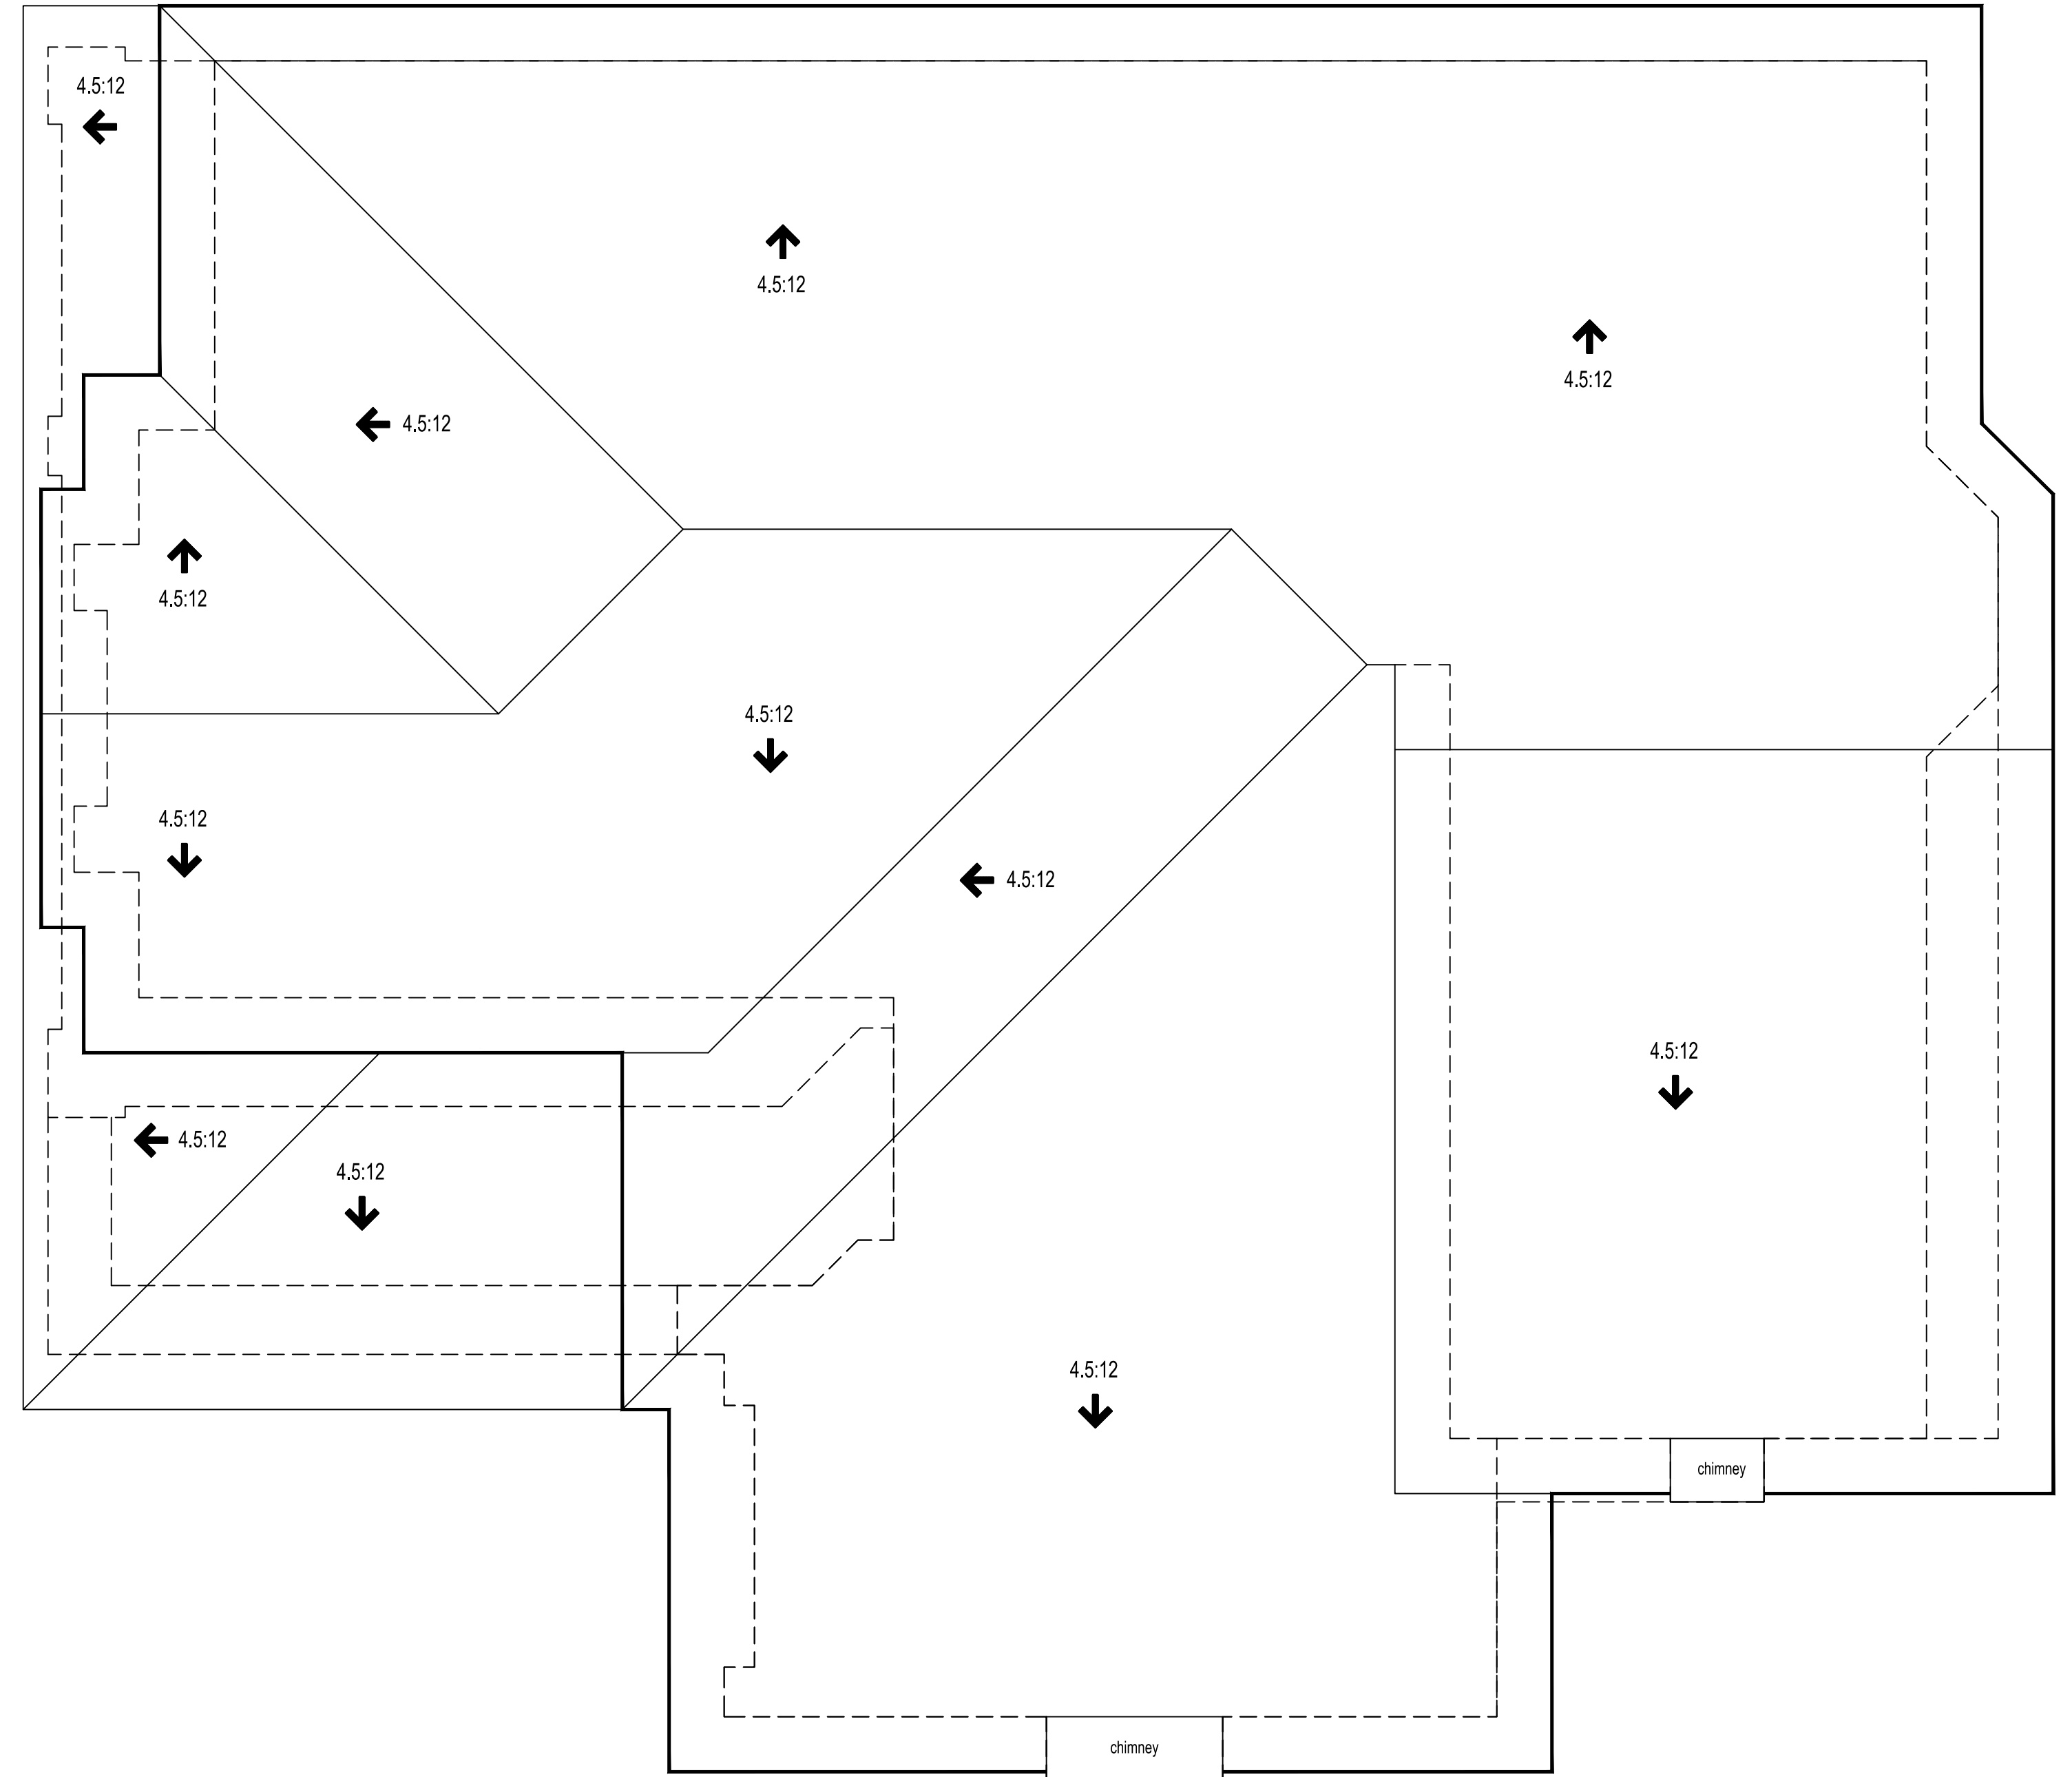

ROOF PLAN

0 2' 4' 8'

SCALE: 1/4" = 1'-0"

Sheet content :
ROOF PLAN

Project :
1953 ERIN WAY
GLENDALE CA 91206

Owner:

Date

Scale



Drawn

Job

Sheet

A-6

08.28.13

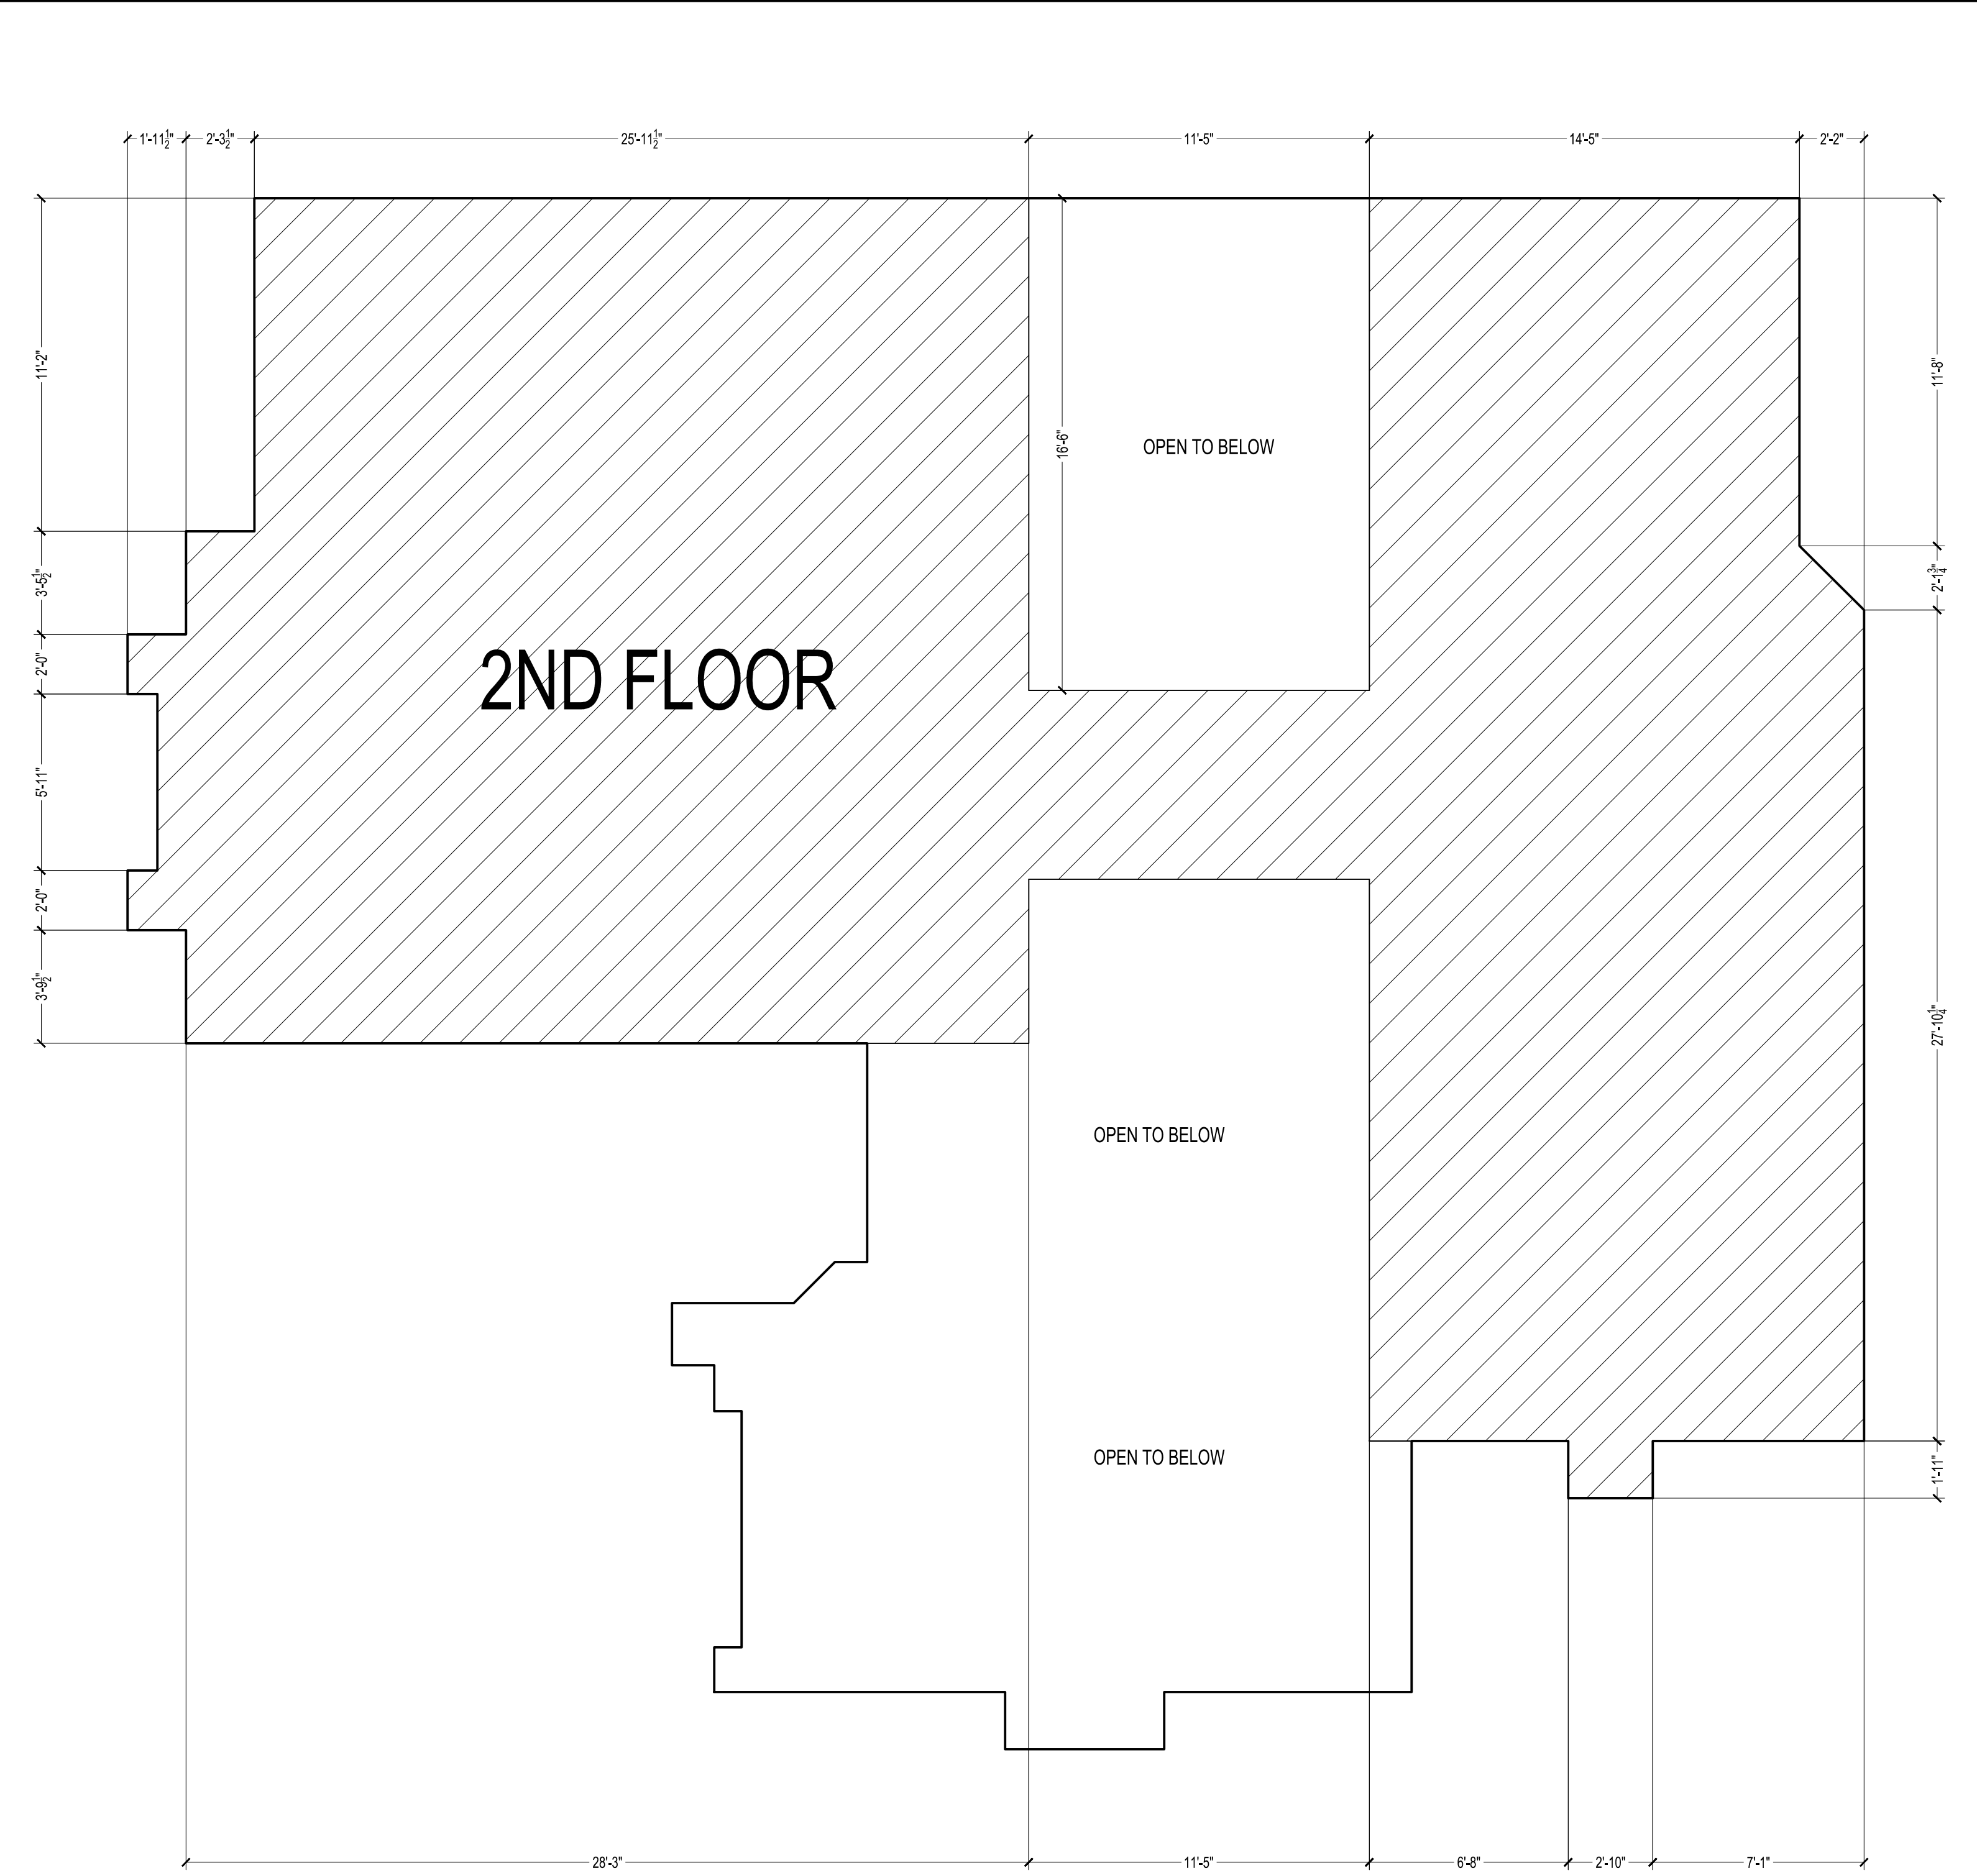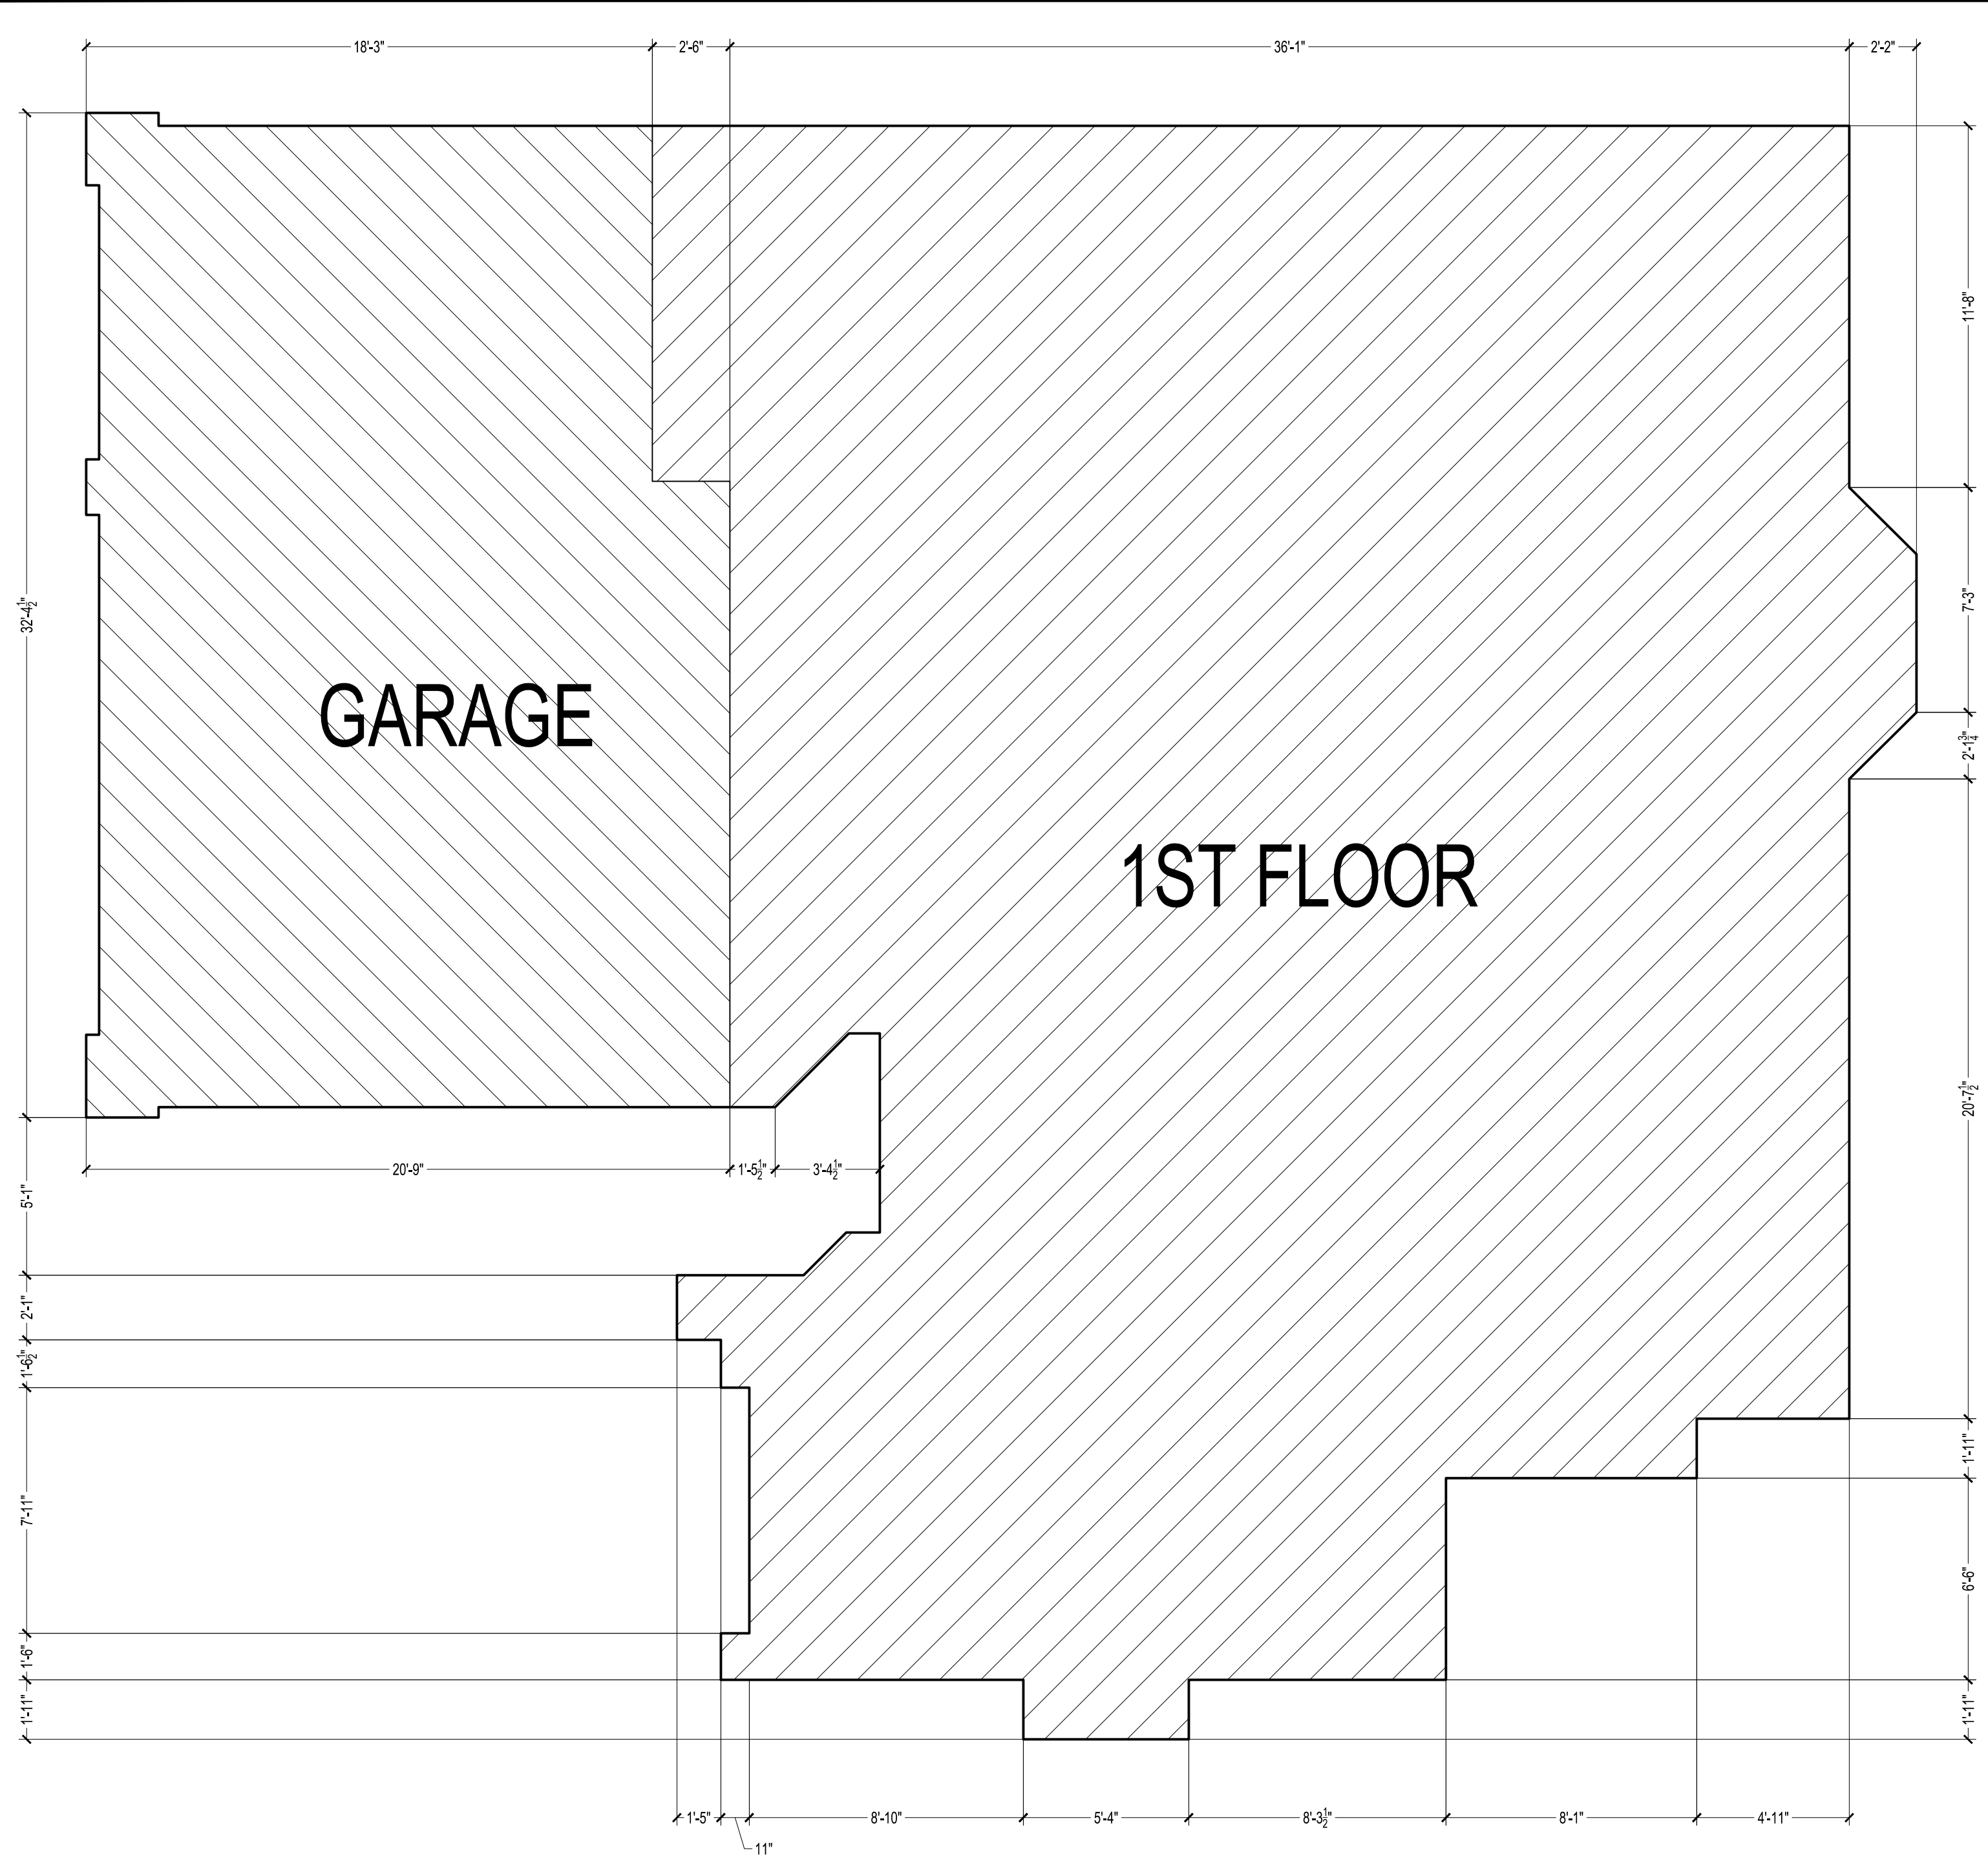

SQUARE FOOTAGE
 FIRST FLOOR: 1738 SF
 SECOND FLOOR: 1529 SF
 GARAGE: 619 SF
 TOTAL: 3,886 SF

REVISIONS	BY
AS-BUILT LOS ANGELES	
Sheet content : SQUARE FOOTAGE CALCULATION	
Project : 1953 ERIN WAY GLENDALE CA 91206	
Owner:	
Date	
Scale	
Drawn	
Job	
Sheet	A-7