

REVISIONS	BY

AS-BUILT
LOS ANGELES

Sheet content:
PLOT PLAN

Project:
6 COLINA LN
ROLLING HILLS ES CA 90274

Owner:

Date

Scale


Drawn

Job

Sheet

A-1

08.26.13

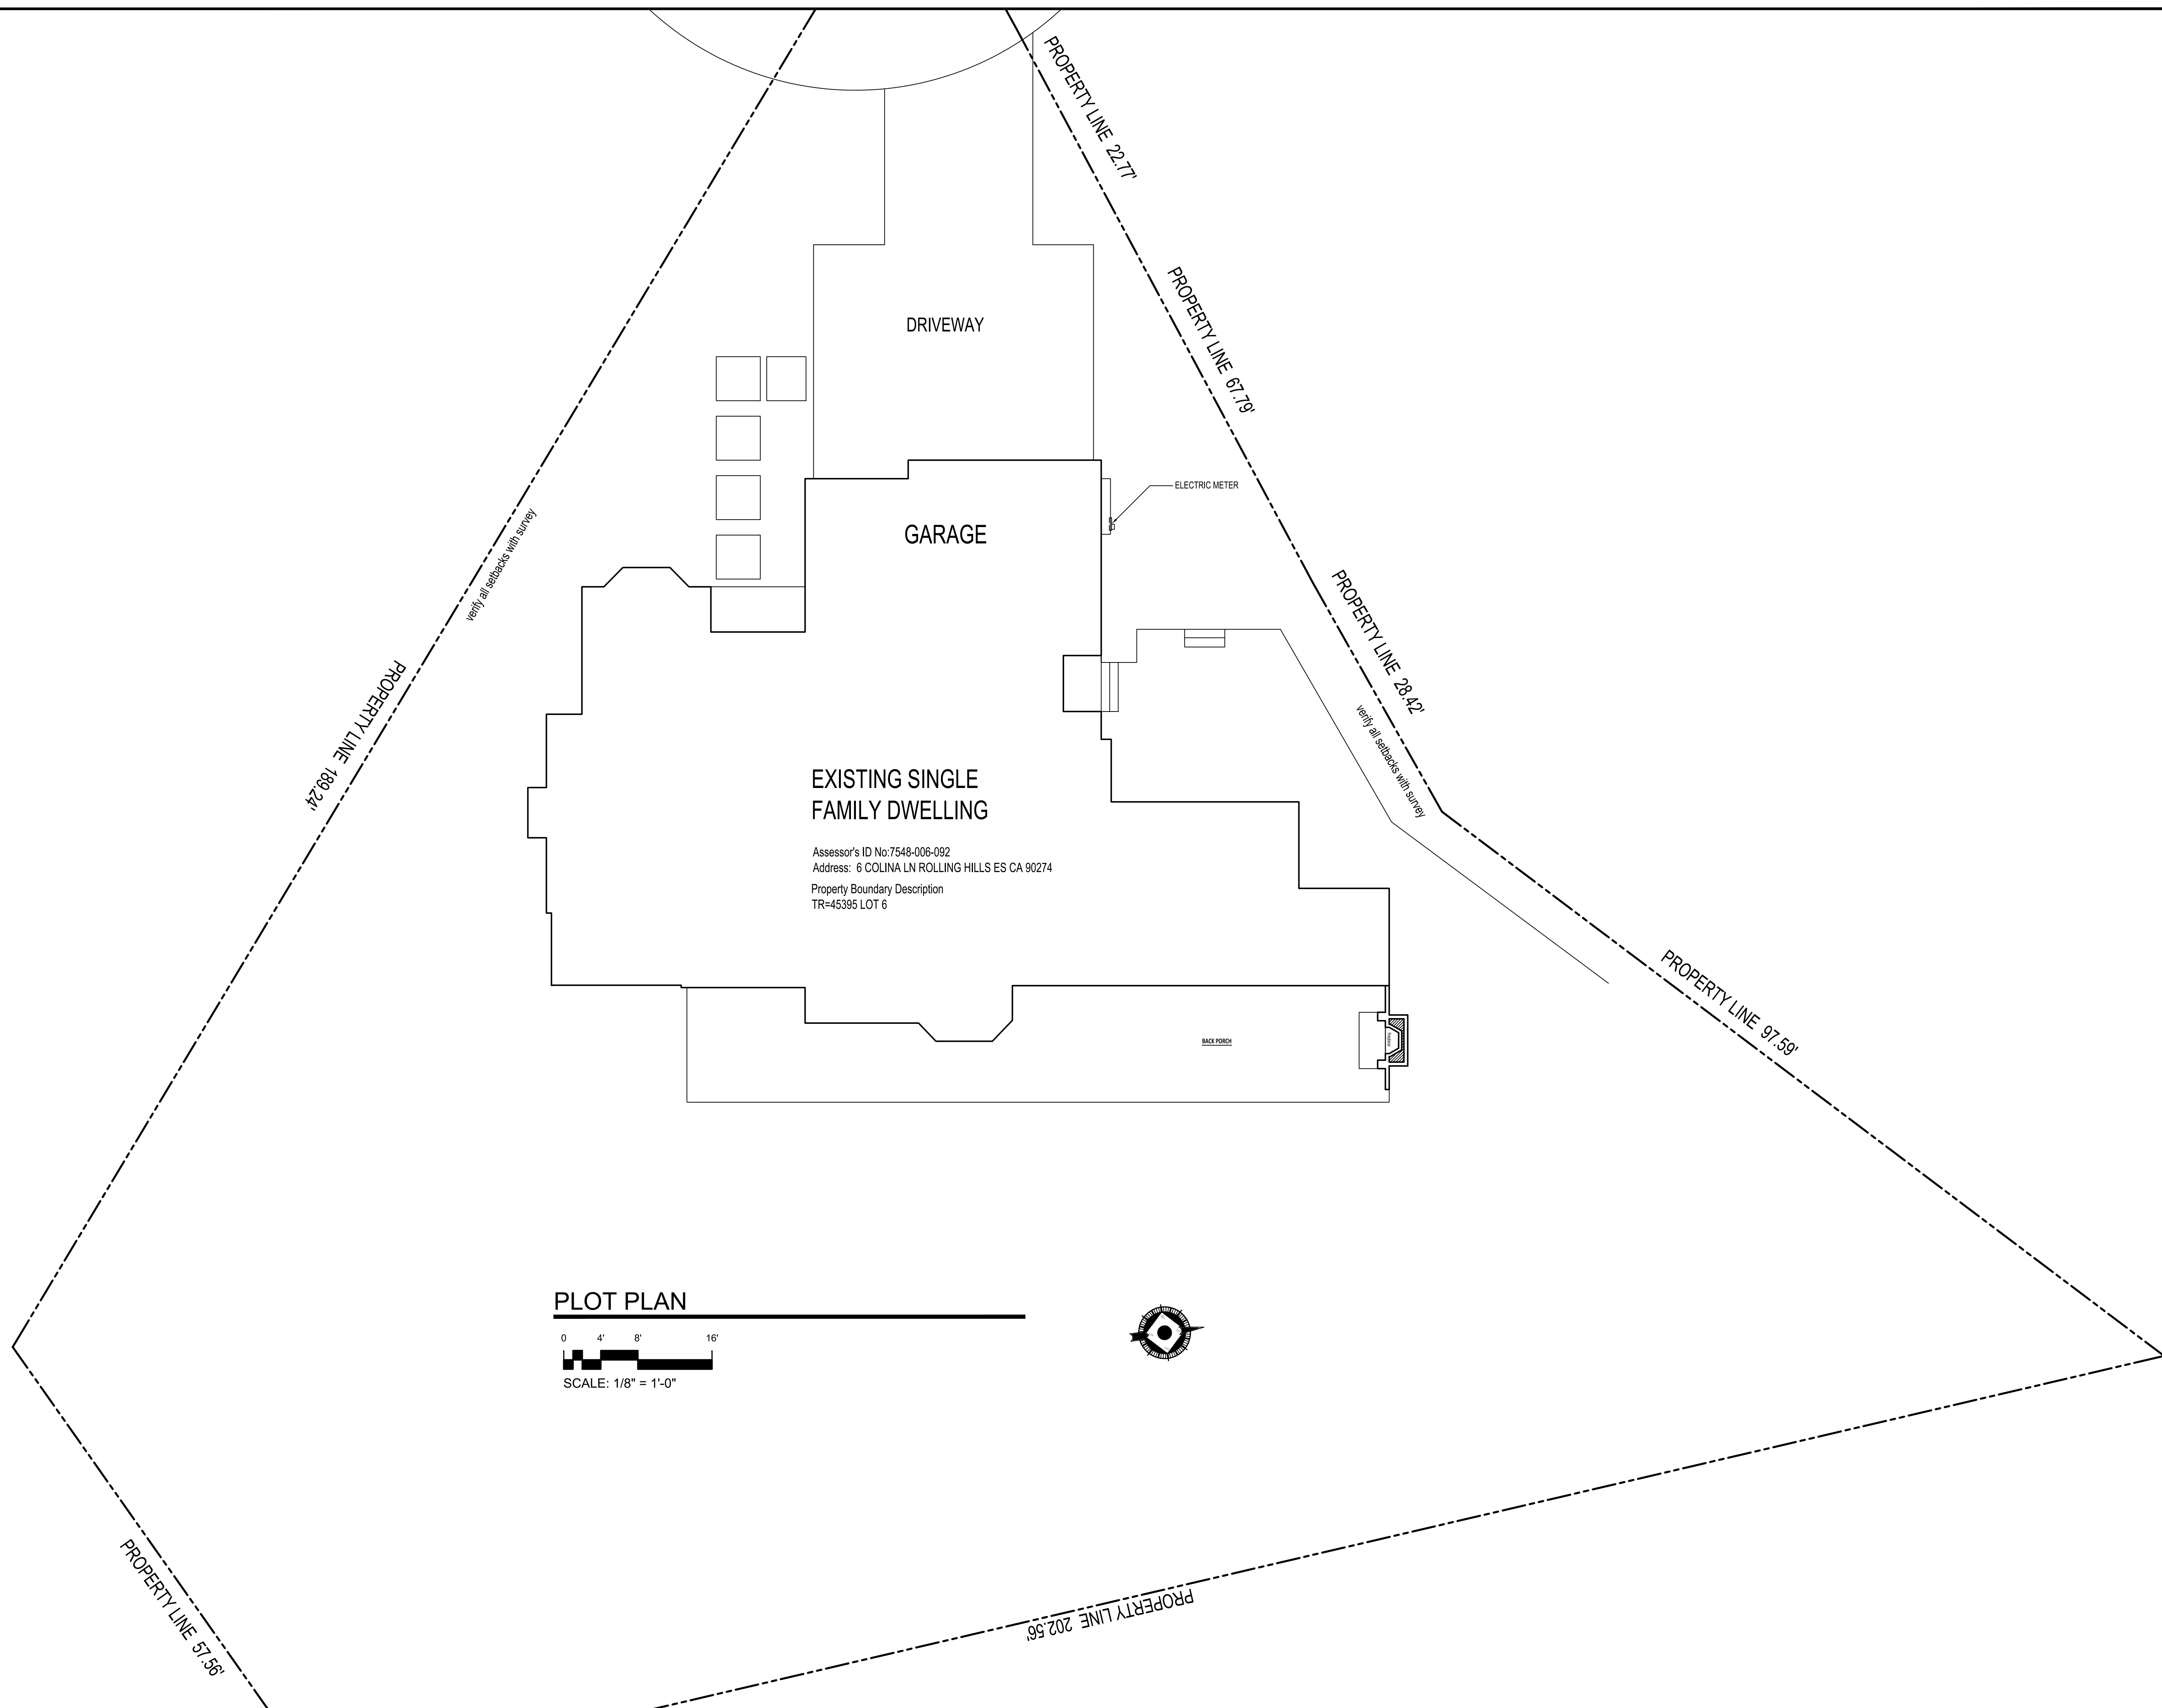



FLOOR PLAN

Sheet content :

Project :
6 COLINA LN
ROLLING HILLS ES CA 90274

Owner:

Date

Scale

Drawn


Job

Sheet

A-2

08.28.13

WINDOW SCHEDULE					
MARK	SIZE		TYPE	Head Height	NOTES
	Width	HEIGHT			
1	1'-10"	4'-10"	FIXED	6'-8"	---
2	1'-10"	4'-10"	FIXED	6'-8"	---
3	2'-0"	4'-10"	CASEMENT	6'-8"	---
4	2'-0"	4'-10"	CASEMENT	6'-8"	---
5	10"	7'-5"	FIXED	8'-0"	---
6	10"	7'-5"	FIXED	8'-0"	---
7	4'-7"	3'-9"	DOUBLE CASEMENT	6'-8"	---
8	5'-10"	4'-9"	XOX CASEMENT	8'-0"	---
9	2'-0"	4'-9"	CASEMENT	7'-10"	---
10	2'-0"	4'-9"	CASEMENT	7'-10"	---
11	5'-10"	4'-9"	XOX CASEMENT	8'-0"	---
12	1'-10"	4'-7"	CASEMENT	6'-7"	W/ 22" high transom above
13	1'-6"	4'-9"	FIXED	6'-7"	W/ 22" high transom above
14	1'-6"	4'-9"	FIXED	6'-7"	W/ 22" high transom above
15	1'-6"	4'-9"	FIXED	6'-7"	W/ 22" high transom above
16	4'-1"	3'-3"	XOX CASEMENT	6'-8"	---
17	3'-0"	6'-7"	FIXED	6'-7"	---
18	3'-0"	6'-7"	FIXED	6'-7"	---
19	2'-9"	3'-9"	DOUBLE CASEMENT	6'-11"	W/ 22" high transom above
20	2'-9"	3'-9"	DOUBLE CASEMENT	6'-11"	W/ 22" high transom above
21	4'-0"	4'-0"	DOUBLE CASEMENT	6'-11"	---
22	3'-2"	3'-3"	DOUBLE CASEMENT	15'-0"	---
23	4'-1"	3'-0"	DOUBLE CASEMENT	6'-10"	---
24	4'-7"	3'-10"	DOUBLE CASEMENT	7'-2"	---
25	4'-7"	3'-10"	DOUBLE CASEMENT	7'-1"	---
26	2'-0"	3'-10"	CASEMENT	7'-0"	---
27	2'-0"	3'-10"	CASEMENT	7'-0"	---
28	1'-10"	4'-3"	CASEMENT	6'-8"	---
29	1'-6"	4'-3"	FIXED	6'-8"	---
30	1'-6"	4'-3"	FIXED	6'-8"	---
31	1'-6"	4'-3"	FIXED	6'-8"	---
32	1'-10"	4'-3"	CASEMENT	6'-8"	---
33	1'-6"	3'-9"	CASEMENT	6'-6"	---
34	1'-6"	3'-9"	FIXED	6'-6"	---
35	1'-6"	3'-9"	CASEMENT	6'-6"	---
36	1'-11"	2'-3"	CASEMENT	7'-2"	---
37	1'-10"	4'-7"	CASEMENT	6'-7"	W/ 22" high transom above

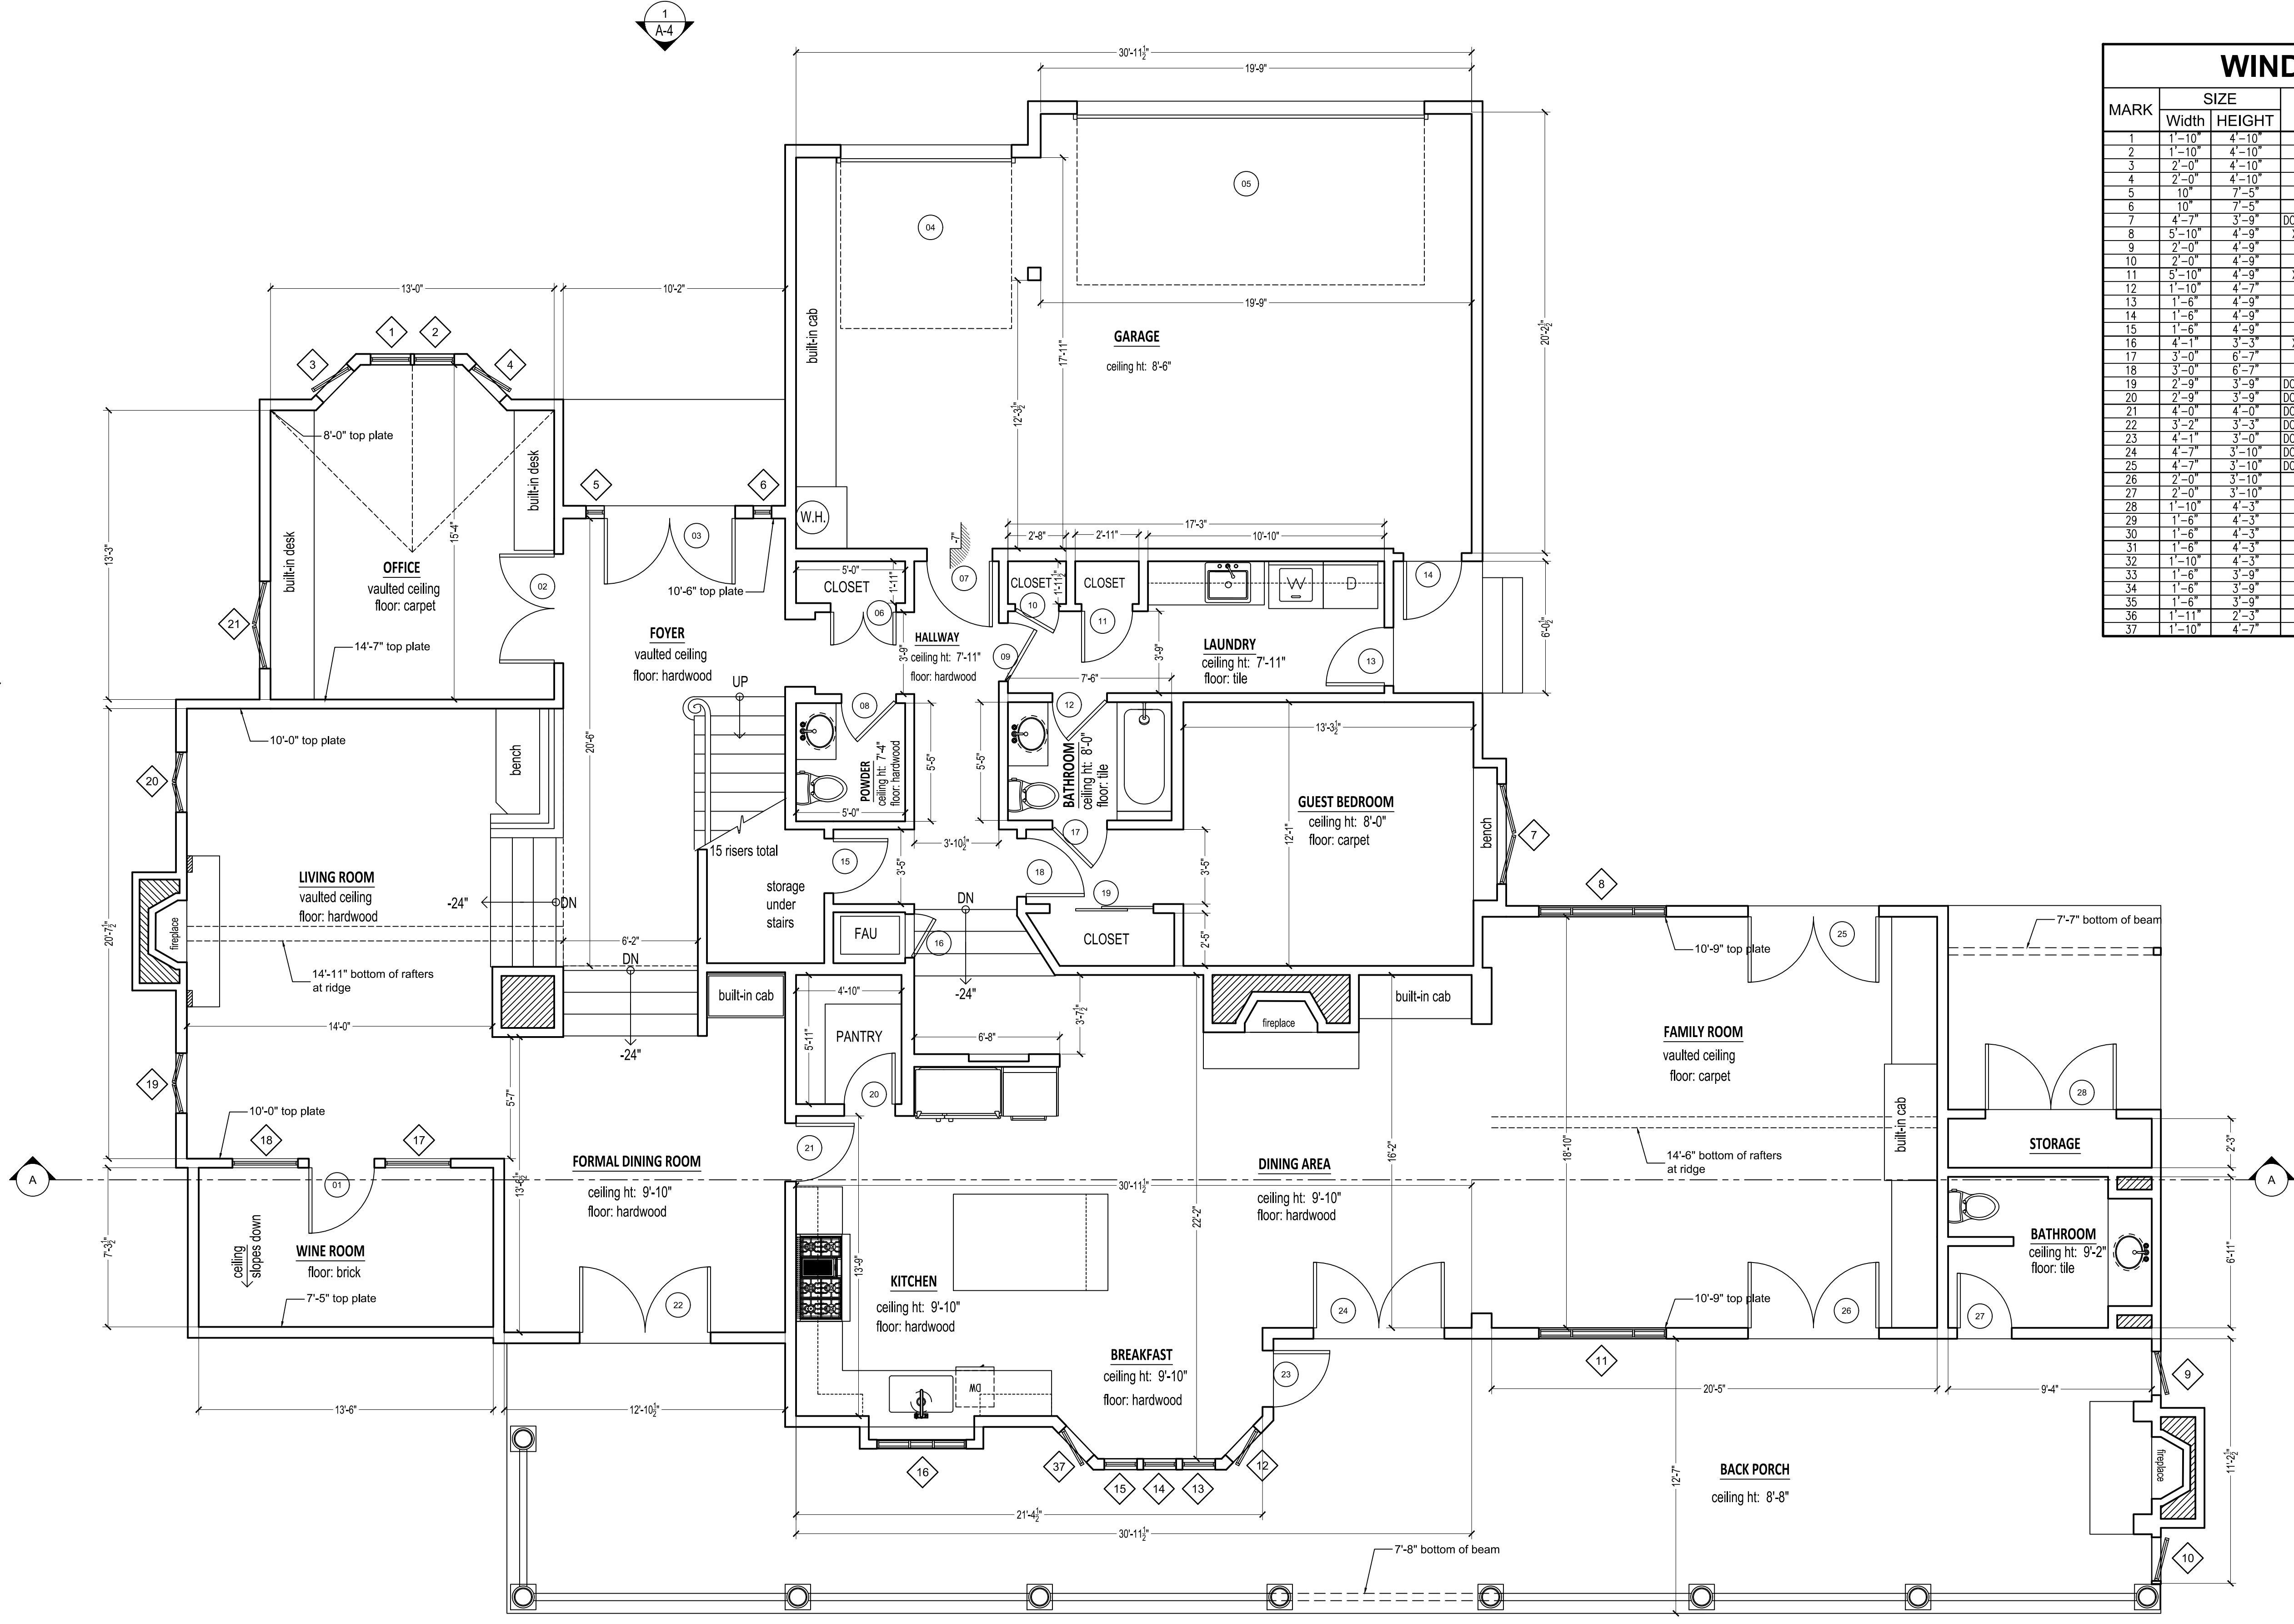

FIRST FLOOR PLAN

0 2' 4' 8'

SCALE: 1/4" = 1'-0"


DOOR SCHEDULE				
MARK	DOOR SIZE		Type	NOTES
	WD	HGT		
1	3'-0"	6'-7"	FRENCH	---
2	5'-0"	6'-8"	FRENCH DOUBLE	---
3	6'-0"	8'-0"	SWING DOUBLE	---
4	7'-10"	7'-7"	GARAGE DOOR	---
5	15'-11"	7'-7"	GARAGE DOOR	---
6	3'-0"	6'-7"	SWING DOUBLE	---
7	3'-0"	6'-8"	SWING	---
8	2'-6"	6'-8"	SWING	---
9	2'-8"	6'-8"	SWING	---
10	2'-0"	6'-8"	SWING	---
11	2'-4"	6'-8"	SWING	---
12	2'-6"	6'-8"	SWING	---
13	2'-8"	6'-8"	SWING	---
14	2'-8"	6'-8"	SWING	---
15	2'-6"	6'-8"	SWING	---
16	2'-0"	6'-8"	SWING	---
17	2'-6"	6'-8"	SWING	---
18	2'-8"	6'-8"	SWING	---
19	4'-9"	6'-8"	SLIDING - DOUBLE	---
20	2'-4"	6'-8"	SWING	---
21	2'-8"	6'-8"	SWING	---
22	6'-0"	8'-1"	SWING DOUBLE	---
23	2'-7"	8'-0"	FRENCH	---
24	6'-0"	8'-0"	FRENCH DOUBLE	---
25	6'-0"	8'-0"	FRENCH DOUBLE	---
26	6'-0"	8'-0"	FRENCH DOUBLE	---
27	2'-6"	6'-9"	SWING	---
28	6'-0"	7'-0"	SWING DOUBLE	---
29	5'-11"	6'-8"	FRENCH DOUBLE	---
30	5'-10"	6'-8"	SLIDING - DOUBLE	---
31	2'-8"	6'-8"	SWING	---
32	2'-8"	6'-8"	SWING	---
33	5'-9"	6'-8"	SLIDING - DOUBLE	---
34	2'-4"	6'-8"	SWING	---
35	2'-6"	6'-8"	SWING	---
36	2'-0"	6'-8"	SWING	---
37	2'-6"	6'-8"	SWING	---
38	5'-0"	6'-8"	SWING DOUBLE	---
39	2'-4"	6'-8"	POCKET	---
40	4'-9"	6'-8"	SLIDING - DOUBLE	---
41	3'-0"	6'-8"	SWING DOUBLE	---
42	2'-6"	6'-8"	SWING	---

AS-BUILT
LOS ANGELES


Sheet content :
SECOND FLOOR PLAN

Project :
**6 COLINA LN
ROLLING HILLS ES CA 90274**


Owner:
Date
Scale
Drawn
Job
Sheet
A-3

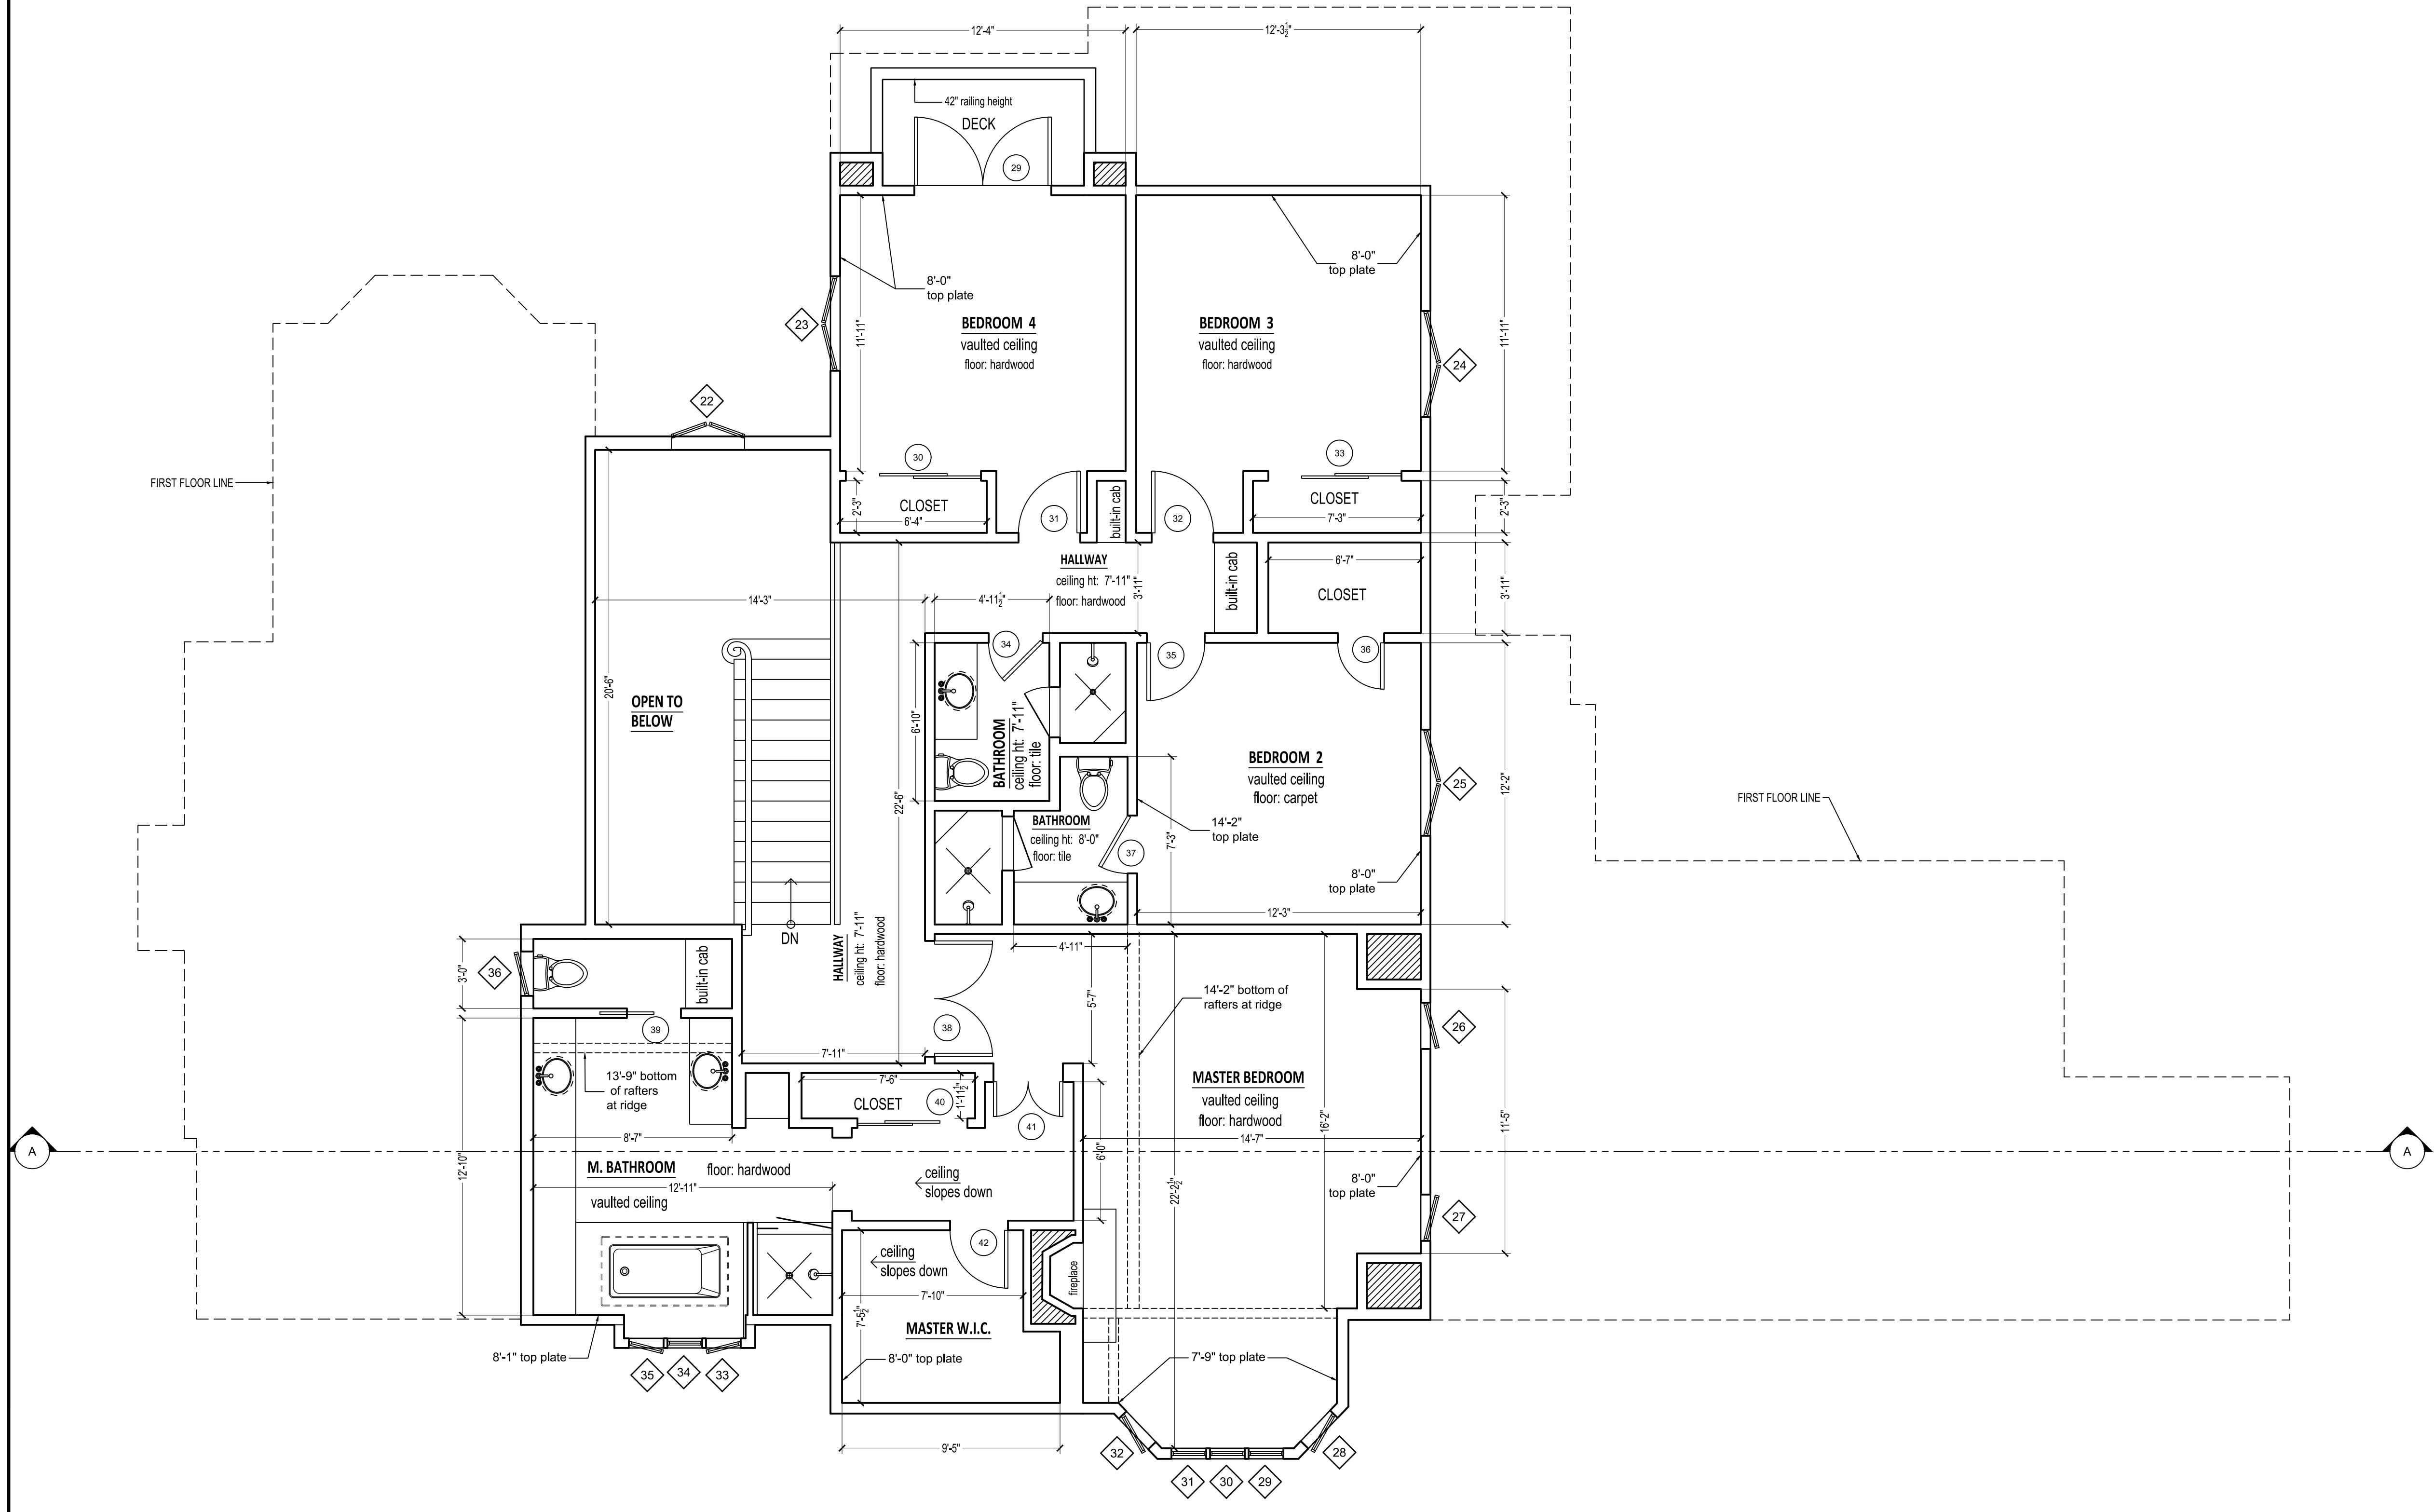


SECOND FLOOR PLAN
0 2' 4' 8'
SCALE: 1/4" = 1'-0"

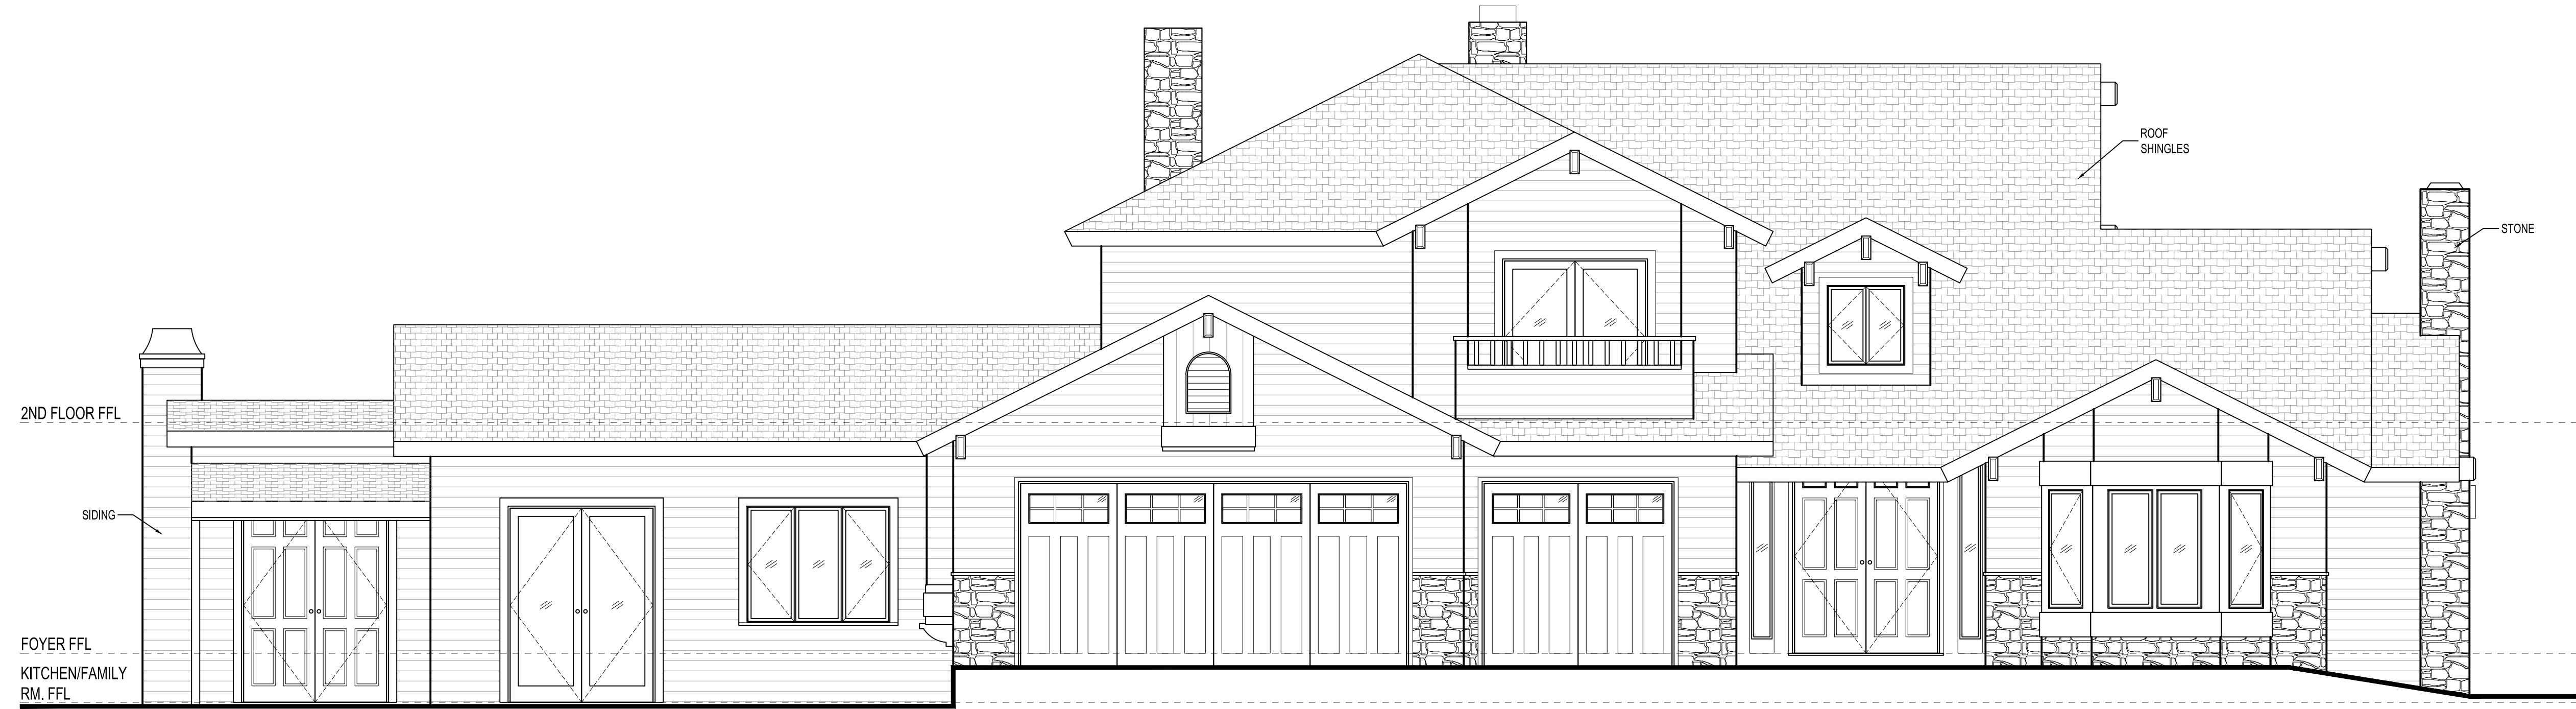

1 W. ELEVATION

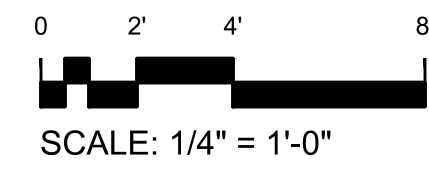


2 N. ELEVATION

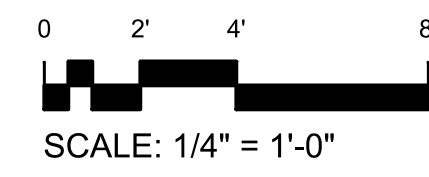



3 **E. ELEVATION**
 0 2' 4' 8'
 SCALE: 1/4" = 1'-0"

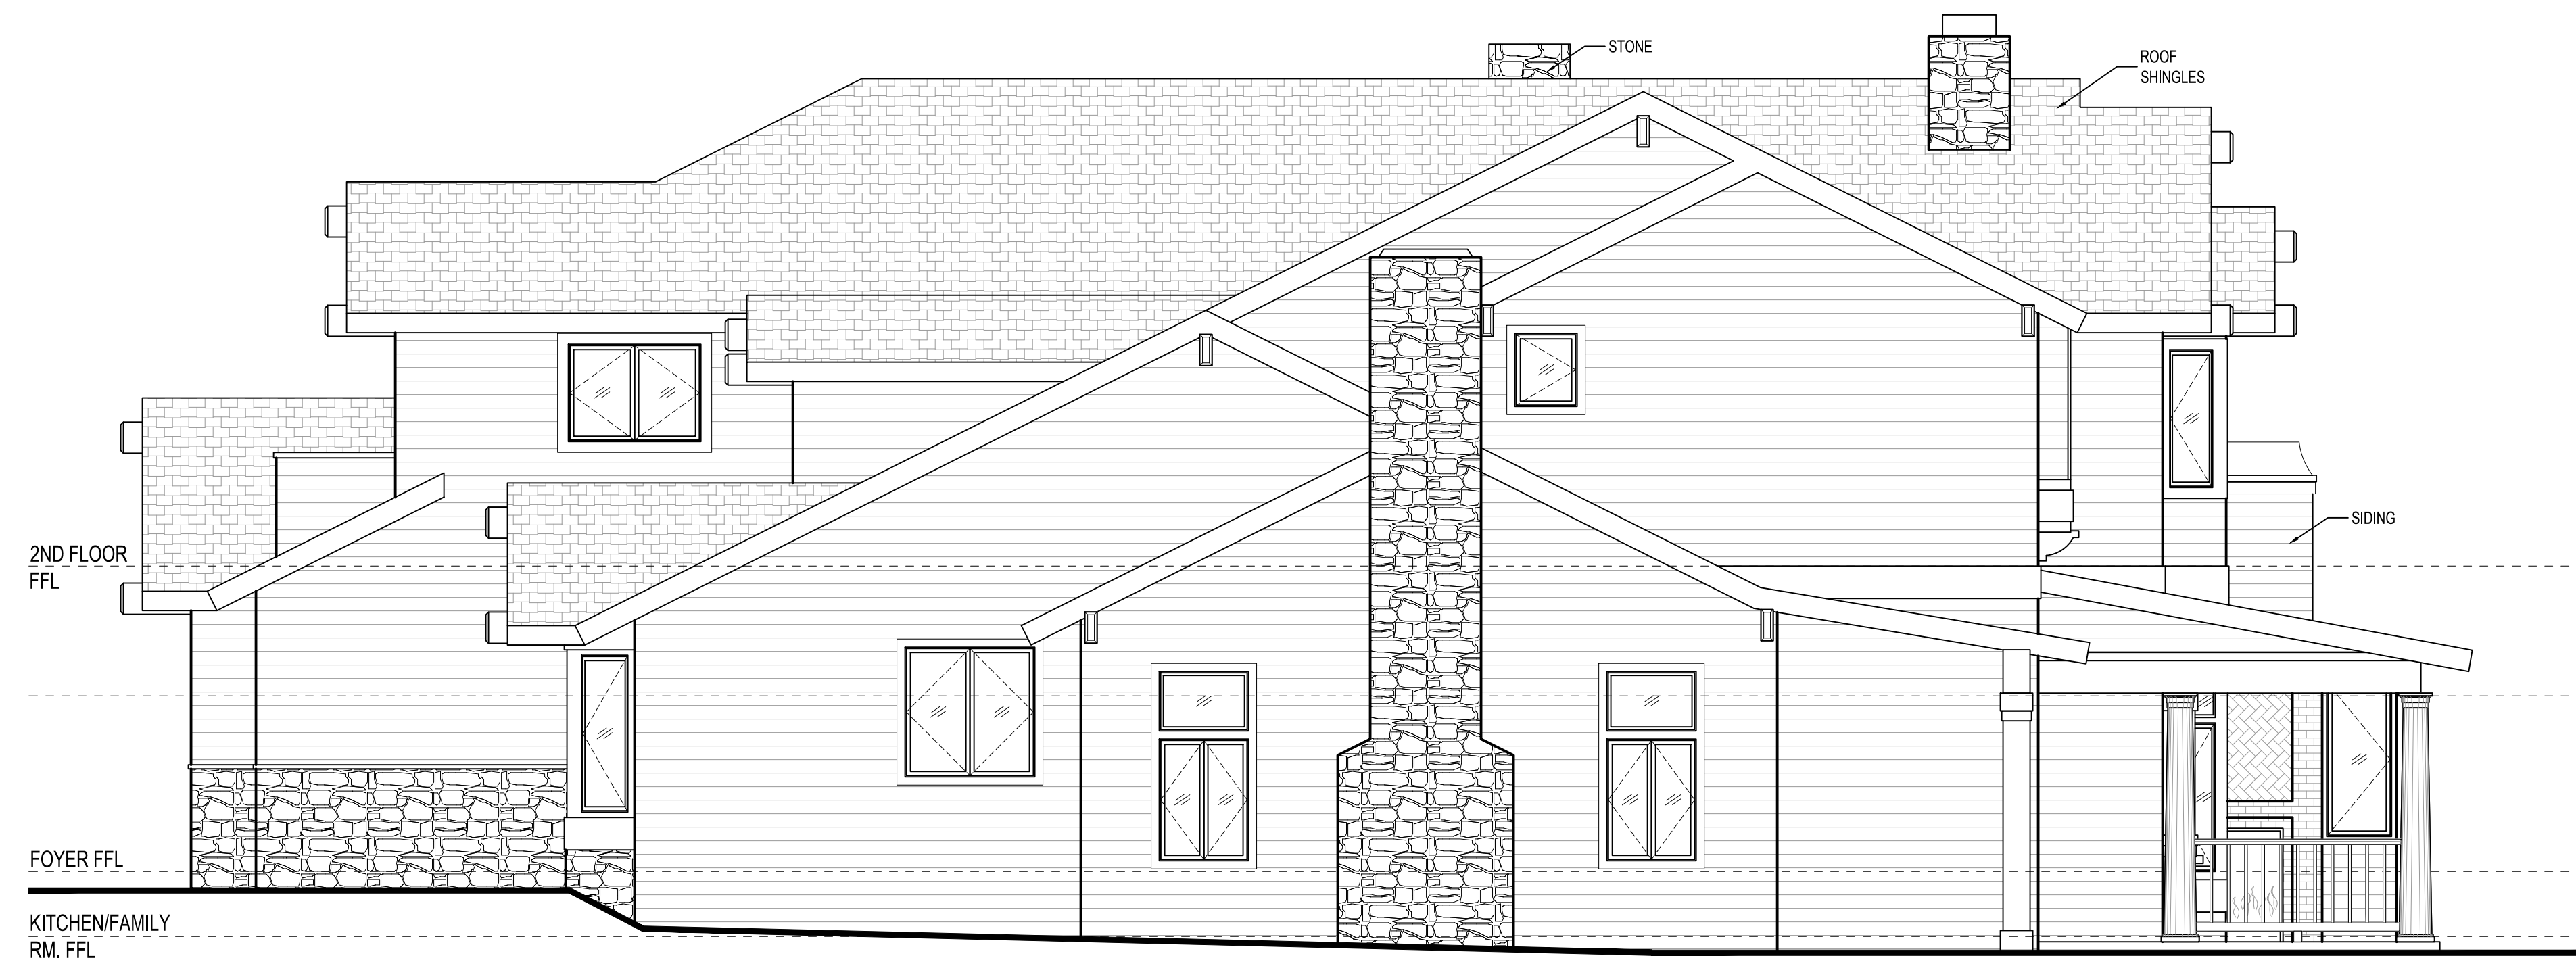

4 **S. ELEVATION**
 0 2' 4' 8'
 SCALE: 1/4" = 1'-0"

Sheet content:
ELEVATIONS

Project:
 6 COLINA LN
 ROLLING HILLS ES CA 90274

Owner:

Date

Scale

Drawn

Job

Sheet

A-5


REVISIONS	BY

AS-BUILT
LOS ANGELES


Sheet content :
BUILDING SECTION

Project :
**6 COLINA LN
ROLLING HILLS ES CA 90274**


Owner:
Date
Scale
Drawn
Job
Sheet
A-6

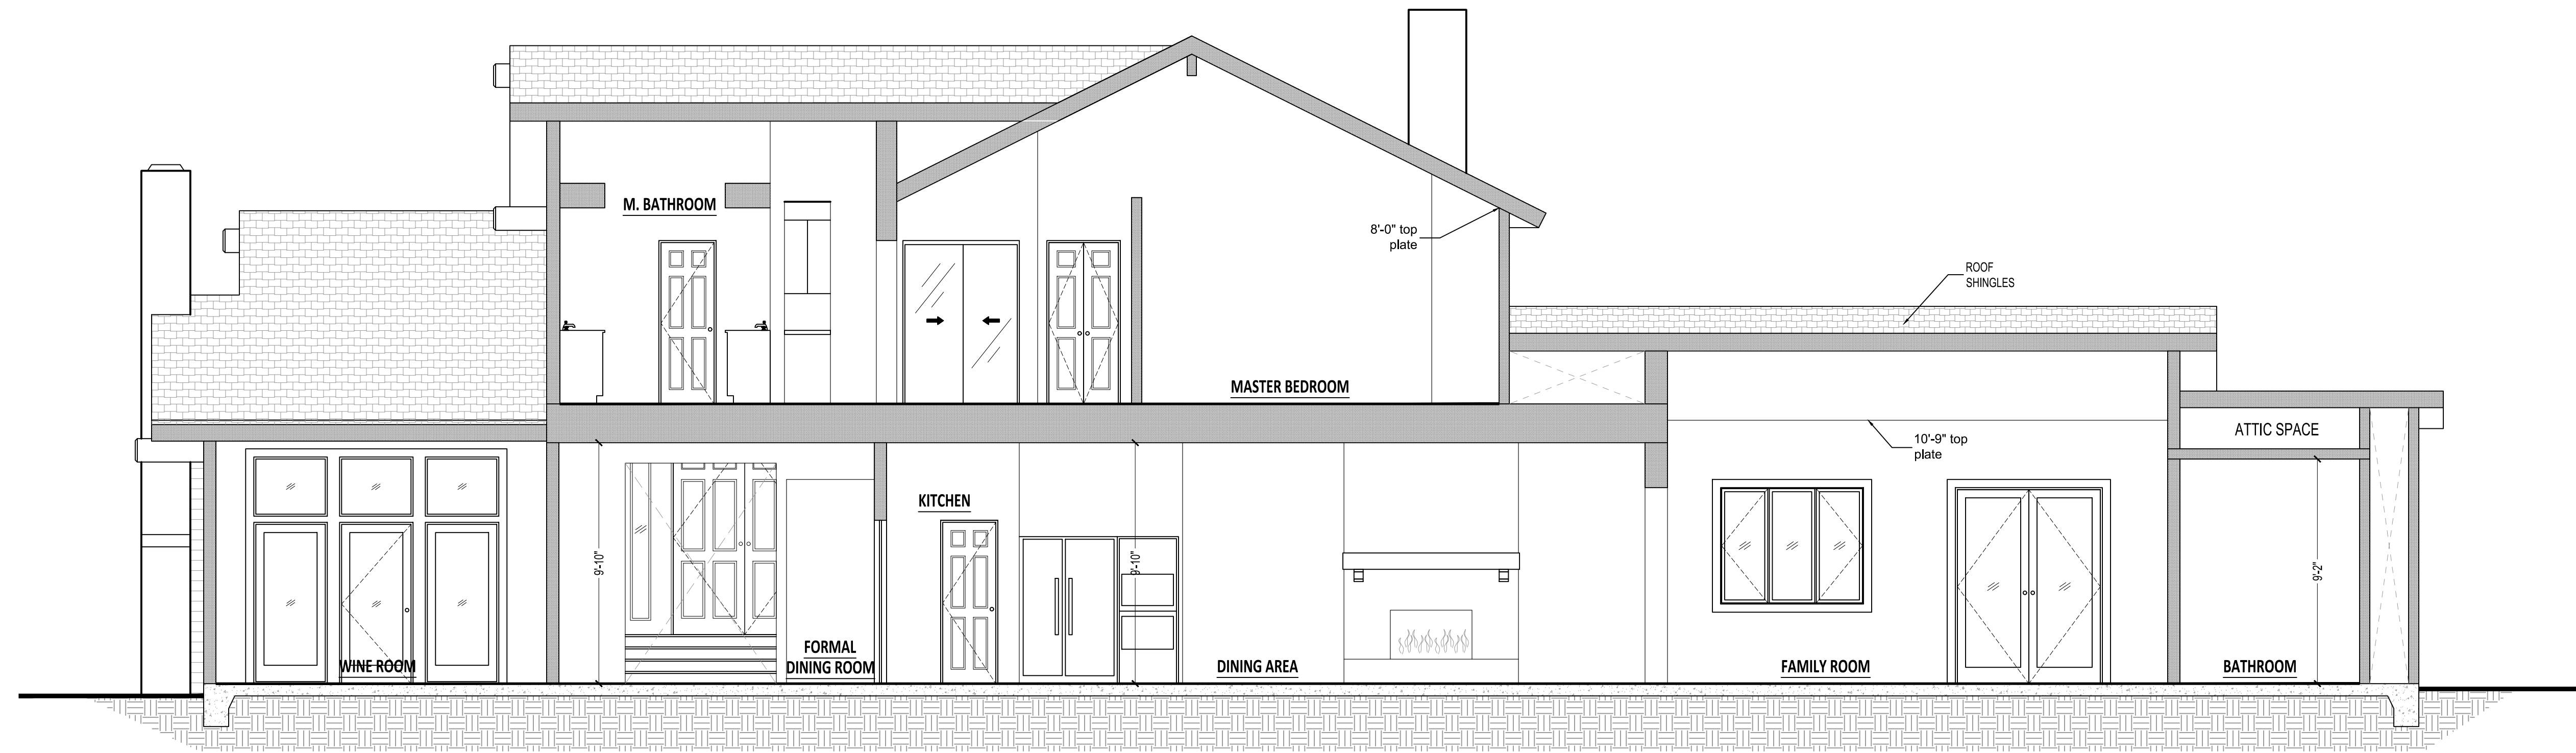

SECTION A-A
0 2' 4' 8'
SCALE: 1/4" = 1'-0"

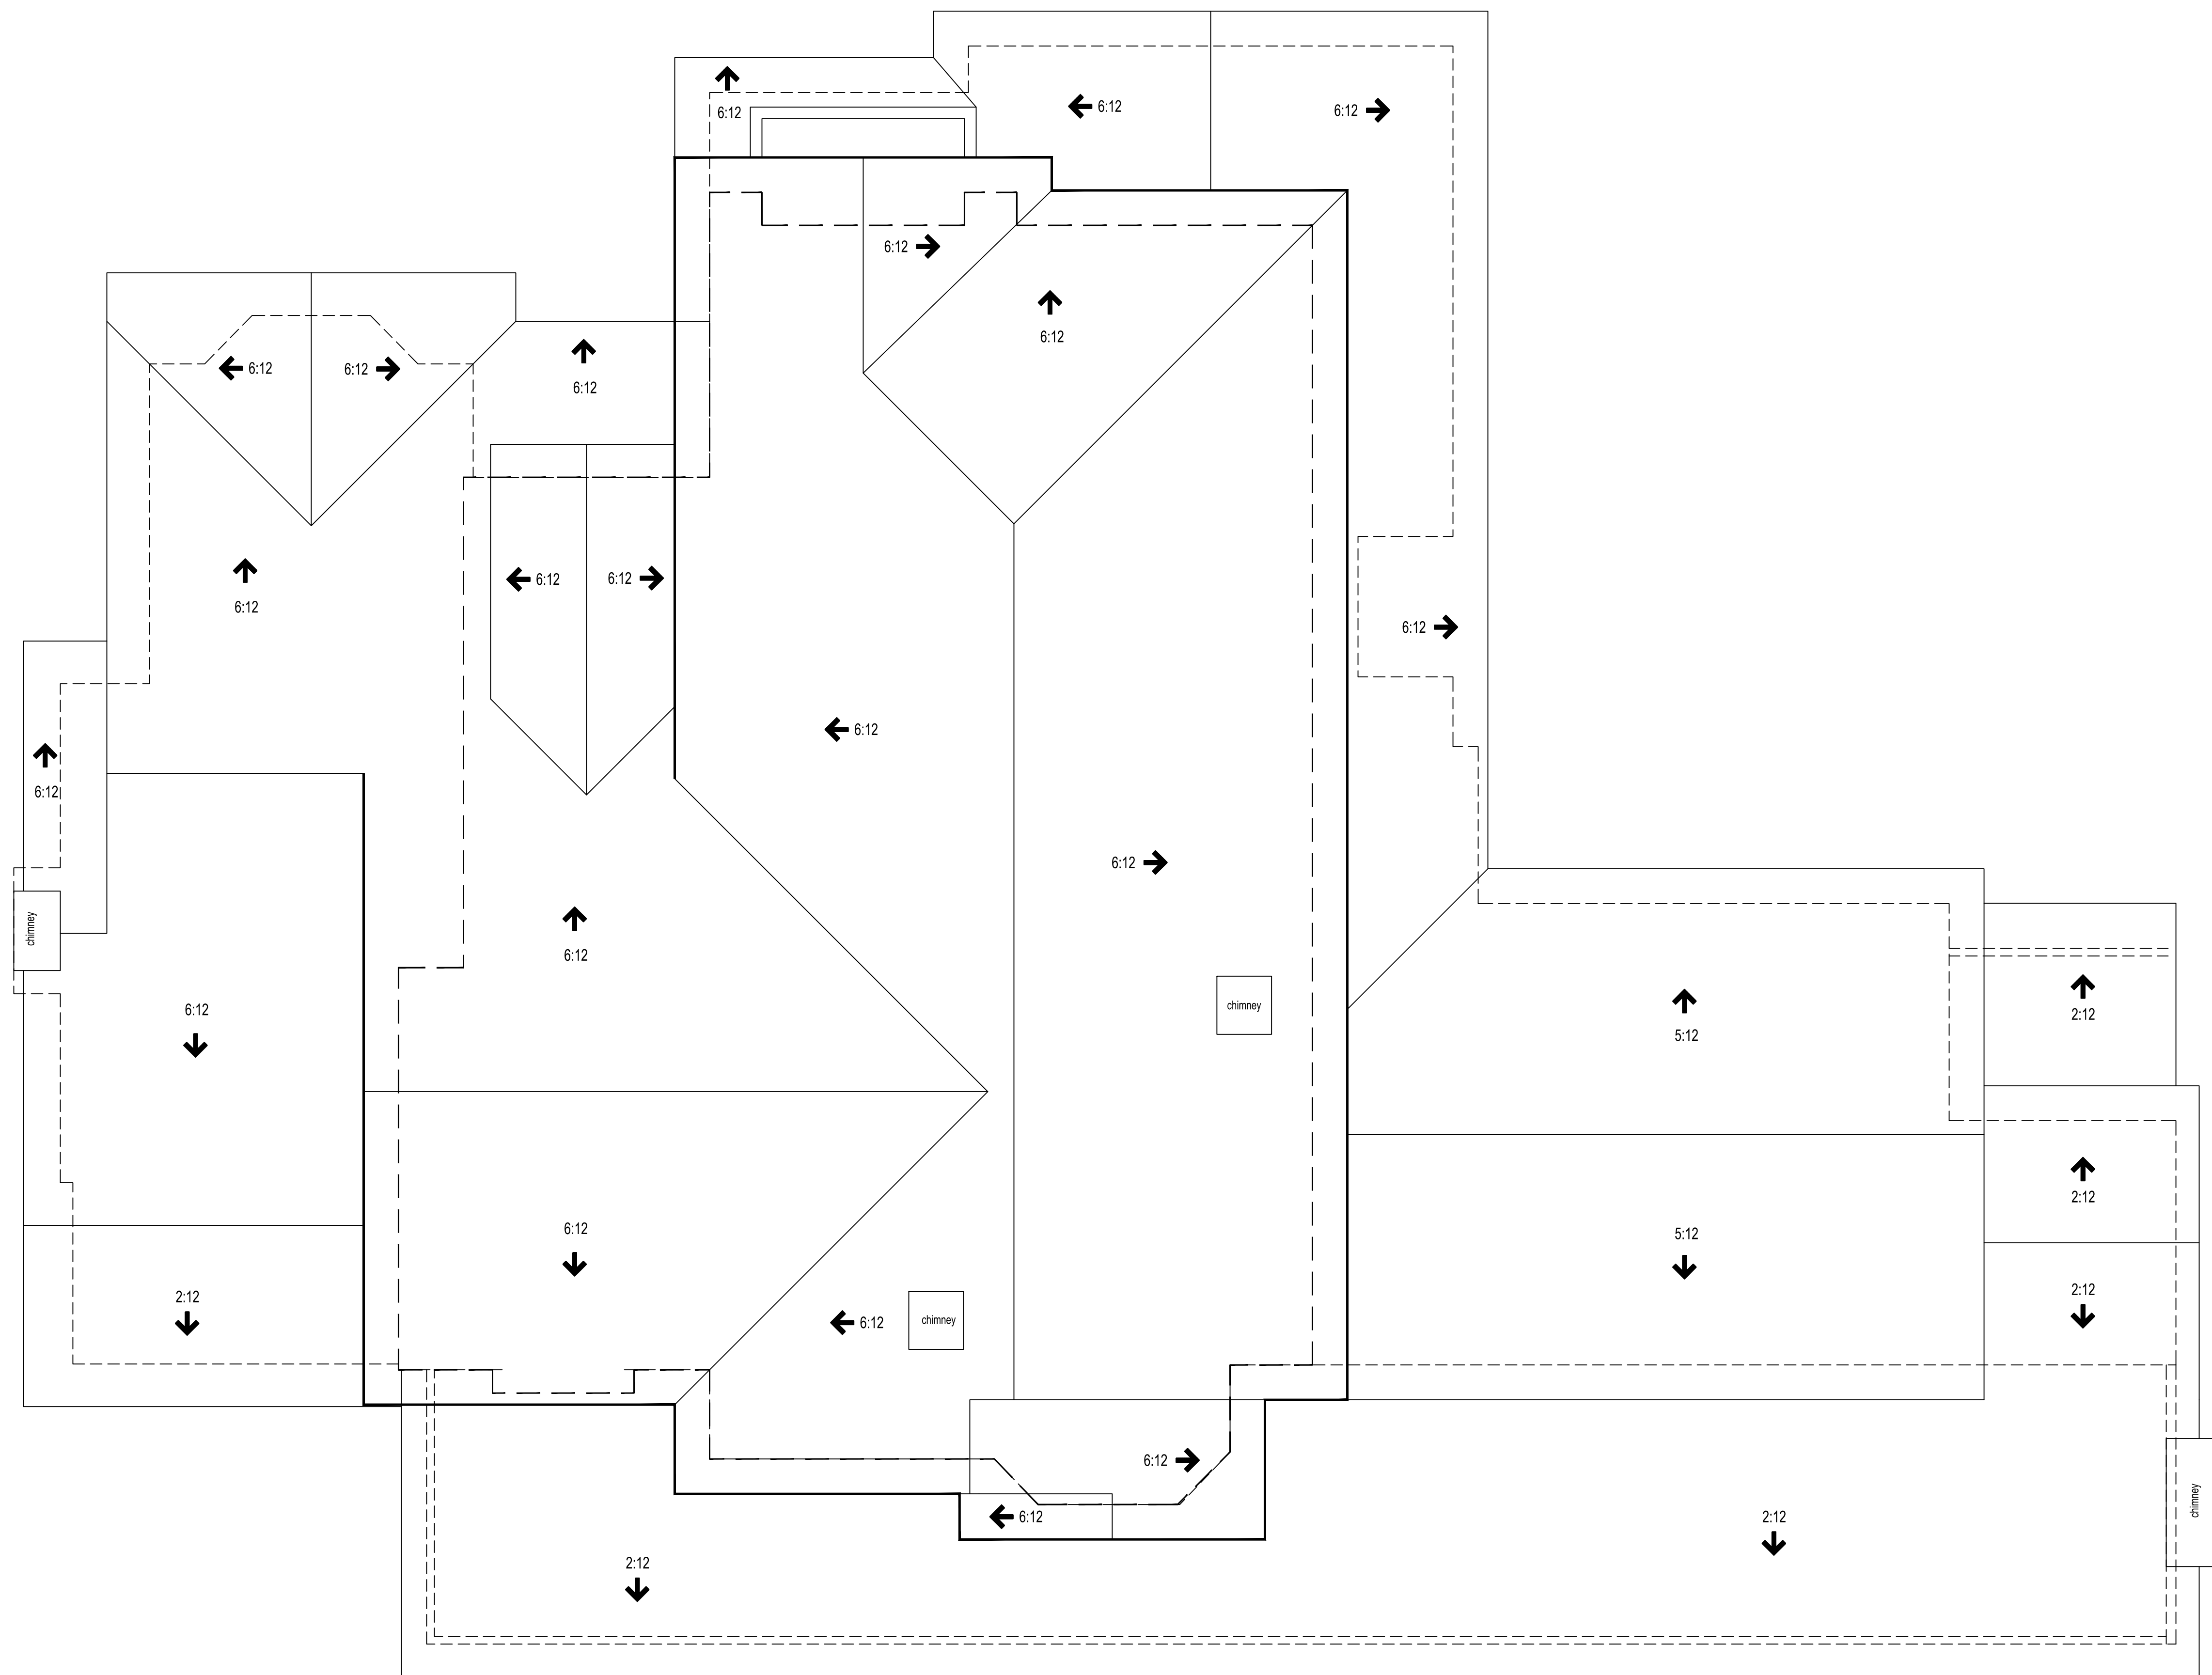

ROOF PLAN

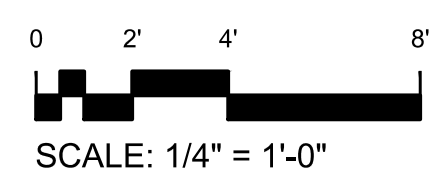

REVISIONS	BY

AS-BUILT
LOS ANGELES

Sheet content :
ROOF PLAN

Project :
6 COLINA LN
ROLLING HILLS ES CA 90274

Owner:

Date

Scale

Drawn

Job


Sheet

A-7

08.28.13

SQUARE FOOTAGE

FIRST FLOOR: 2892 SF
 SECOND FLOOR: 1619 SF
 GARAGE: 635 SF
 TOTAL: 5,146 SF

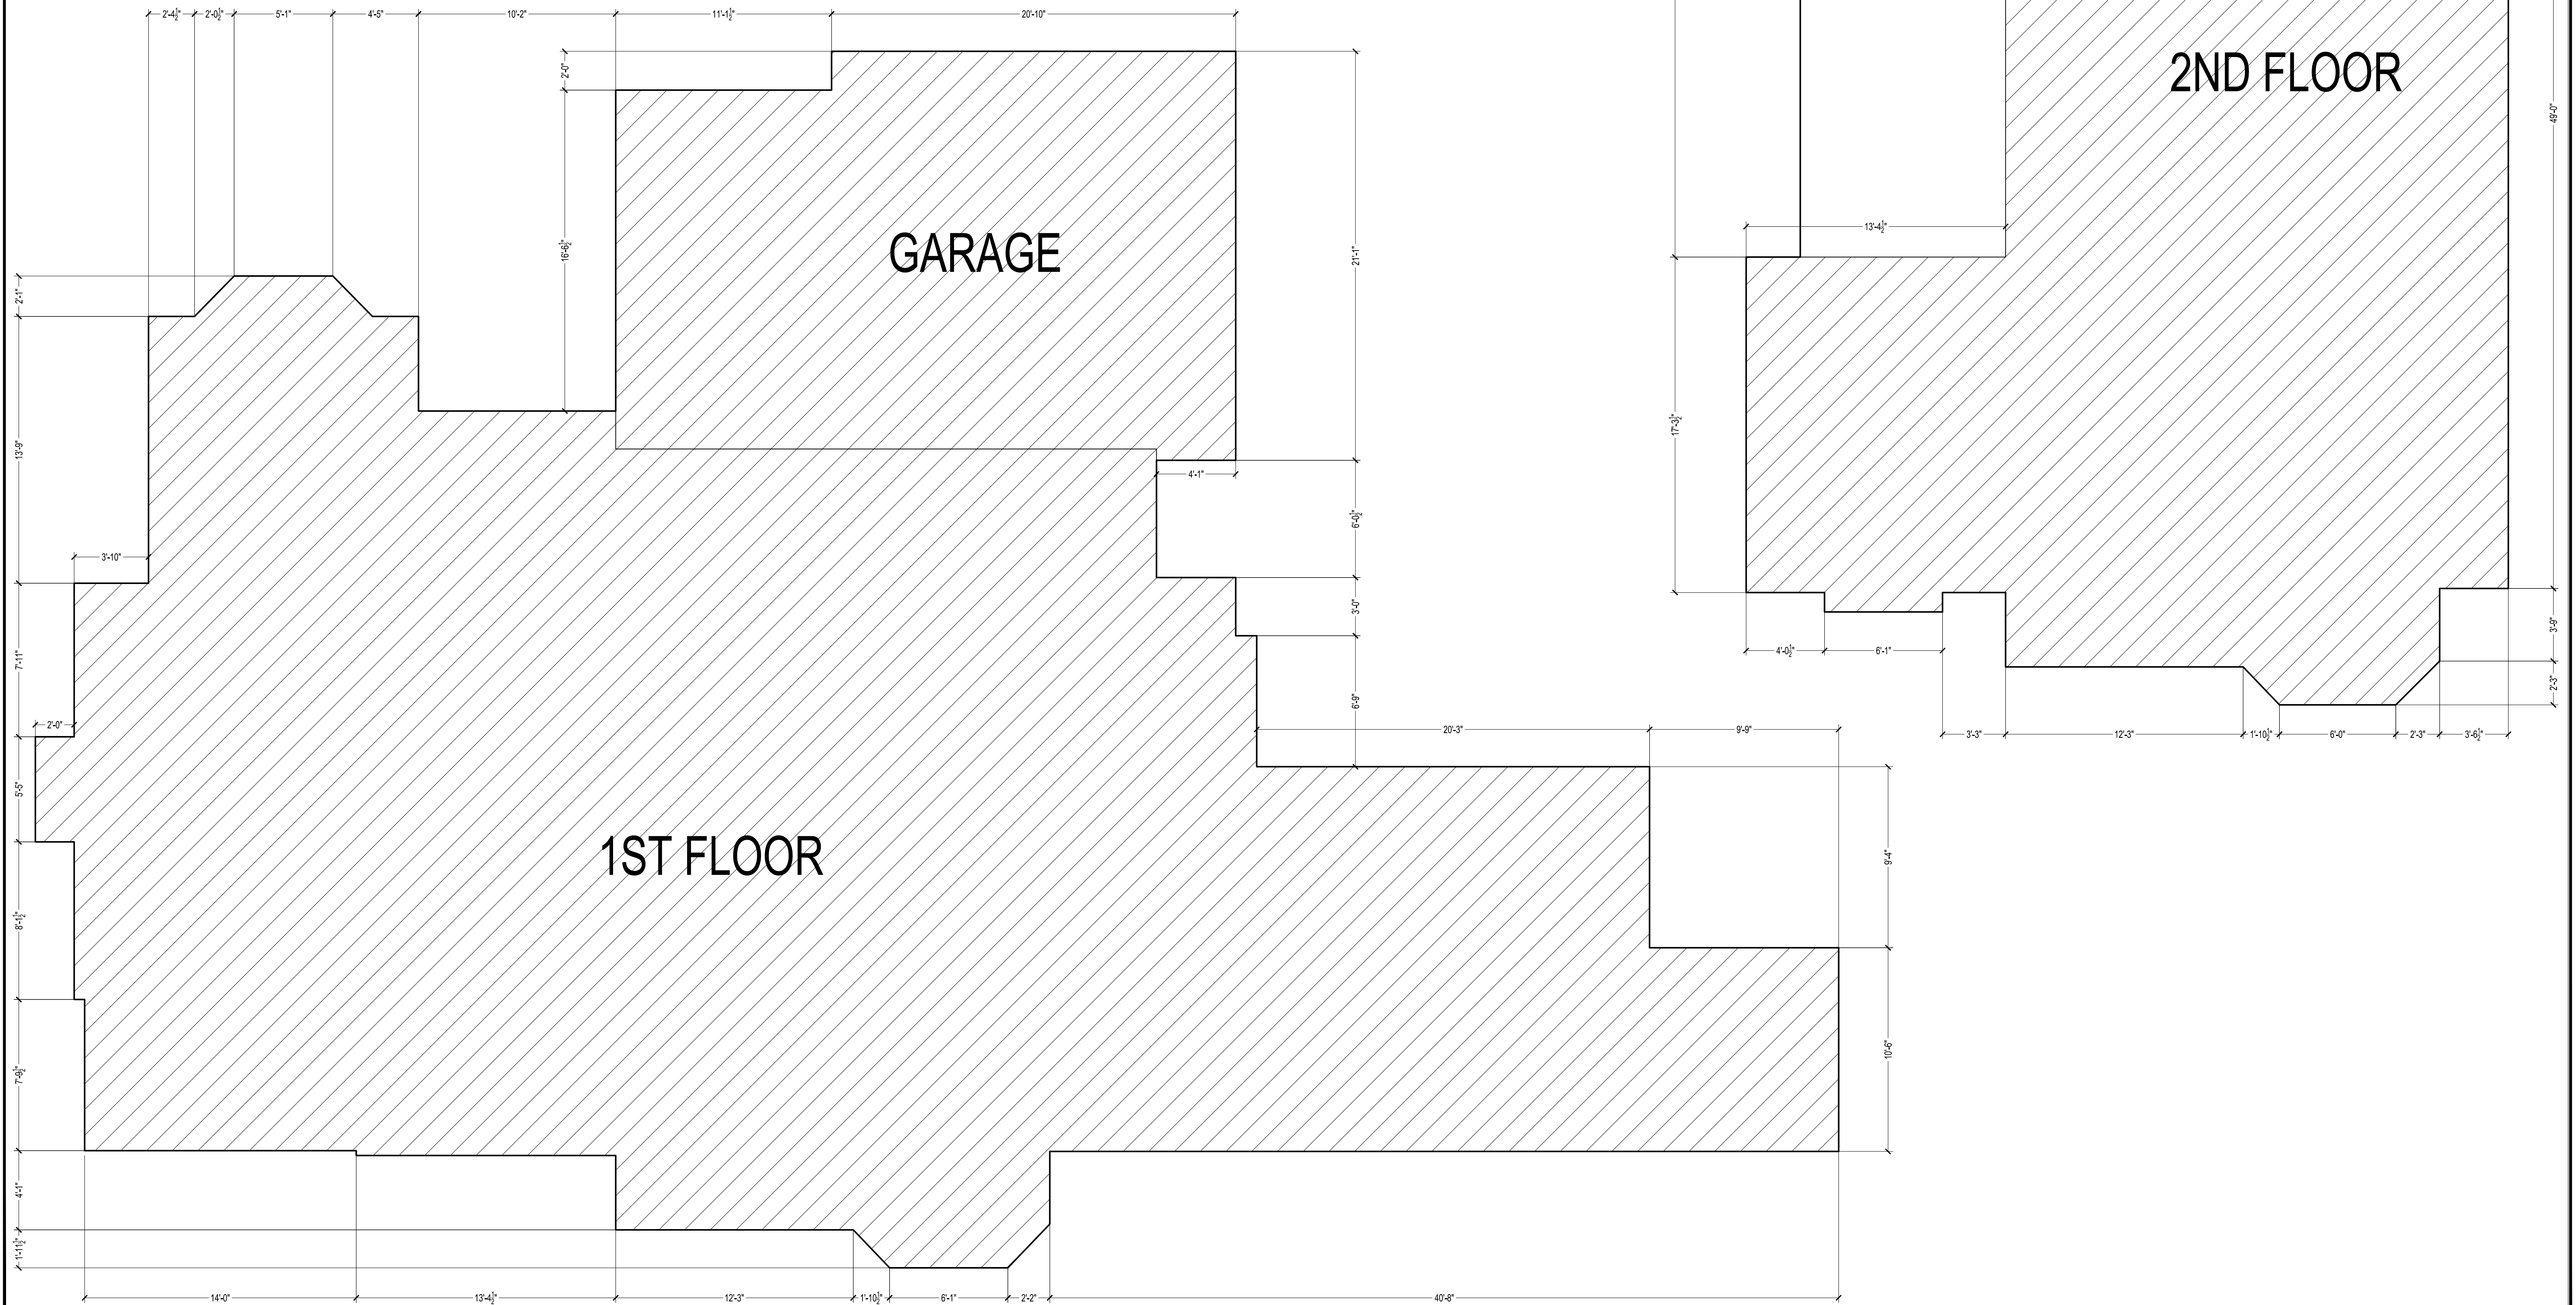

REVISIONS	BY
AS-BUILT LOS ANGELES	
Sheet content : SQUARE FOOTAGE CALCULATION	
Project : 6 COLINA LN ROLLING HILLS ES CA 90274	
Owner:	
Date	
Scale	
Drawn	
Job	
Sheet	A-8