

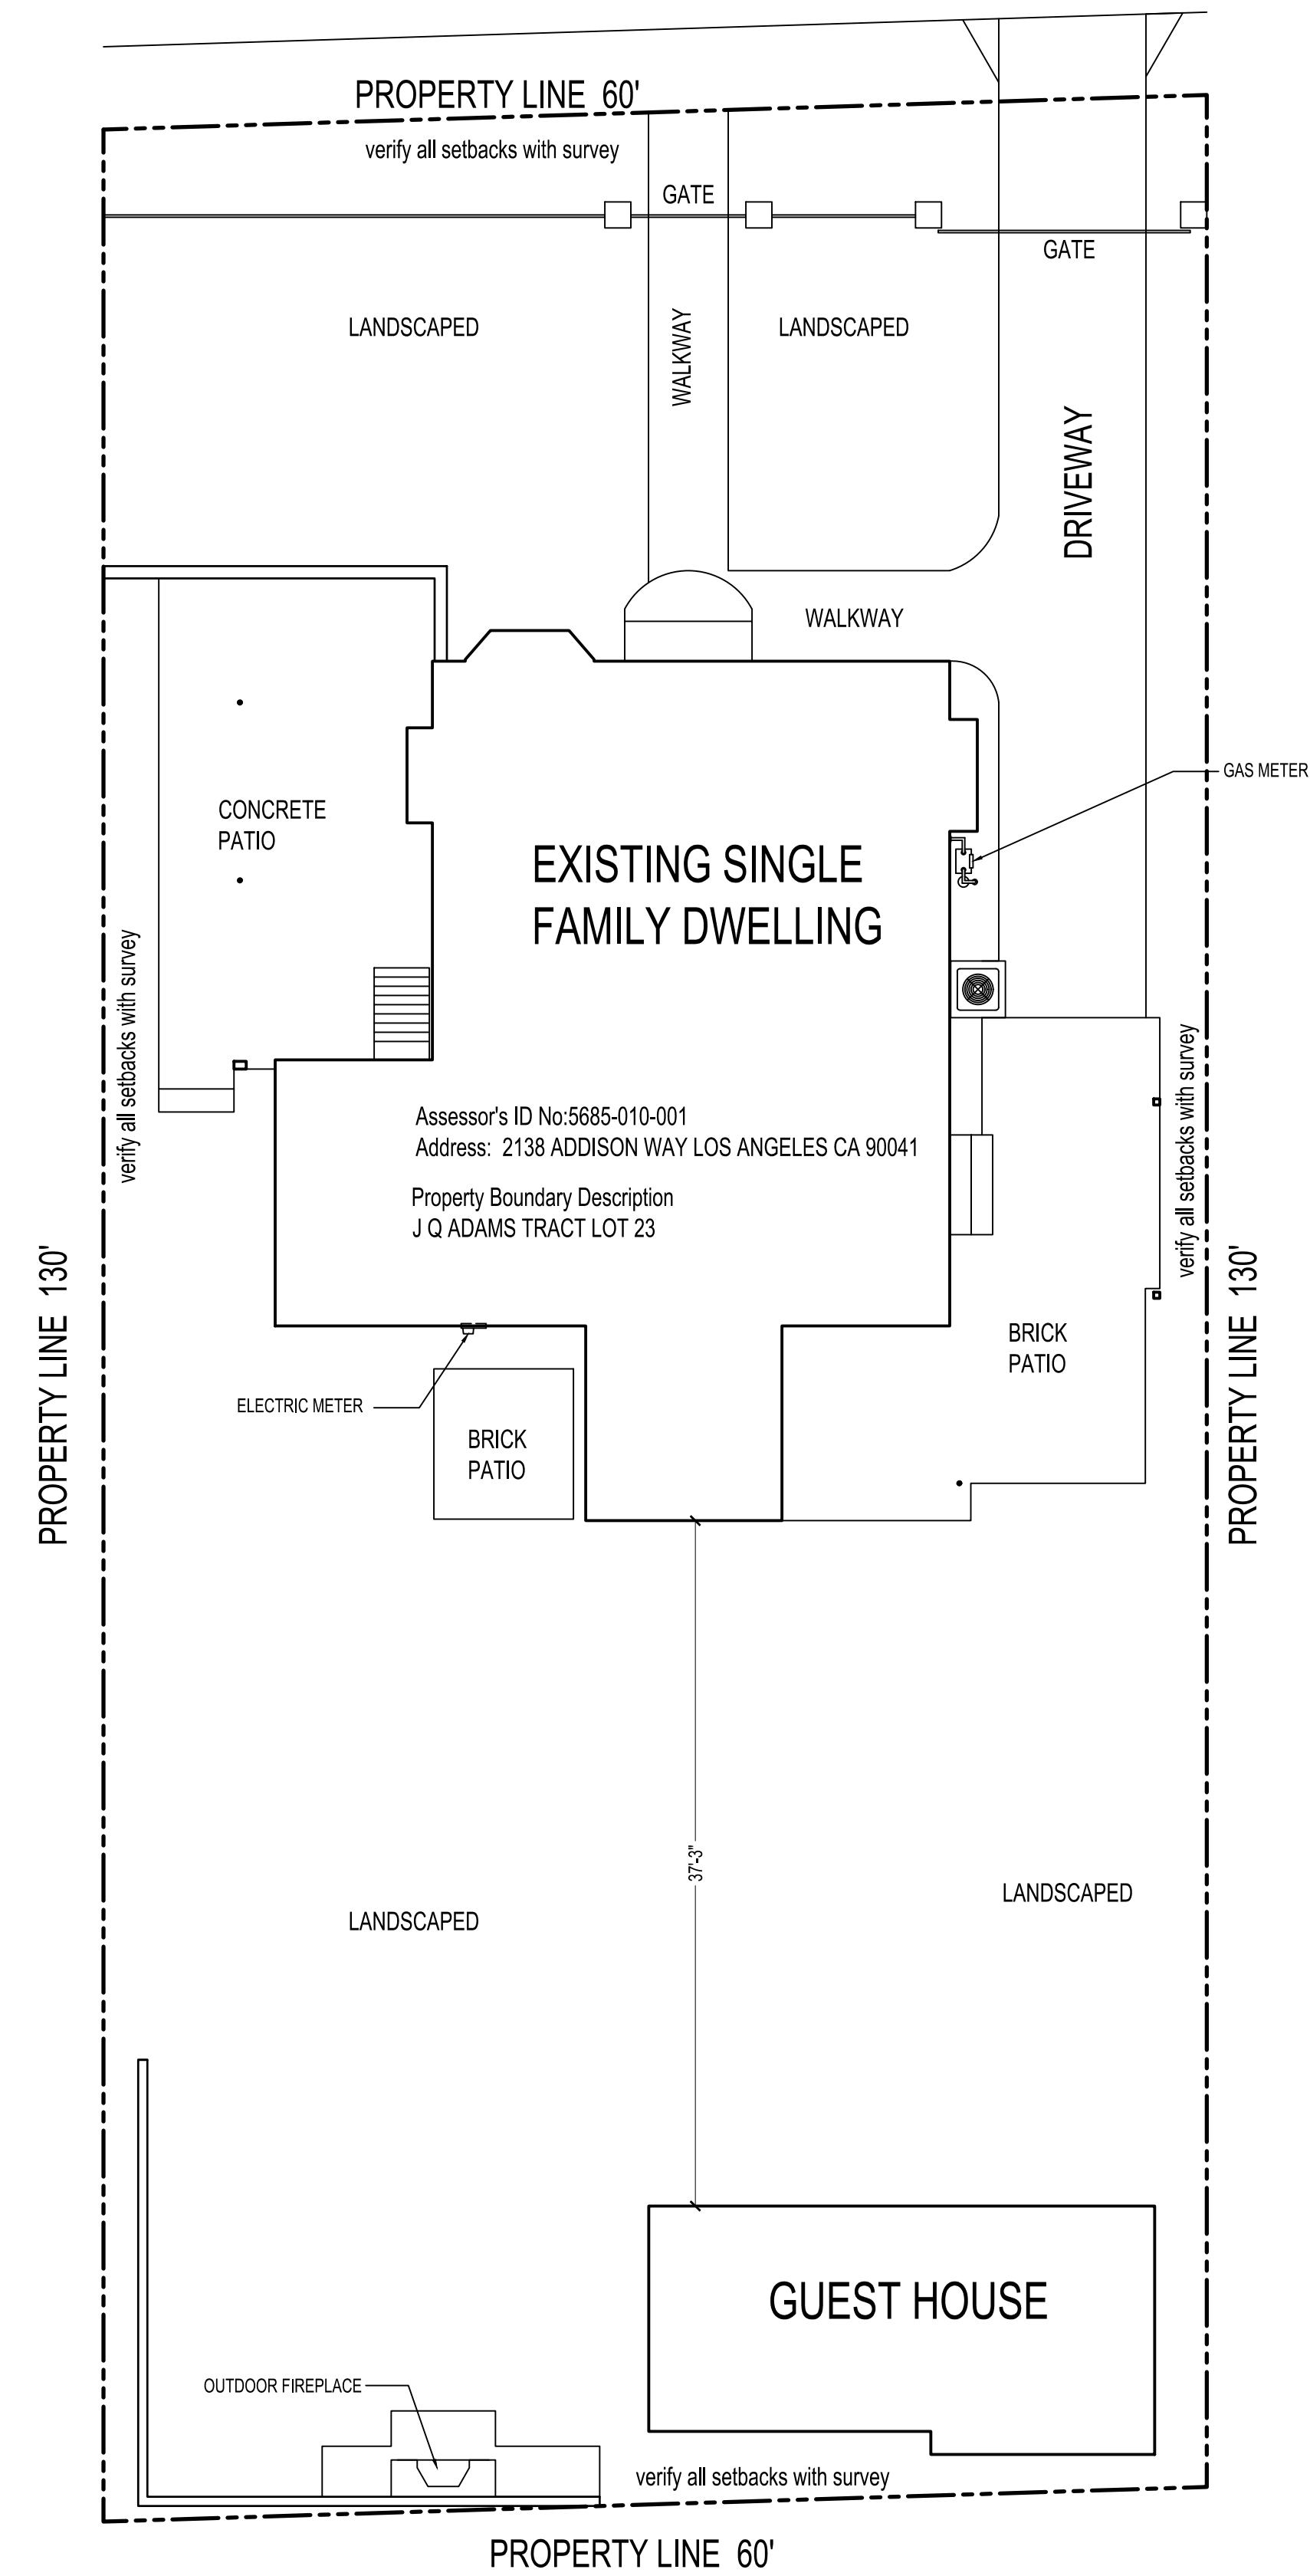


ADDISON WAY

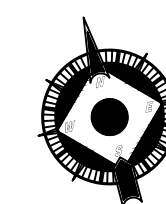

PLOT PLAN

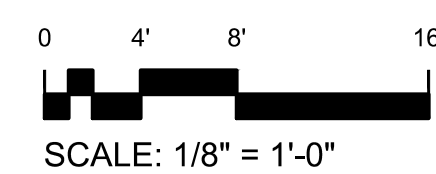

REVISIONS	BY

AS-BUILT
LOS ANGELES

Sheet content :
PLOT PLAN

Project :
2138 ADDISON WAY
LOS ANGELES CA 90041

Owner:

Date

Scale

Drawn

Job

Sheet

A-1

REVISIONS	BY


AS-BUILT
LOS ANGELES

WINDOW SCHEDULE


MARK	SIZE		TYPE	Head Height	NOTES
	Width	HEIGHT			
1	4'-0"	5'-0"	FIXED	6'-8"	---
2	1'-10"	5'-0"	FIXED	6'-8"	---
3	1'-10"	5'-0"	FIXED	6'-8"	---
4	1'-0"	5'-0"	CASEMENT	6'-8"	---
5	1'-0"	5'-0"	CASEMENT	6'-8"	---
6	6'-7"	5'-0"	FIXED	6'-8"	---
7	2'-0"	5'-11"	CASEMENT	6'-8"	---
8	4'-10"	3'-5"	FIXED	6'-8"	---
9	2'-0"	5'-1"	CASEMENT	6'-8"	---
10	5'-11"	2'-10"	SLIDING	6'-8"	---
11	2'-7"	2'-11"	FIXED	6'-8"	---
12	2'-7"	2'-11"	FIXED	6'-8"	---
13	2'-7"	2'-11"	FIXED	6'-8"	---
14	2'-7"	2'-11"	FIXED	6'-8"	---
15	2'-11"	2'-10"	SLIDING	6'-8"	---
16	3'-0"	3'-11"	SINGLE HUNG	6'-8"	---
17	3'-11"	6'-6"	SINGLE HUNG	6'-8"	---
18	3'-11"	6'-6"	SINGLE HUNG	6'-8"	---
19	3'-0"	4'-0"	SINGLE HUNG	6'-8"	---
20	5'-11"	2'-10"	SLIDING	6'-8"	---

DOOR SCHEDULE

MARK	DOOR SIZE		Type	NOTES
	WD	HGT		
1	3'-6"	6'-8"	FRENCH	---
2	2'-6"	6'-8"	FRENCH DOUBLE	---
3	2'-6"	6'-8"	FRENCH DOUBLE	---
4	2'-6"	6'-8"	FRENCH	---
5	2'-6"	6'-8"	FRENCH	---
6	2'-6"	6'-8"	FRENCH	---
7	2'-7"	6'-8"	FRENCH	---
8	2'-6"	6'-8"	FRENCH	---
9	2'-8"	6'-8"	FRENCH	---

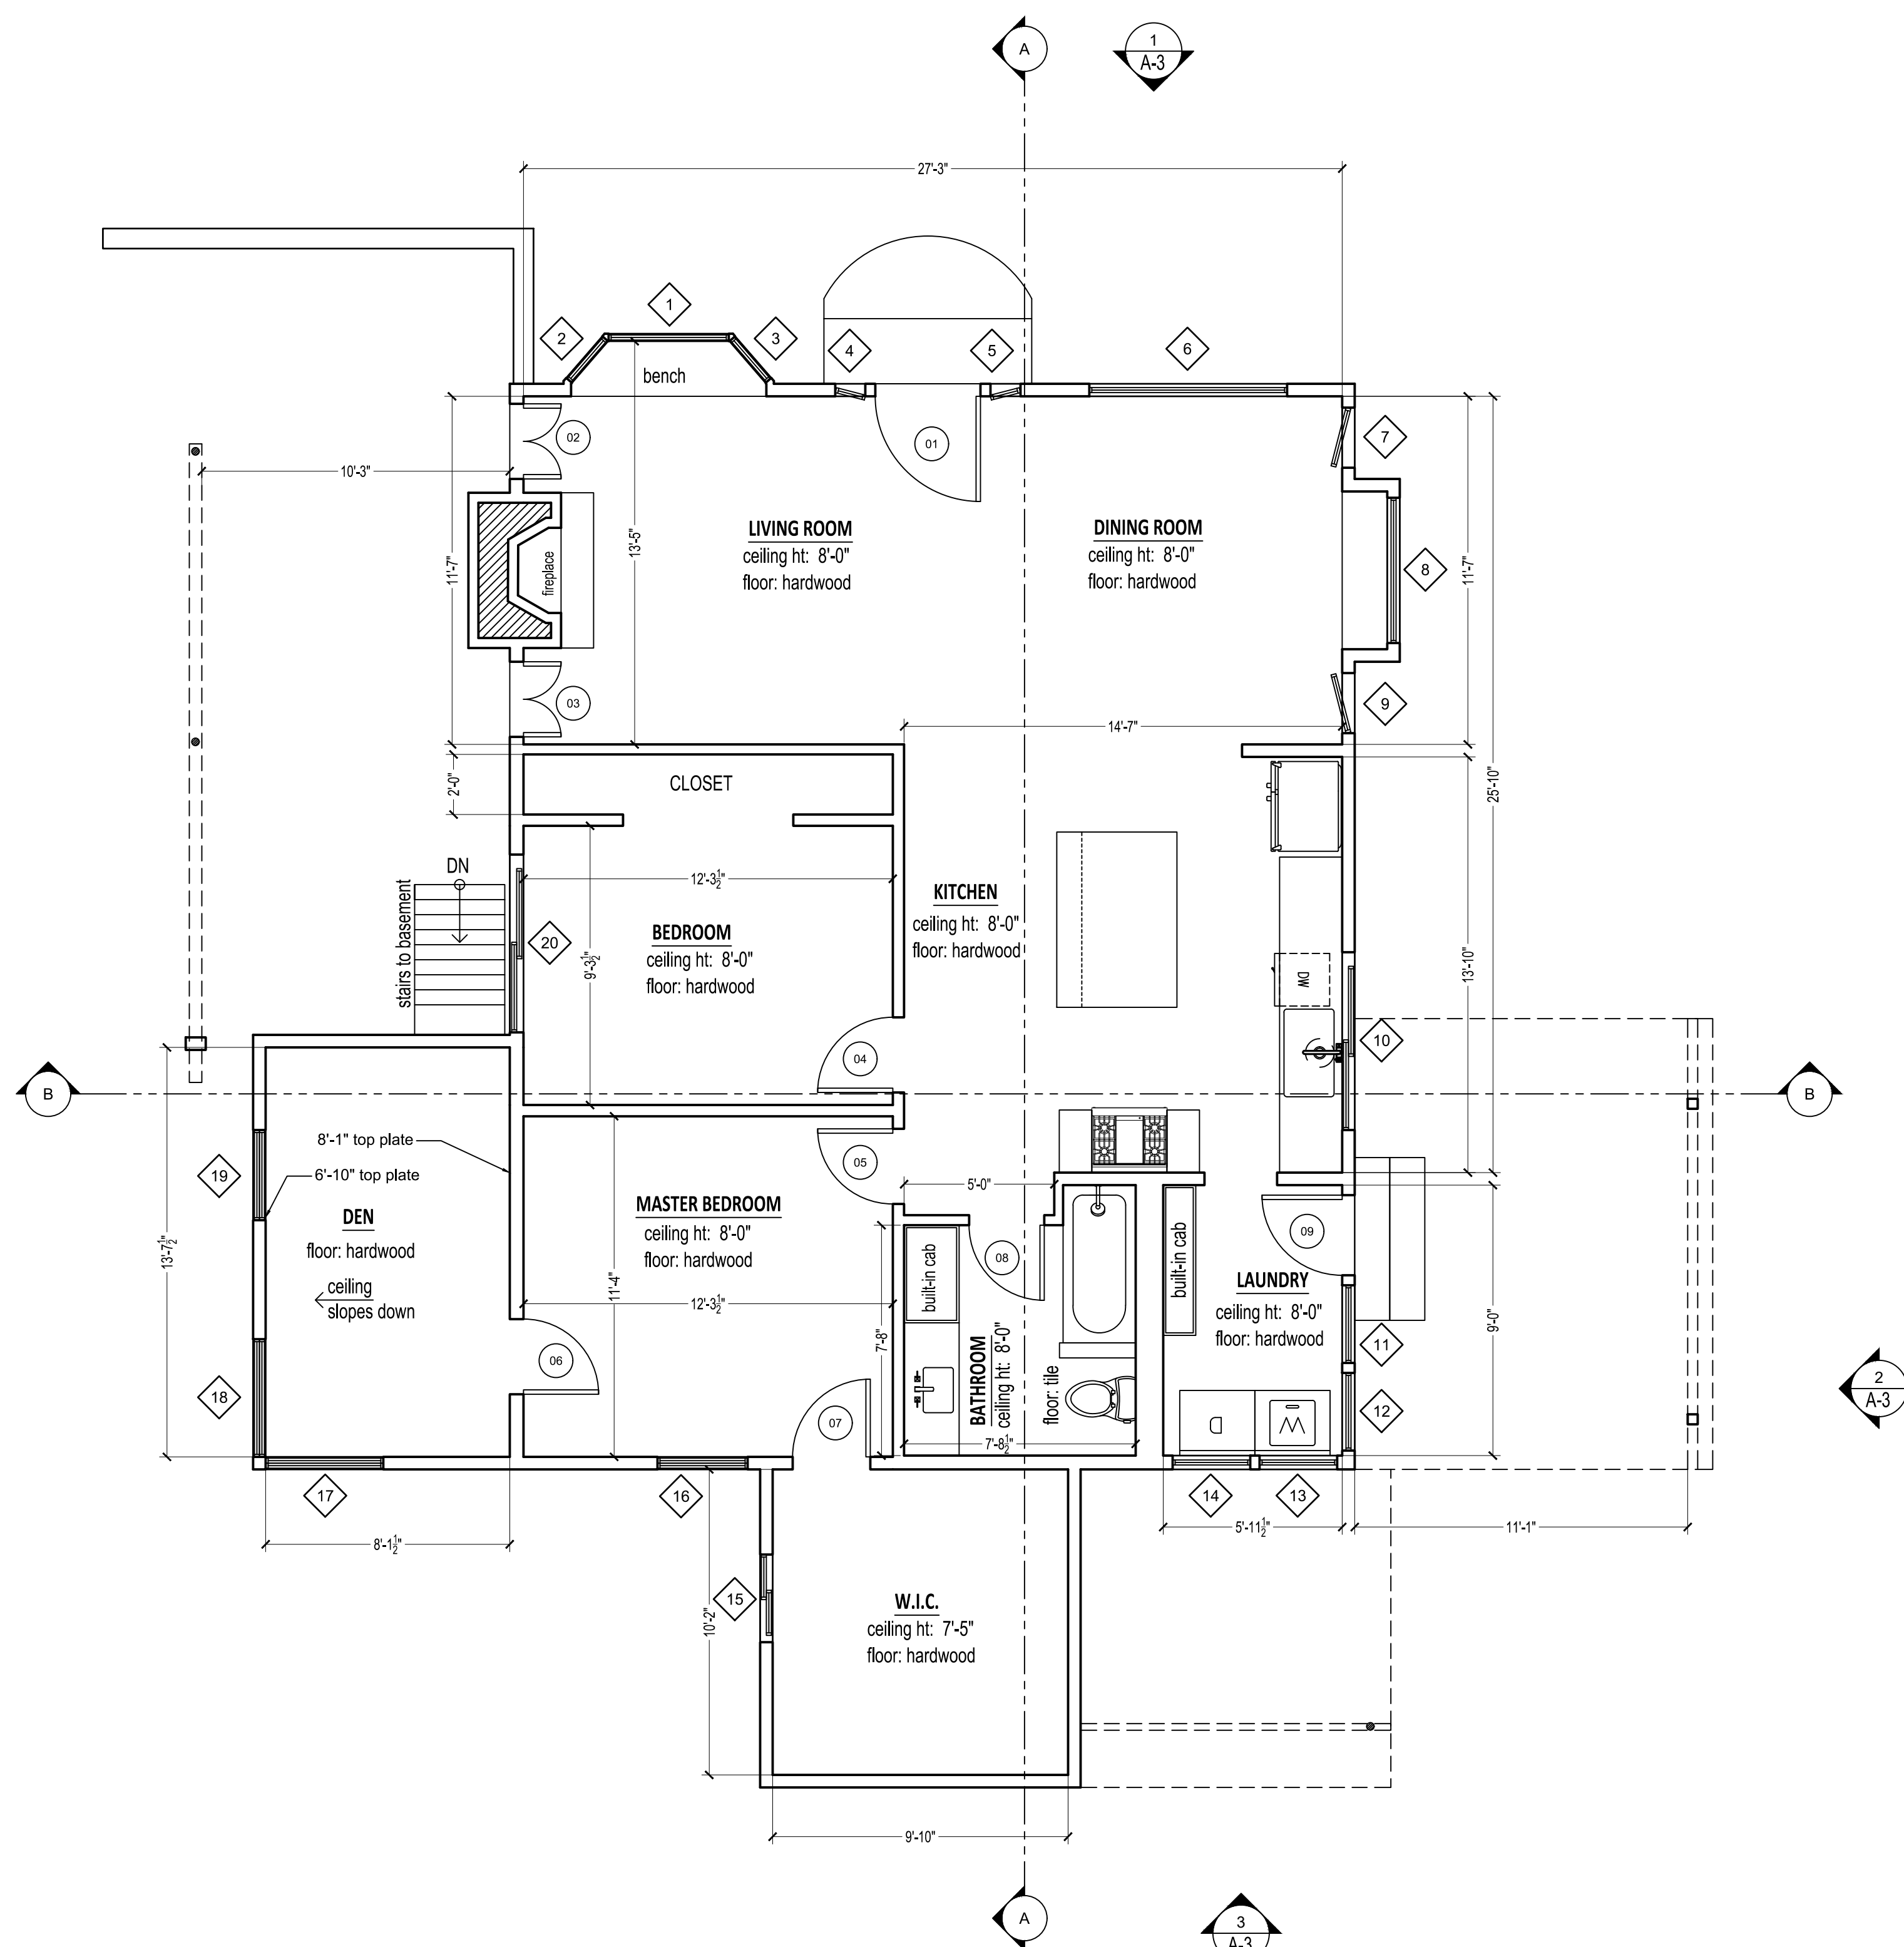

FLOOR PLAN

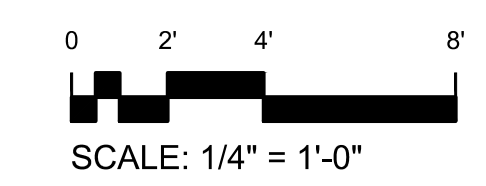

Sheet content : FLOOR PLAN

Project : 2138 ADDISON WAY
LOS ANGELES CA 90041

Owner:

Date


Scale

Drawn

Job


Sheet

A-2

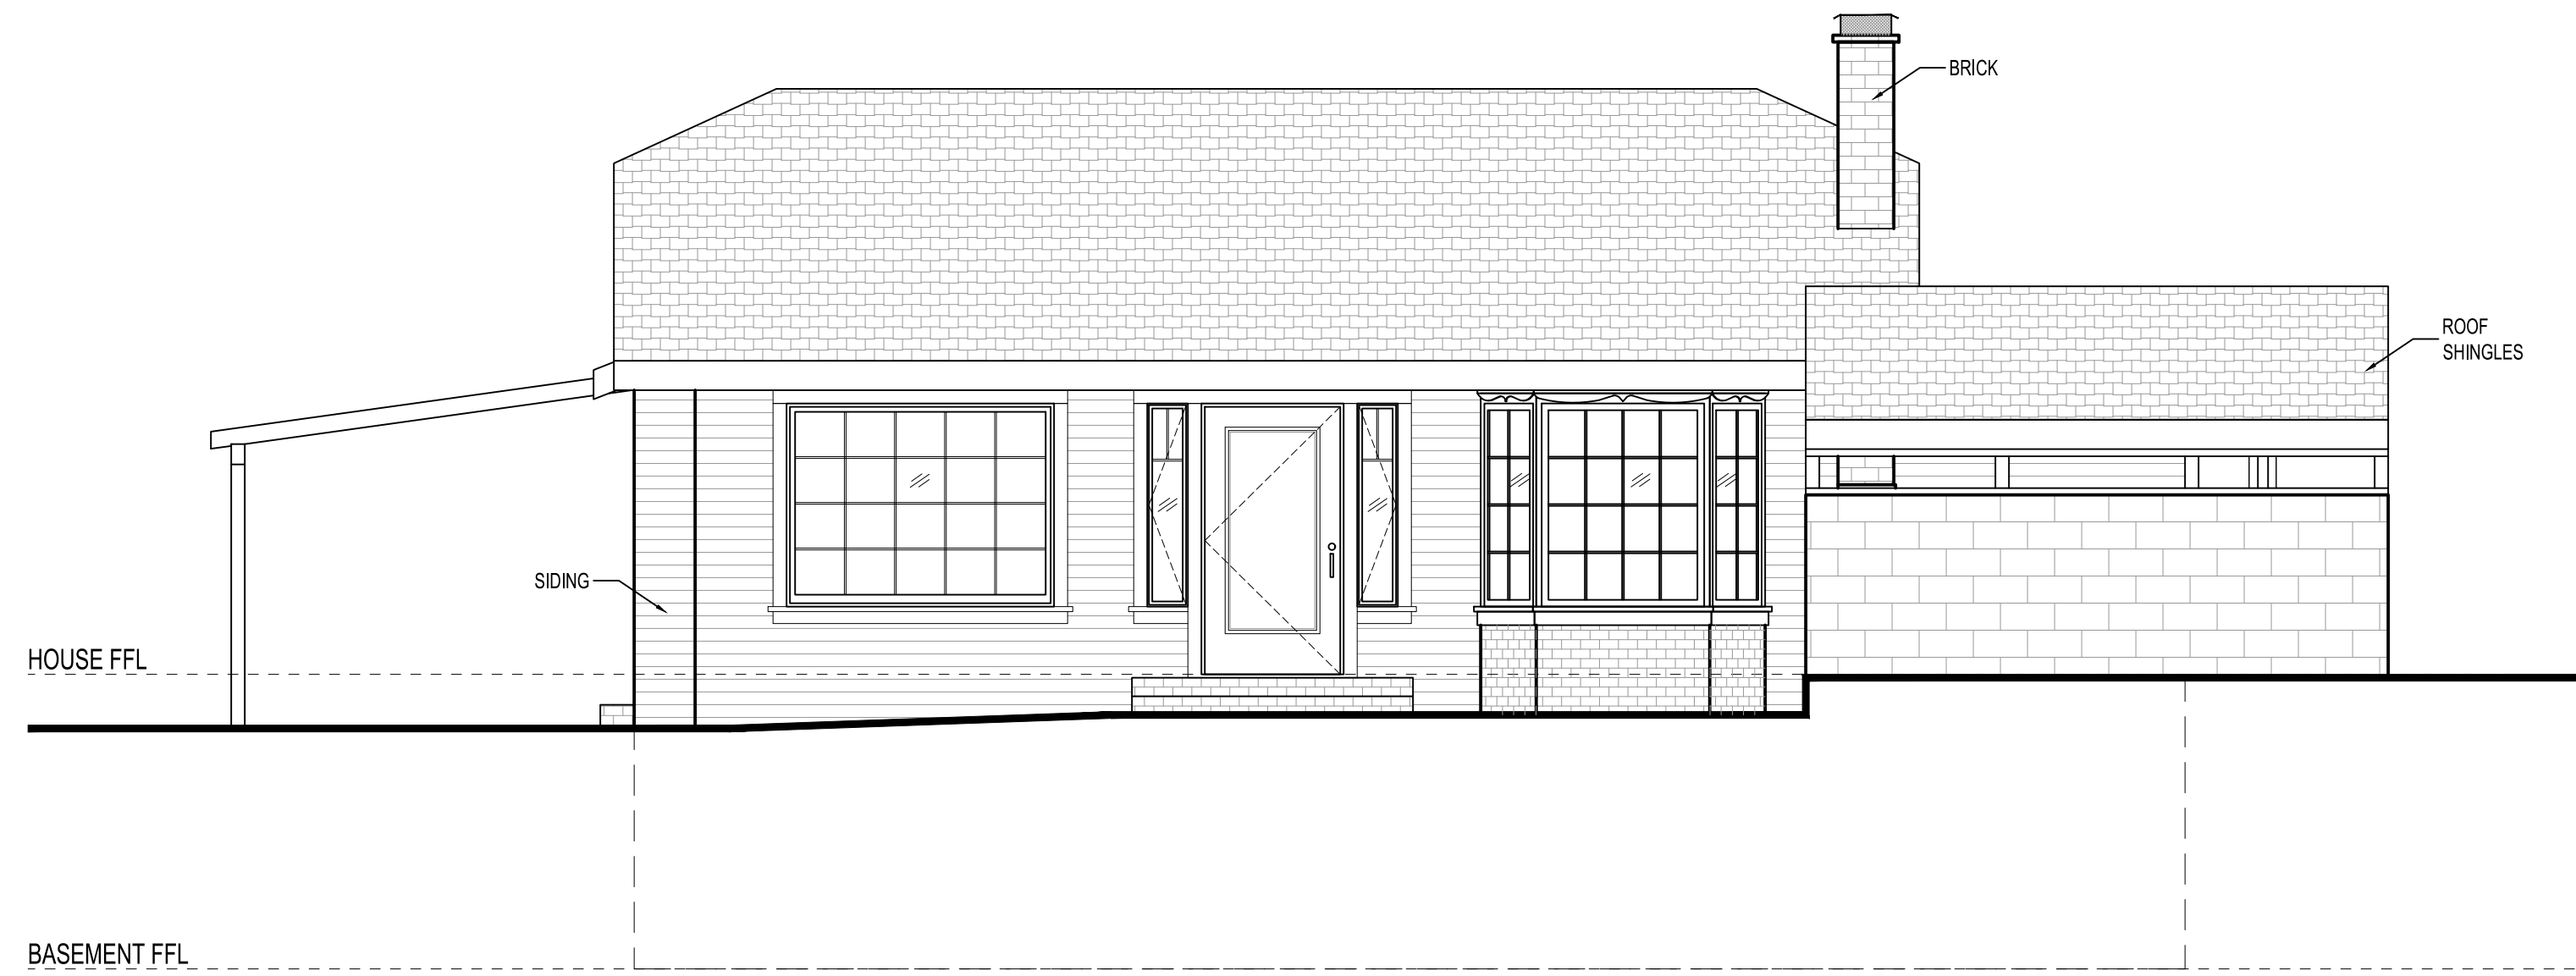


1 N. ELEVATION

SCALE: 1/4" = 1'-0"

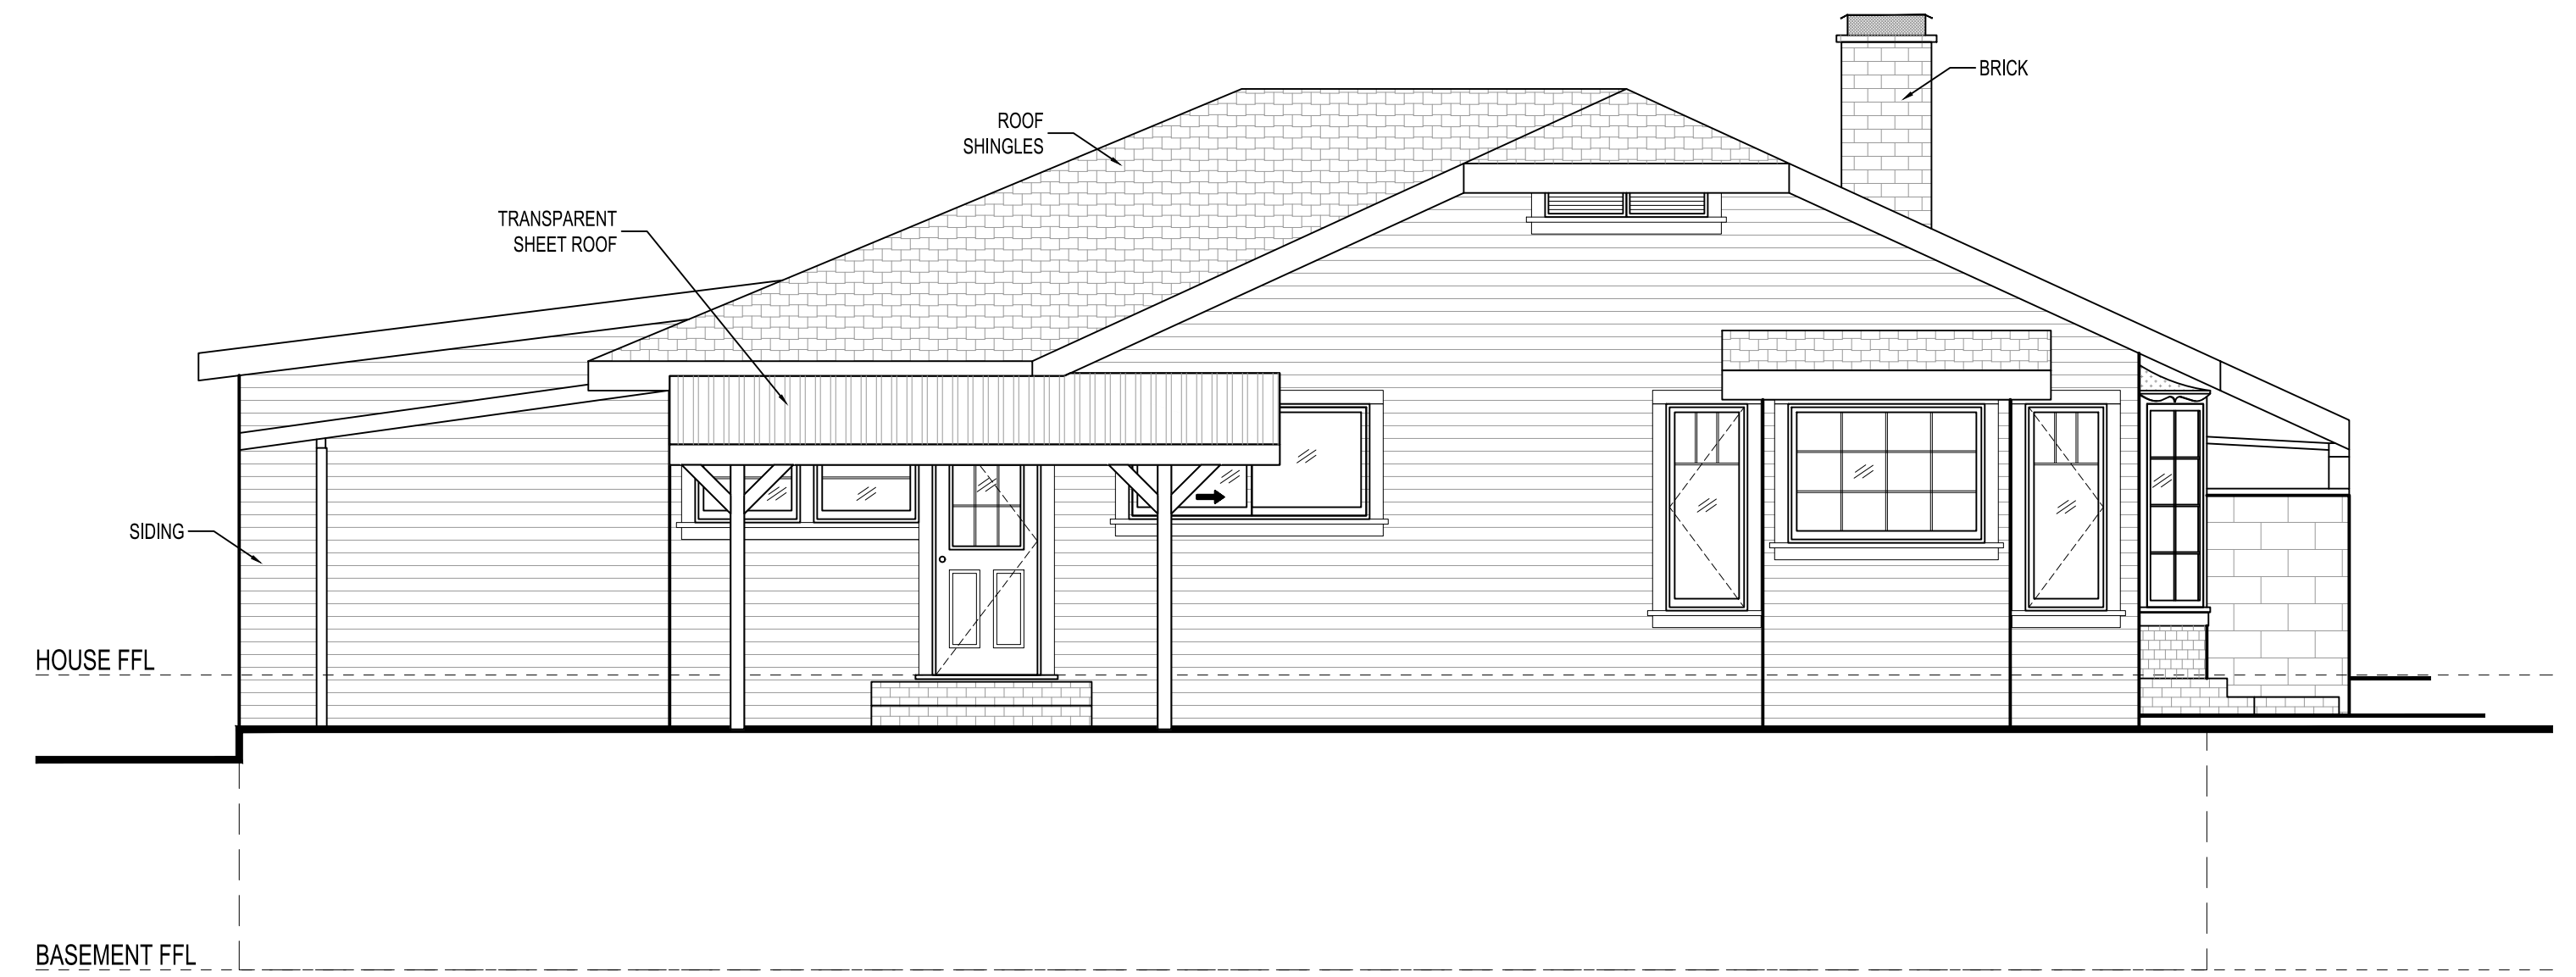


2 E. ELEVATION

SCALE: 1/4" = 1'-0"

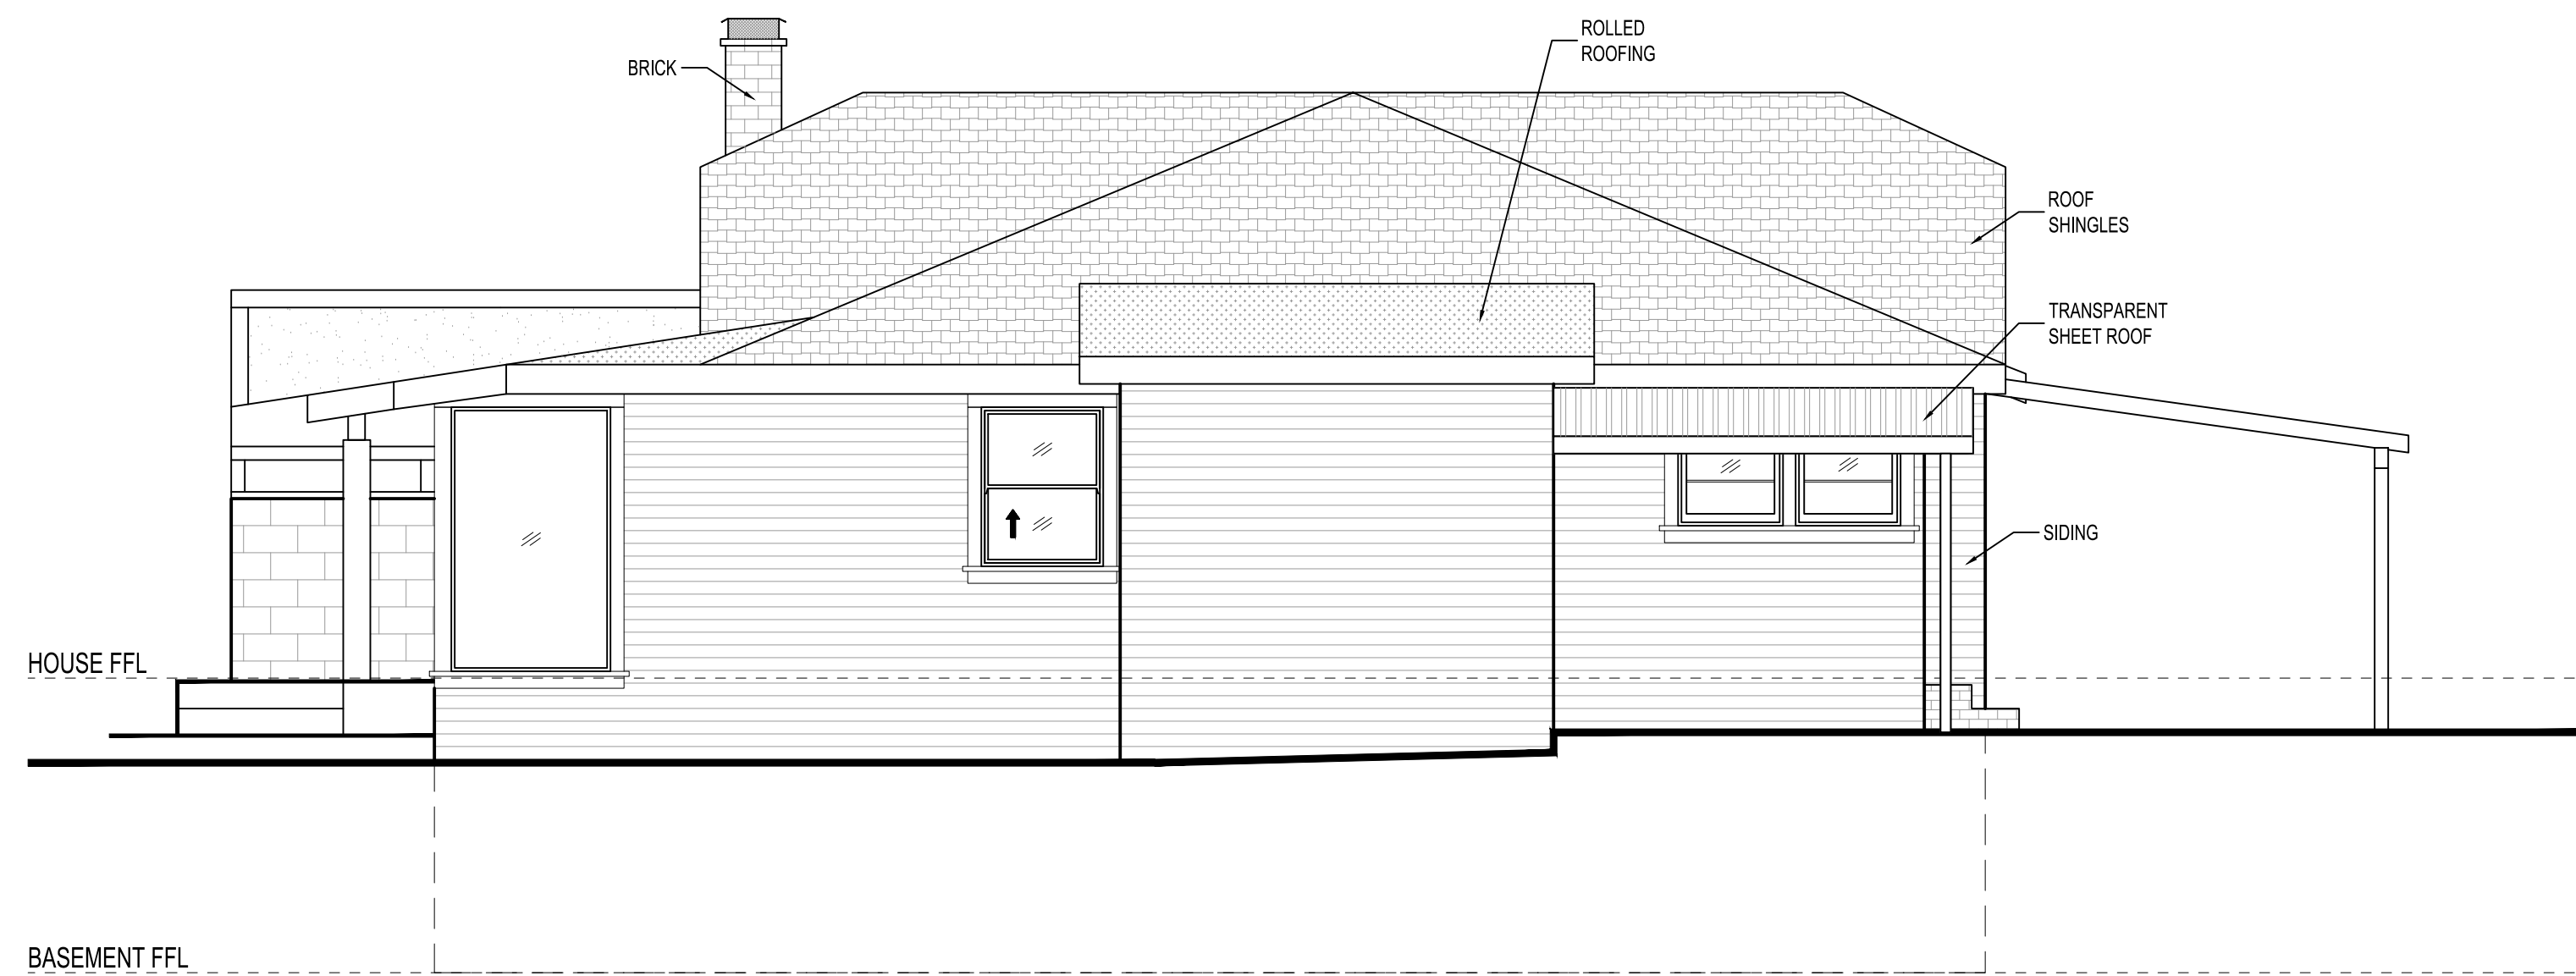

3 S. ELEVATION

SCALE: 1/4" = 1'-0"

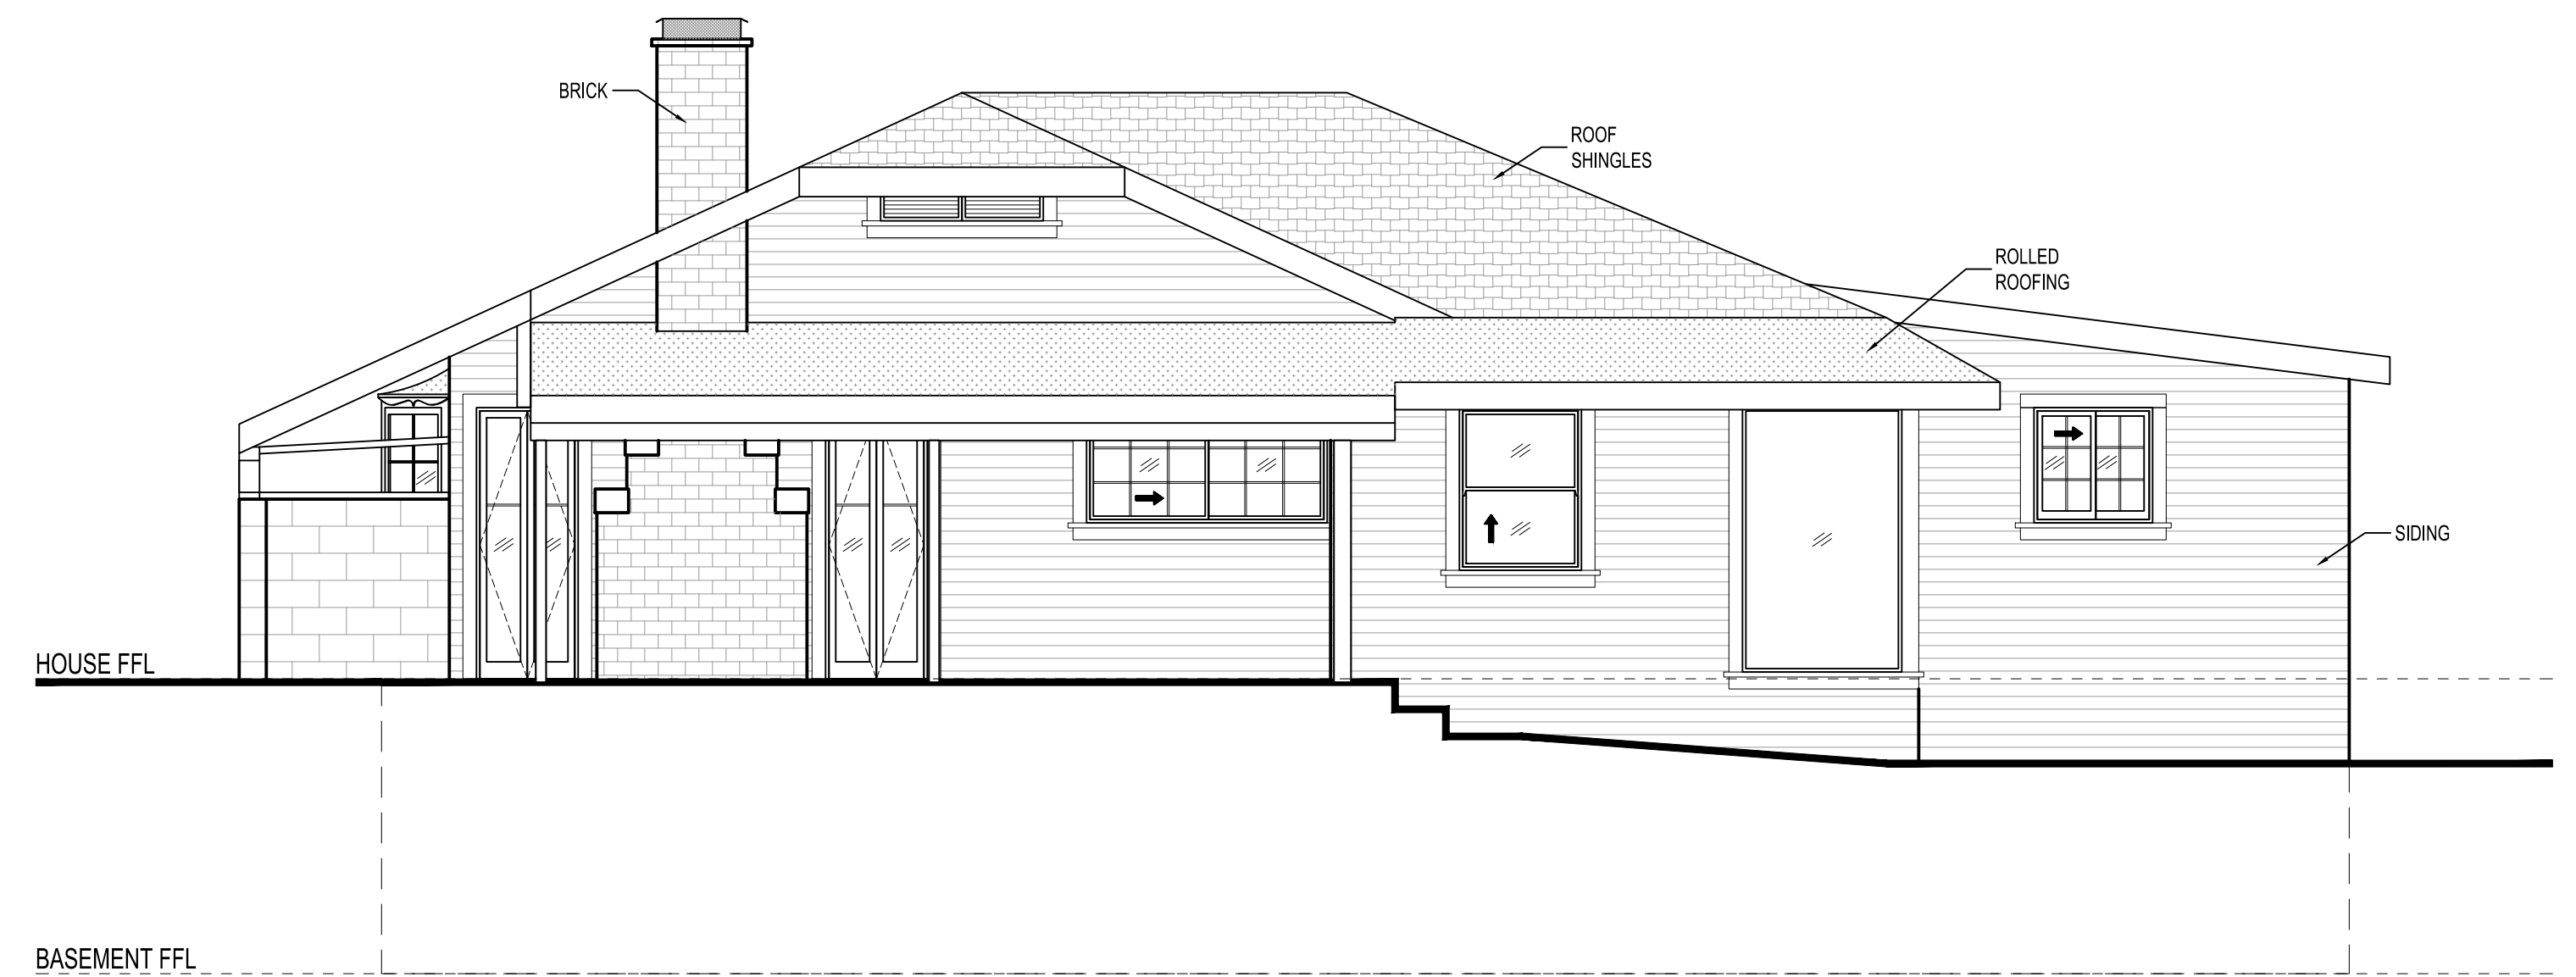

4 W. ELEVATION

SCALE: 1/4" = 1'-0"

REVISIONS	BY

AS-BUILT
LOS ANGELES

Sheet content :
ELEVATIONS

Project :
2138 ADDISON WAY
LOS ANGELES CA 90041

Owner:
Date
Scale
Drawn
Job
Sheet

A-3

REVISIONS	BY

AS-BUILT
LOS ANGELES


Sheet content:
ROOF PLAN
ROOF FRAMING
CEILING FRAMING

Project:
2138 ADDISON WAY
LOS ANGELES CA 90041



Owner:
Date
Scale
Drawn
Job
Sheet

A-4



08.06.13

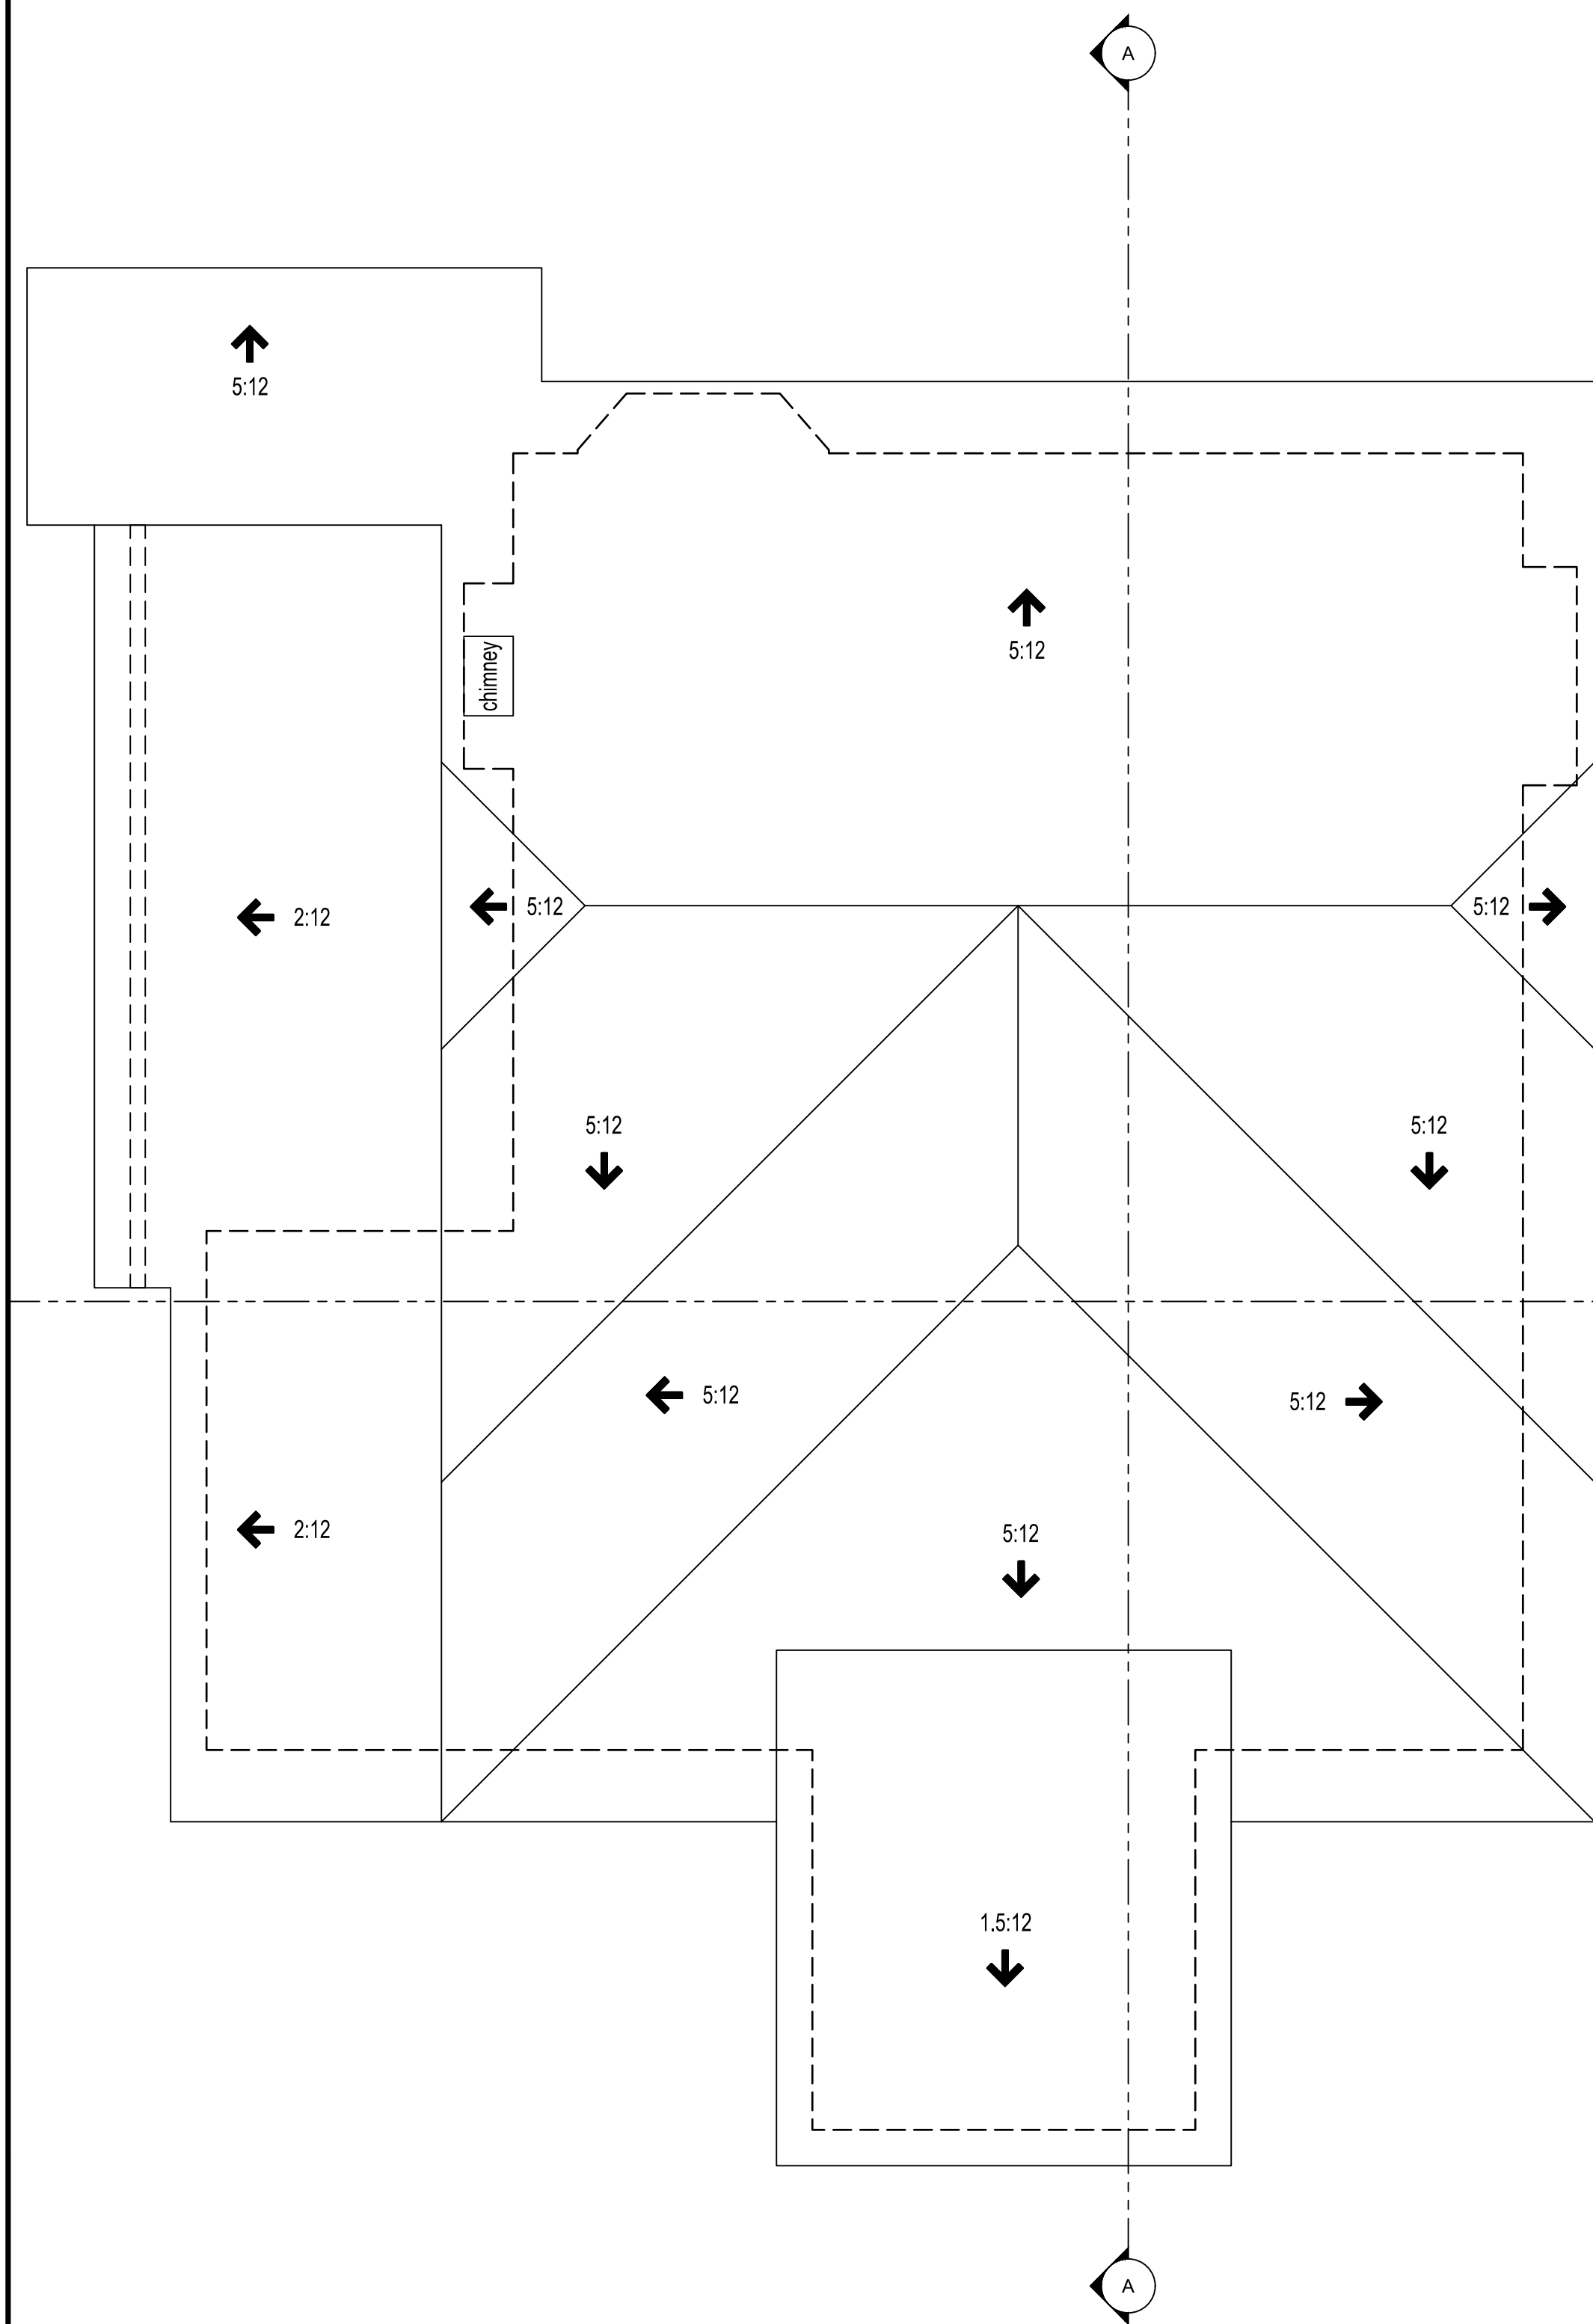


ROOF PLAN

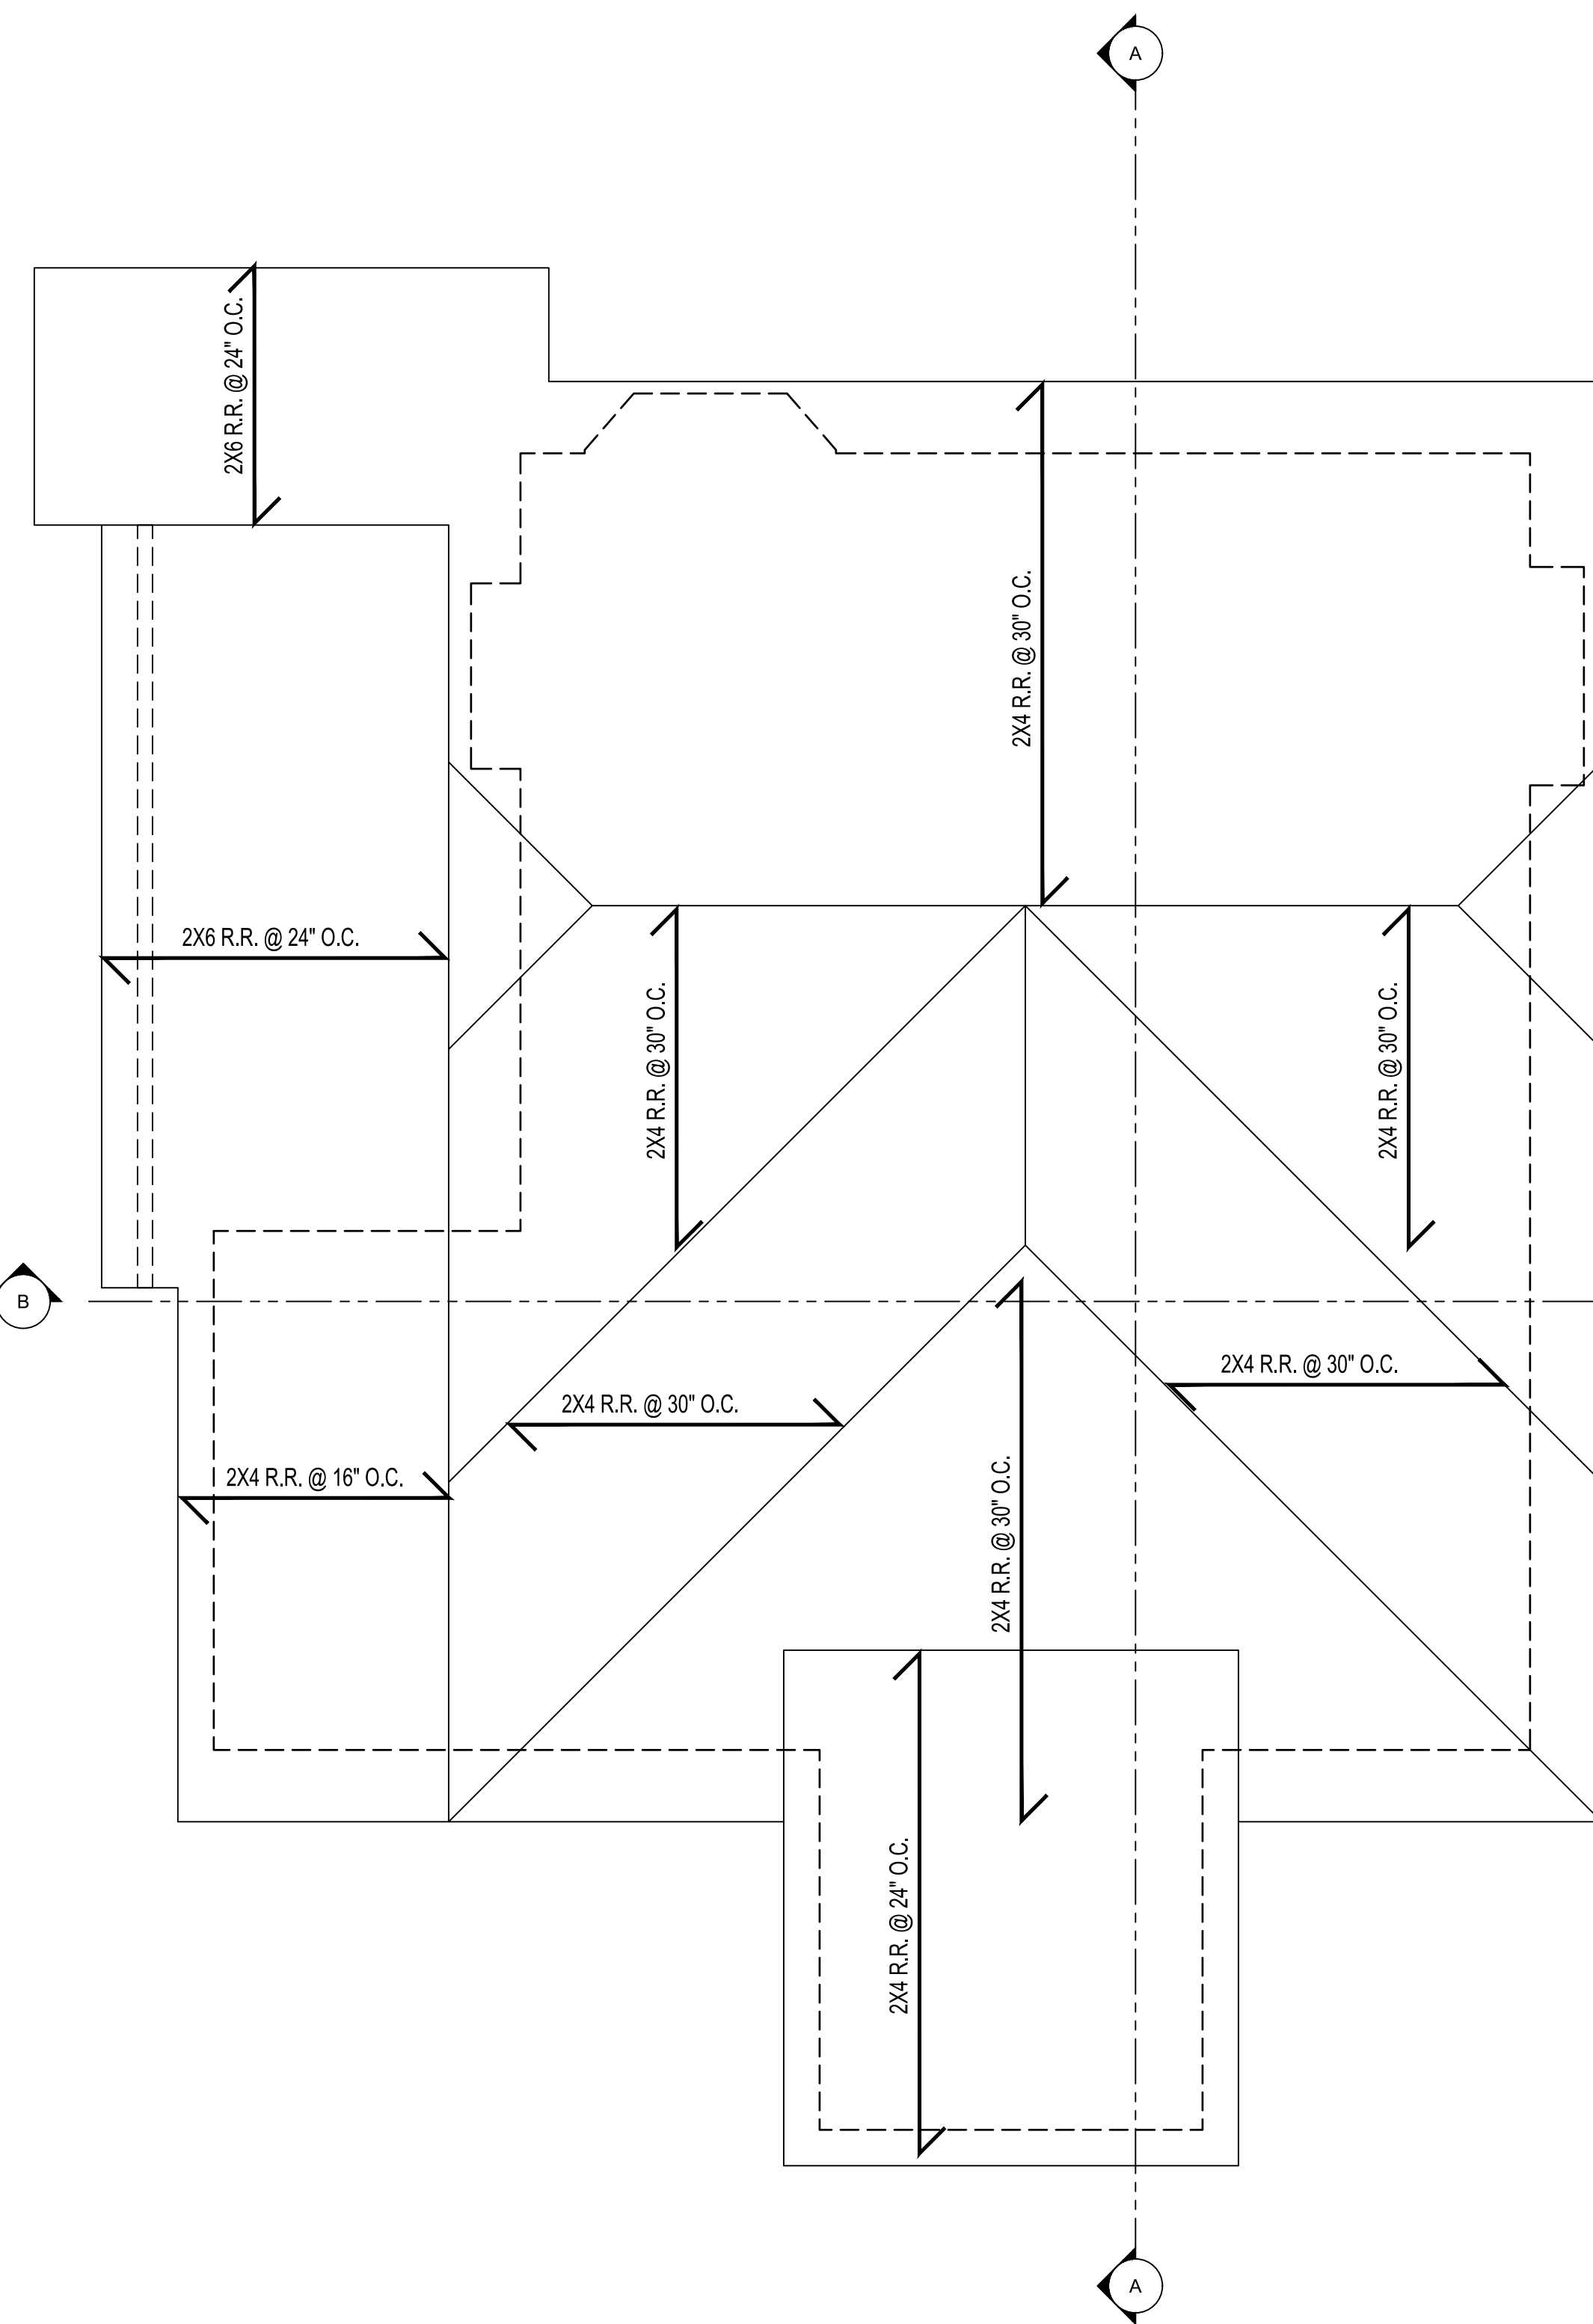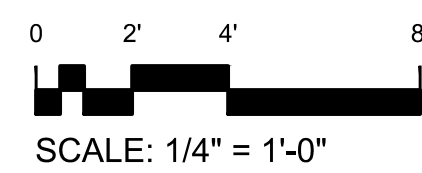

ROOF FRAMING PLAN

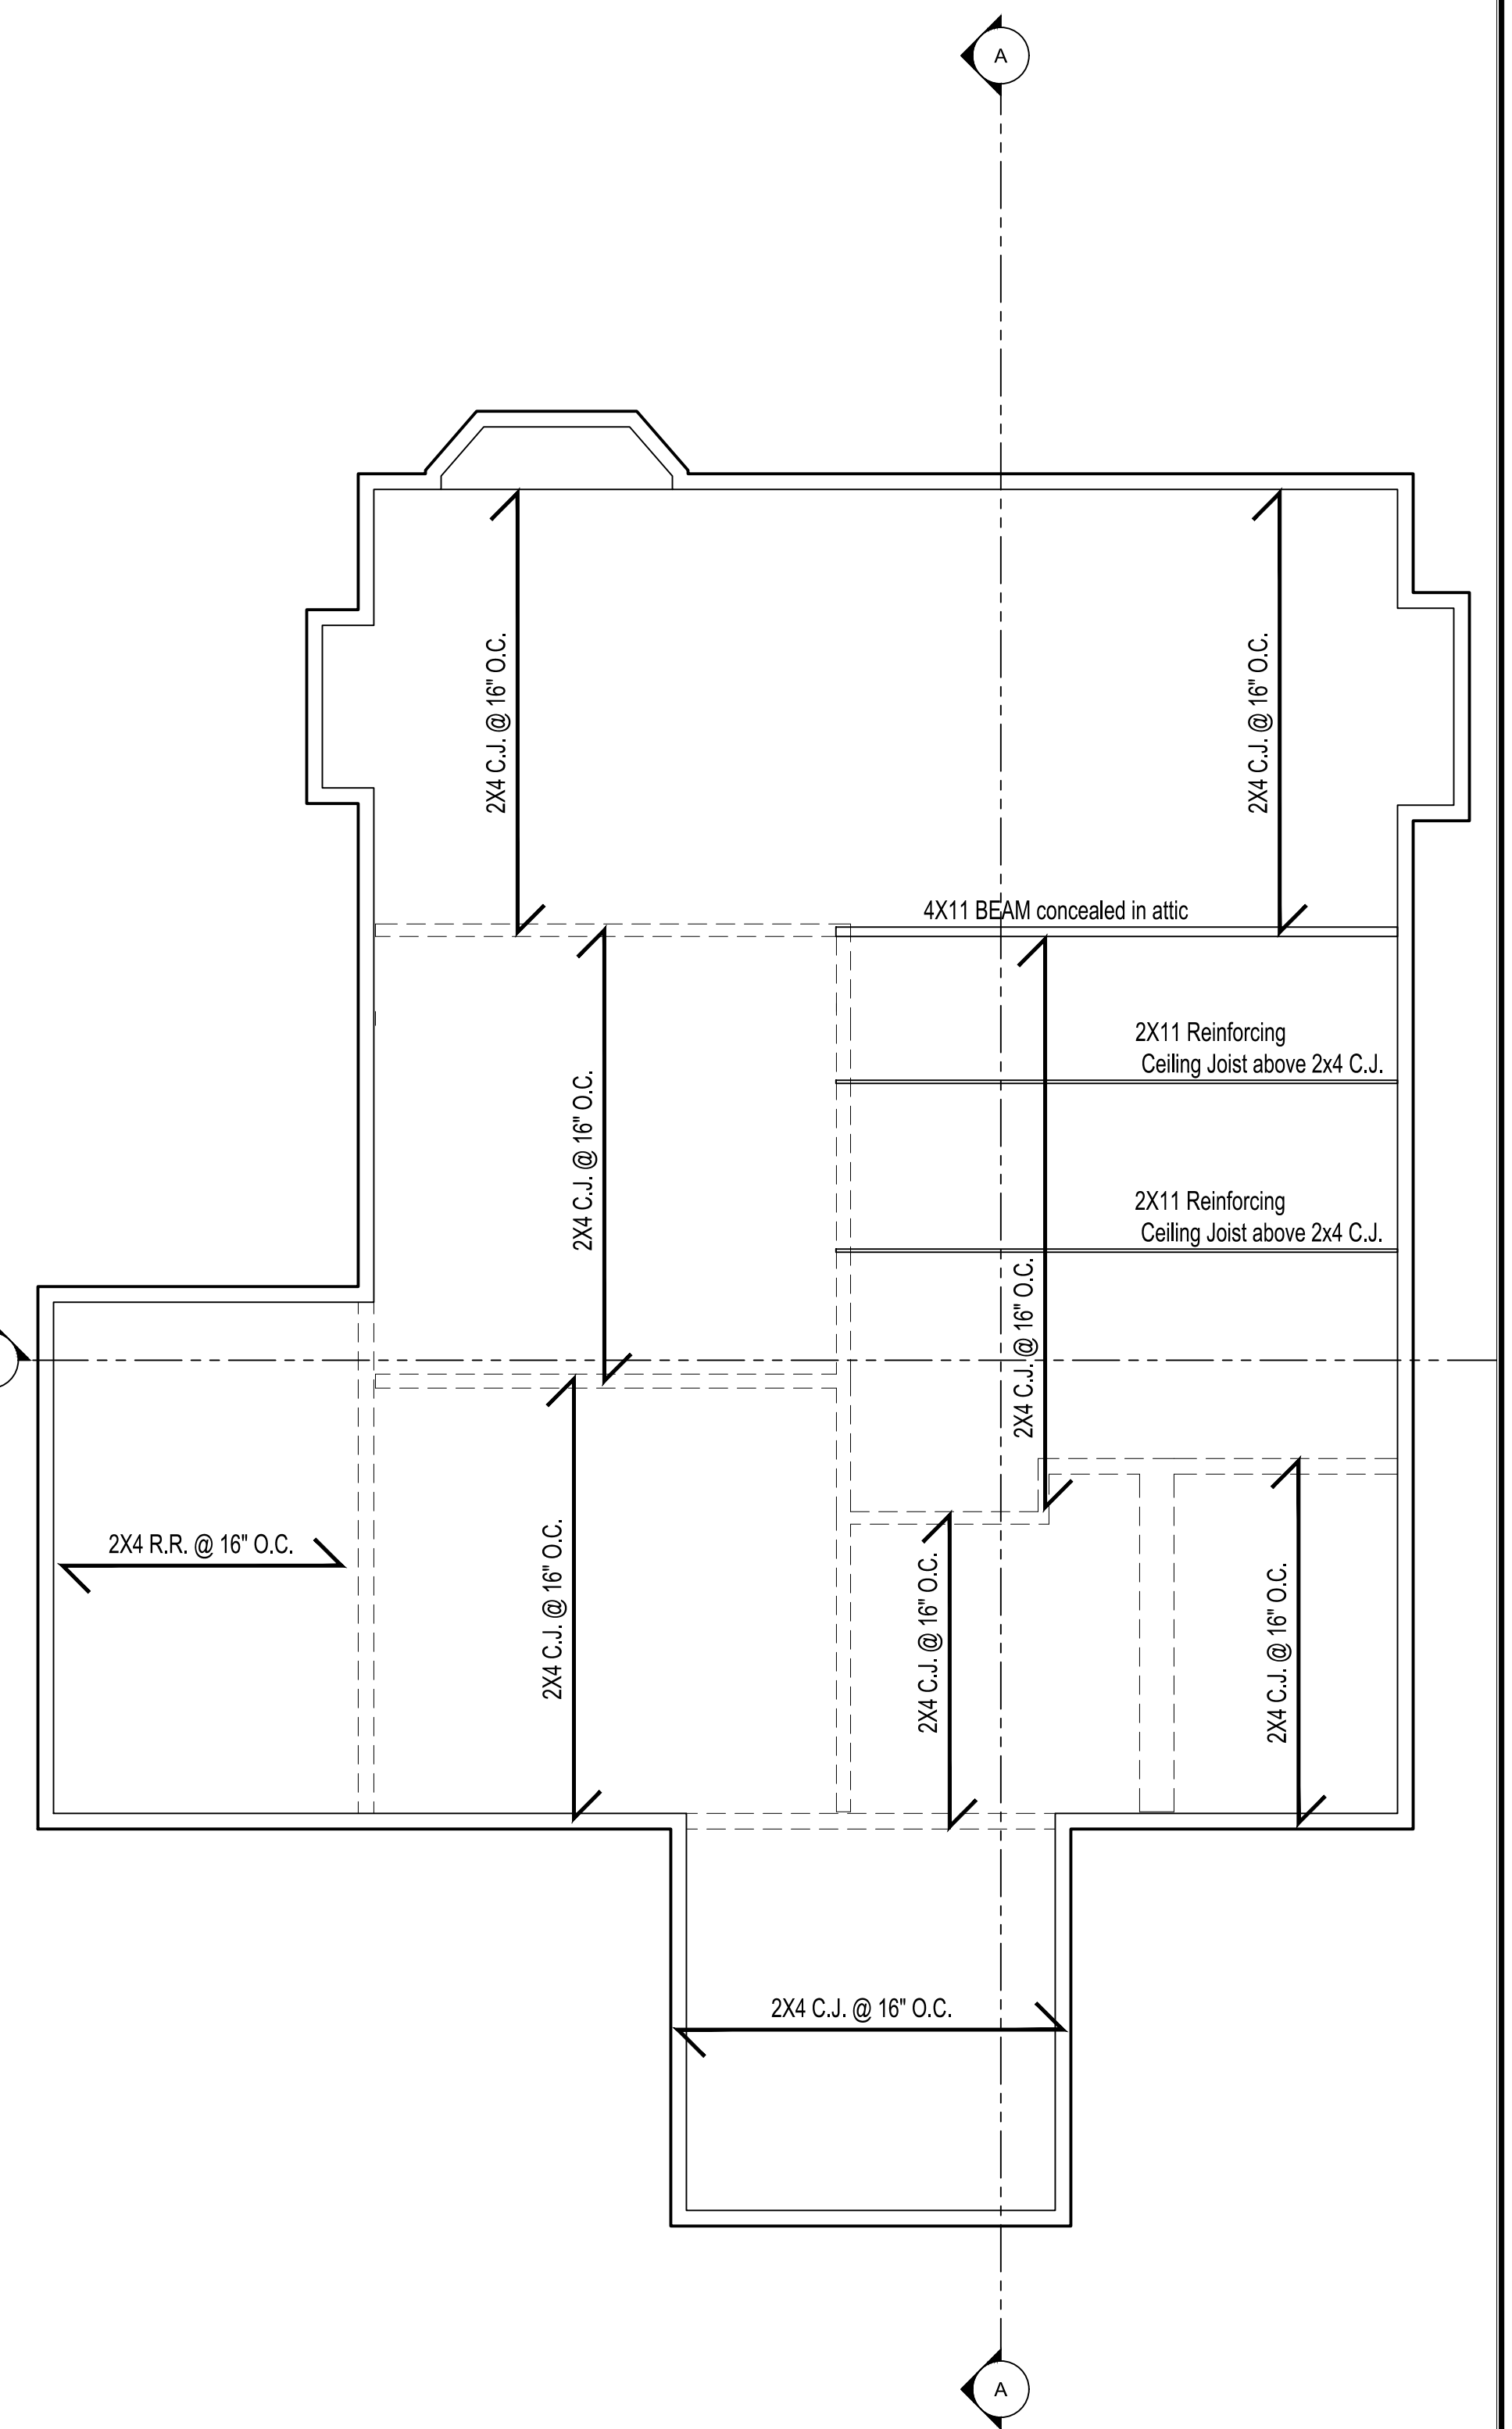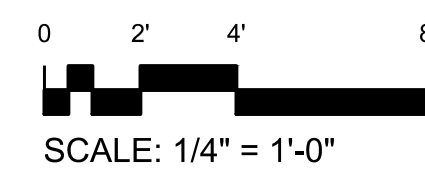


CEILING FRAMING PLAN


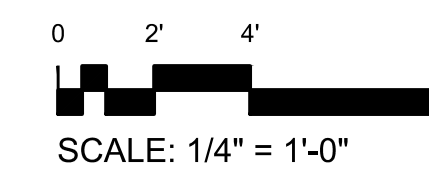


REVISIONS	BY


AS-BUILT
LOS ANGELES

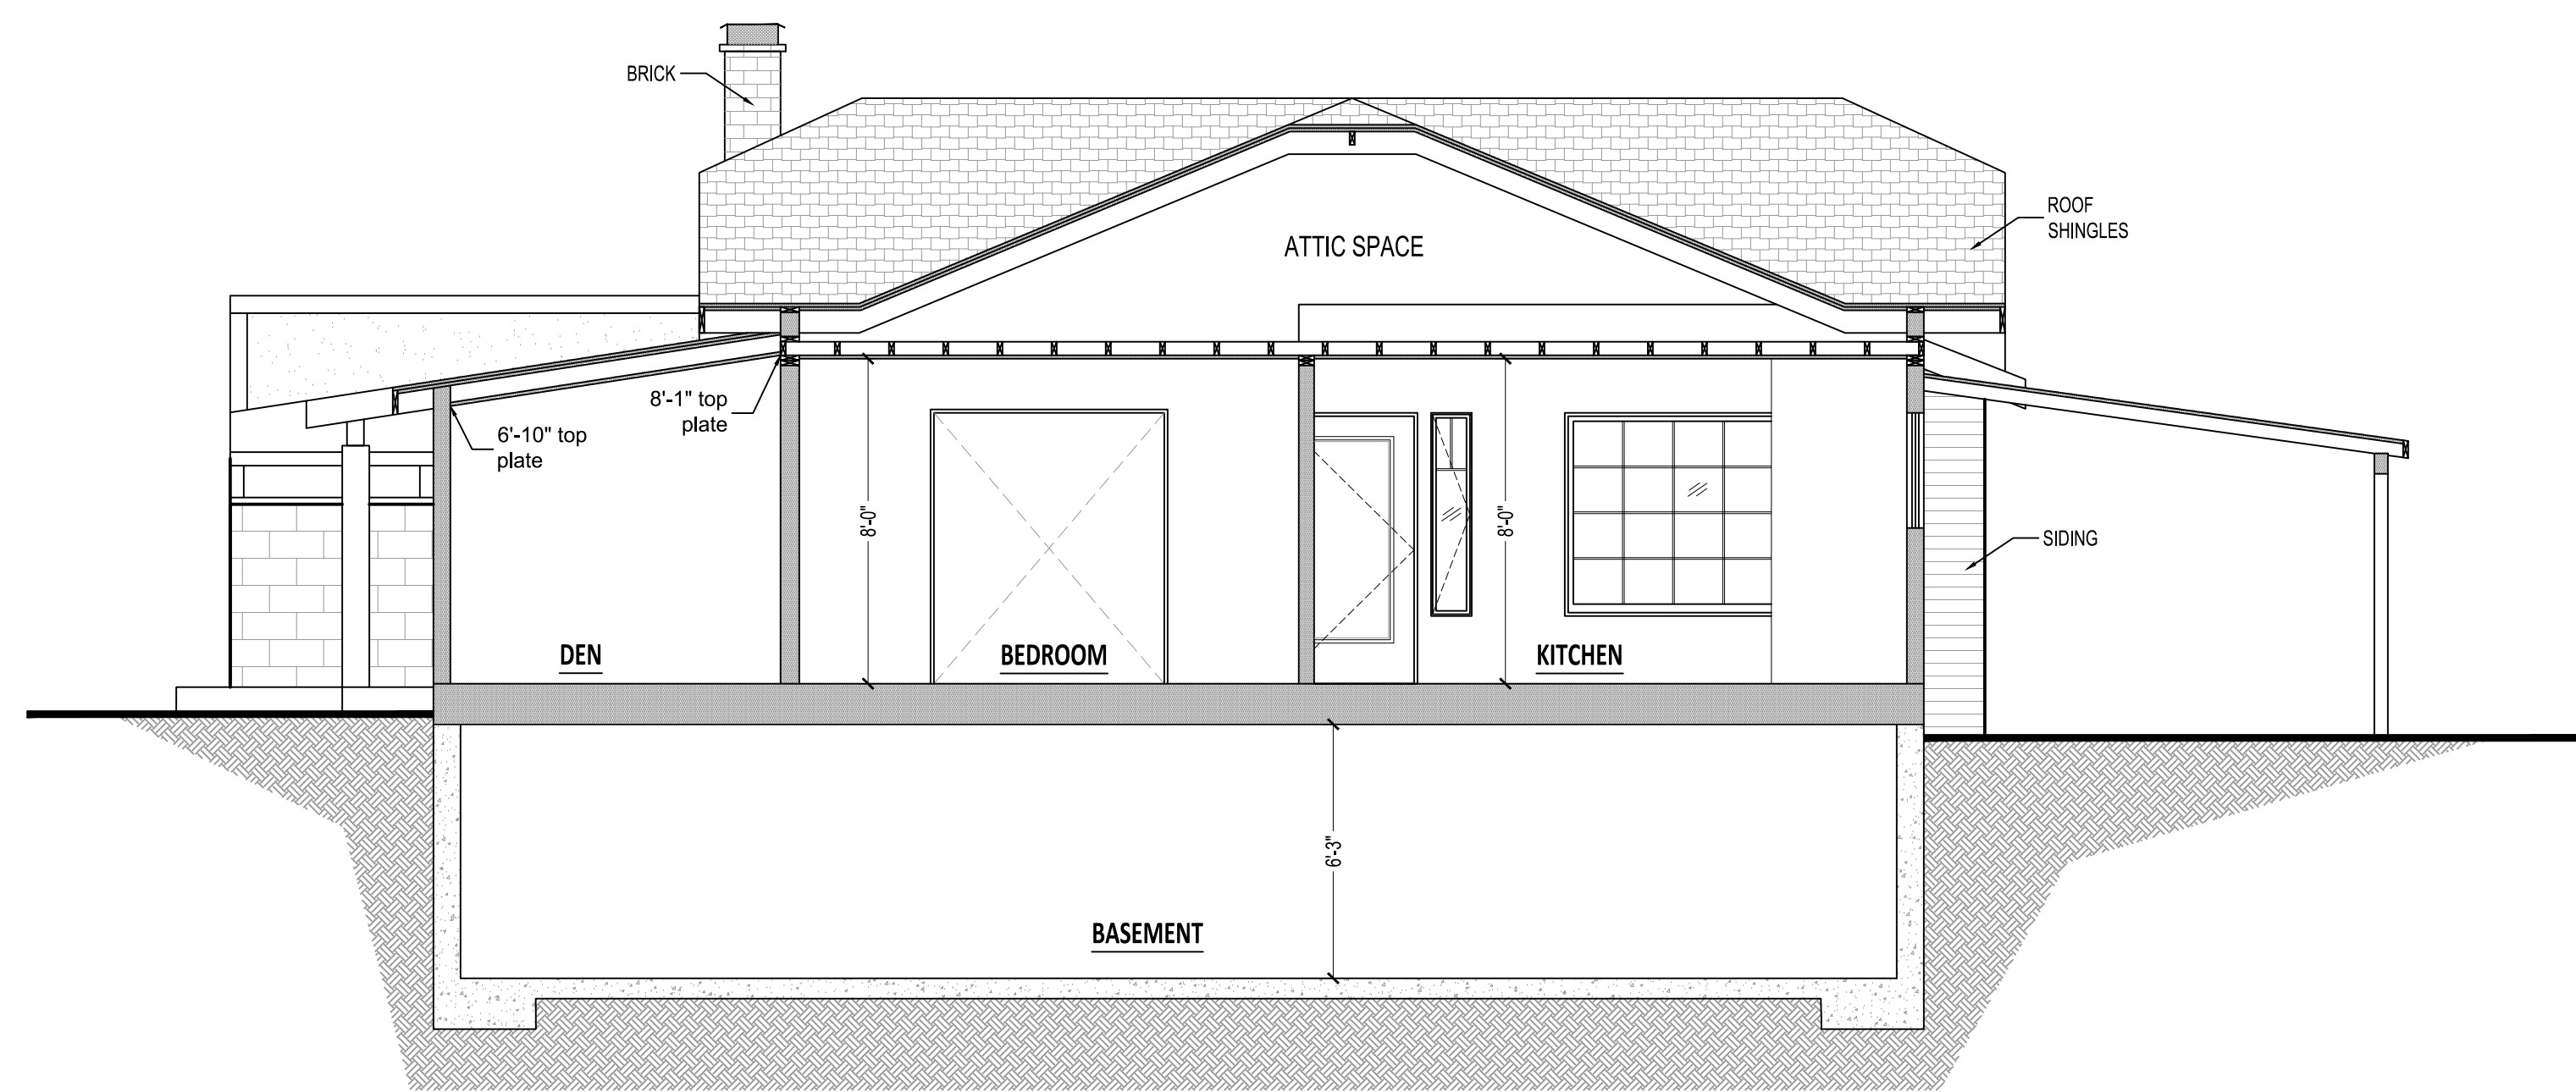

SECTION B-B

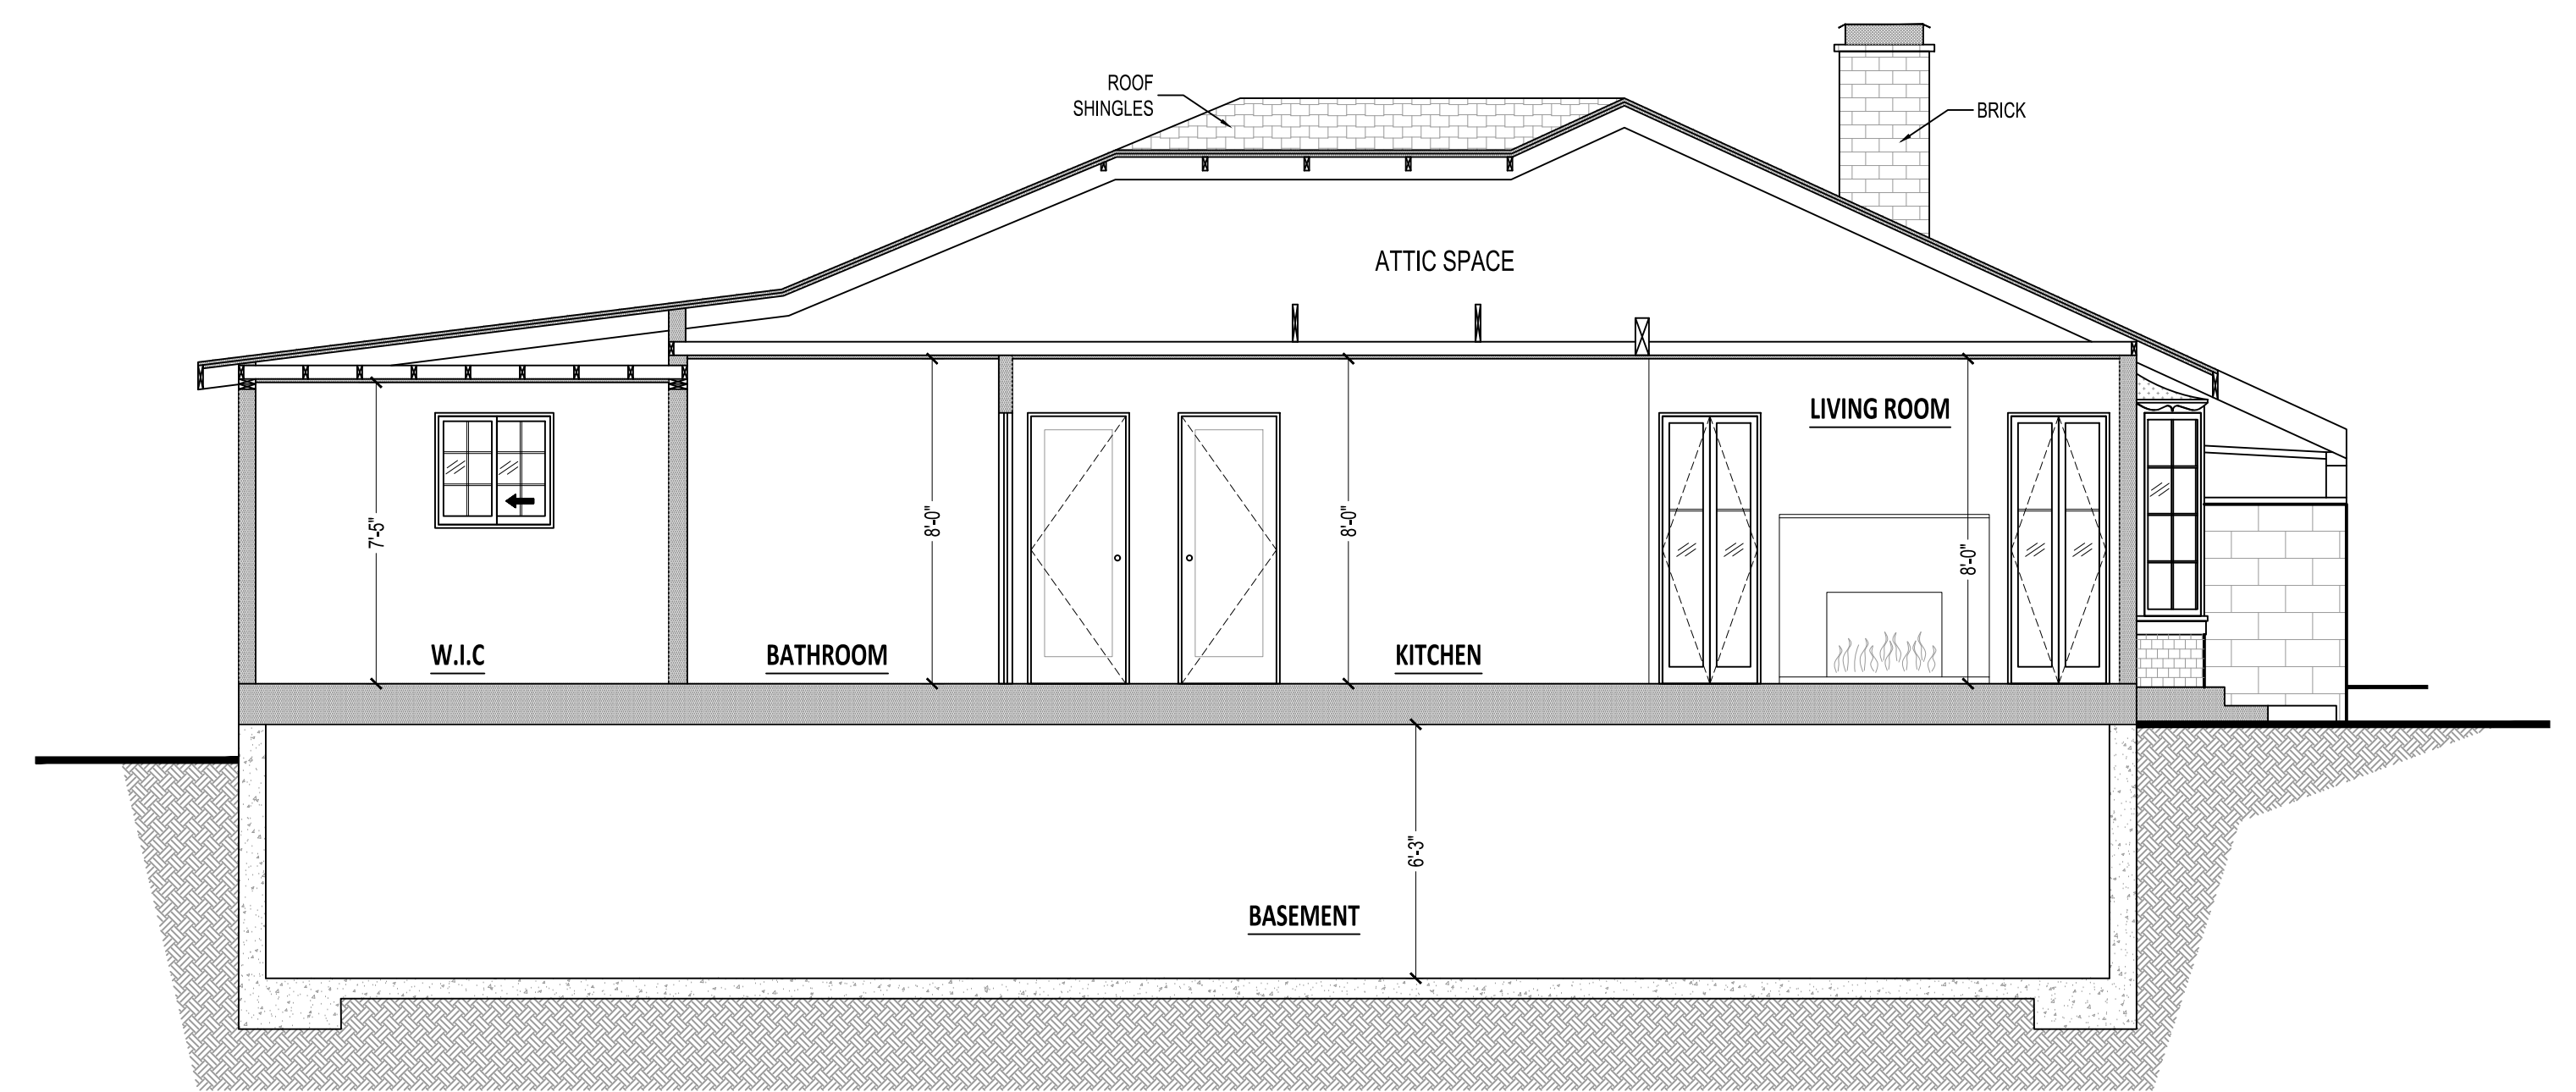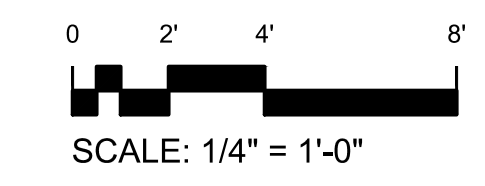

SECTION A-A

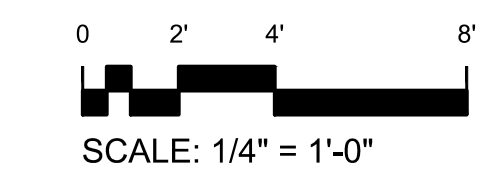

Sheet content :
BUILDING SECTIONS

Project :
2138 ADDISON WAY
LOS ANGELES CA 90041

Owner:
Date
Scale
Drawn
Job
Sheet

A-5