



REVISIONS	BY


AS-BUILT
LOS ANGELES

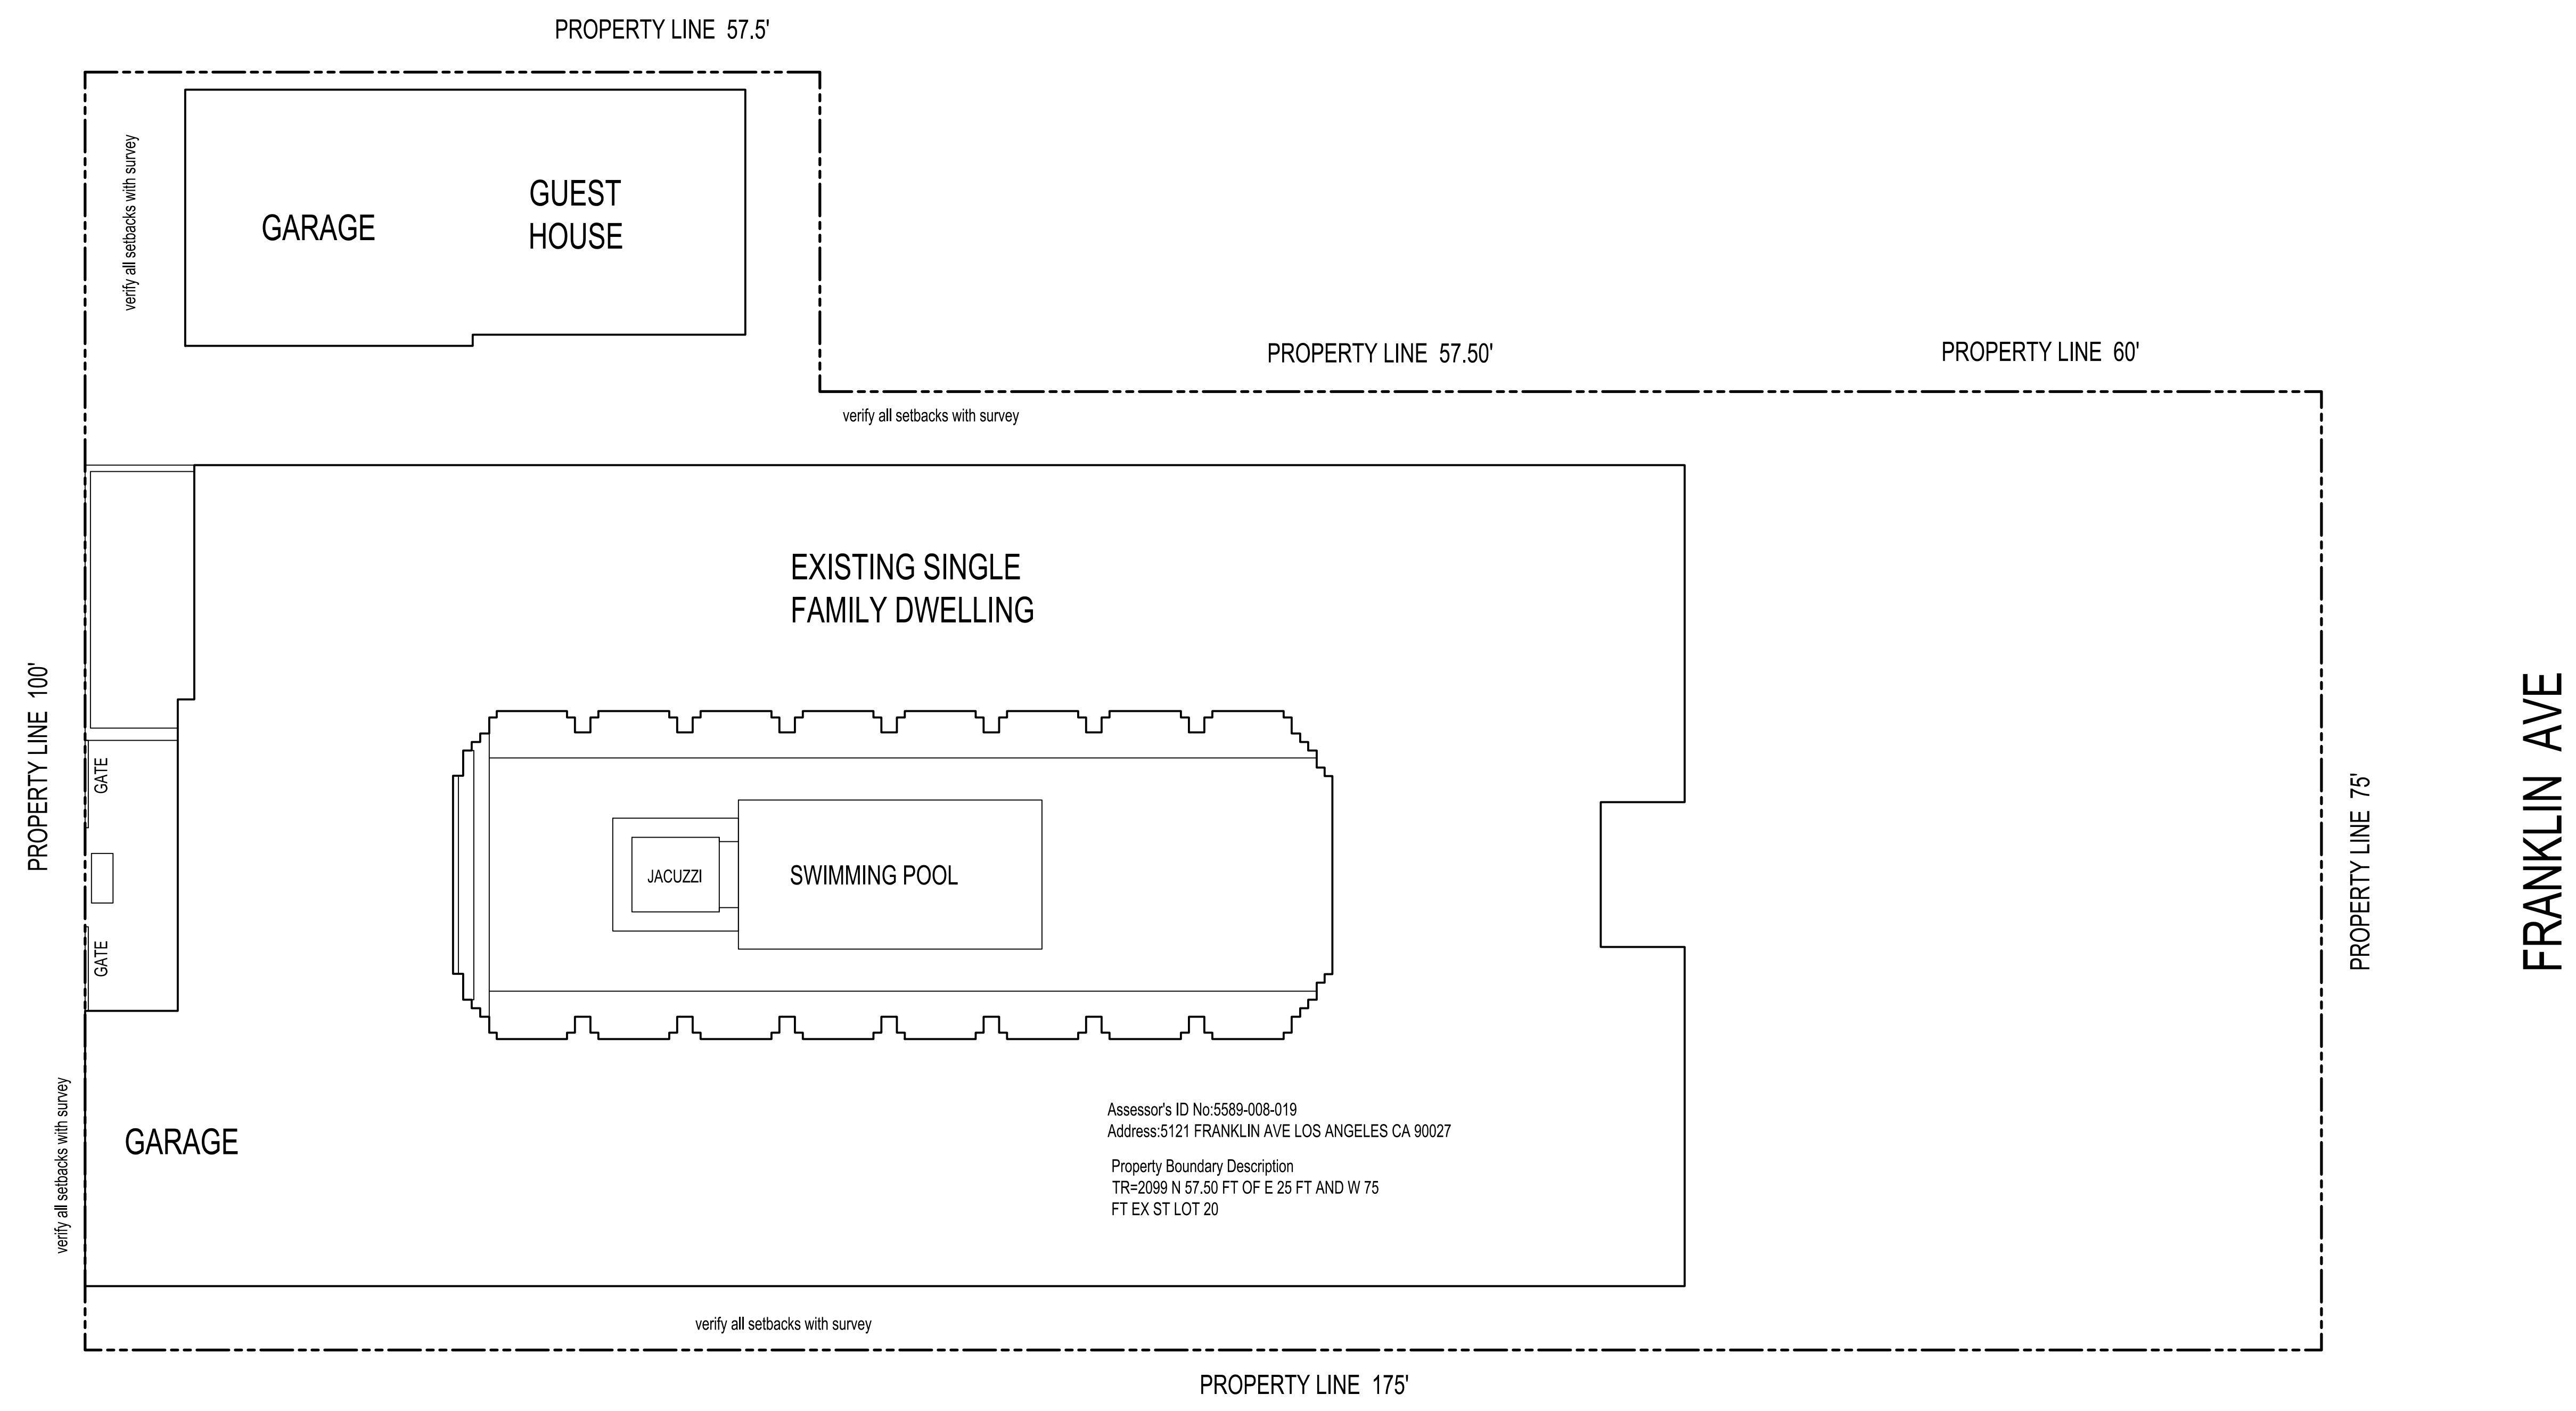

PLOT PLAN

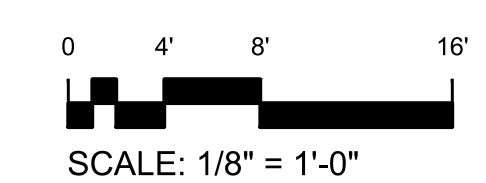

SCALE: 1/8" = 1'-0"

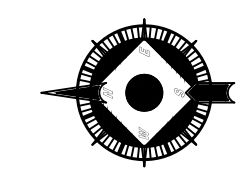

Sheet content :
PLOT PLAN

Project :
5121 FRANKLIN AVE,
LOS ANGELES, CA 90027

Owner:

Date

Scale

Drawn


Job

Sheet

A-1

DOOR SCHEDULE				
MARK	SIZE	Type	NOTES	
	WD HGT			
1	2'-0" 8'-8"	SWING DOUBLE	---	---
2	12'-10" 8'-8"	SWING	---	---
3	18'-0" 7'-0"	GARAGE DOOR	---	---
4	5'-2" 7'-0"	POCKET DOUBLE	---	---
5	2'-4" 6'-0"	SWING	---	---
6	2'-8" 6'-8"	SWING	---	---
7	1'-0" 6'-8"	FRENCH	---	---
8	2'-8" 6'-8"	FRENCH	---	---
9	2'-8" 6'-8"	SWING	---	---
10	2'-8" 6'-8"	SWING	---	---
11	5'-0" 8'-10"	POCKET DOUBLE	---	---
12	2'-8" 8'-8"	SWING	---	---
13	15'-8" 7'-2"	POCKET DOUBLE	---	---
14	5'-8" 7'-2"	POCKET DOUBLE	---	---
15	15'-8" 7'-2"	POCKET DOUBLE	---	---
16	15'-8" 7'-2"	POCKET DOUBLE	---	---
17	5'-8" 7'-2"	POCKET DOUBLE	---	---
18	15'-8" 7'-2"	POCKET DOUBLE	---	---
19	5'-8" 7'-2"	POCKET DOUBLE	---	---
20	5'-8" 7'-2"	POCKET DOUBLE	---	---
21	5'-8" 7'-2"	POCKET DOUBLE	---	---
22	5'-8" 7'-2"	POCKET DOUBLE	---	---
23	5'-8" 7'-2"	POCKET DOUBLE	---	---
24	5'-8" 7'-2"	POCKET DOUBLE	---	---
25	5'-8" 7'-2"	POCKET DOUBLE	---	---
26	5'-8" 7'-2"	POCKET DOUBLE	---	---
27	5'-8" 7'-2"	POCKET DOUBLE	---	---
28	5'-8" 7'-2"	POCKET DOUBLE	---	---
29	5'-8" 7'-2"	POCKET DOUBLE	---	---
30	9'-11" 8'-1"	POCKET DOUBLE	---	---
31	9'-11" 8'-1"	POCKET DOUBLE	---	---
32	2'-8" 6'-8"	SWING	---	---
33	2'-8" 6'-8"	SWING	---	---
34	2'-8" 6'-8"	SWING	---	---
35	7'-11" 8'-11"	POCKET DOUBLE	---	---
36	2'-8" 6'-8"	SWING	---	---
37	2'-8" 6'-8"	SWING	---	---
38	2'-8" 6'-8"	SWING	---	---
39	2'-8" 6'-8"	SWING	---	---
40	7'-11" 8'-11"	POCKET DOUBLE	---	---
41	2'-8" 6'-8"	SWING	---	---
42	2'-8" 6'-8"	SWING	---	---
43	5'-4" 6'-8"	SWING DOUBLE	---	---
44	2'-8" 6'-8"	SWING	---	---
45	2'-8" 6'-8"	SWING	---	---
46	3'-0" 6'-8"	SWING	---	---
47	2'-8" 7'-0"	SWING	---	---
48	15'-3" 14'-8"	OPENING	---	---
49	15'-3" 14'-8"	OPENING	---	---
50	15'-3" 14'-8"	OPENING	---	---
51	2'-8" 6'-7"	SWING	---	---
52	2'-8" 6'-7"	SWING	---	---
53	2'-8" 6'-7"	SWING	---	---
54	2'-8" 6'-7"	SWING	---	---
55	2'-8" 6'-7"	SWING	---	---
56	2'-8" 6'-7"	SWING	---	---
57	2'-4" 6'-8"	SWING	---	---

WINDOW SCHEDULE				
MARK	SIZE	TYPE	Head Height	NOTES
	Width HEIGHT			
1	2'-10" 8'-8"	CASEMENT	8'-0"	---
2	2'-8" 8'-8"	CASEMENT	8'-0"	---
3	2'-8" 8'-10"	CASEMENT	8'-0"	---
4	2'-10" 8'-8"	CASEMENT	7'-8"	---
5	2'-10" 8'-8"	CASEMENT	7'-8"	---
6	3'-0" 8'-11"	AWNING	8'-0"	---
7	2'-8" 8'-10"	CASEMENT	7'-10"	---
8	2'-8" 8'-10"	CASEMENT	7'-10"	---
9	4'-0" 9'-8"	AWNING	7'-11"	---
10	2'-2" 8'-10"	CASEMENT	7'-8"	---
11	6'-3" 14'-4"	FIXED	14'-4"	---
12	4'-0" 8'-8"	AWNING	8'-0"	---
13	4'-0" 8'-8"	AWNING	8'-0"	---
14	2'-8" 8'-10"	CASEMENT	7'-8"	---
15	2'-8" 8'-10"	CASEMENT	7'-8"	---
16	11'-4" 7'-3"	FIXED	13'-0"	---
17	2'-4" 8'-8"	CASEMENT	8'-0"	---
18	2'-4" 8'-8"	CASEMENT	8'-0"	---

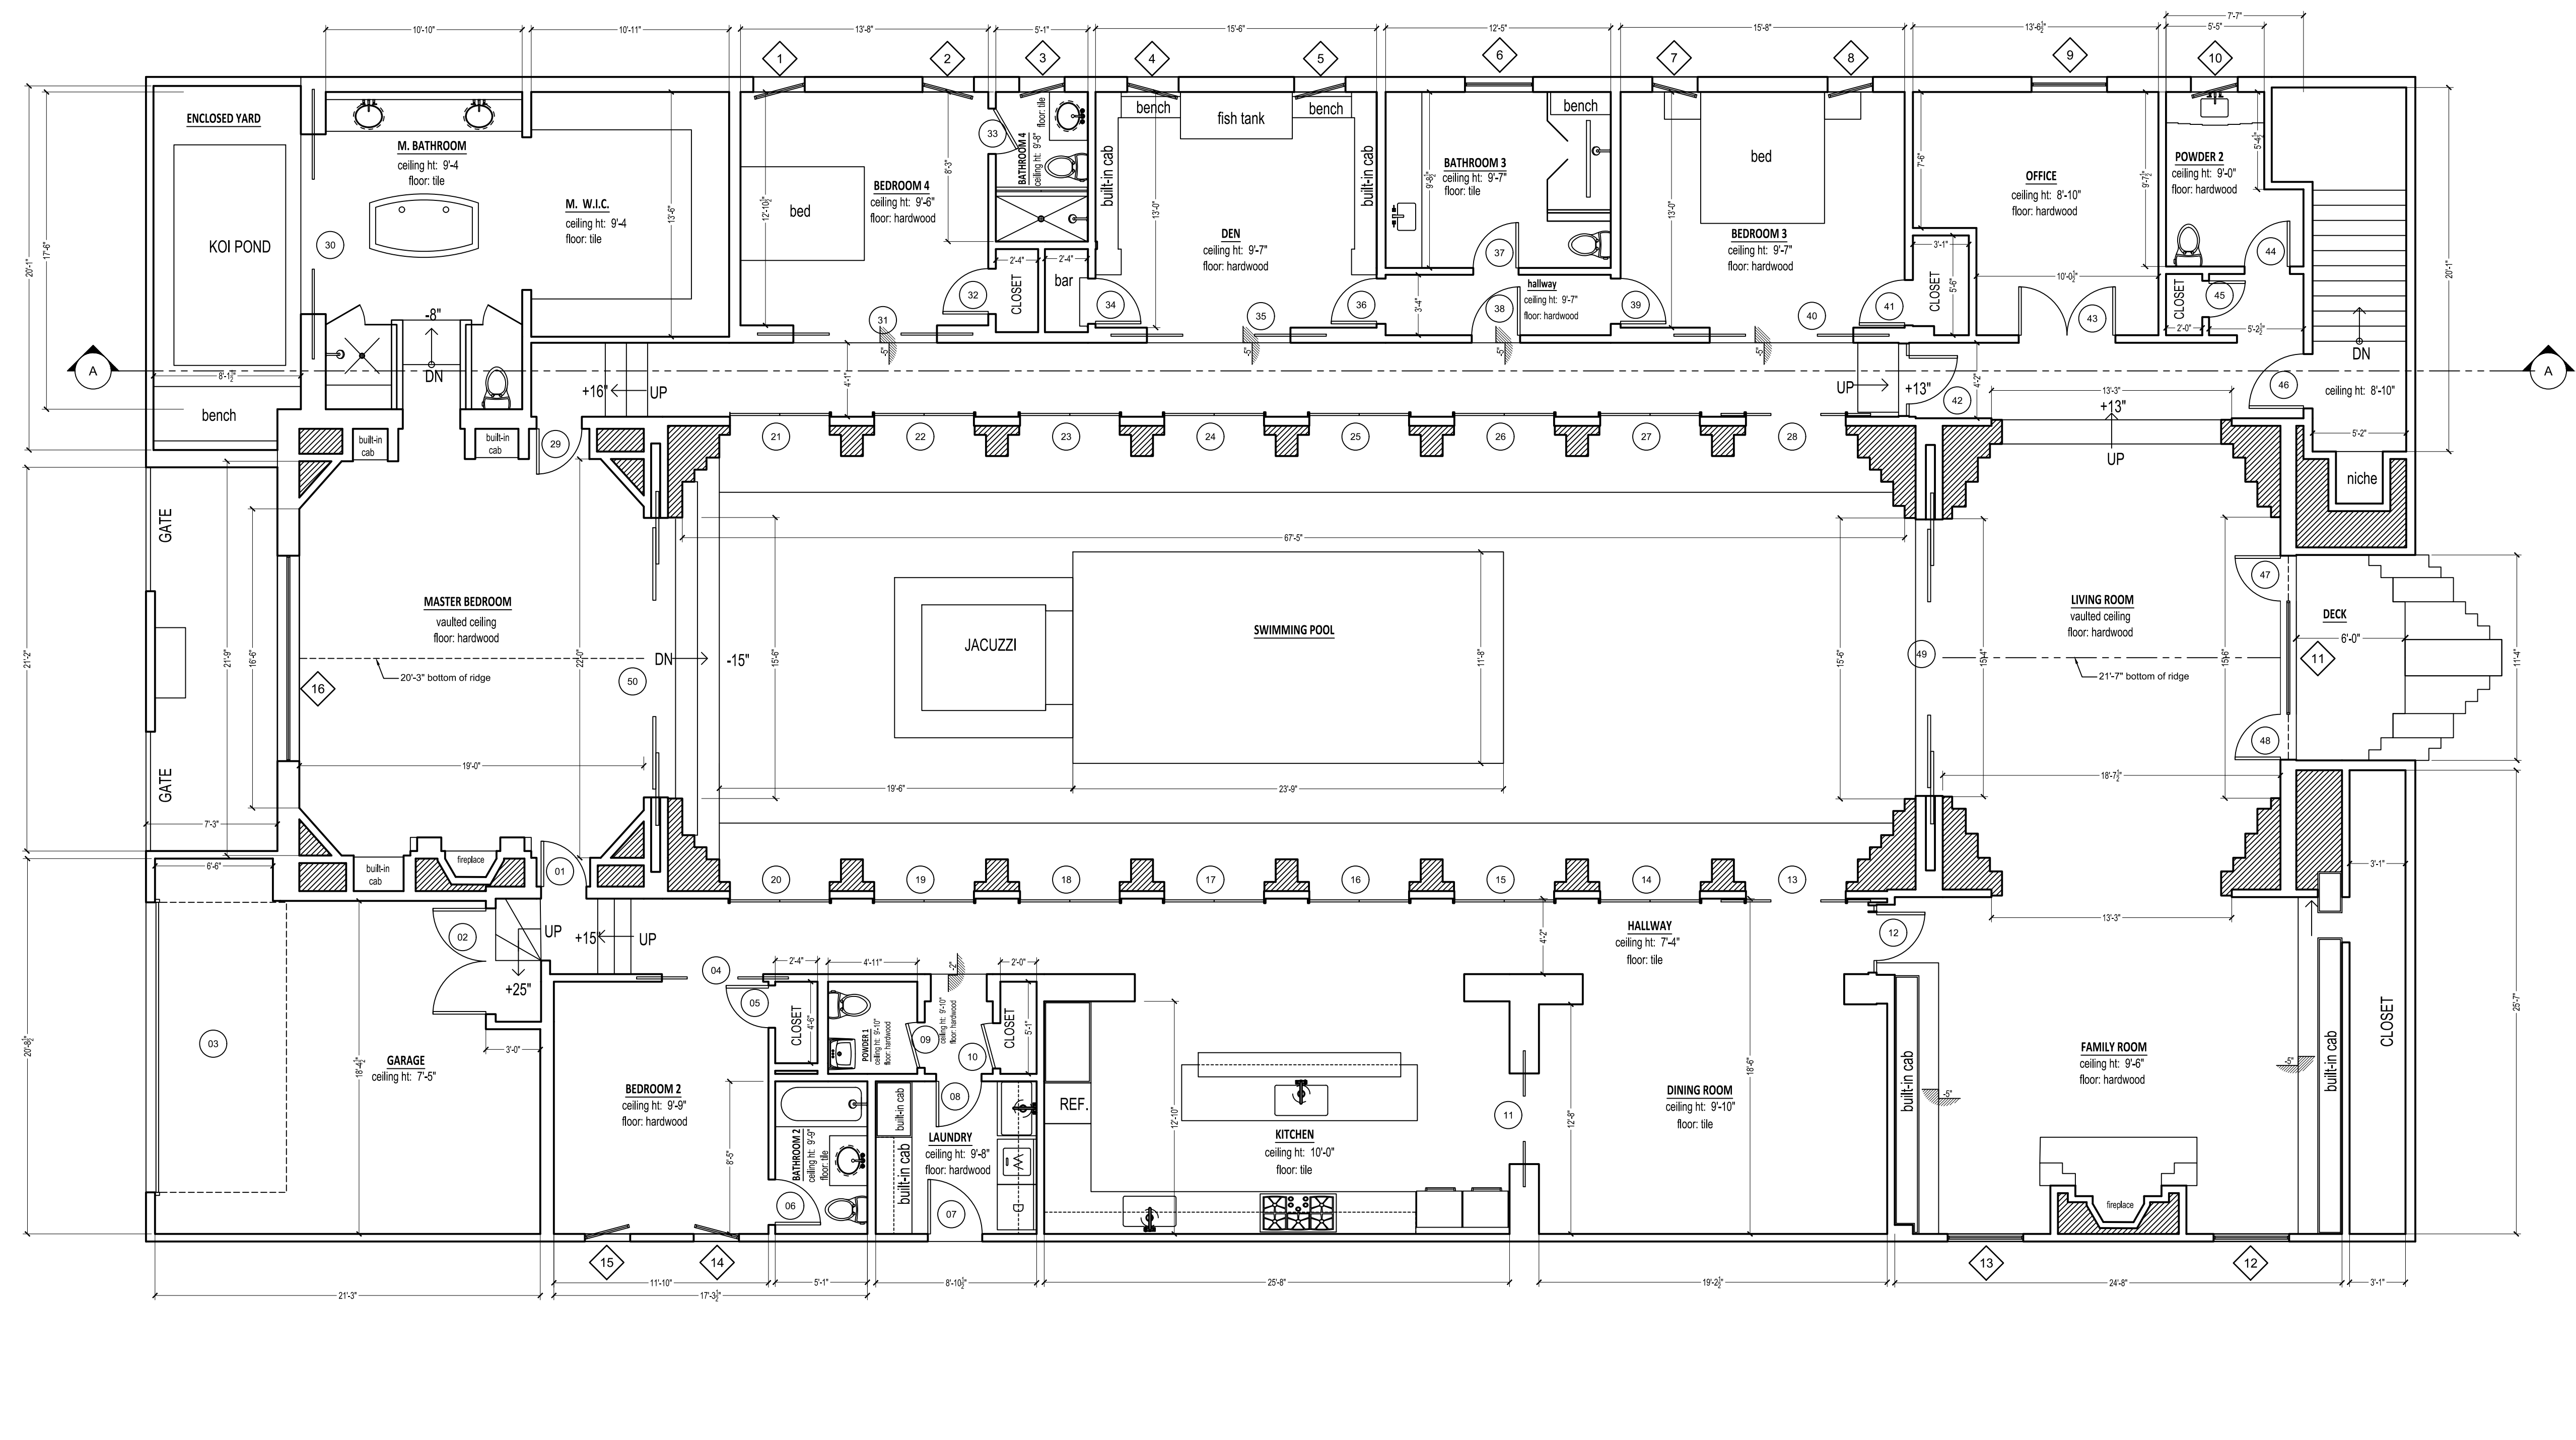

FLOOR PLAN
 0 2'-8" 5'-4" 10'-8"
 SCALE: 3/16" = 1'-0"

REVISIONS	BY

AS-BUILT
LOS ANGELES


Sheet content :
FLOOR PLANS

Project :
**5121 FRANKLIN AVE,
LOS ANGELES, CA 90027**



Owner:
Date
Scale
Drawn
Job
Sheet

A-3


08.08.13

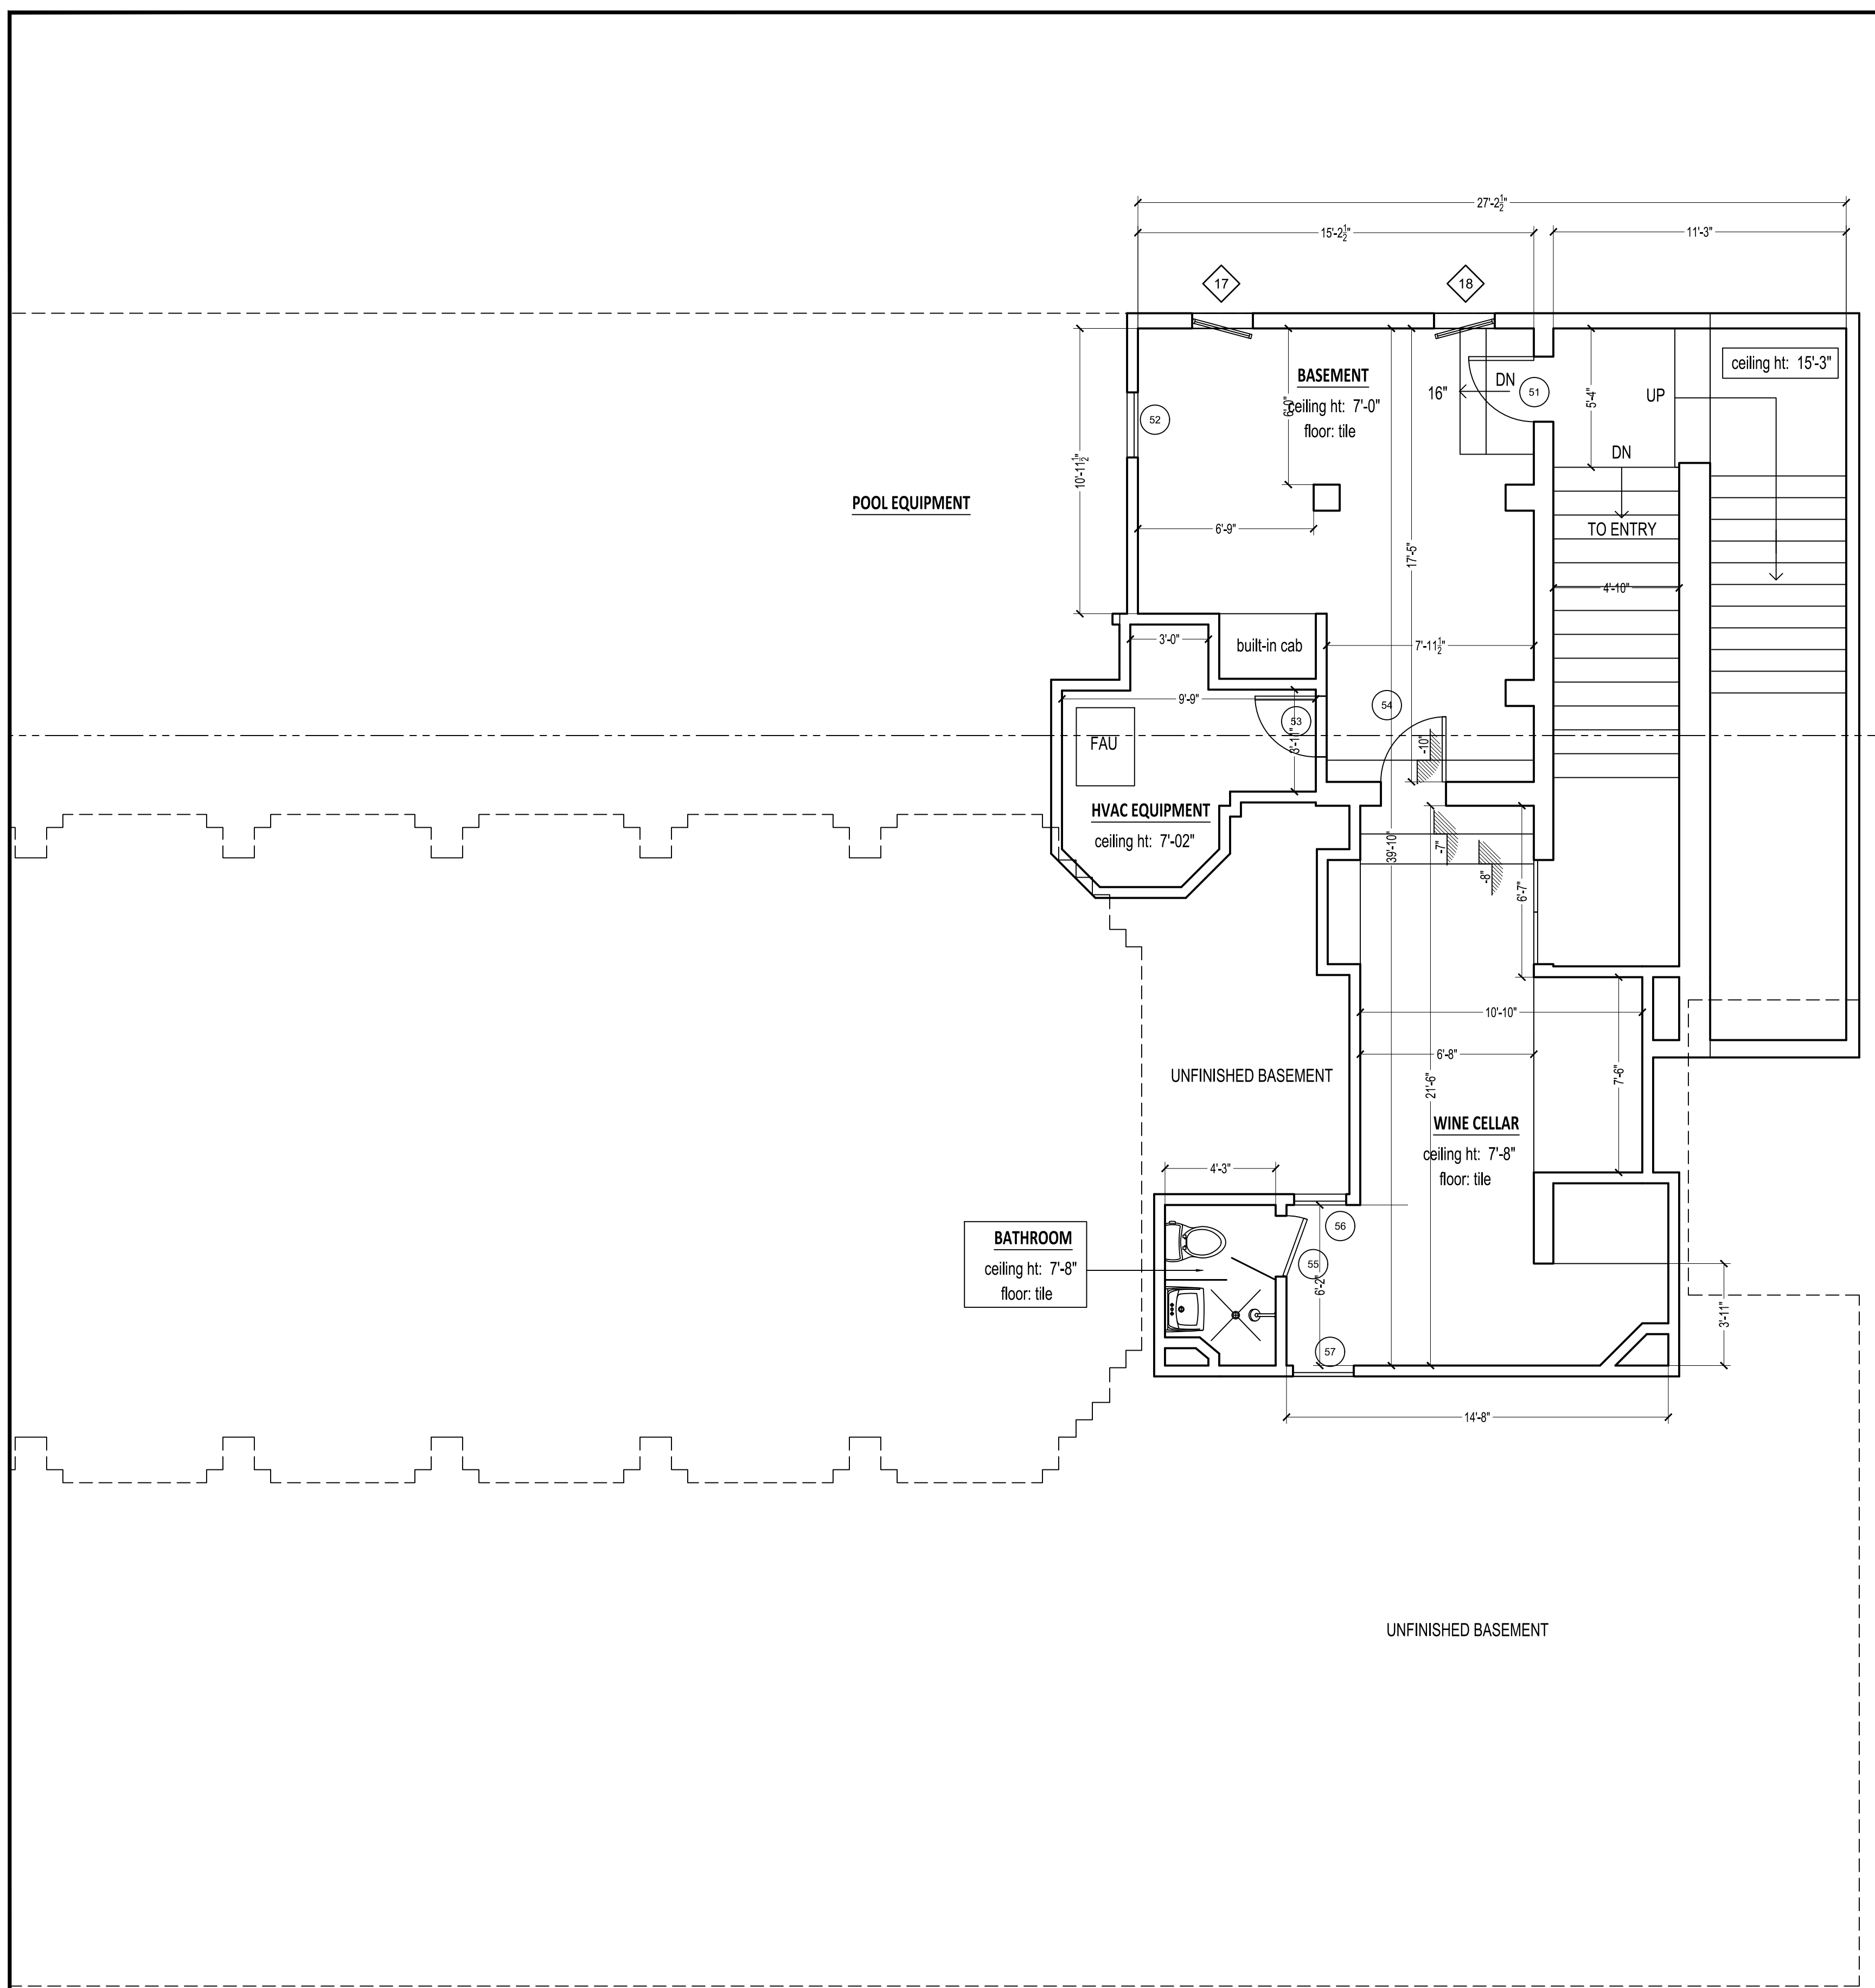

BASEMENT FLOOR PLAN

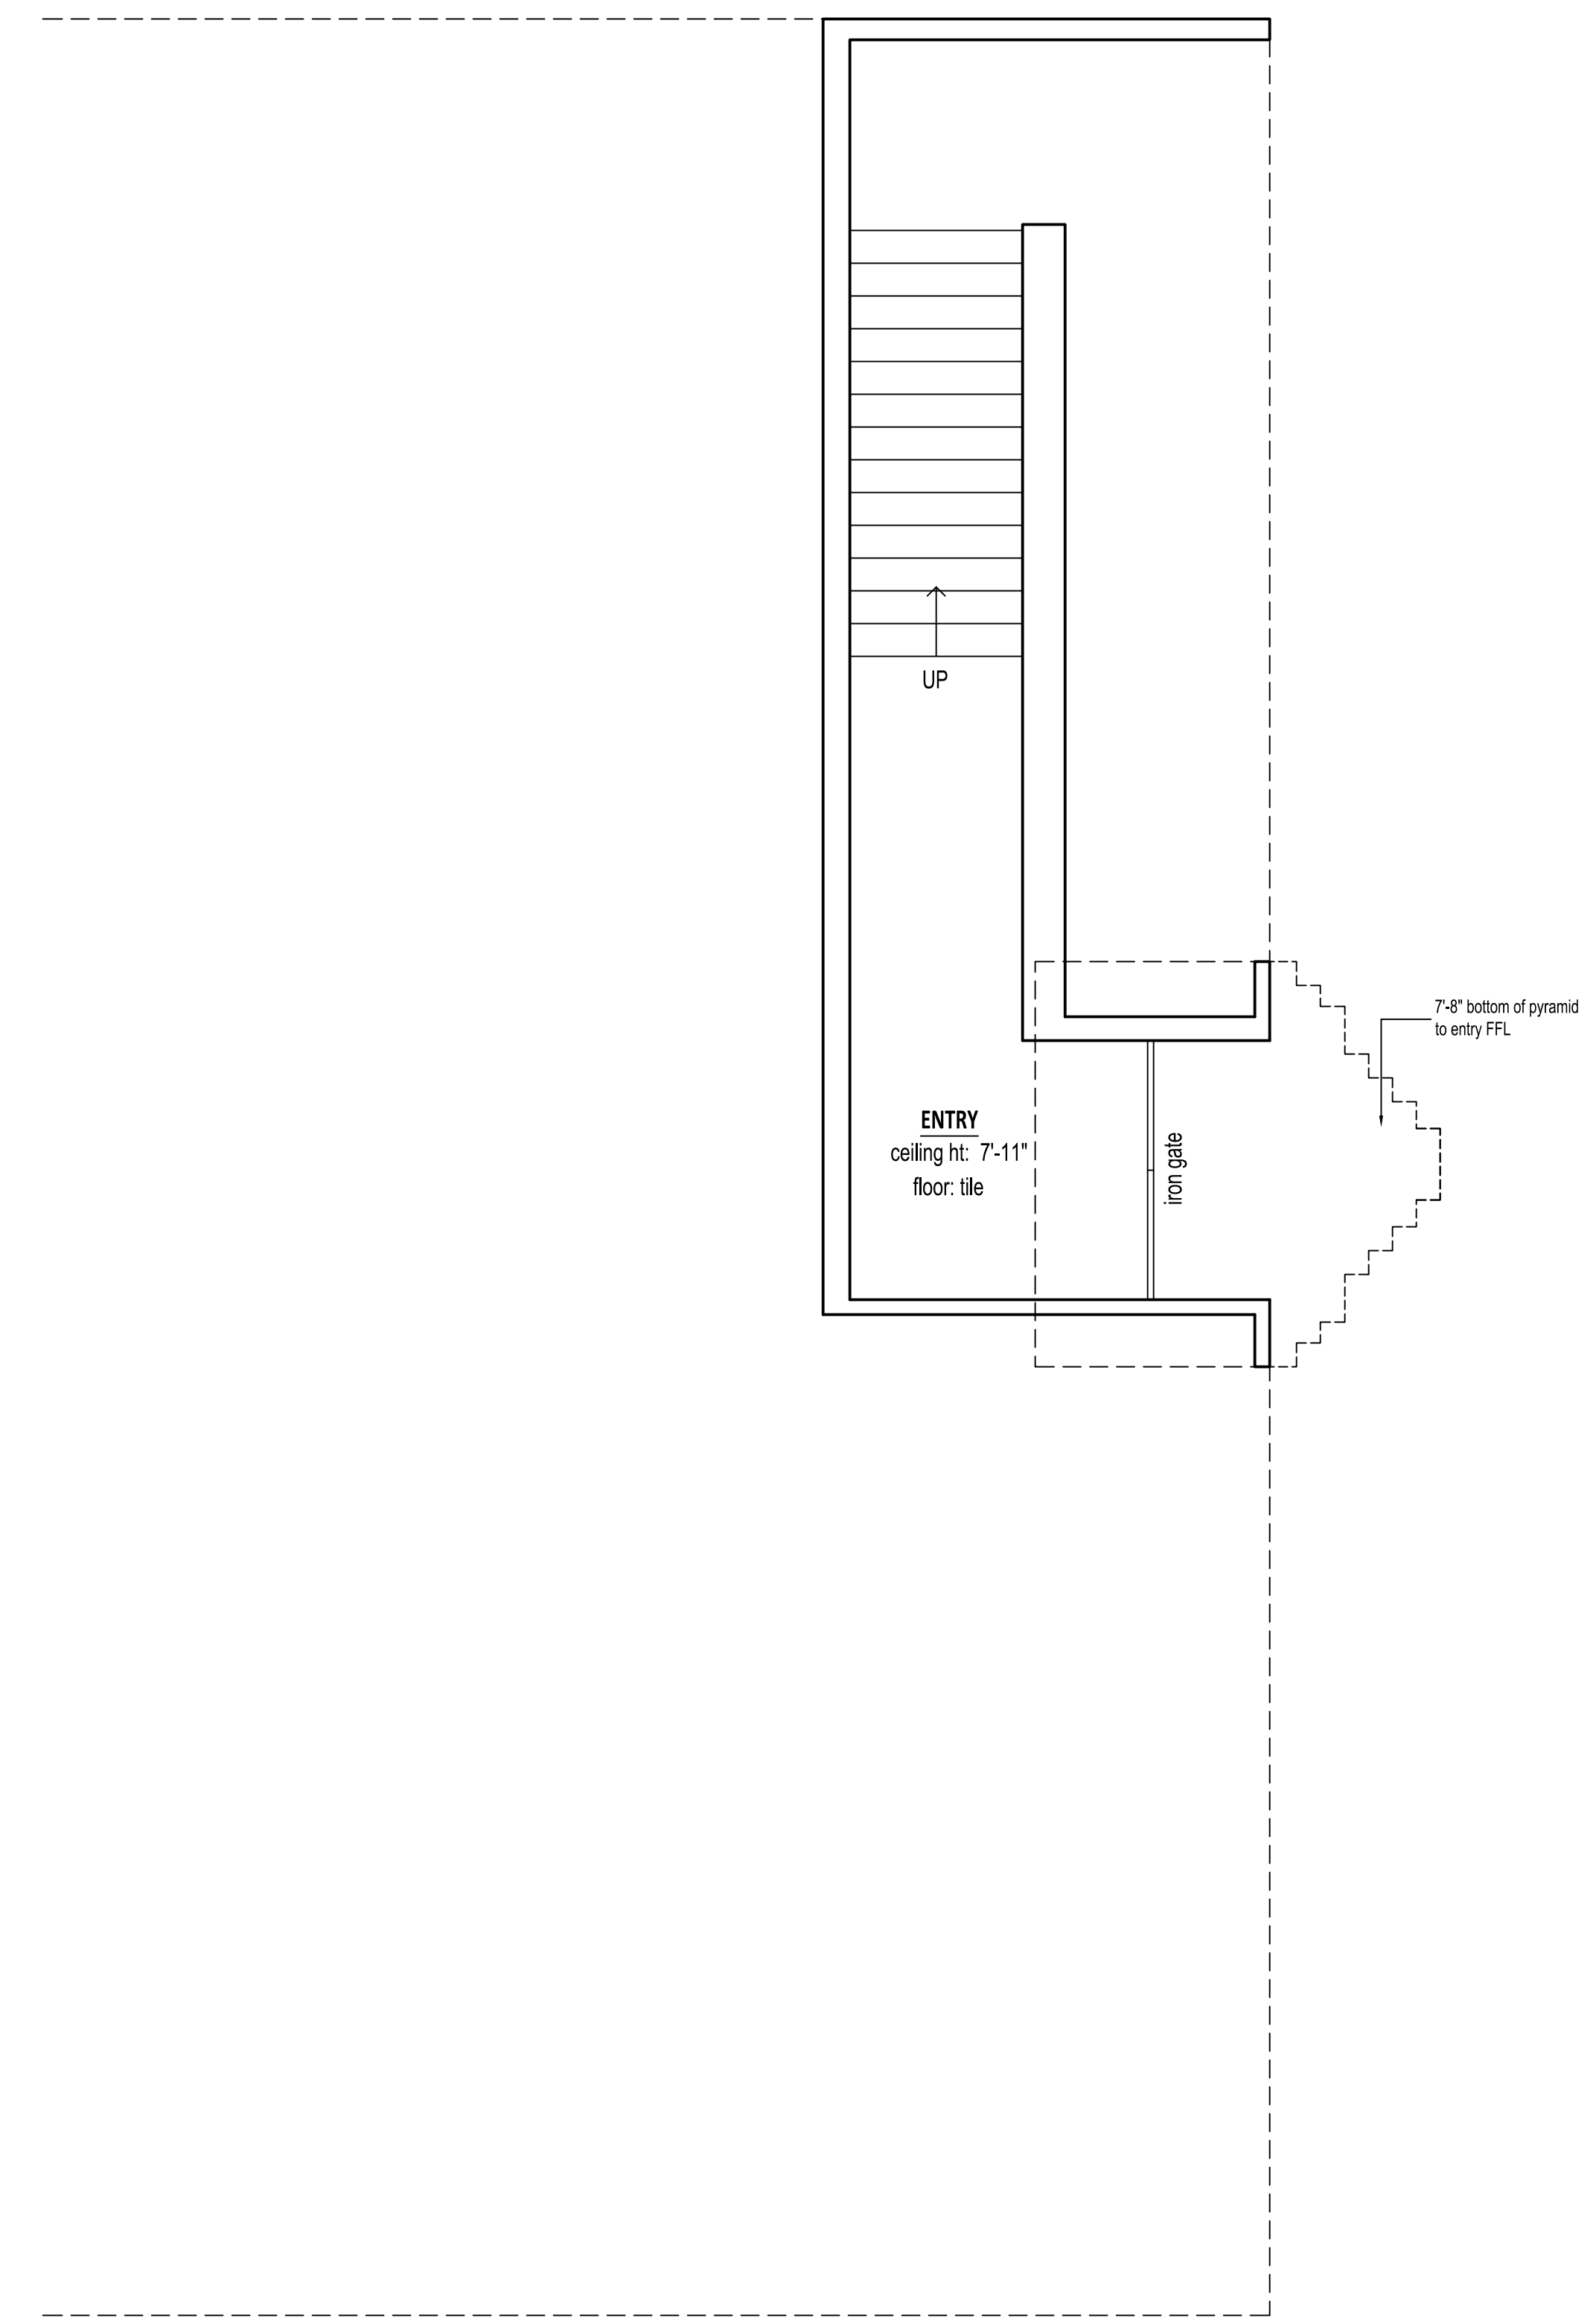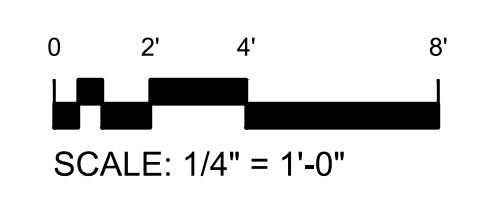

ENTRY FLOOR PLAN

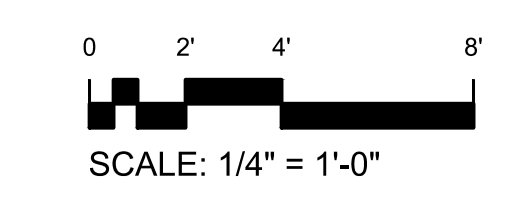

REVISIONS BY

AS-BUILT
LOS ANGELES

Sheet content:
ELEVATIONS

Project:
**5121 FRANKLIN AVE,
LOS ANGELES, CA 90027**

Owner:

Date

Scale



Drawn


Job

Sheet

A-4


08.26.13

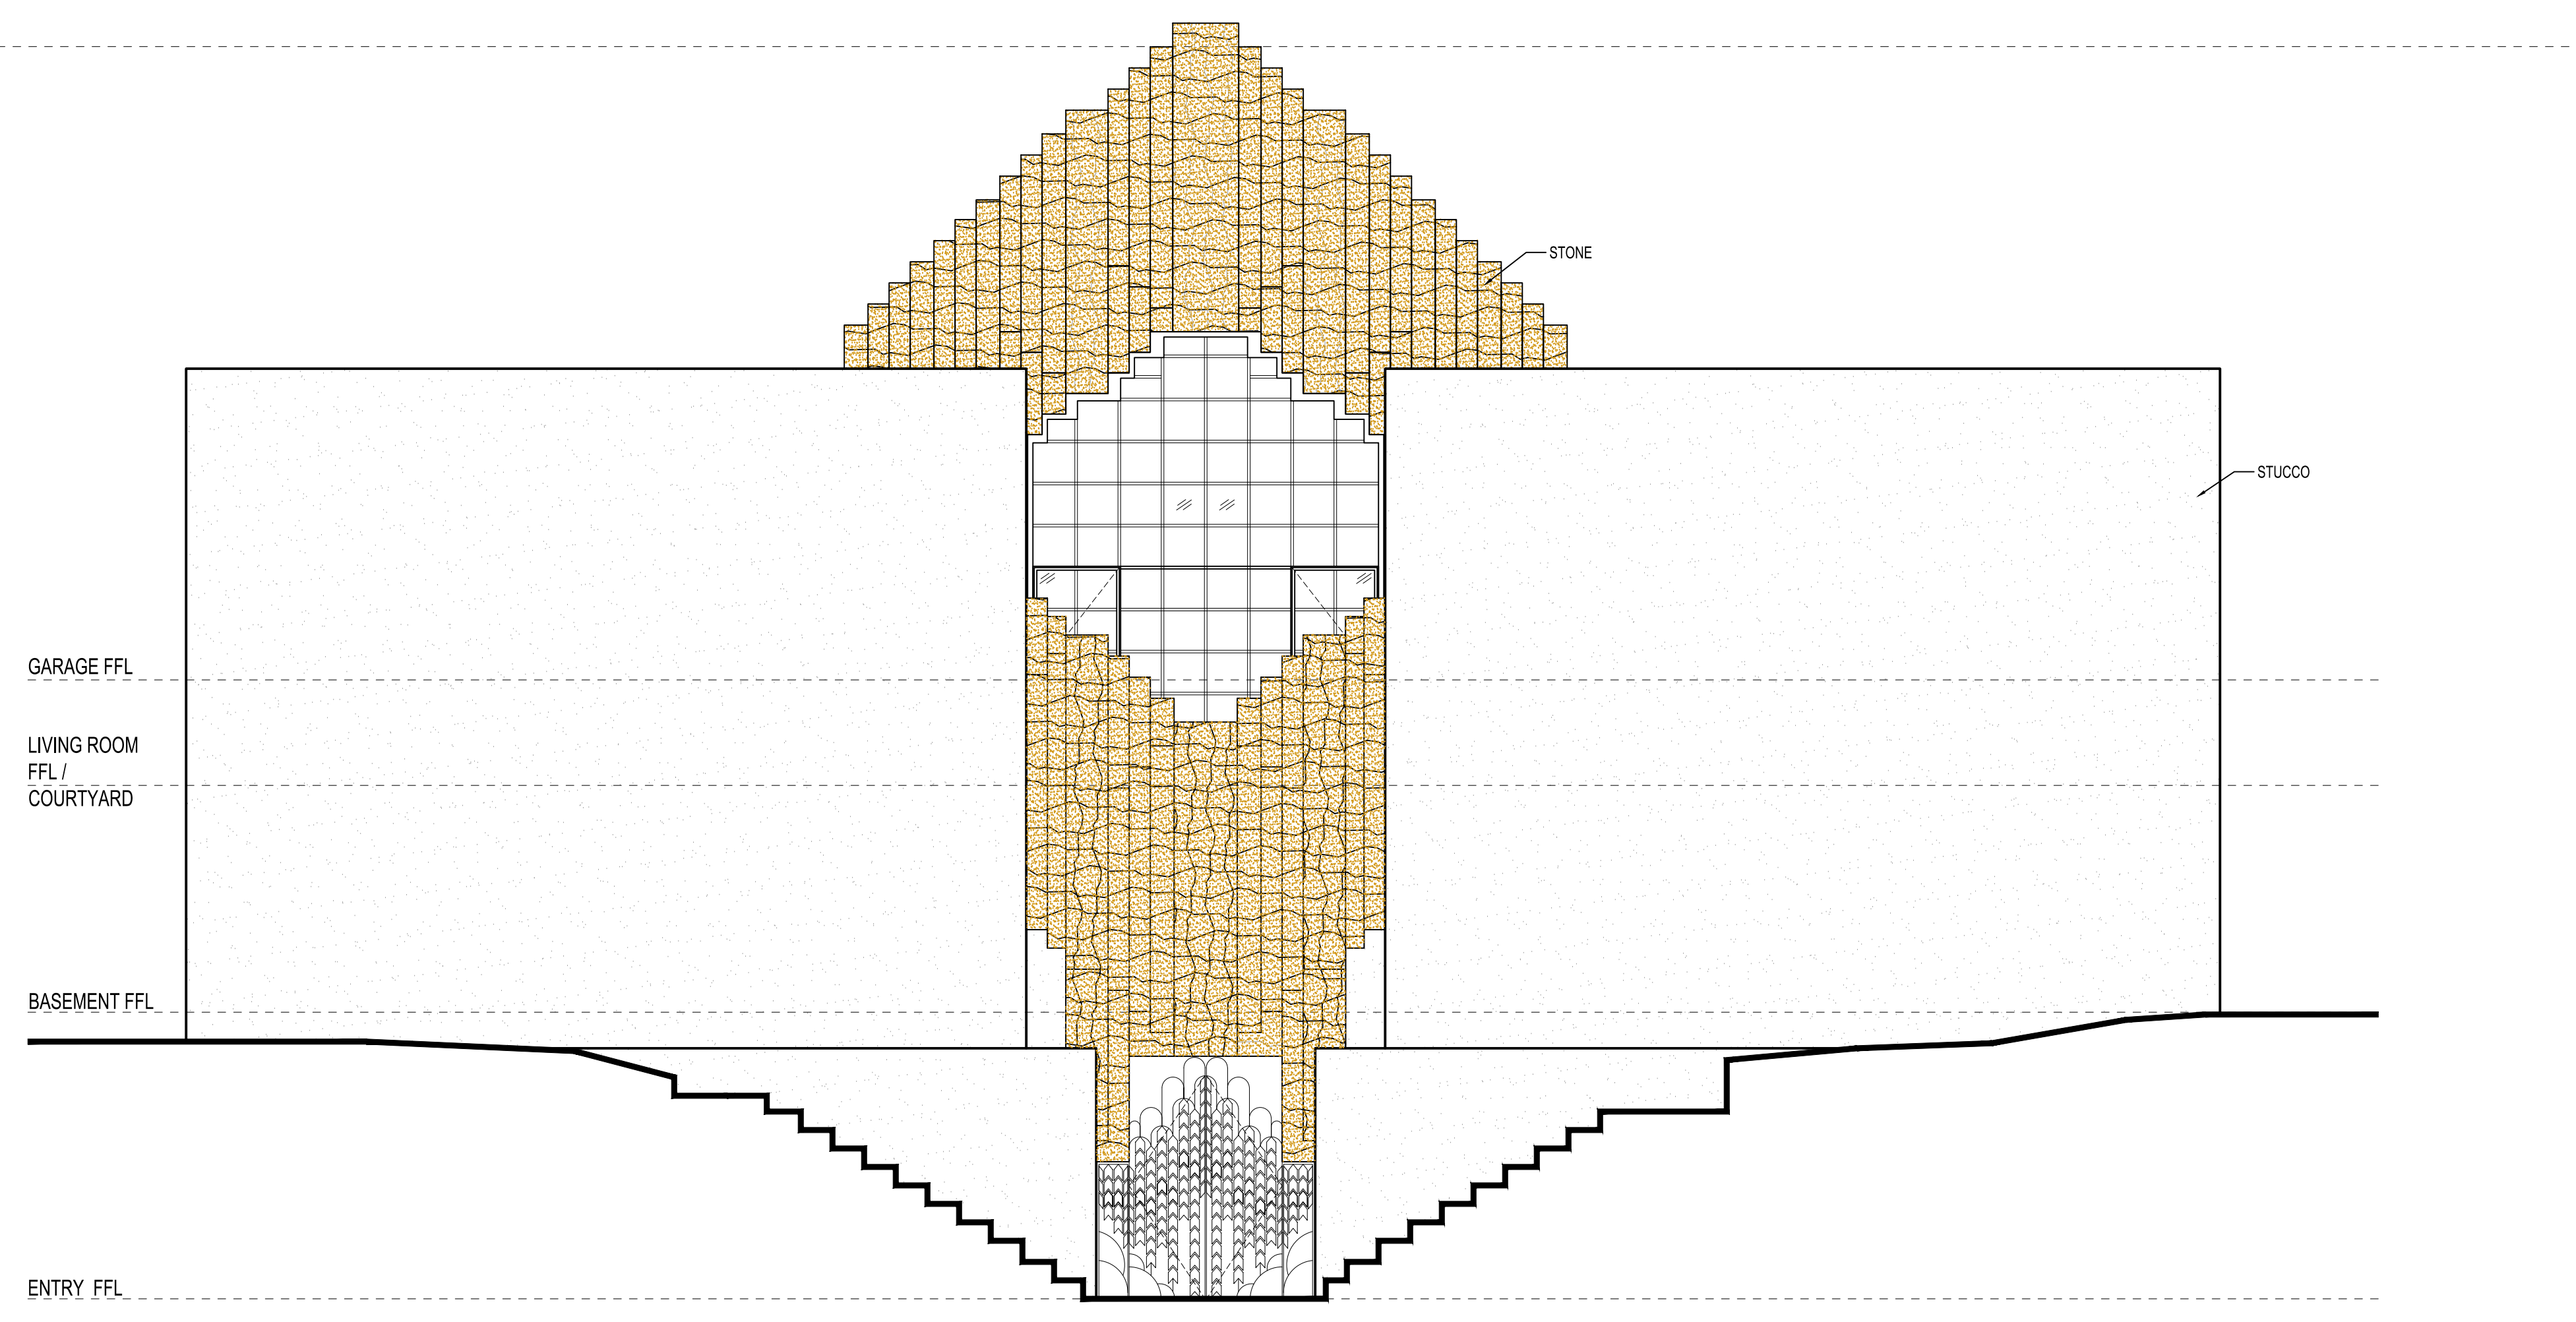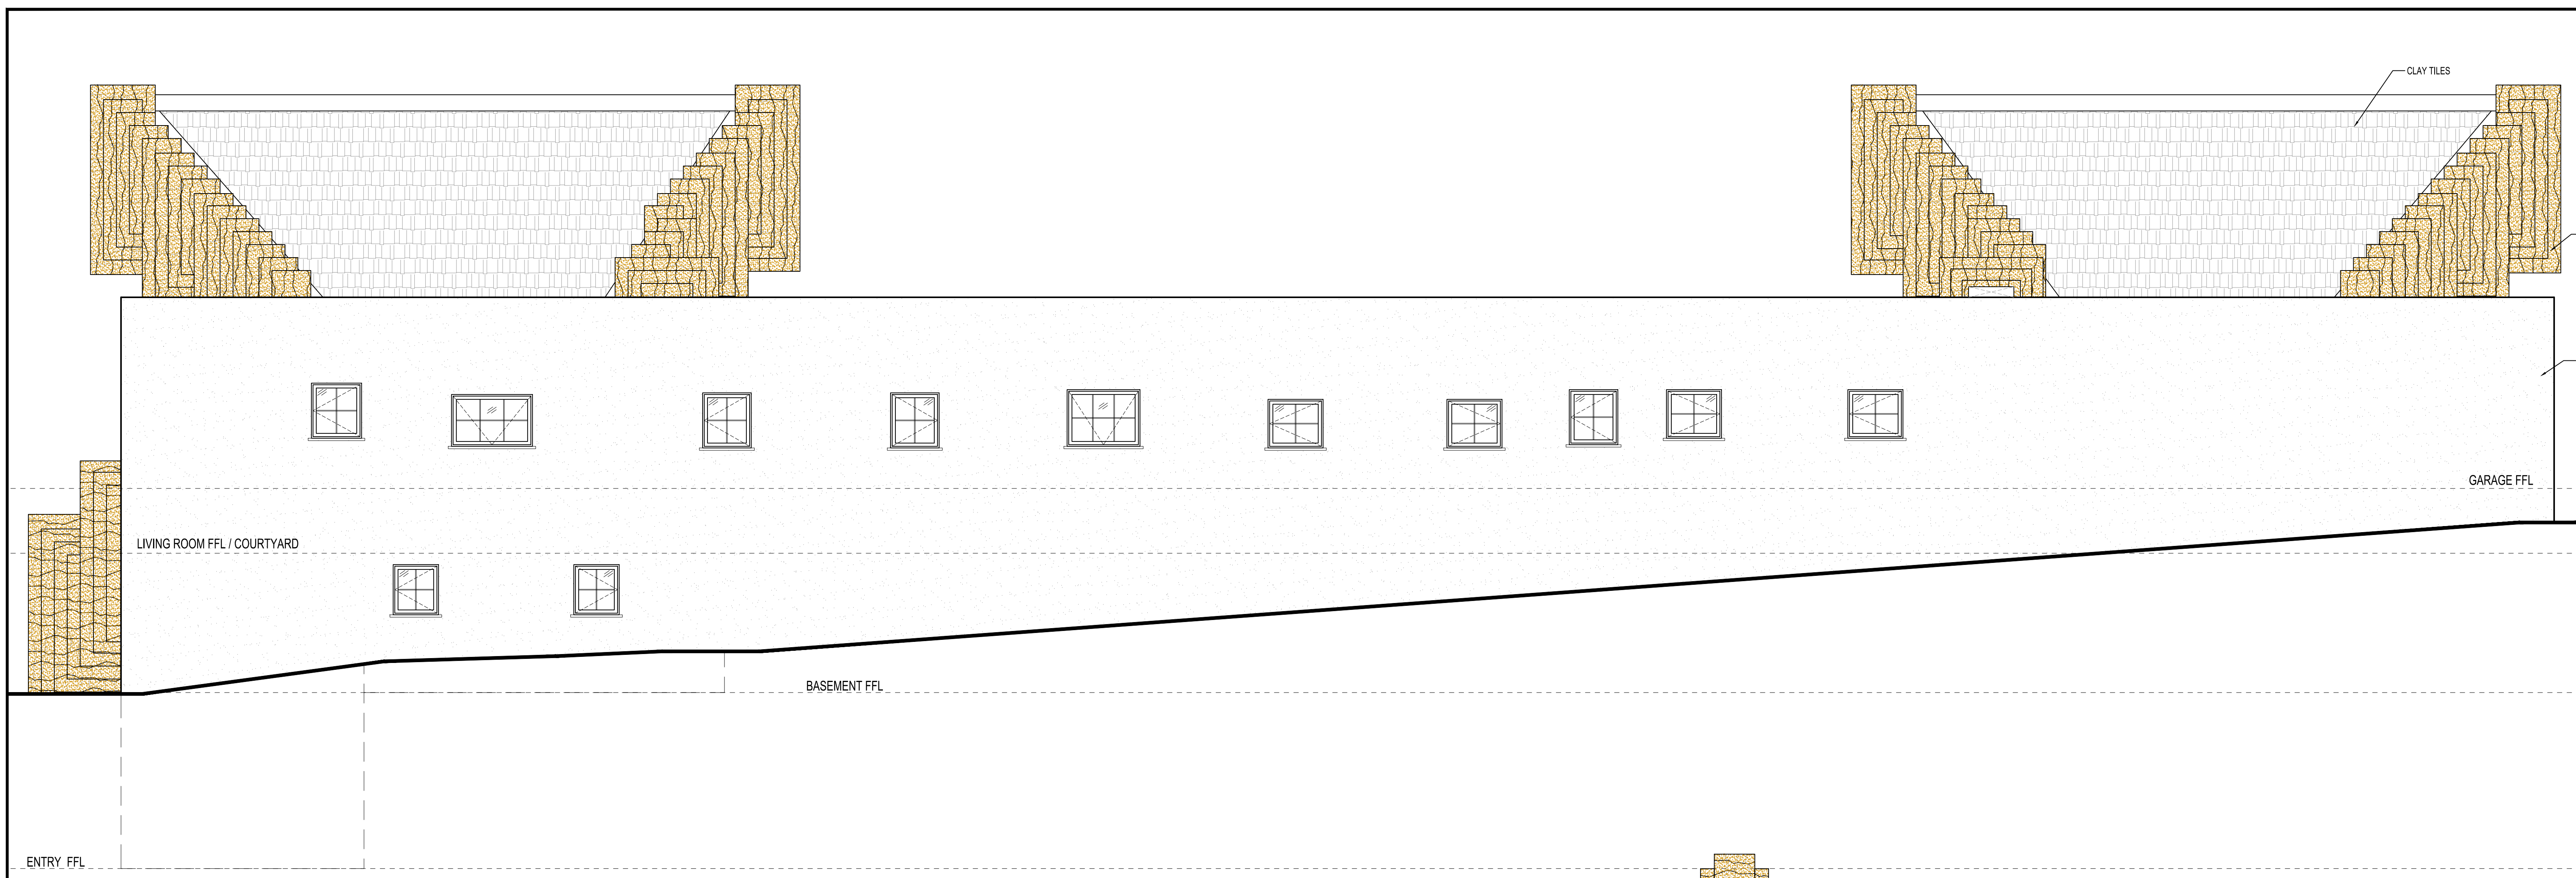

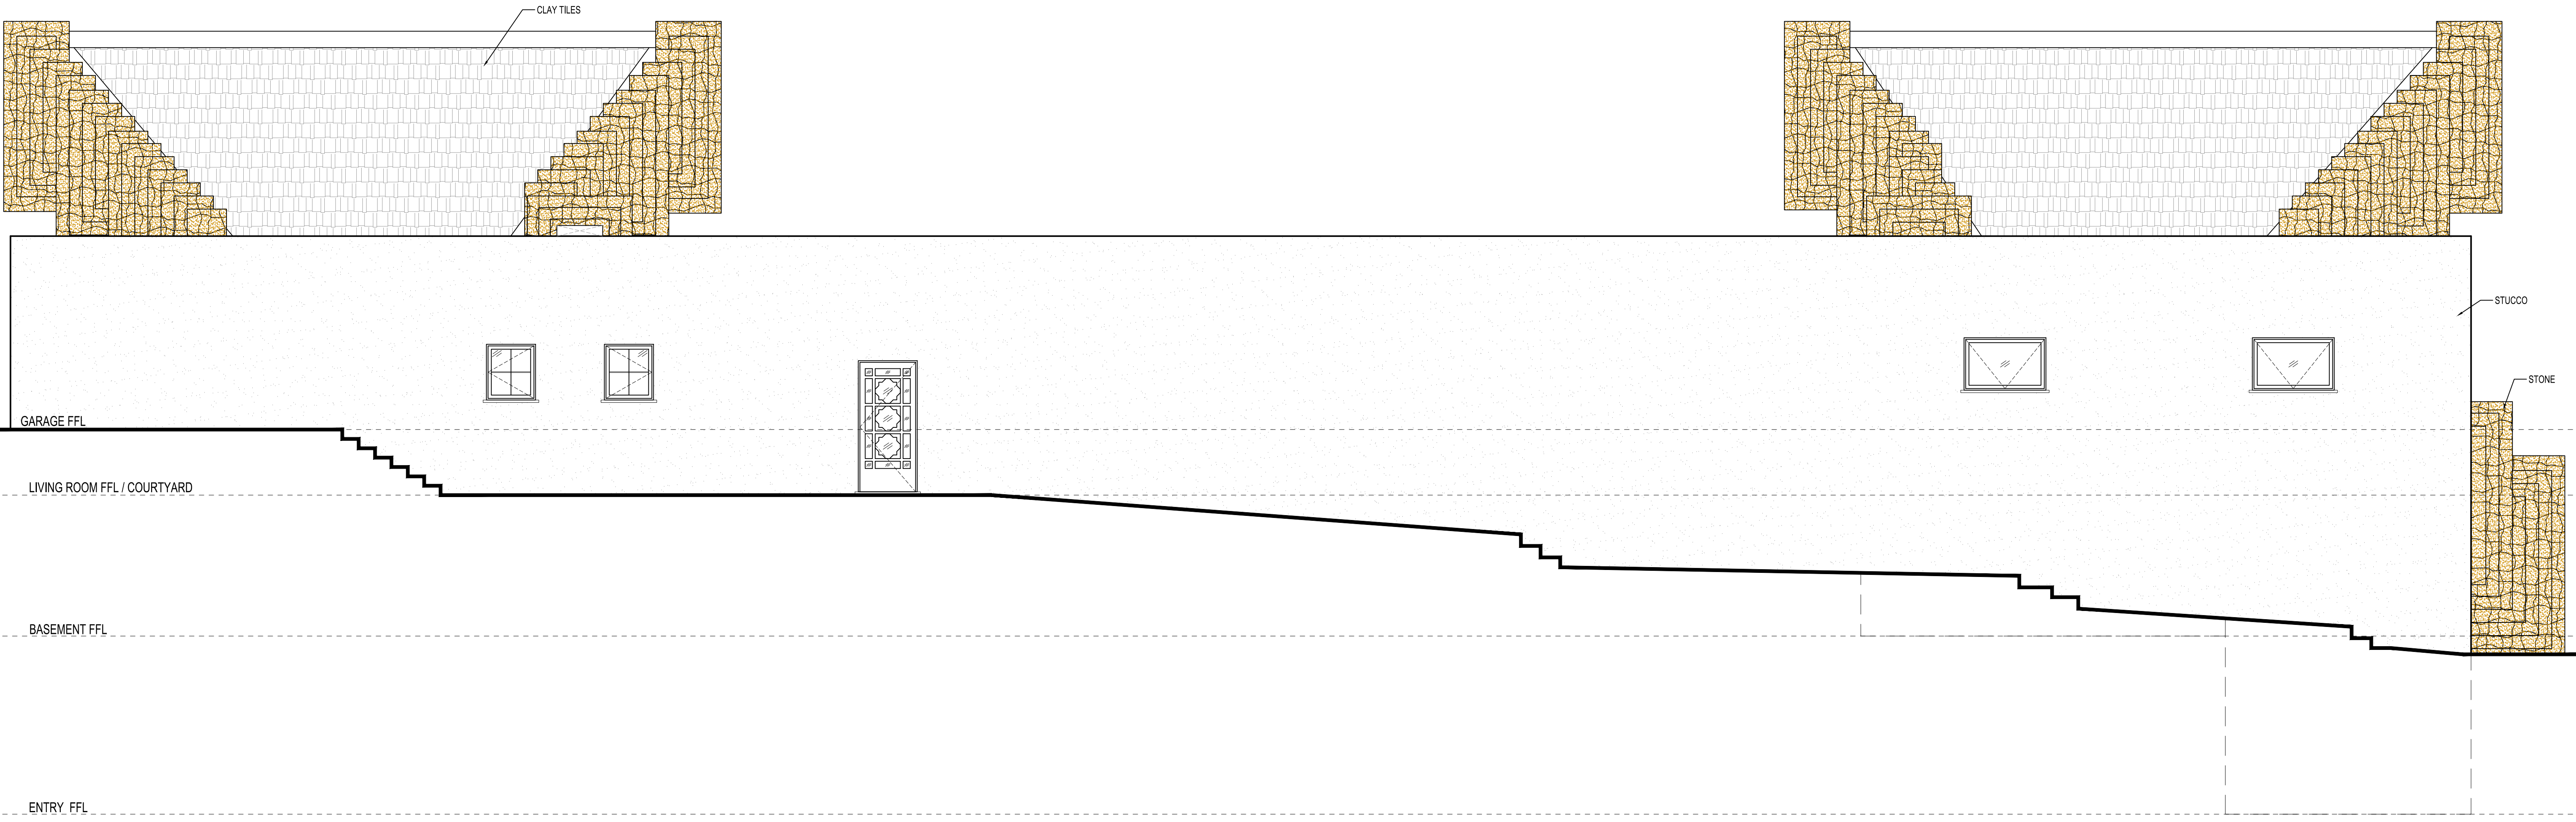

3 W. ELEVATION

SCALE: 1/4" = 1'-0"

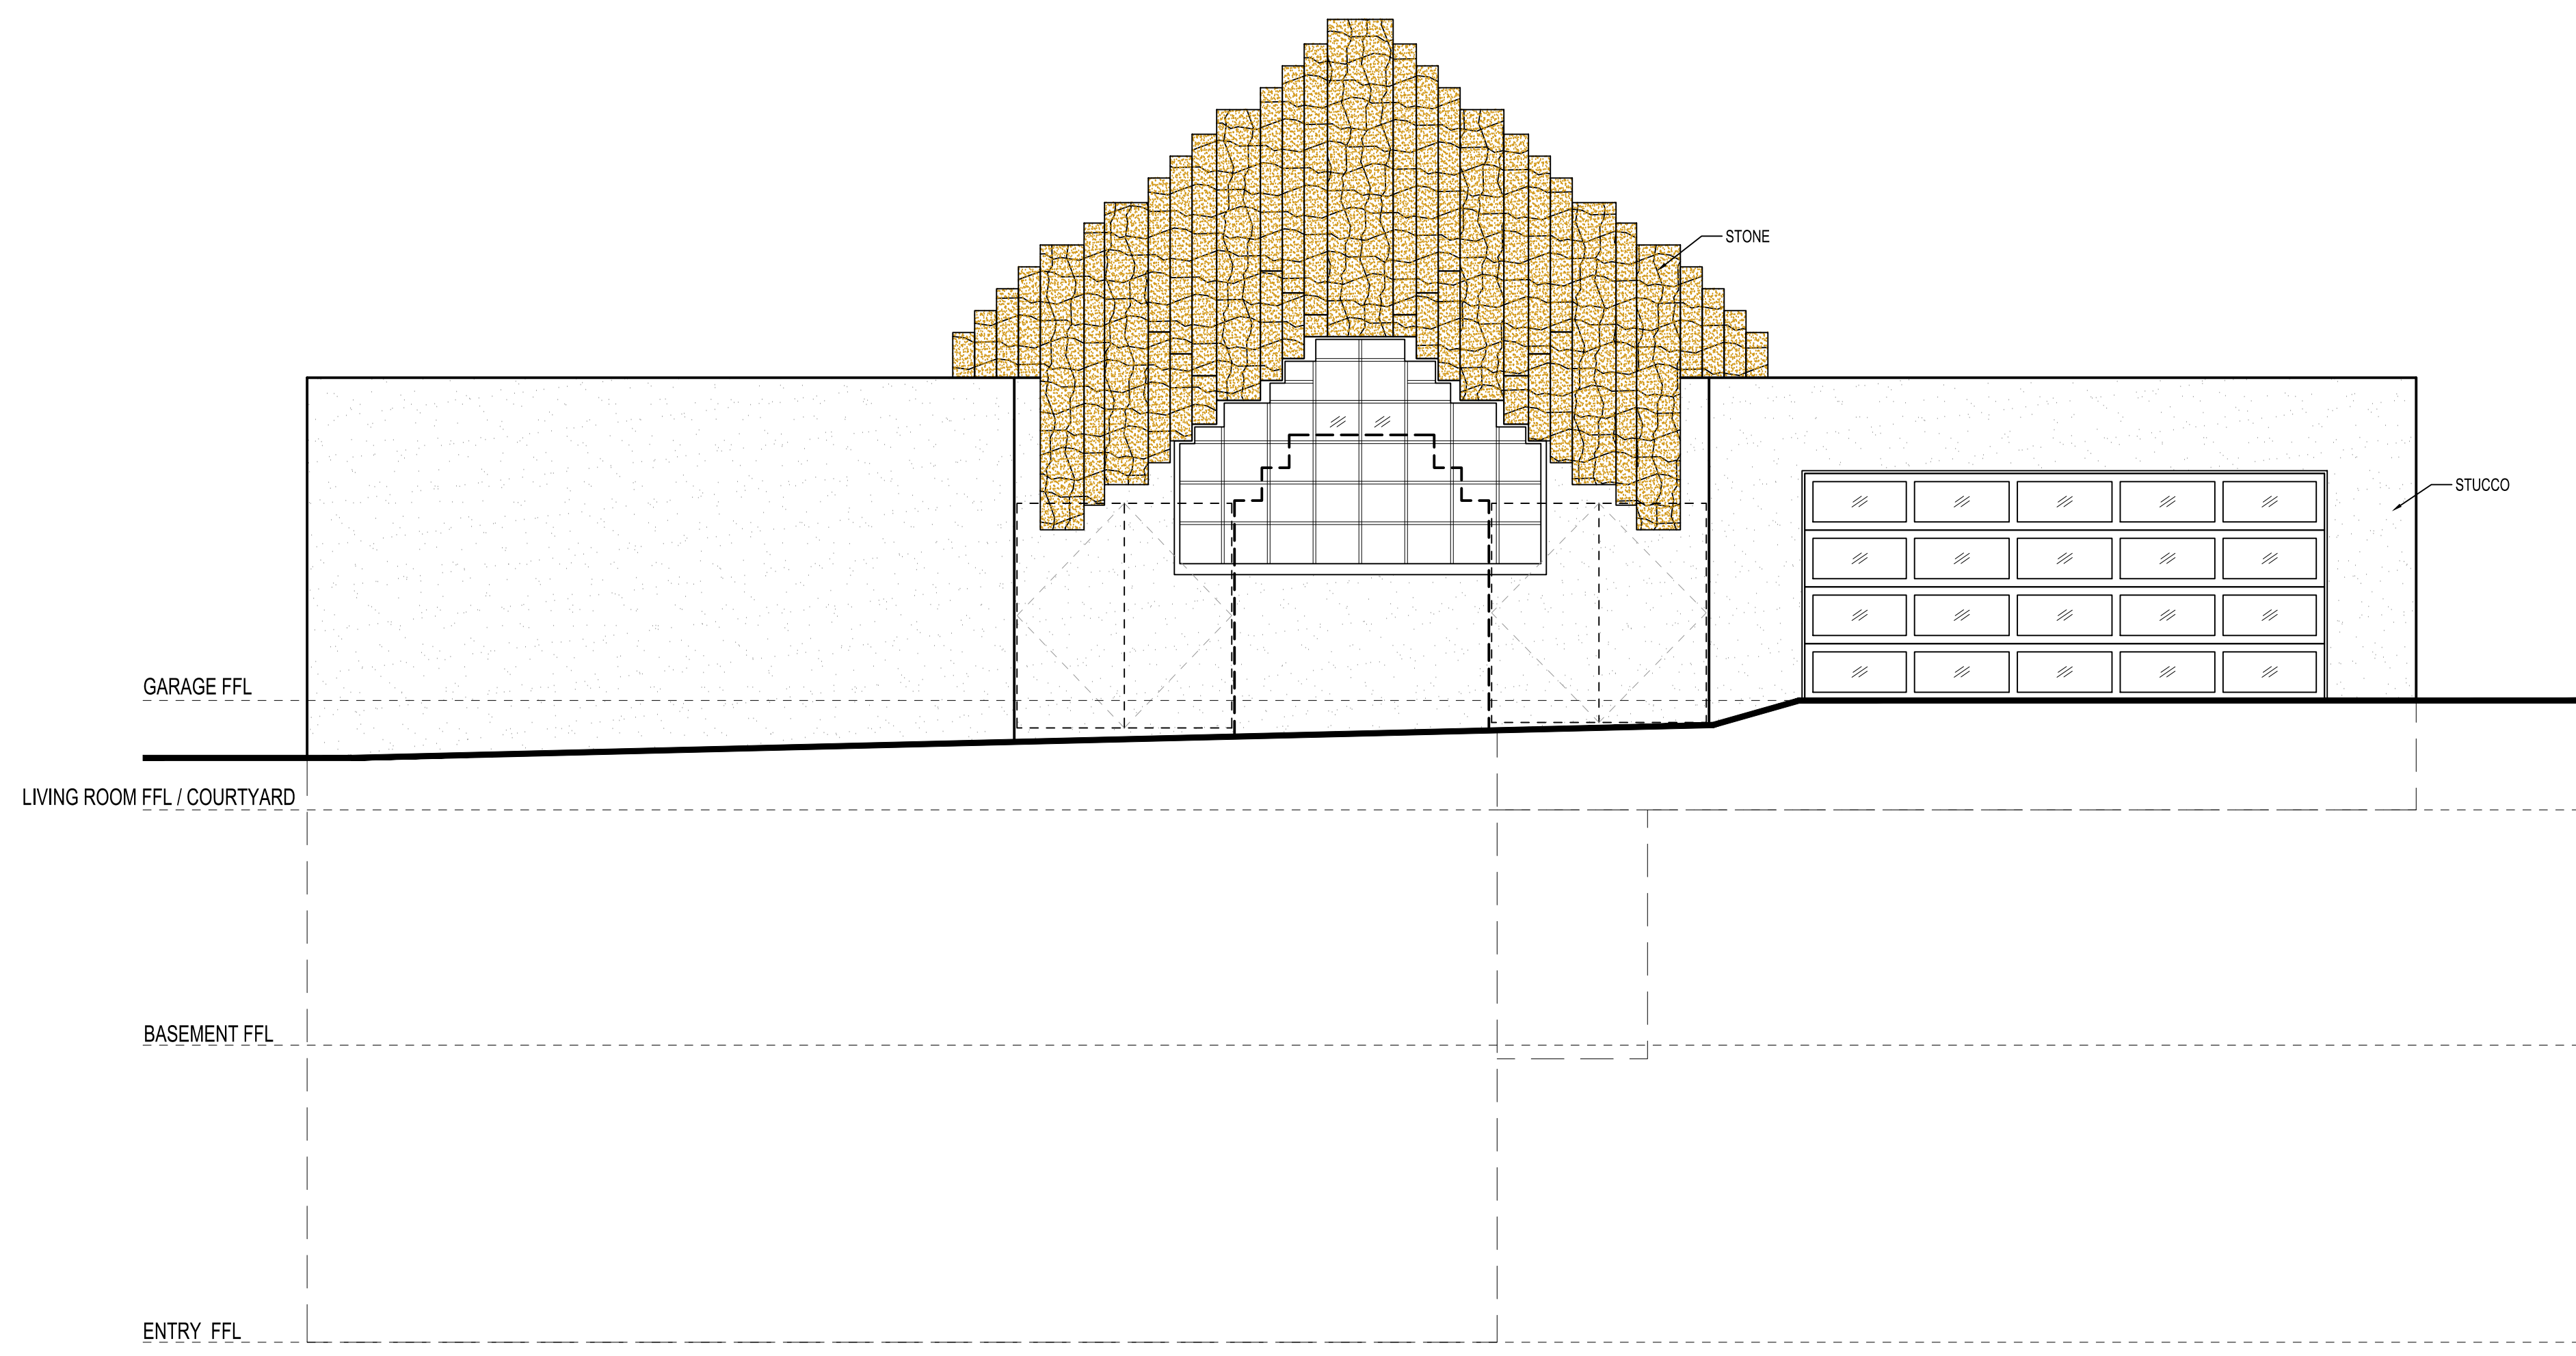

4 N. ELEVATION

SCALE: 1/4" = 1'-0"

REVISIONS	BY

AS-BUILT
LOS ANGELES

Sheet content :
ELEVATIONS

Project :
5121 FRANKLIN AVE,
LOS ANGELES, CA 90027

Owner:
Date
Scale
Drawn
Job
Sheet

A-5

REVISIONS	BY

AS-BUILT
LOS ANGELES

Sheet content :
SECTION

Project :
5121 FRANKLIN AVE,
LOS ANGELES, CA 90027

Owner:

Date

Scale


Drawn

Job

Sheet

A-6

08.06.13

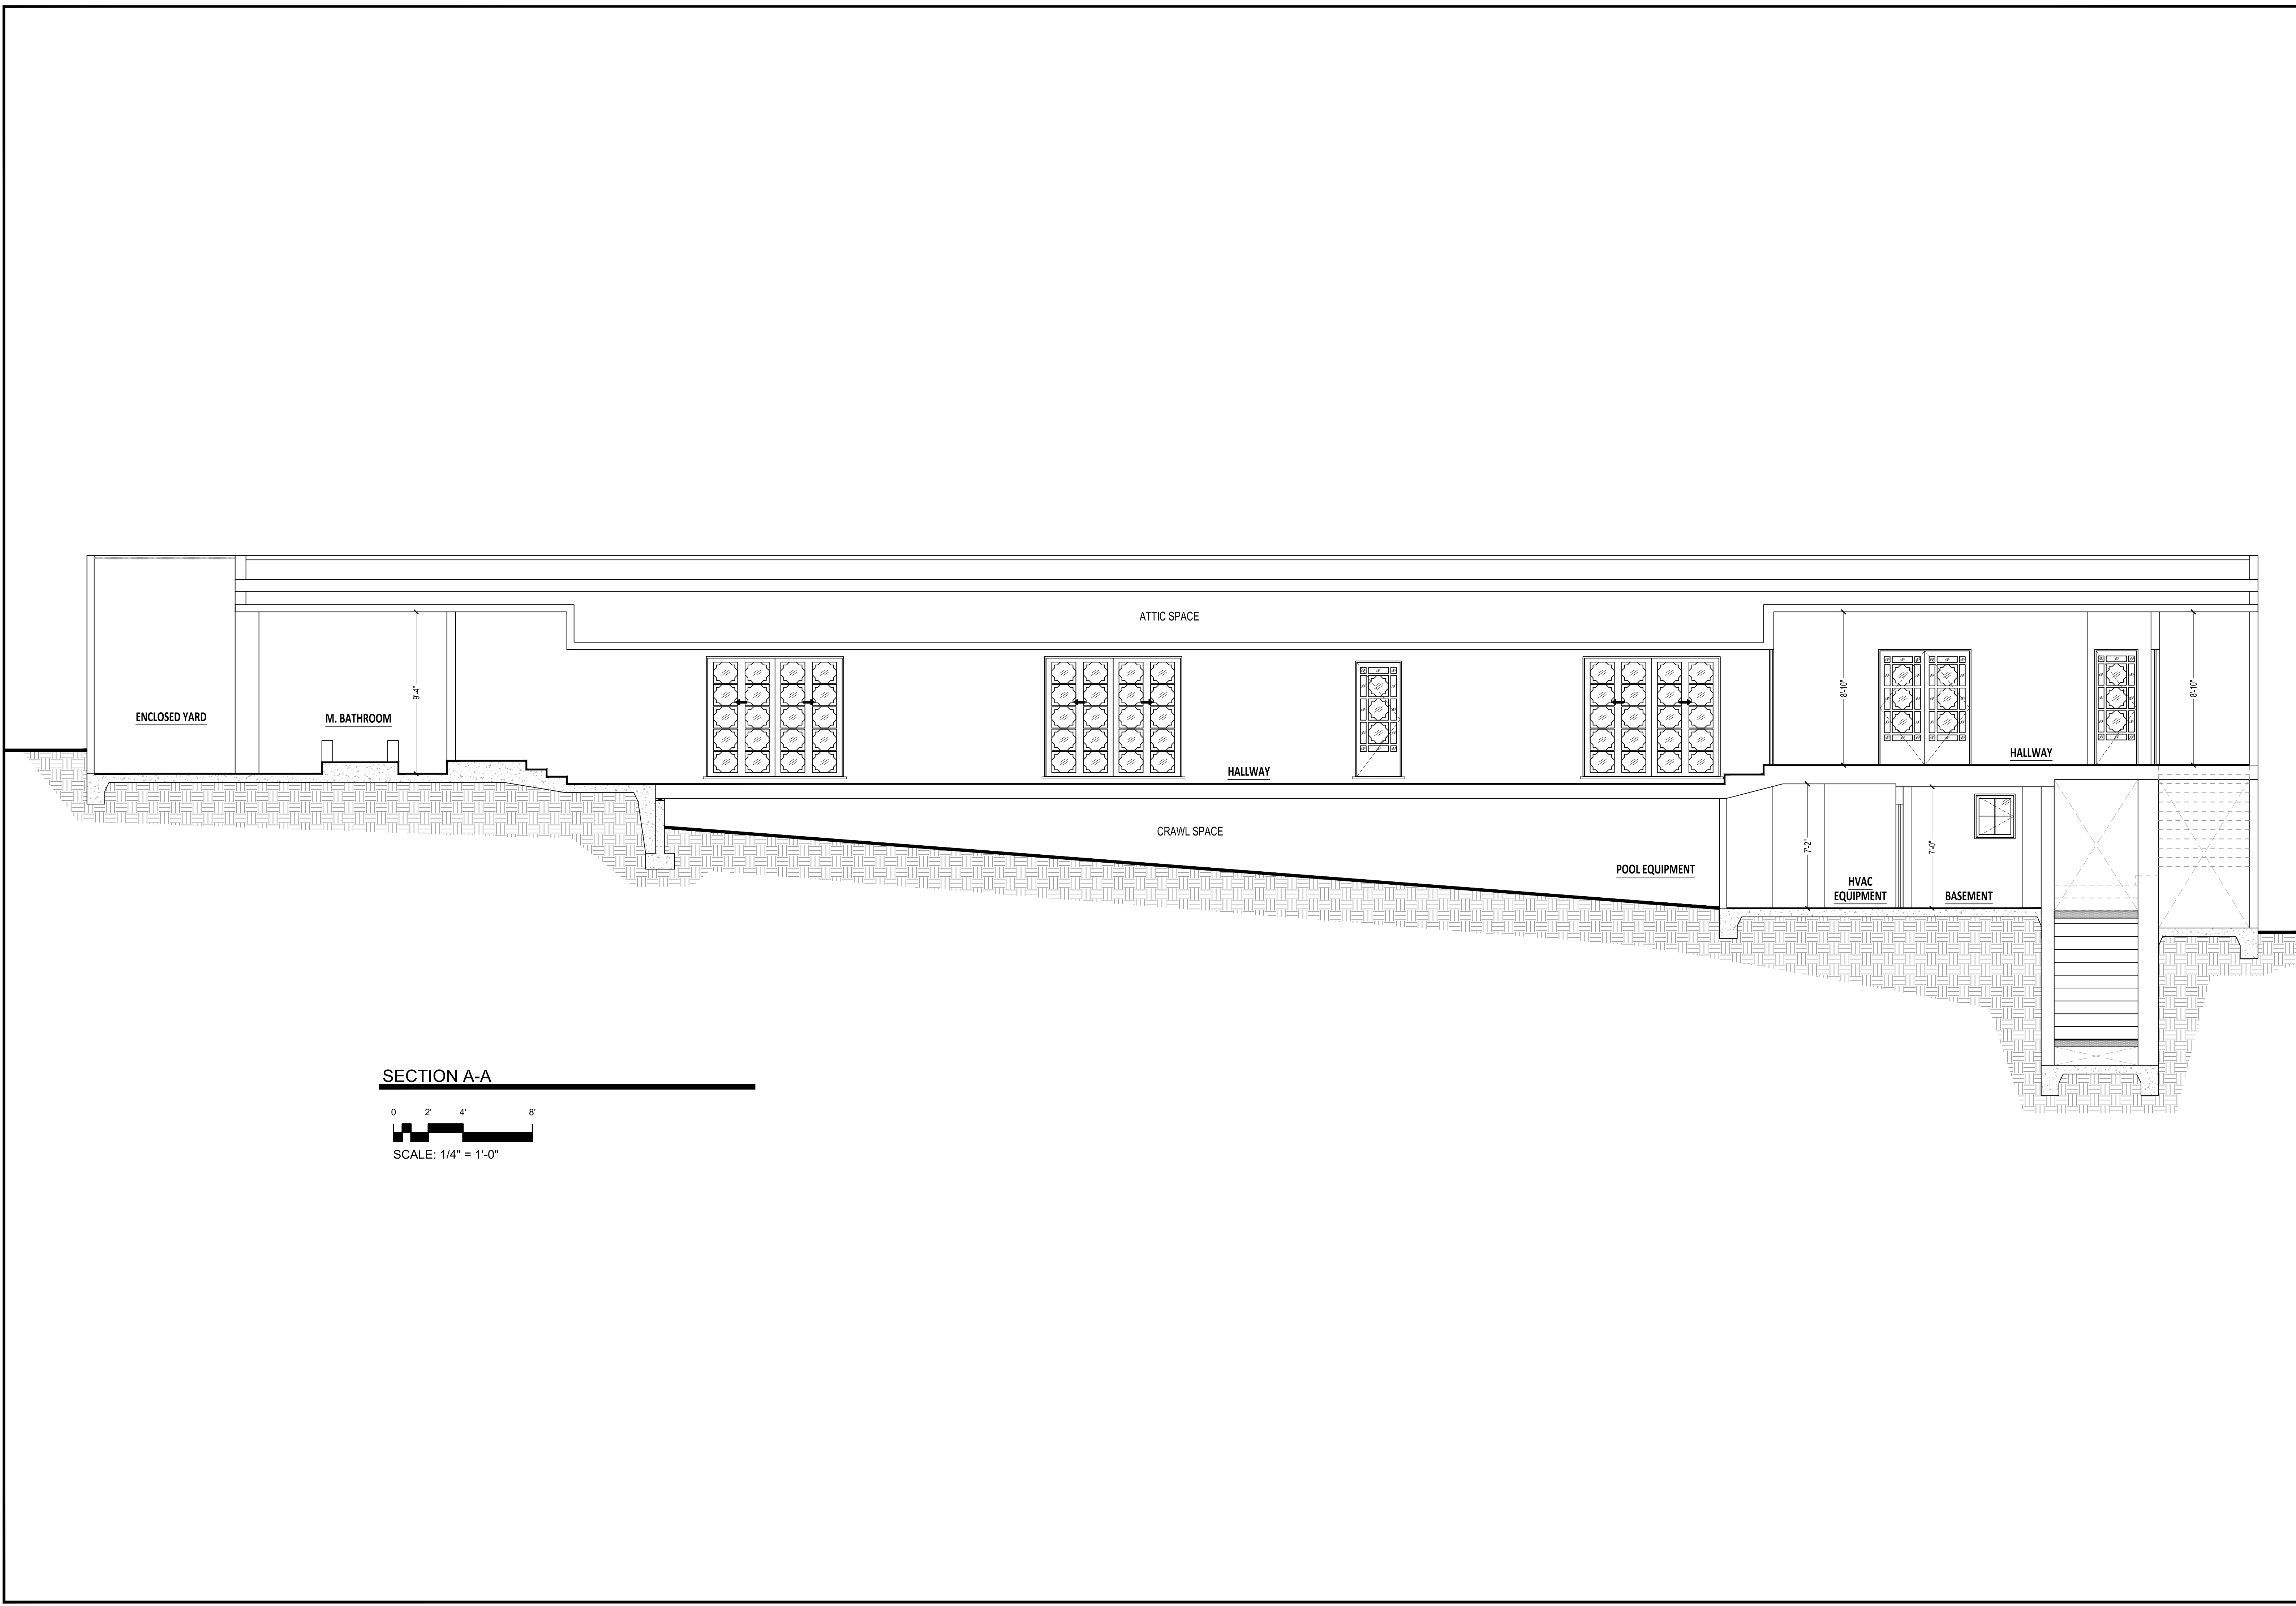

SECTION A-A

SCALE: 1/4" = 1'-0"

REVISIONS	BY


AS-BUILT
LOS ANGELES

Sheet content :
ROOF PLAN


Project :
5121 FRANKLIN AVE,
LOS ANGELES, CA 90027




Owner:
Date
Scale
Drawn
Job
Sheet

A-7

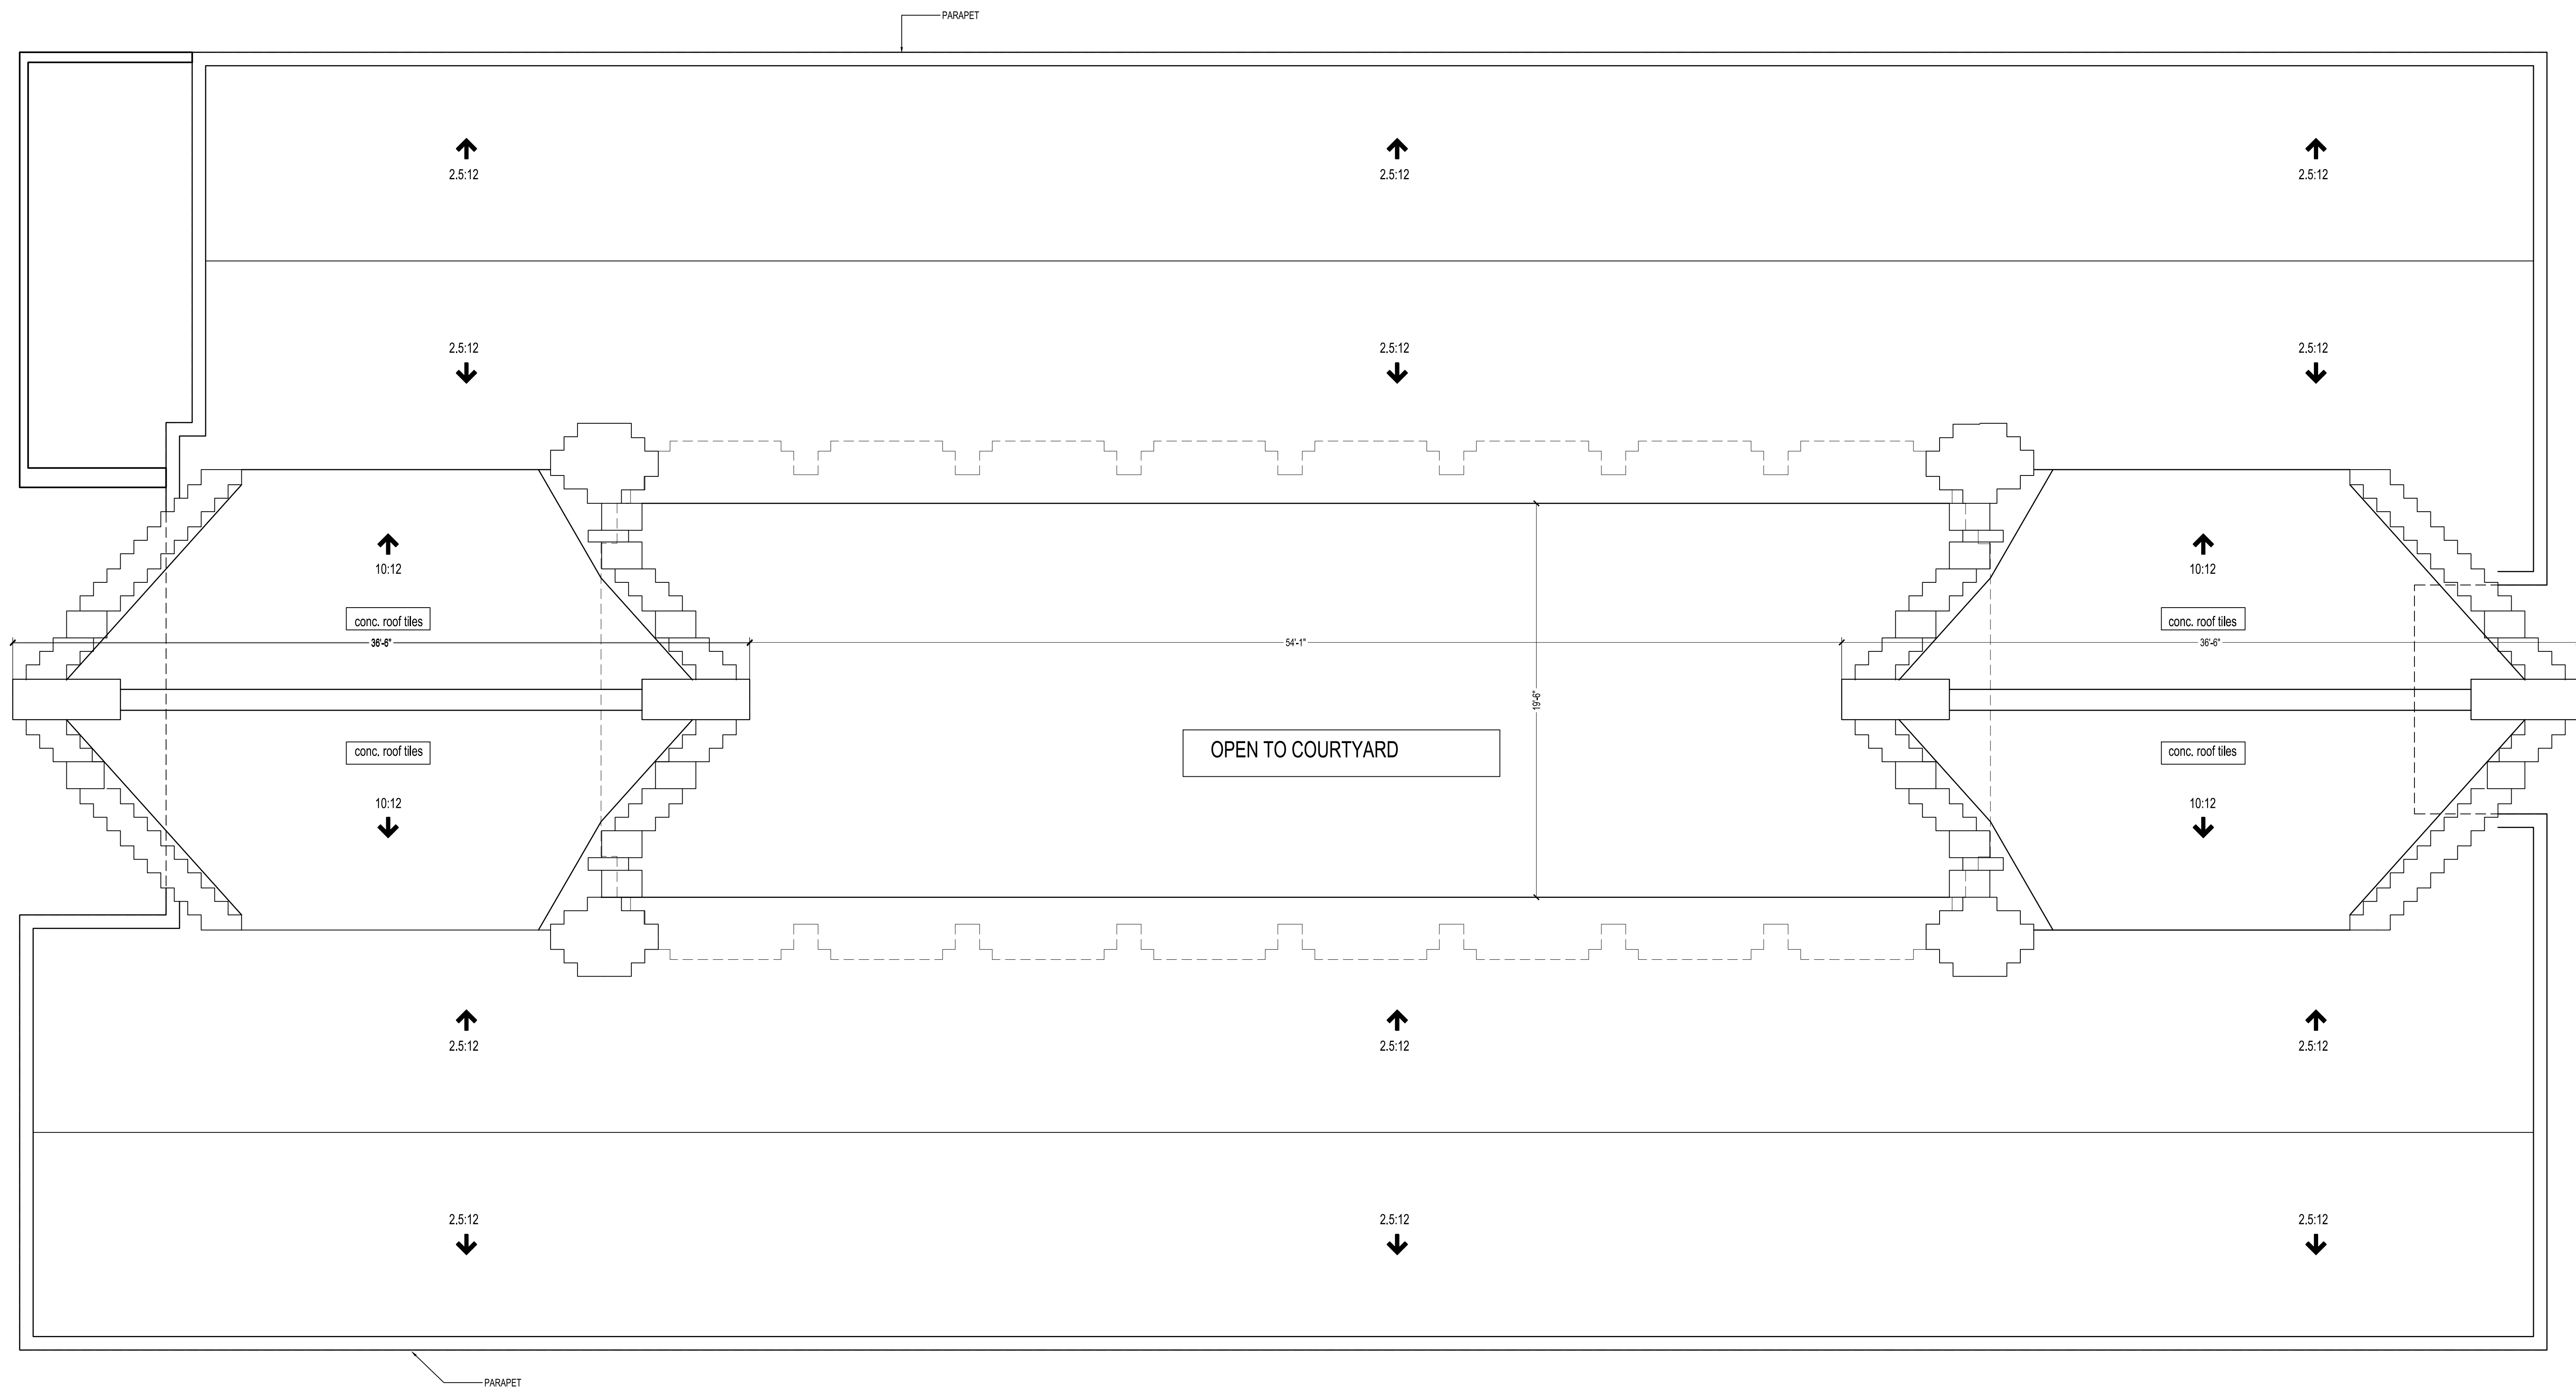

ROOF PLAN

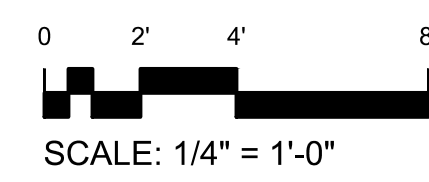

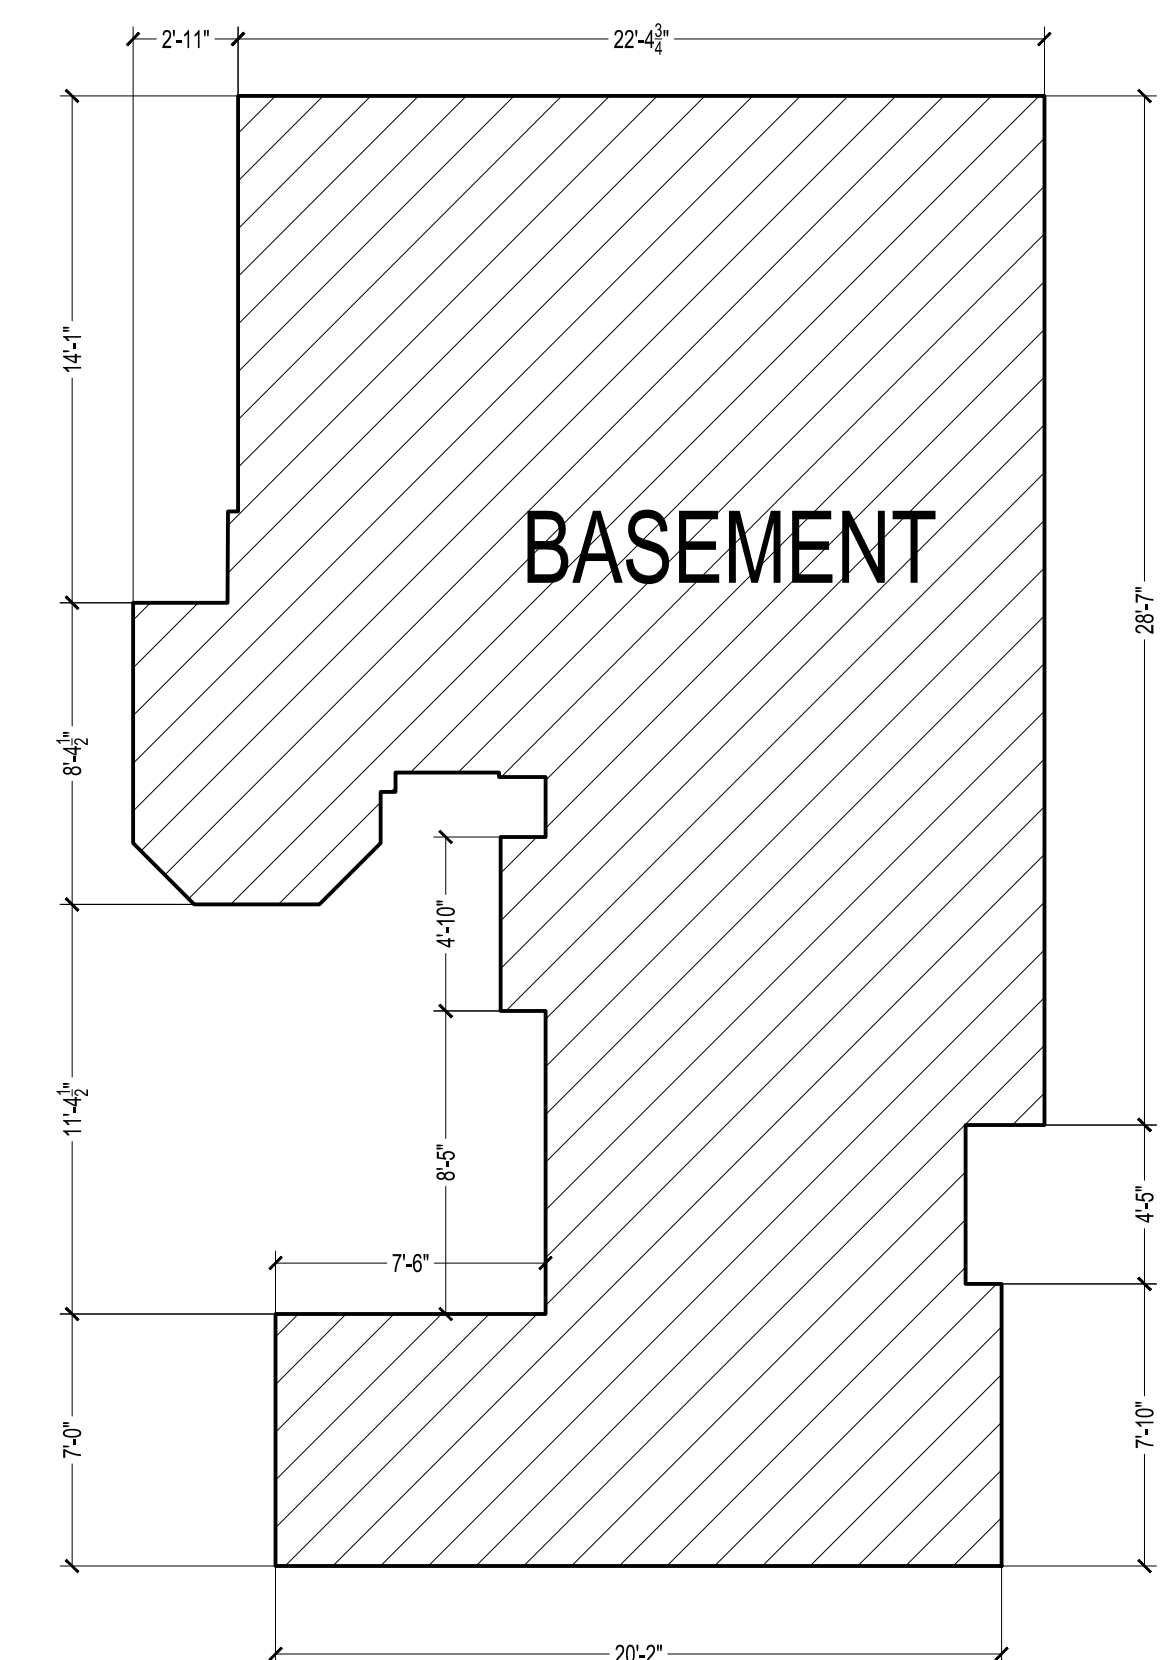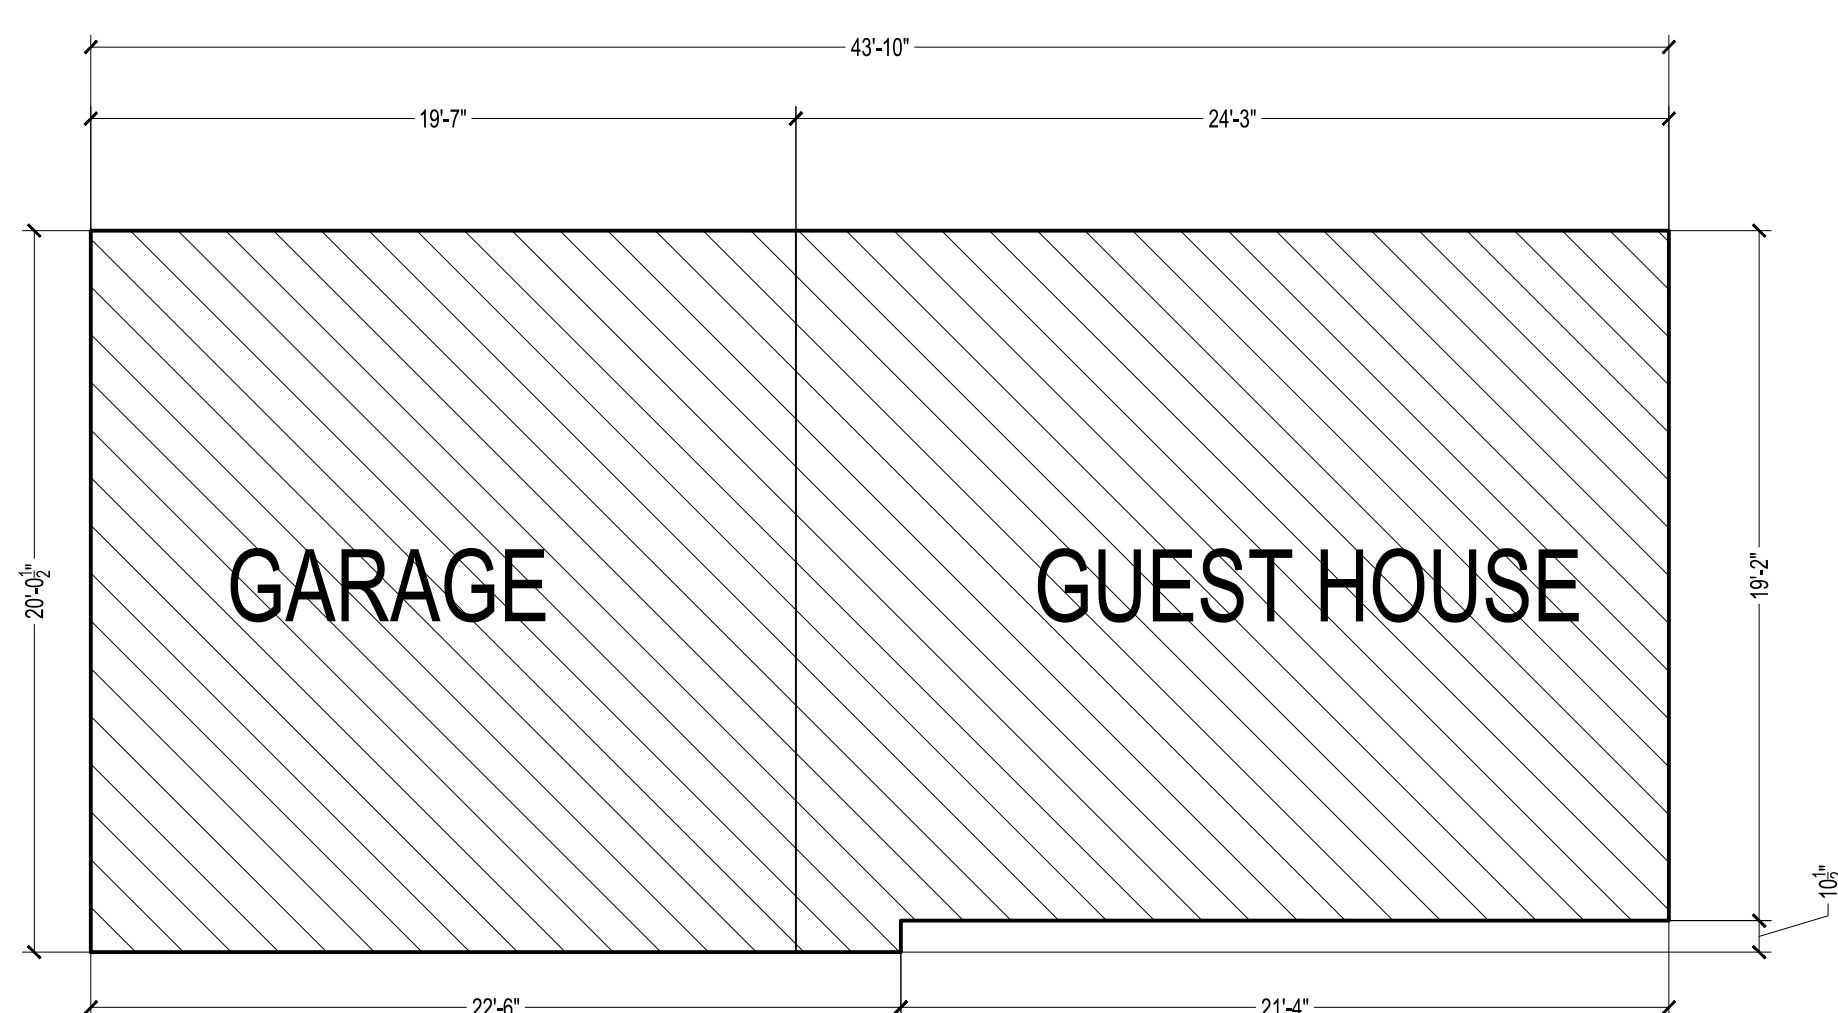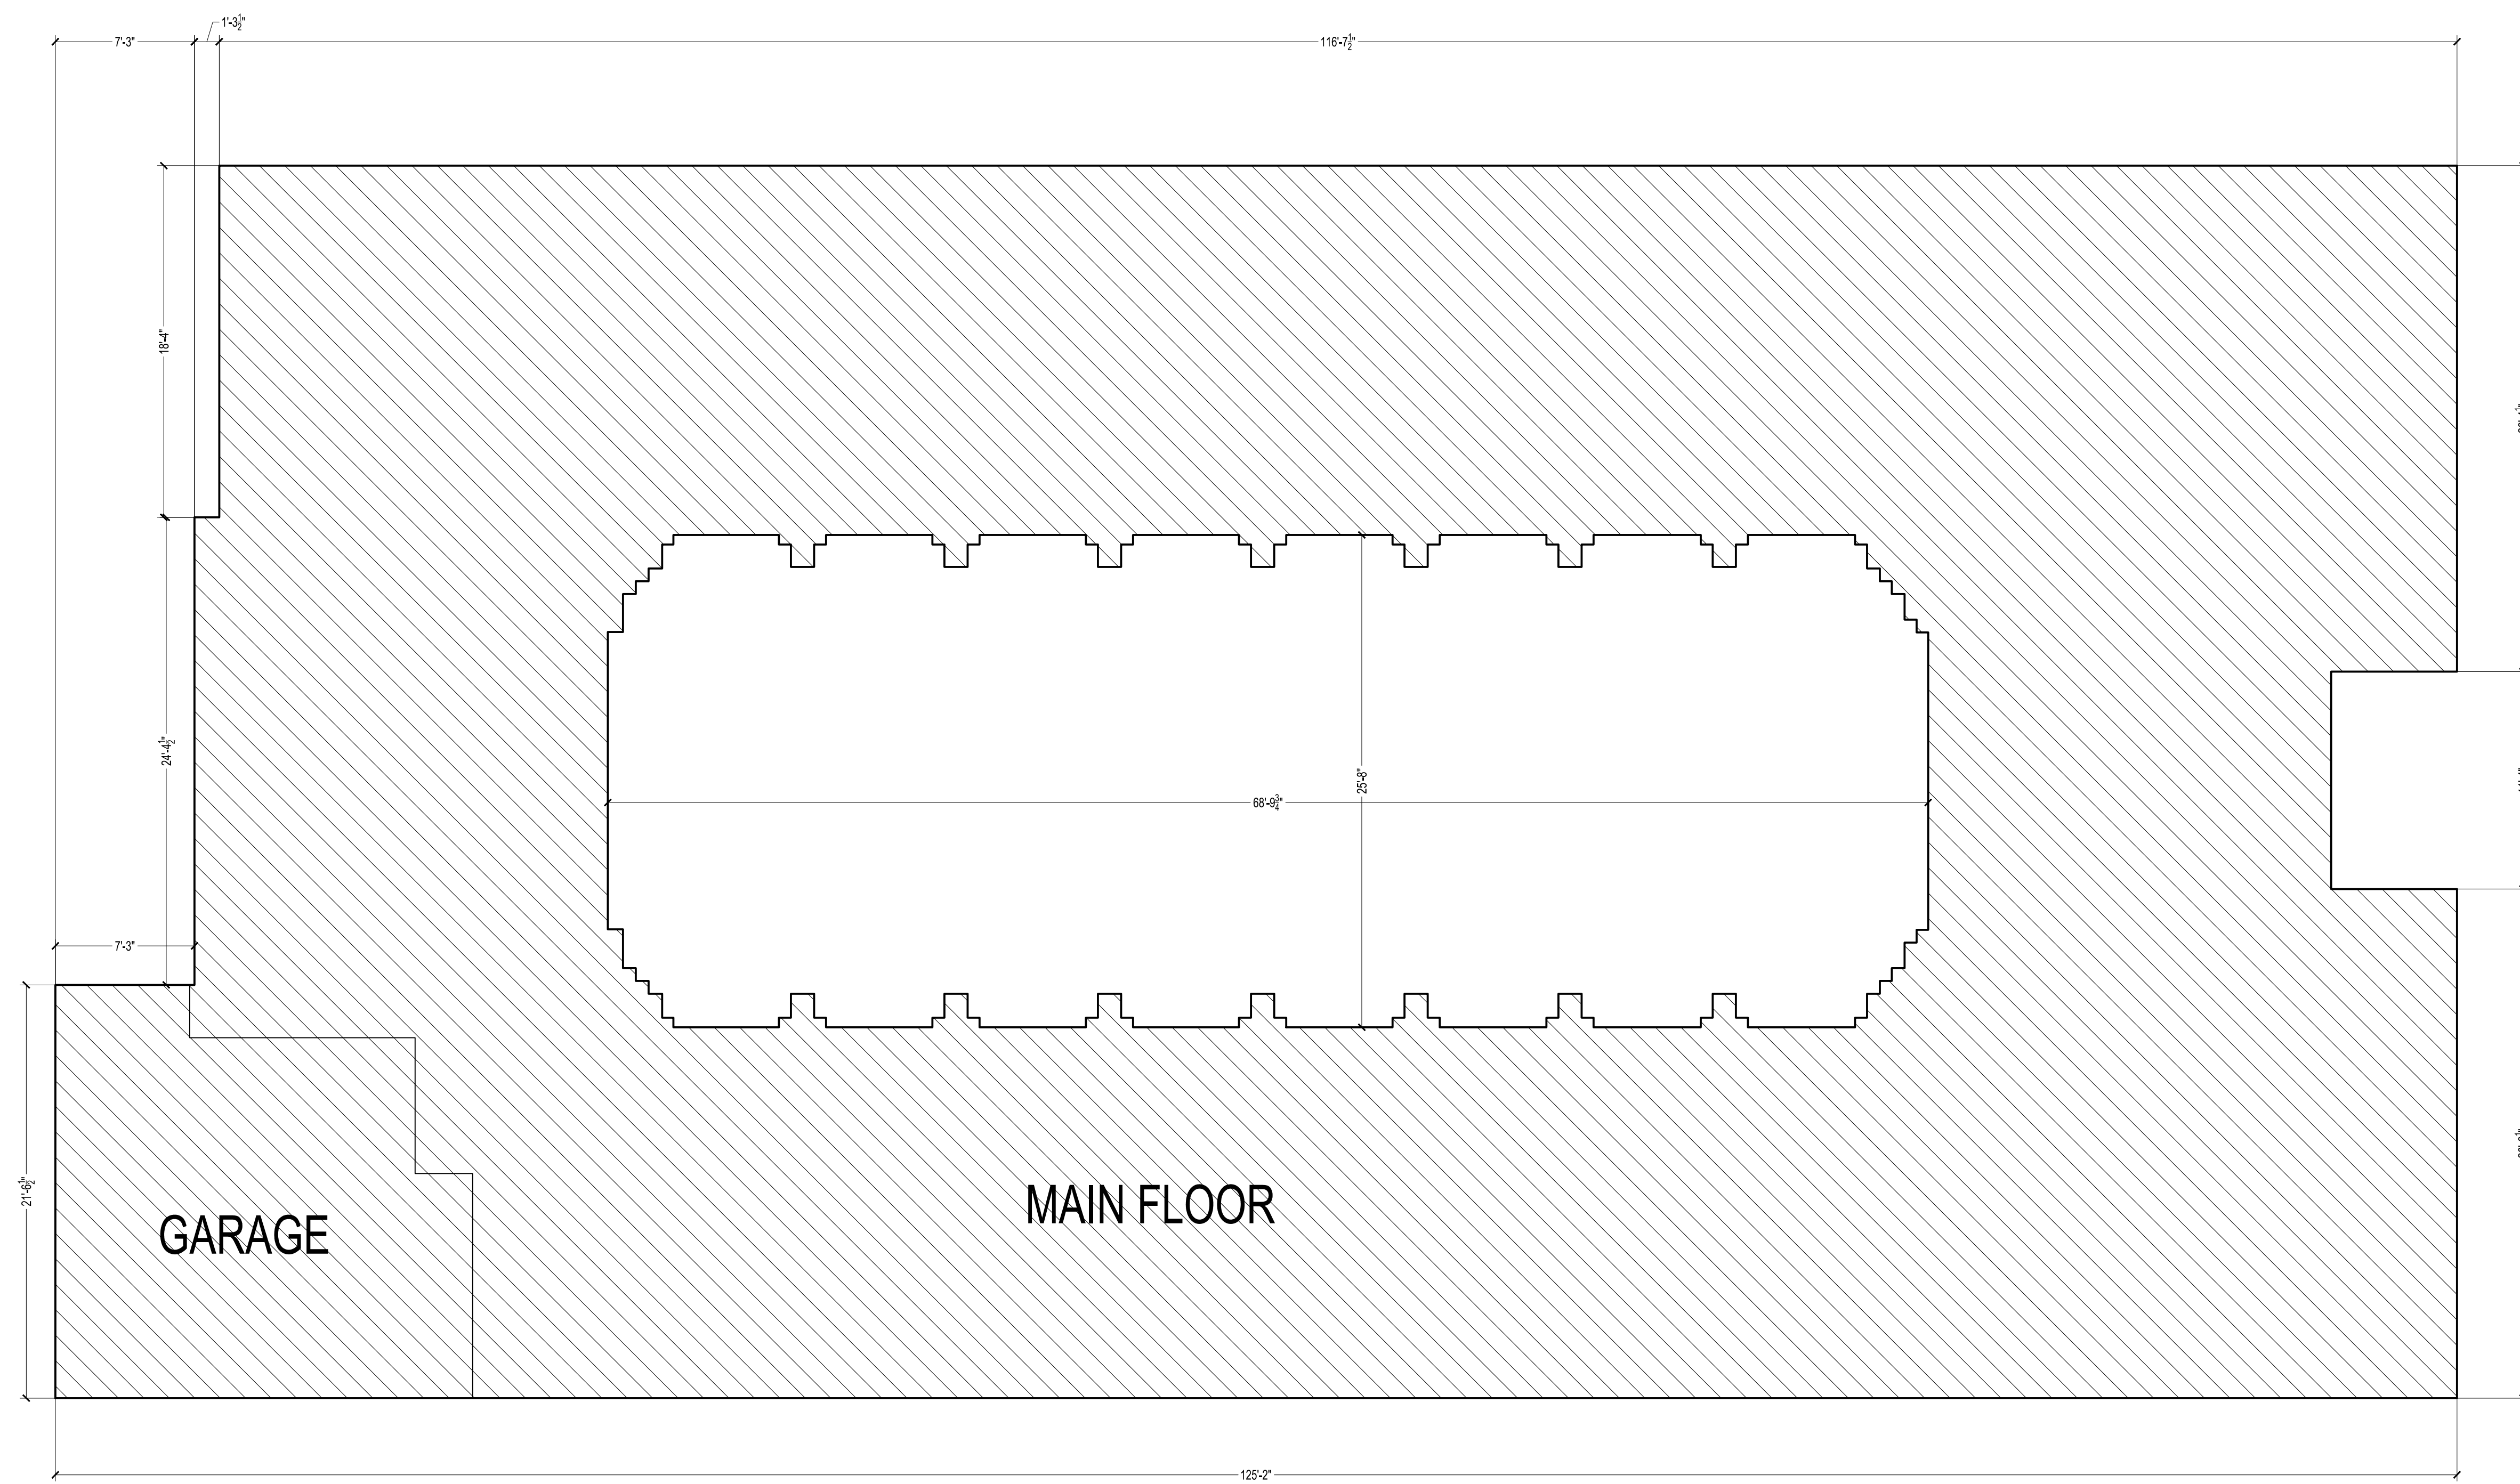

SQUARE FOOTAGE
 MAIN FLOOR: 5539 SF
 BASEMENT: 803 SF
 GUEST HOUSE: 467 SF
 GARAGES: 799 SF
 TOTAL: 7,608 SF

REVISIONS	BY

AS-BUILT
 LOS ANGELES

Sheet content :
 SQUARE FOOTAGE
 CALCULATION

Project :
 5121 FRANKLIN AVE,
 LOS ANGELES, CA 90027

Owner:
 Date
 Scale
 Drawn
 Job
 Sheet

A-8