
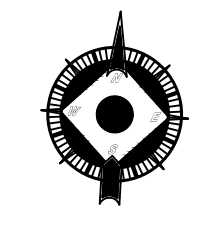


PLOT PLAN

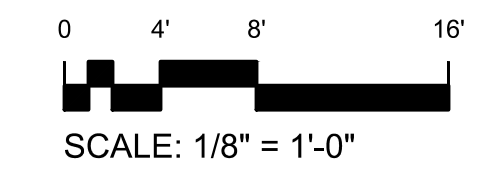


REVISIONS	BY
AS-BUILT LOS ANGELES	
Sheet content : PLOT PLAN	
Project : 1880 BEL AIR RD LOS ANGELES CA 90077	
Owner:	
Date	
Scale	
Drawn	
Job	
Sheet	A-1

DOOR SCHEDULE



MARK	SIZE		Type	NOTES
	WD	HGT		
1	2'-8"	6'-8"	SWING	---
2	16'-0"	7'-0"	GARAGE DOOR	---
3	5'-10"	6'-6"	FRENCH DOUBLE	---
4	5'-10"	6'-6"	FRENCH DOUBLE	---
5	2'-8"	6'-8"	SWING	---
6	3'-0"	7'-0"	SWING	---
7	2'-0"	6'-1"	SWING	---
8	2'-8"	6'-8"	SWING	---
9	2'-8"	6'-8"	SWING	---
10	2'-5"	6'-7"	POCKET	---
11	2'-8"	6'-8"	SWING	---
12	2'-8"	6'-8"	SWING	---
13	2'-8"	6'-8"	SWING	---
14	2'-11"	6'-6"	FRENCH	---
15	5'-10"	6'-6"	FRENCH DOUBLE	---
16	5'-10"	6'-6"	FRENCH DOUBLE	---
17	5'-10"	6'-6"	FRENCH DOUBLE	---
18	2'-8"	6'-8"	SWING	---
19	5'-9"	6'-8"	SLIDING - DOUBLE	---
20	2'-8"	6'-8"	SWING	---
21	2'-8"	6'-8"	SWING	---
22	6'-3"	6'-8"	SLIDING - DOUBLE	---
23	2'-8"	6'-8"	SWING	---
24	2'-8"	6'-8"	SWING	---
25	2'-8"	6'-8"	SWING	---
26	5'-0"	6'-8"	SWING DOUBLE	---
27	2'-8"	6'-8"	FRENCH	---
28	2'-8"	6'-8"	FRENCH	---
29	5'-0"	6'-8"	SWING DOUBLE	---
30	5'-10"	6'-6"	SLIDING DOUBLE	---
31	5'-10"	6'-6"	SLIDING DOUBLE	---
32	2'-8"	6'-8"	SWING	---
33	2'-8"	6'-8"	SWING	---
34	2'-8"	6'-8"	SWING	---
35	2'-0"	6'-8"	SWING	---
36	2'-8"	6'-8"	SWING	---
37	2'-4"	7'-5"	FRENCH	---
38	4'-7"	6'-8"	SWING DOUBLE	---
39	2'-0"	5'-6"	SWING	---
40	2'-0"	5'-6"	SWING	---
41	2'-0"	5'-6"	SWING	---
42	2'-5"	6'-9"	SWING	---
43	5'-0"	6'-8"	SLIDING - DOUBLE	---
44	2'-8"	6'-8"	SWING	---
45	2'-8"	6'-8"	SWING	---
46	2'-8"	6'-8"	SWING	---
47	2'-8"	6'-7"	SWING	---
48	2'-0"	6'-8"	SWING	---
49	3'-0"	6'-8"	SWING	---
50	2'-4"	6'-8"	SWING	---
51	2'-0"	6'-0"	SWING	---
52	2'-8"	6'-8"	POCKET	---
53	2'-7"	6'-8"	SWING	---

WINDOW SCHEDULE


MARK	SIZE		TYPE	Head Height	NOTES
	Width	HEIGHT			
1	2'-10"	3'-4"	SLIDING	6'-6"	---
2	4'-11"	3'-4"	DOUBLE CASEMENT	6'-8"	---
3	4'-11"	3'-4"	DOUBLE CASEMENT	6'-8"	---
4	2'-8"	3'-10"	FIXED	6'-11"	---
5	2'-8"	3'-10"	FIXED	6'-11"	---
6	2'-5"	3'-11"	CASEMENT	6'-8"	---
7	5'-11"	3'-10"	DOUBLE CASEMENT	6'-8"	---
8	6'-0"	3'-10"	DOUBLE CASEMENT	6'-6"	---
9	5'-11"	3'-11"	DOUBLE CASEMENT	6'-8"	---
10	3'-0"	3'-11"	CASEMENT	6'-8"	---
11	4'-11"	3'-10"	DOUBLE CASEMENT	6'-7"	---
12	4'-11"	3'-10"	DOUBLE CASEMENT	6'-7"	---
13	6'-10"	4'-10"	FIXED	6'-8"	---
14	3'-5"	3'-10"	DOUBLE CASEMENT	6'-8"	---
15	3'-5"	3'-10"	DOUBLE CASEMENT	6'-8"	---
16	3'-4"	3'-4"	SLIDING	6'-10"	---
17	4'-10"	3'-10"	SLIDING	6'-8"	---
18	4'-10"	3'-10"	SLIDING	6'-8"	---
19	4'-10"	3'-10"	SLIDING	6'-8"	---
20	3'-10"	3'-4"	SLIDING	6'-11"	---
21	3'-3"	3'-4"	SLIDING	6'-7"	---
22	4'-10"	3'-10"	SLIDING	6'-8"	---
23	4'-10"	3'-10"	SLIDING	6'-8"	---

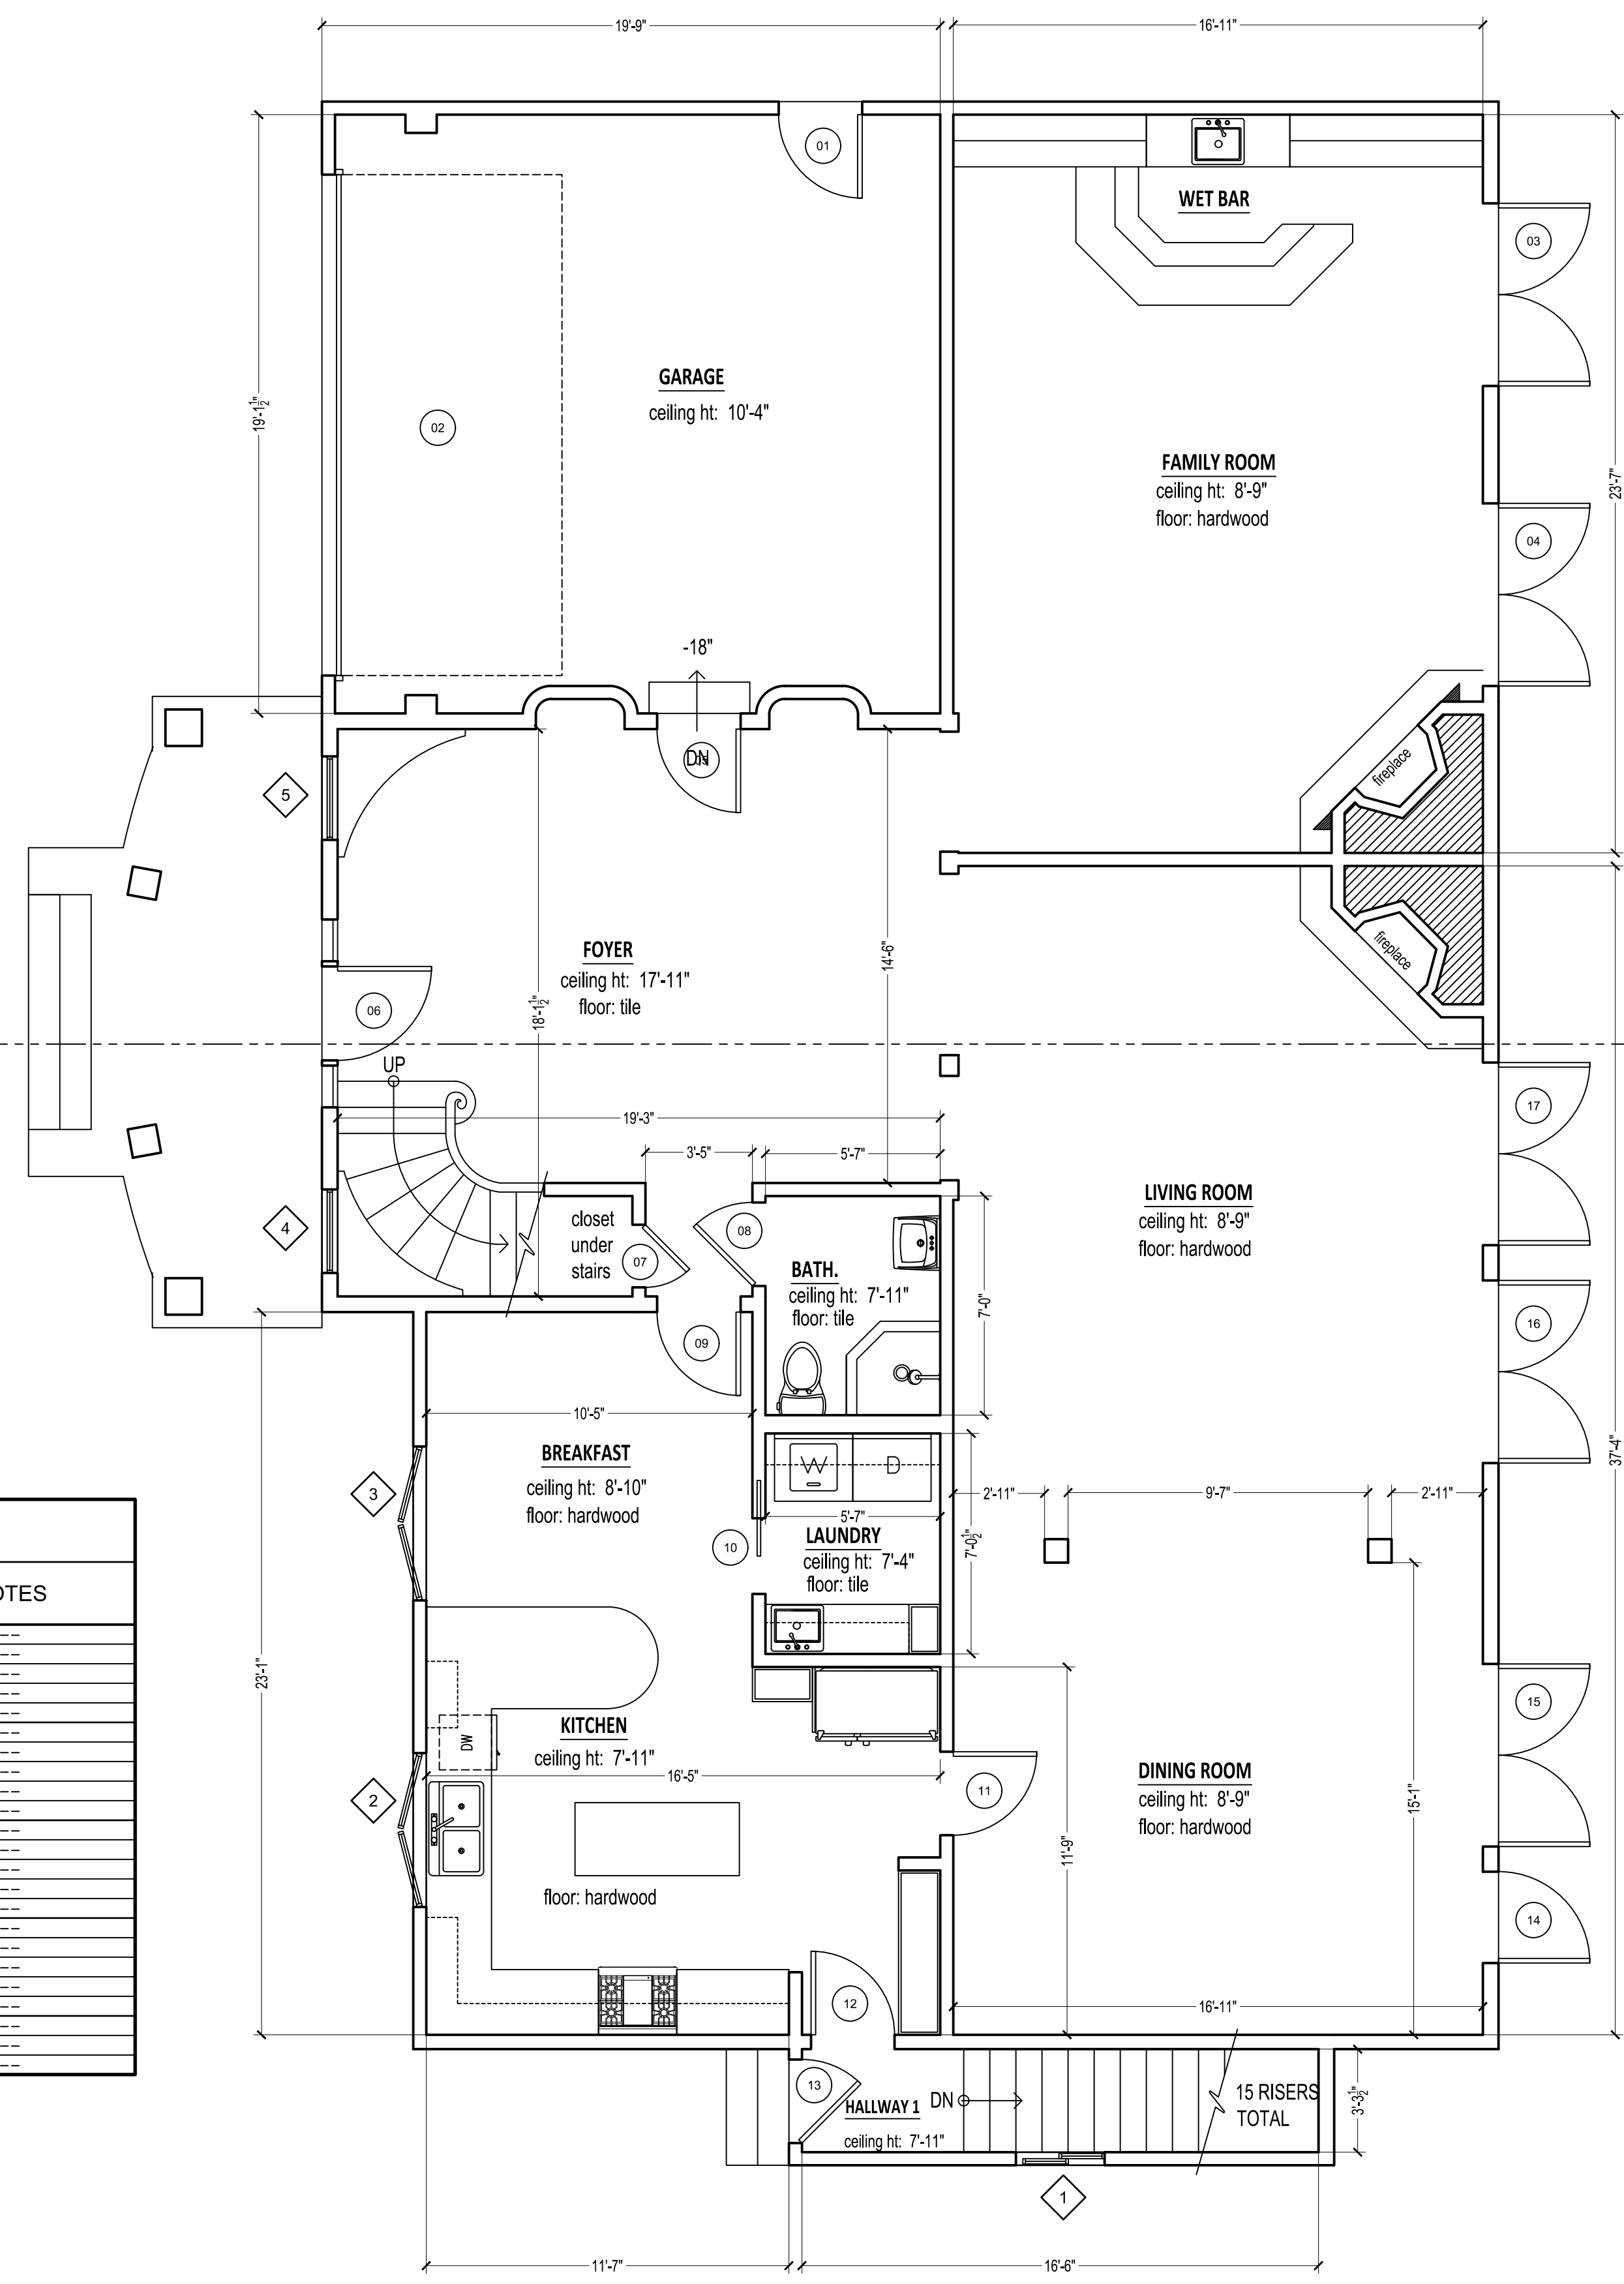

FIRST FLOOR PLAN

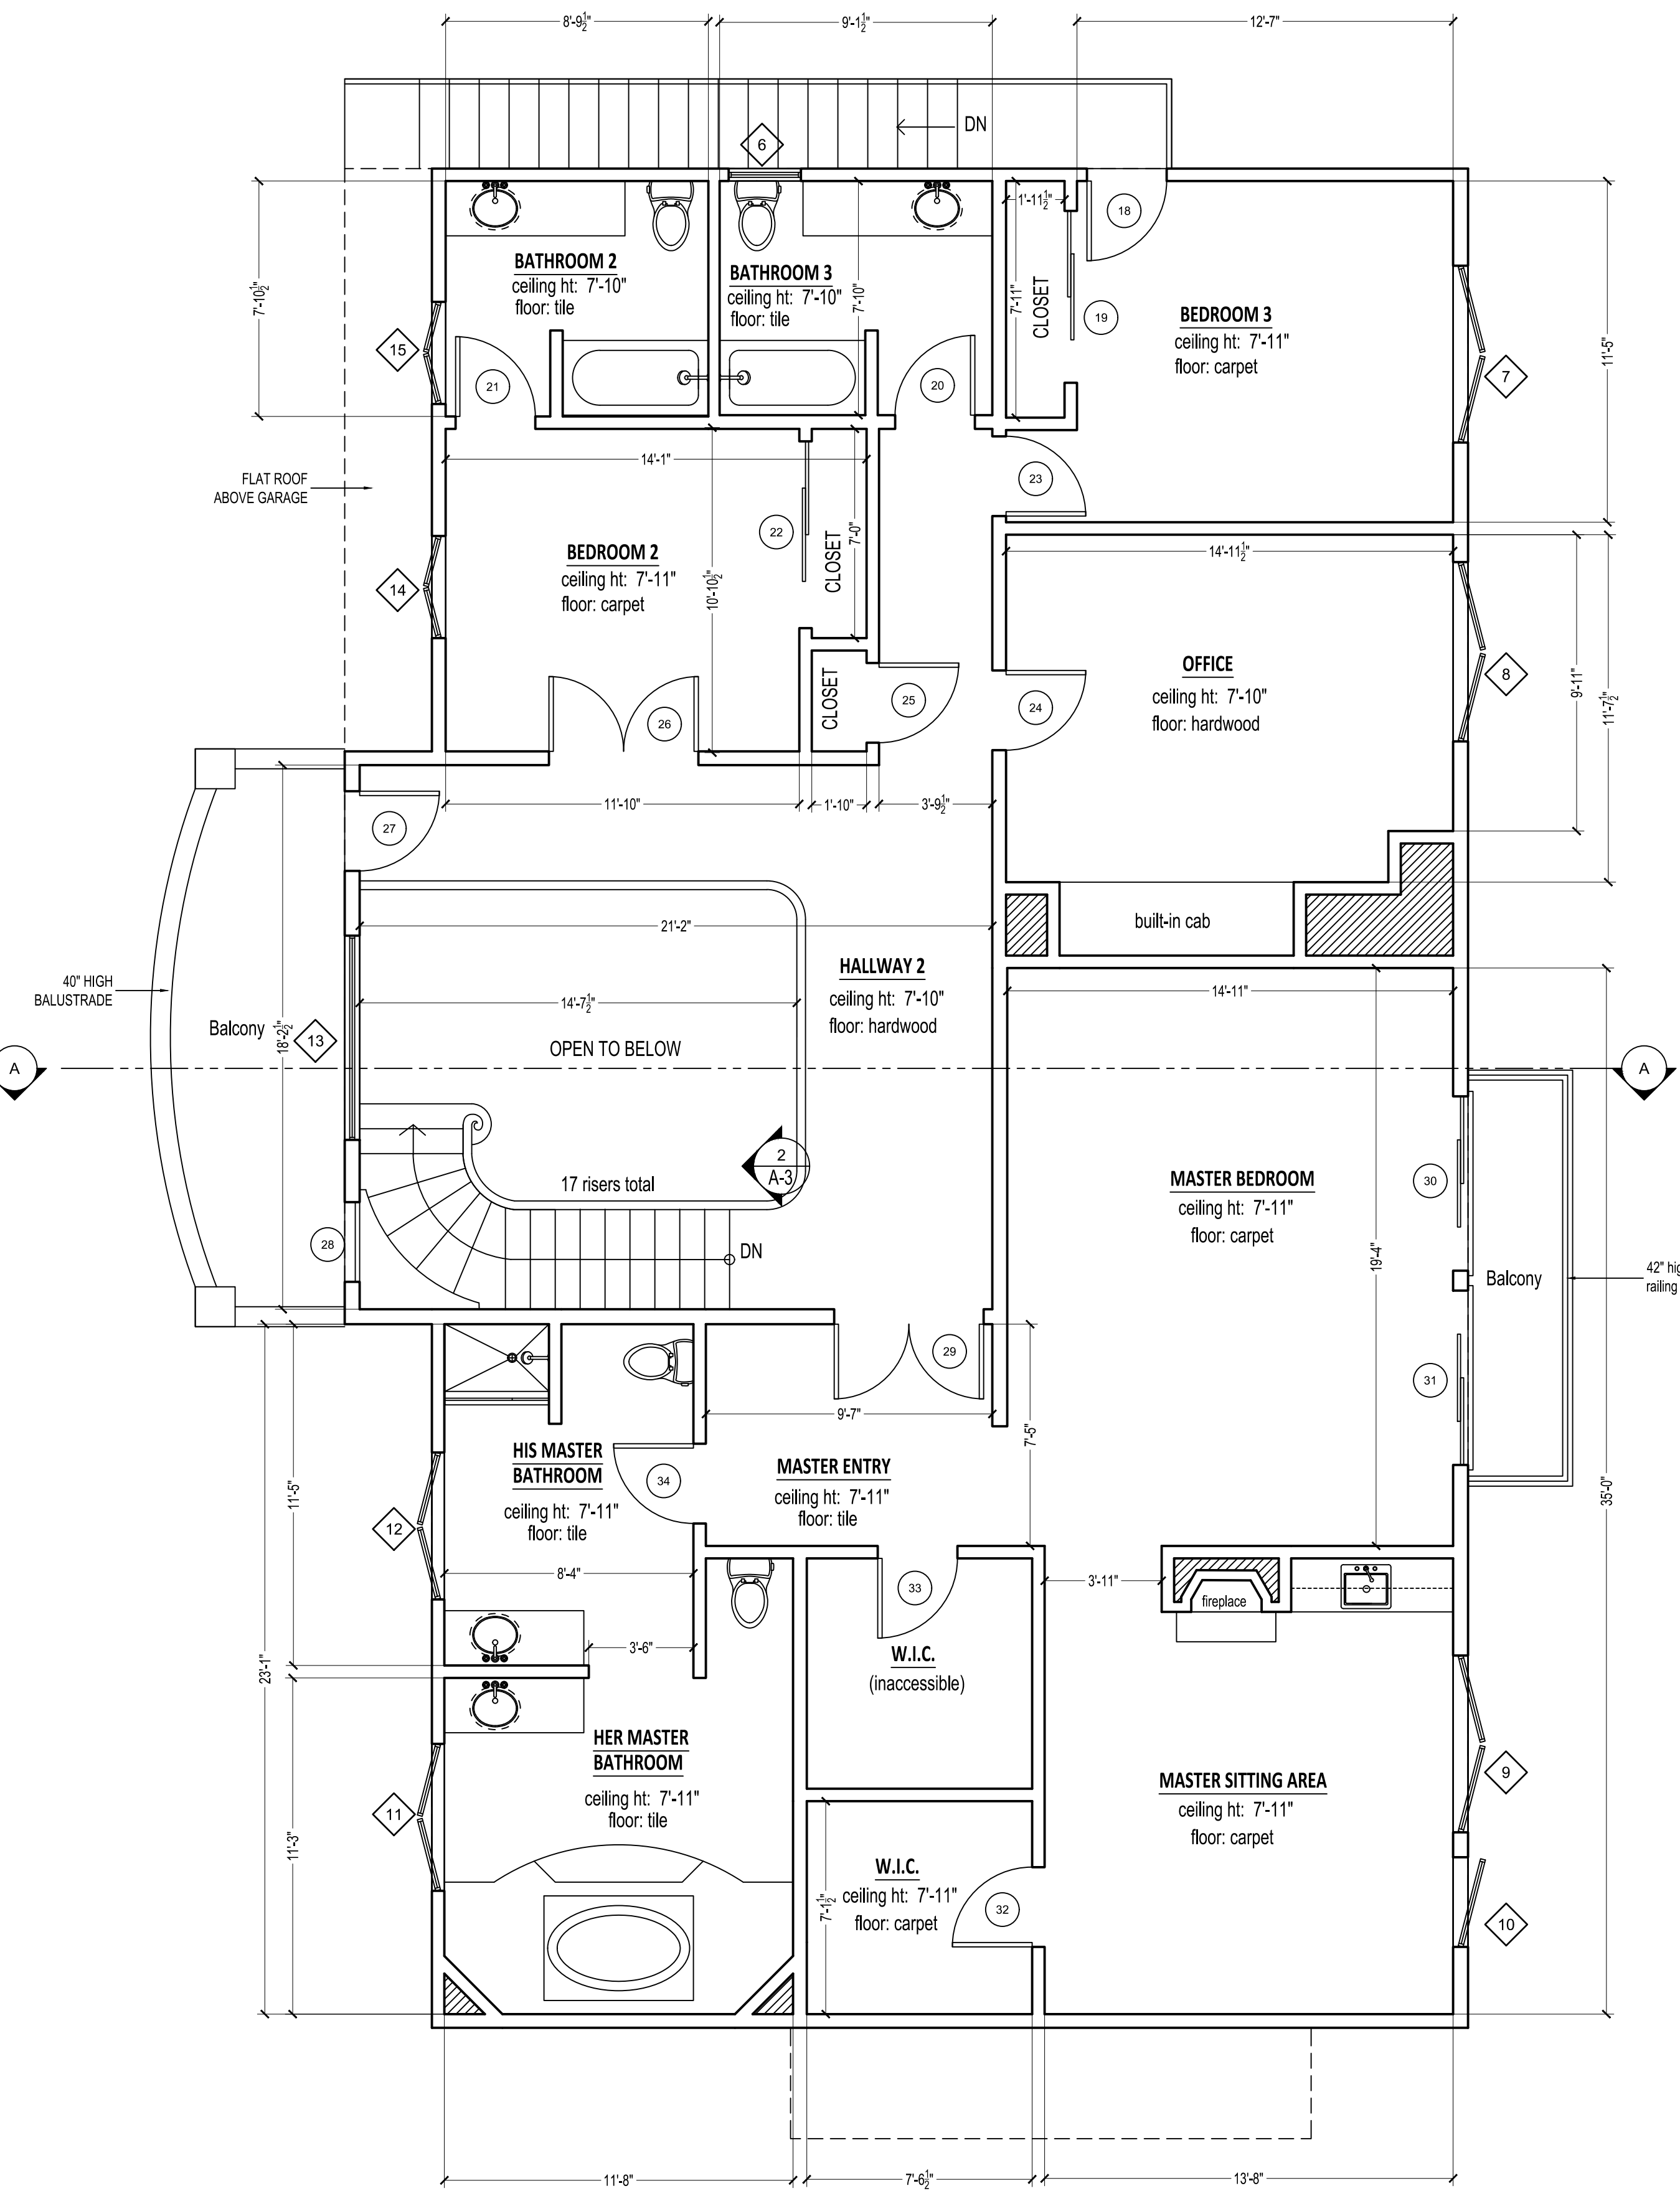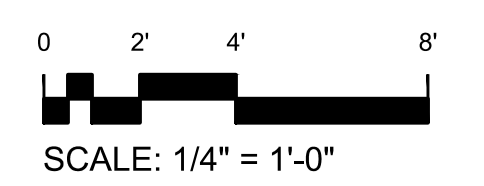

SECOND FLOOR PLAN

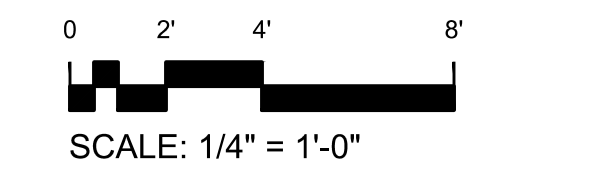

REVISIONS

BY

AS-BUILT
LOS ANGELES

Sheet content: **FLOOR PLANS**

Project: **1880 BEL AIR RD
LOS ANGELES CA 90077**

Owner:

Date

Scale


Drawn

Job


Sheet

A-2


08.08.13

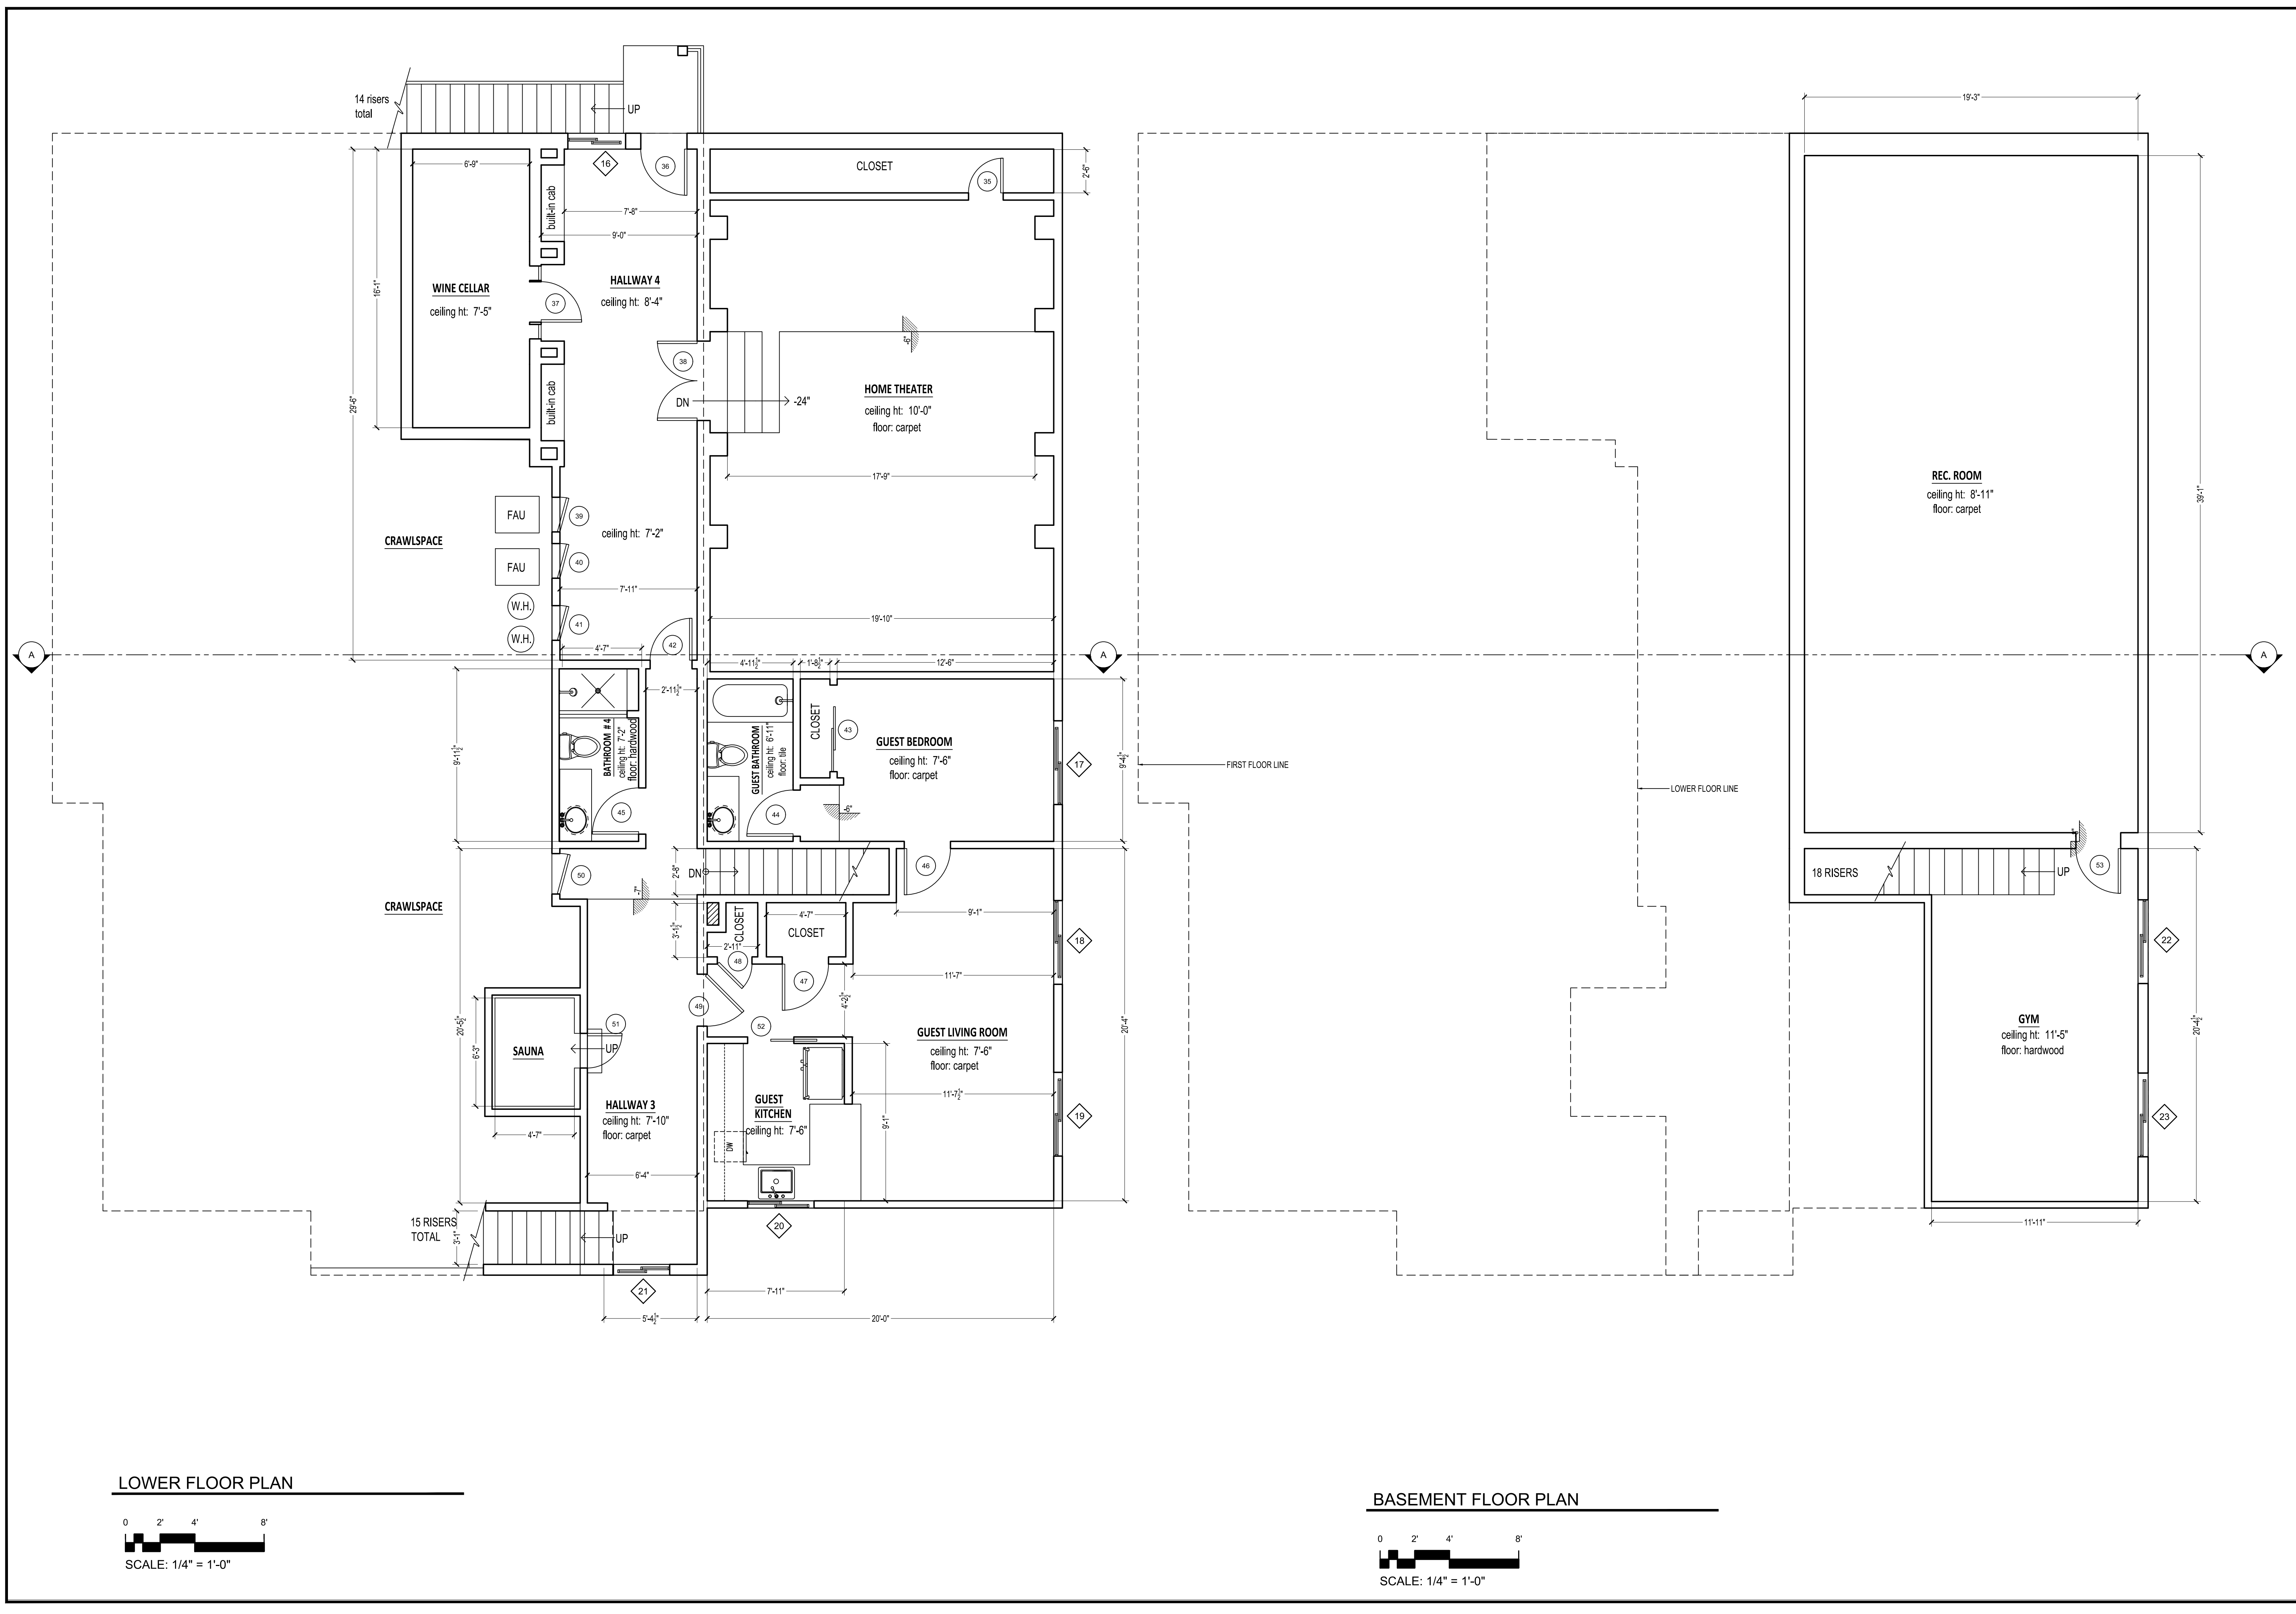


LOWER FLOOR PLAN

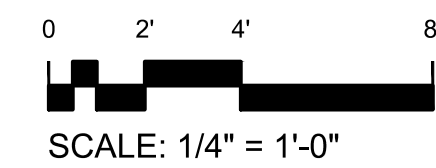

BASEMENT FLOOR PLAN

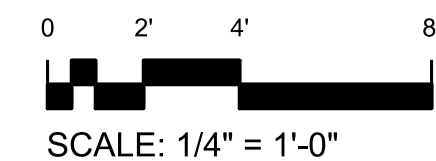

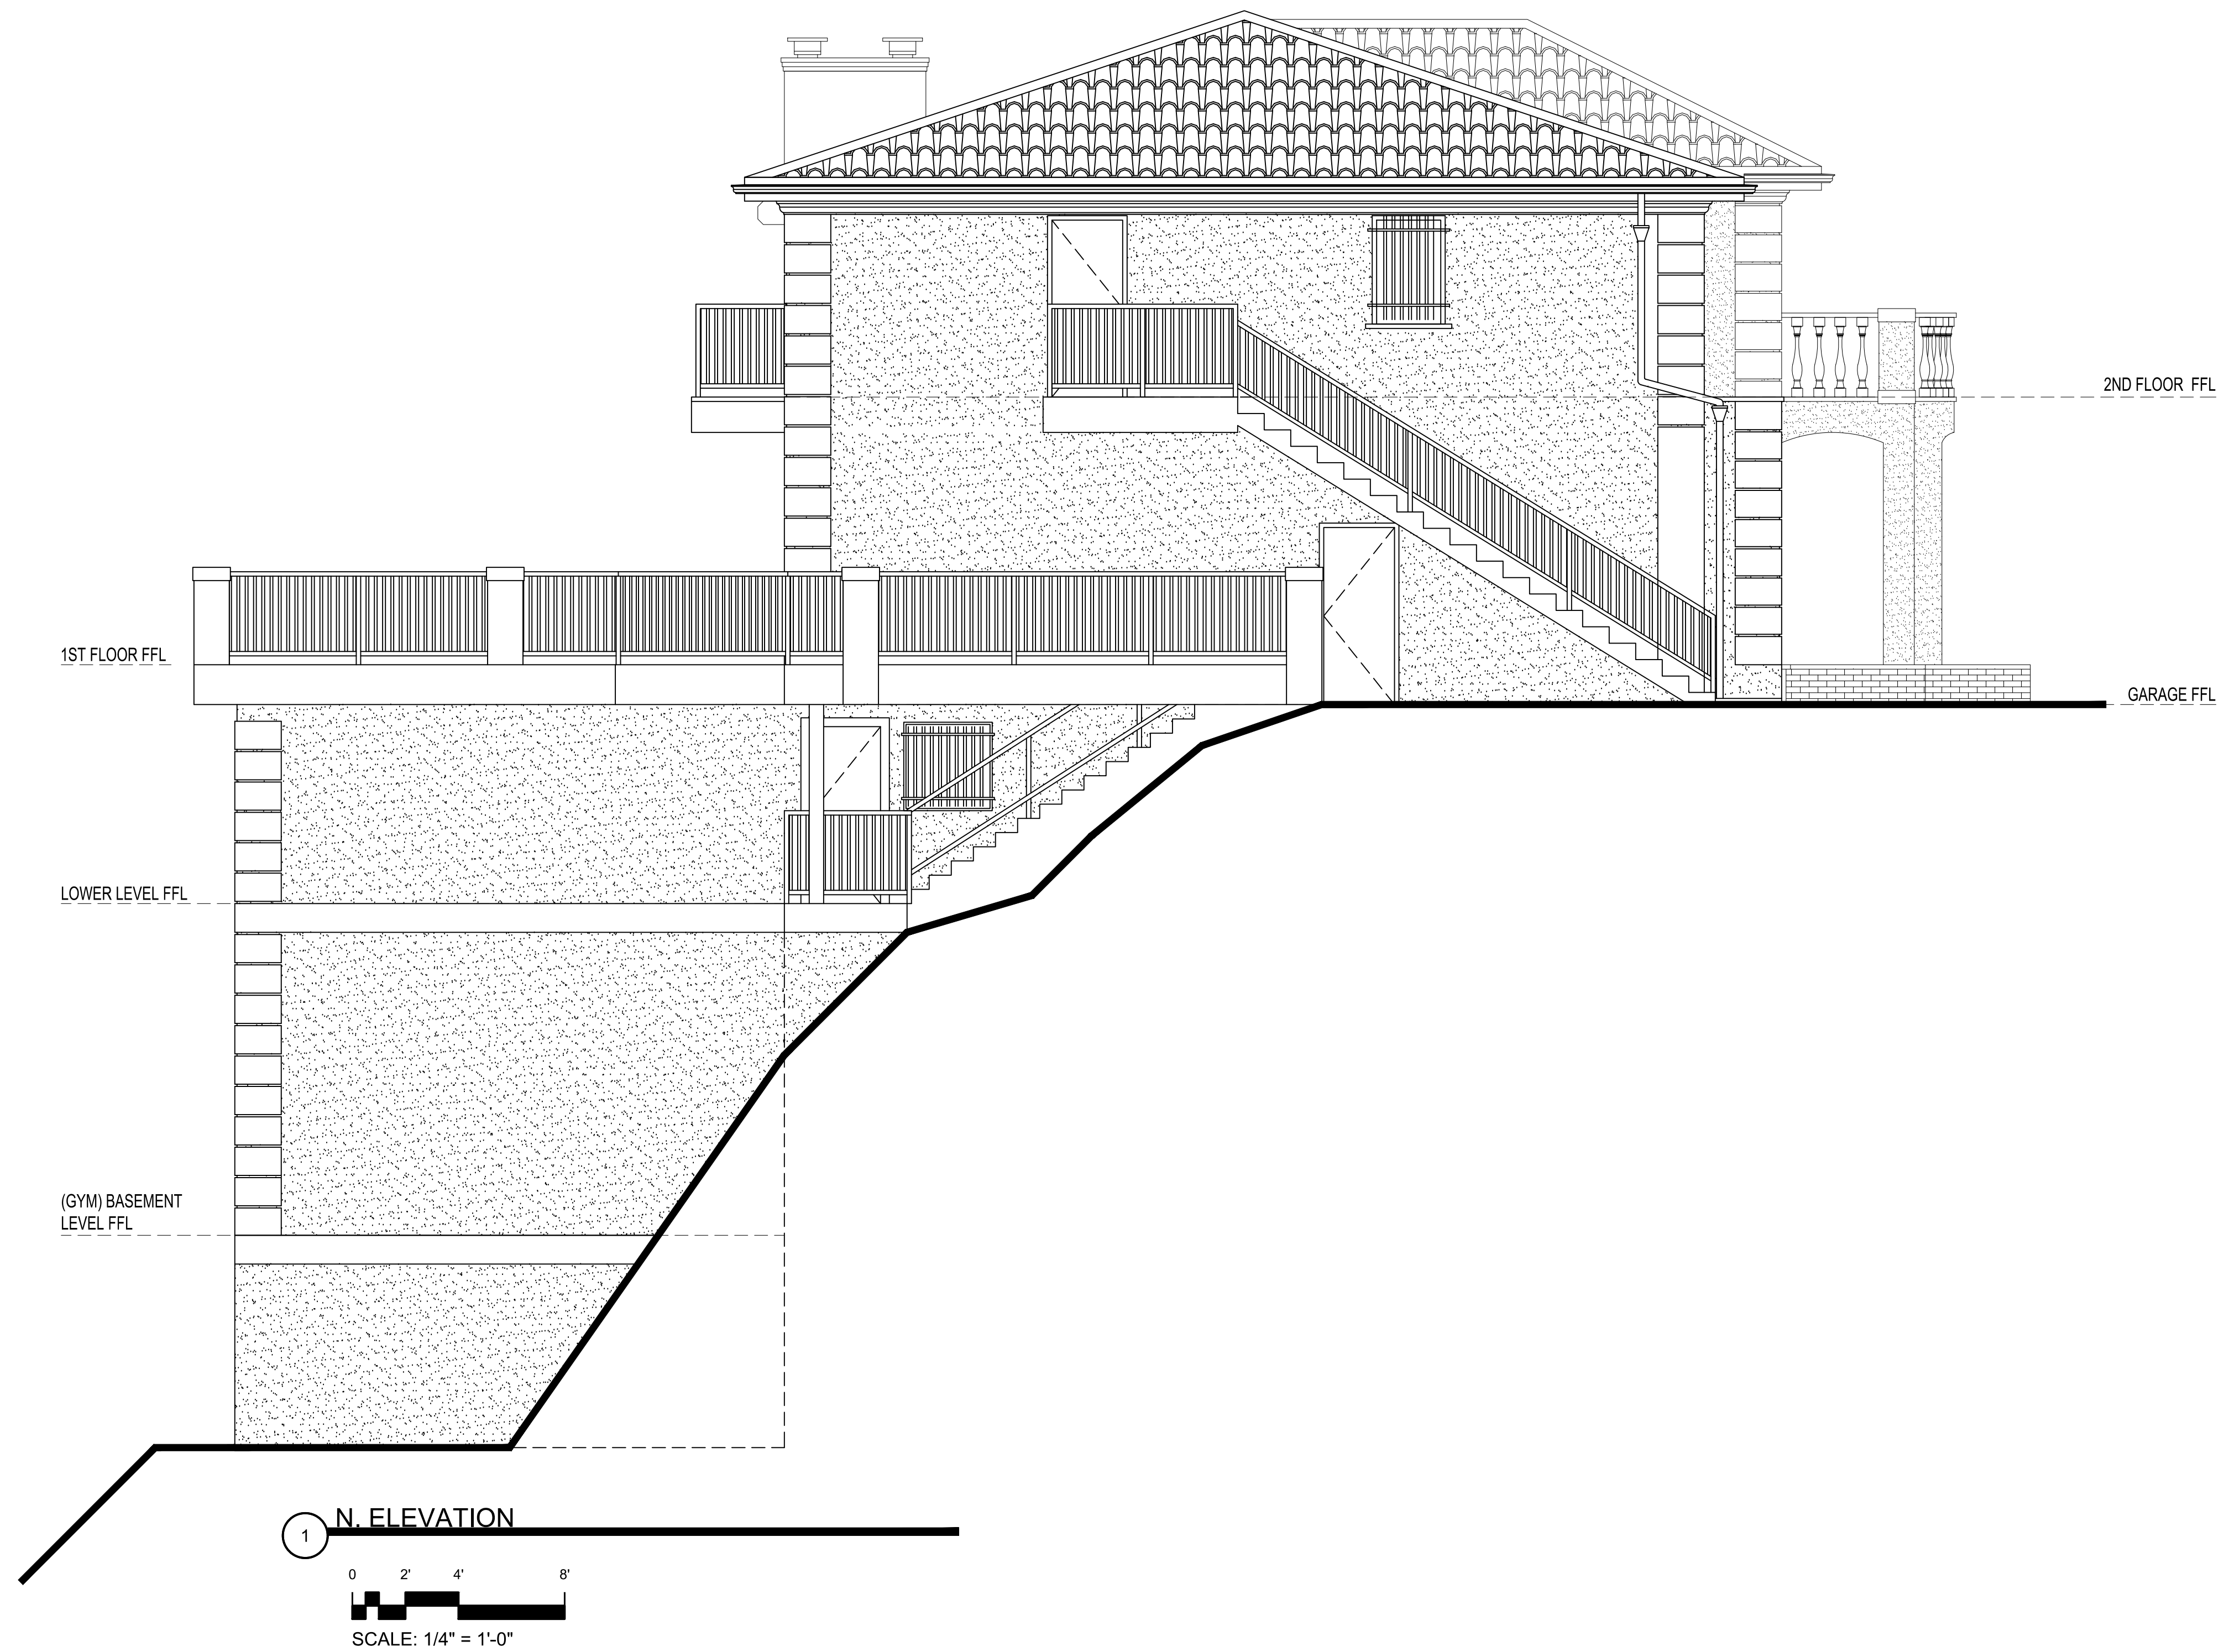

REVISIONS	BY


AS-BUILT
LOS ANGELES

Sheet content :
ELEVATIONS


Project :
1880 BEL AIR RD
LOS ANGELES CA 90077

Owner:
Date
Scale
Drawn
Job
Sheet


A-4

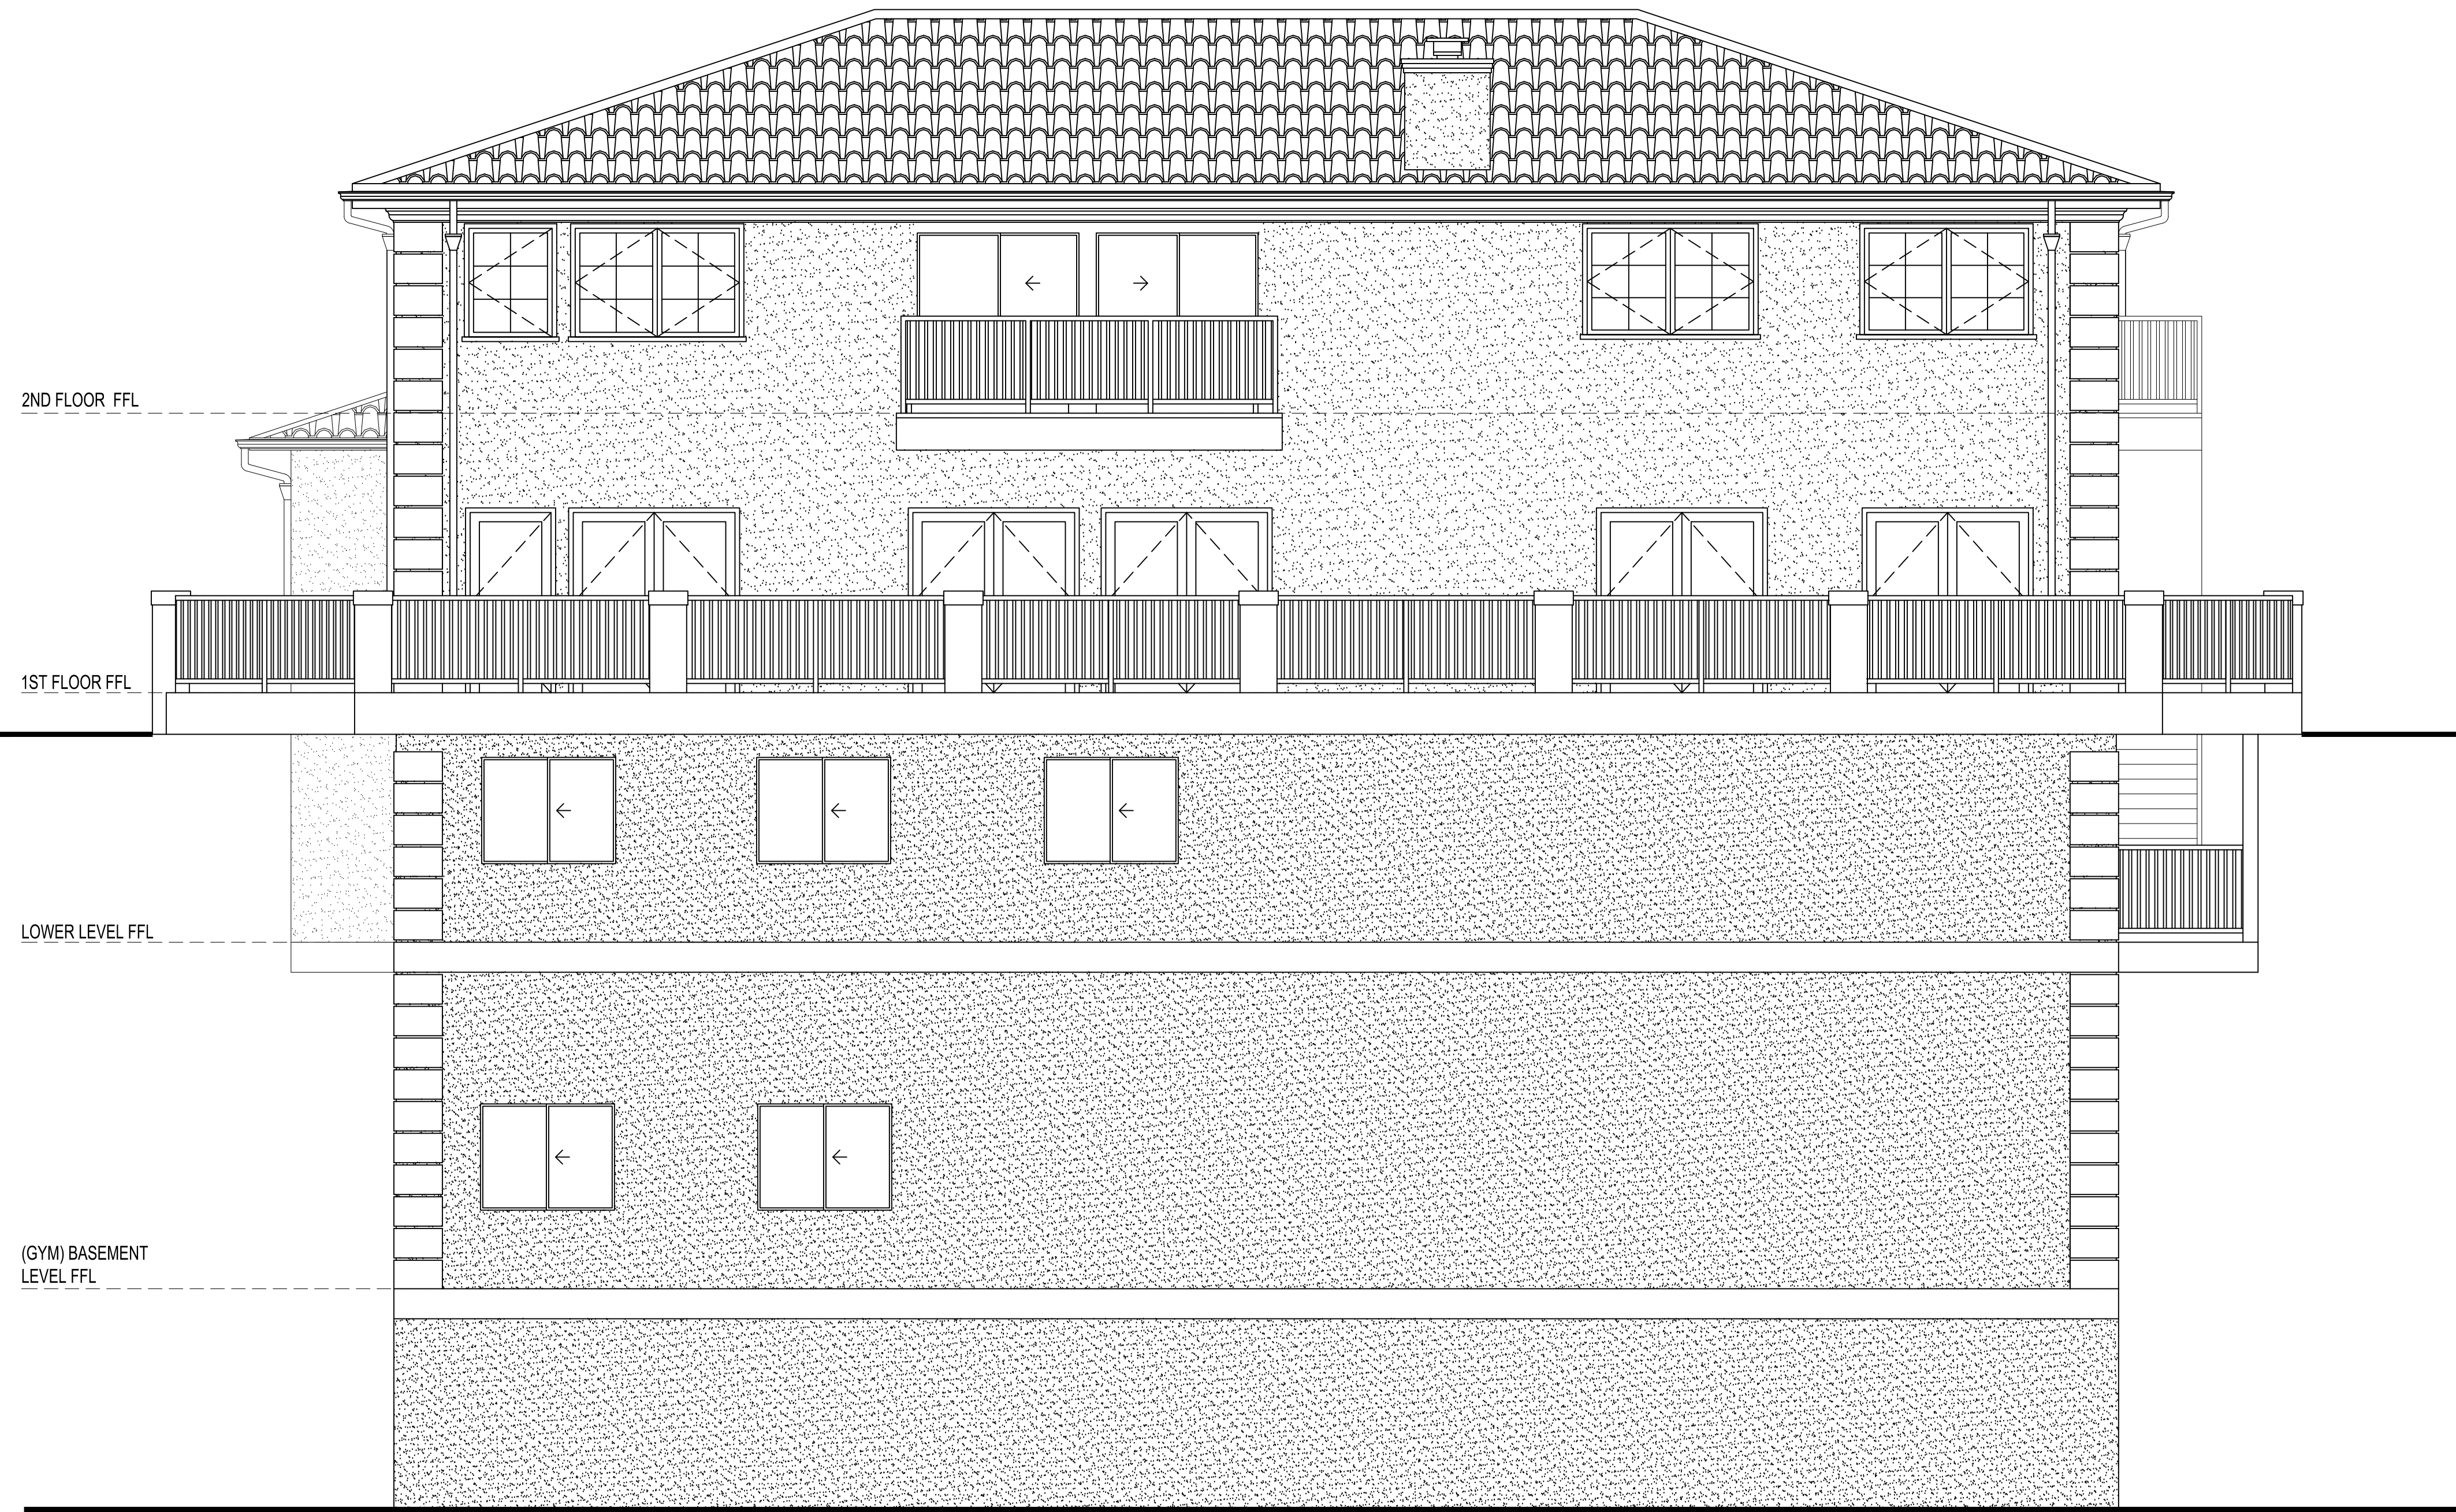

2 E. ELEVATION

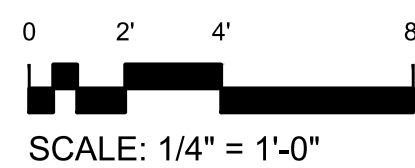

4 W. ELEVATION

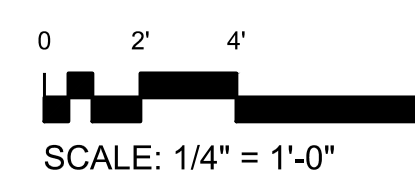

REVISIONS BY

AS-BUILT
LOS ANGELES

Sheet content :
ELEVATIONS

Project :
1880 BEL AIR RD
LOS ANGELES CA 90077

Owner:

Date

Scale


Drawn

Job

Sheet

A-5

08.28.13

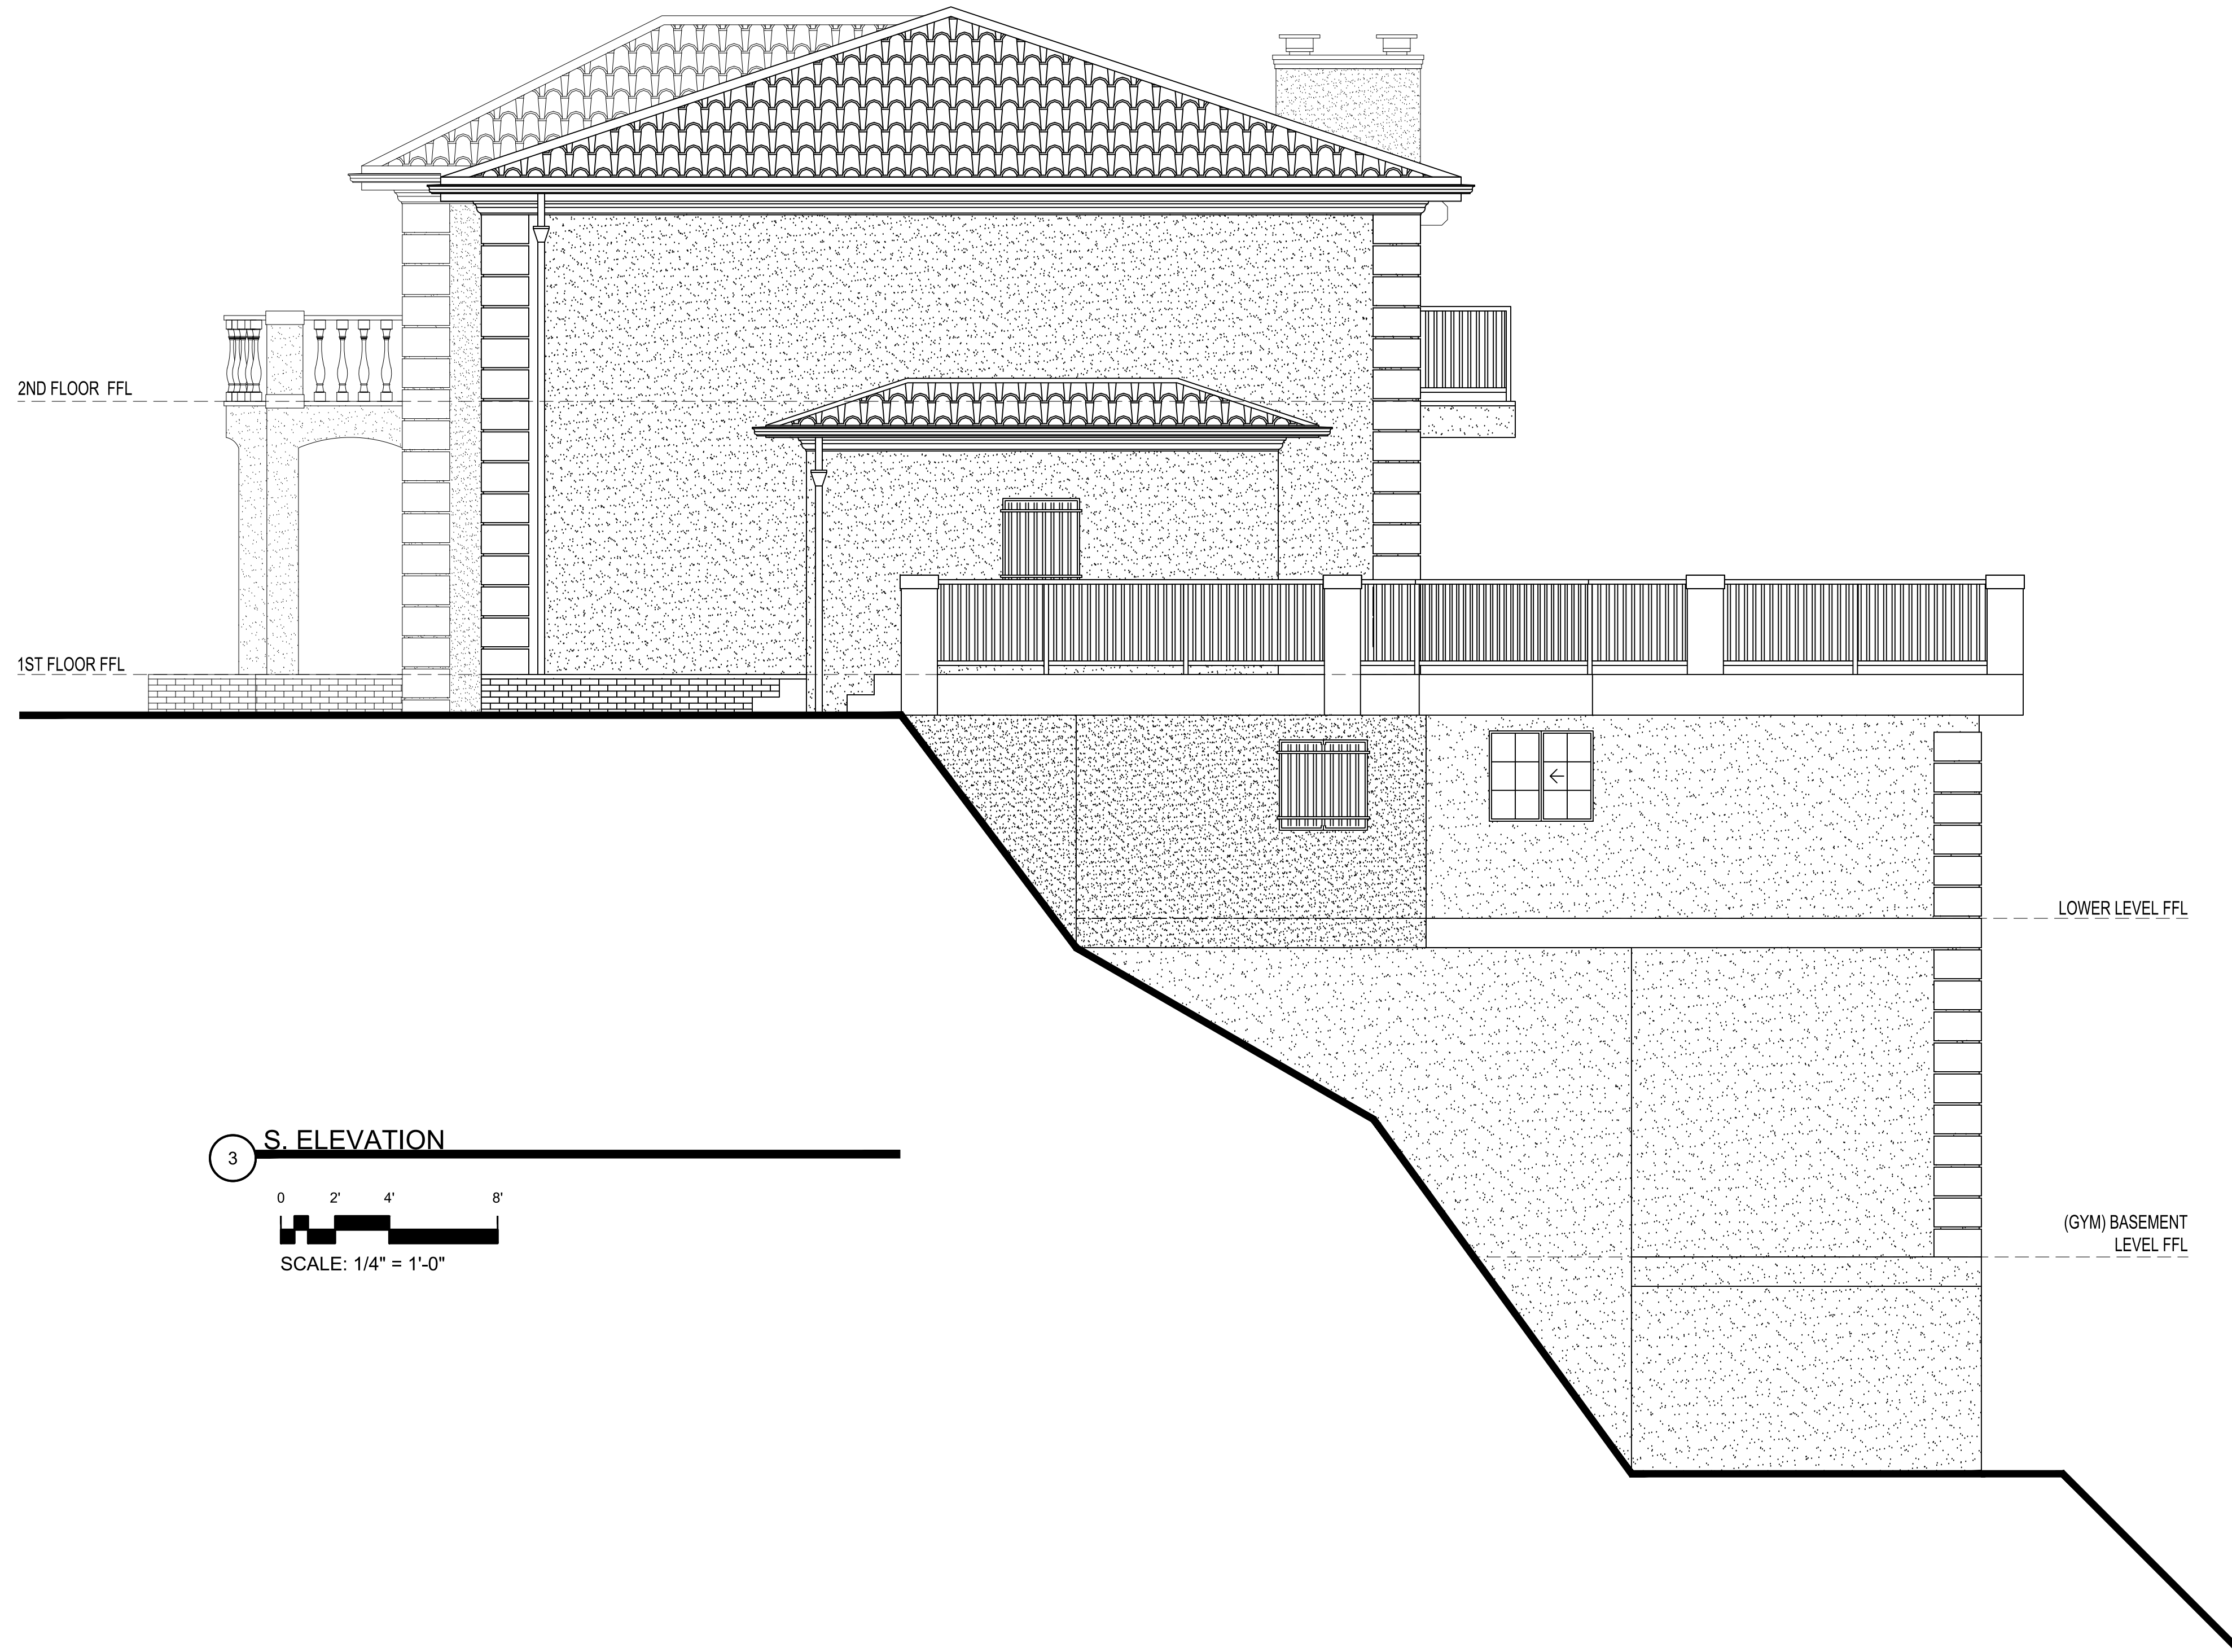

3 S. ELEVATION
 0 2' 4' 8'
 SCALE: 1/4" = 1'-0"

REVISIONS	BY

AS-BUILT
 LOS ANGELES

Sheet content :
 ELEVATION

Project :
 1880 BEL AIR RD
 LOS ANGELES CA 90077

Owner:
 Date
 Scale
 Drawn
 Job
 Sheet

A-6

REVISIONS	BY


AS-BUILT
LOS ANGELES

Sheet content :
BUILDING SECTION

Project :
1880 BEL AIR RD
LOS ANGELES CA 90077

Owner:
Date
Scale
Drawn
Job
Sheet


A-7

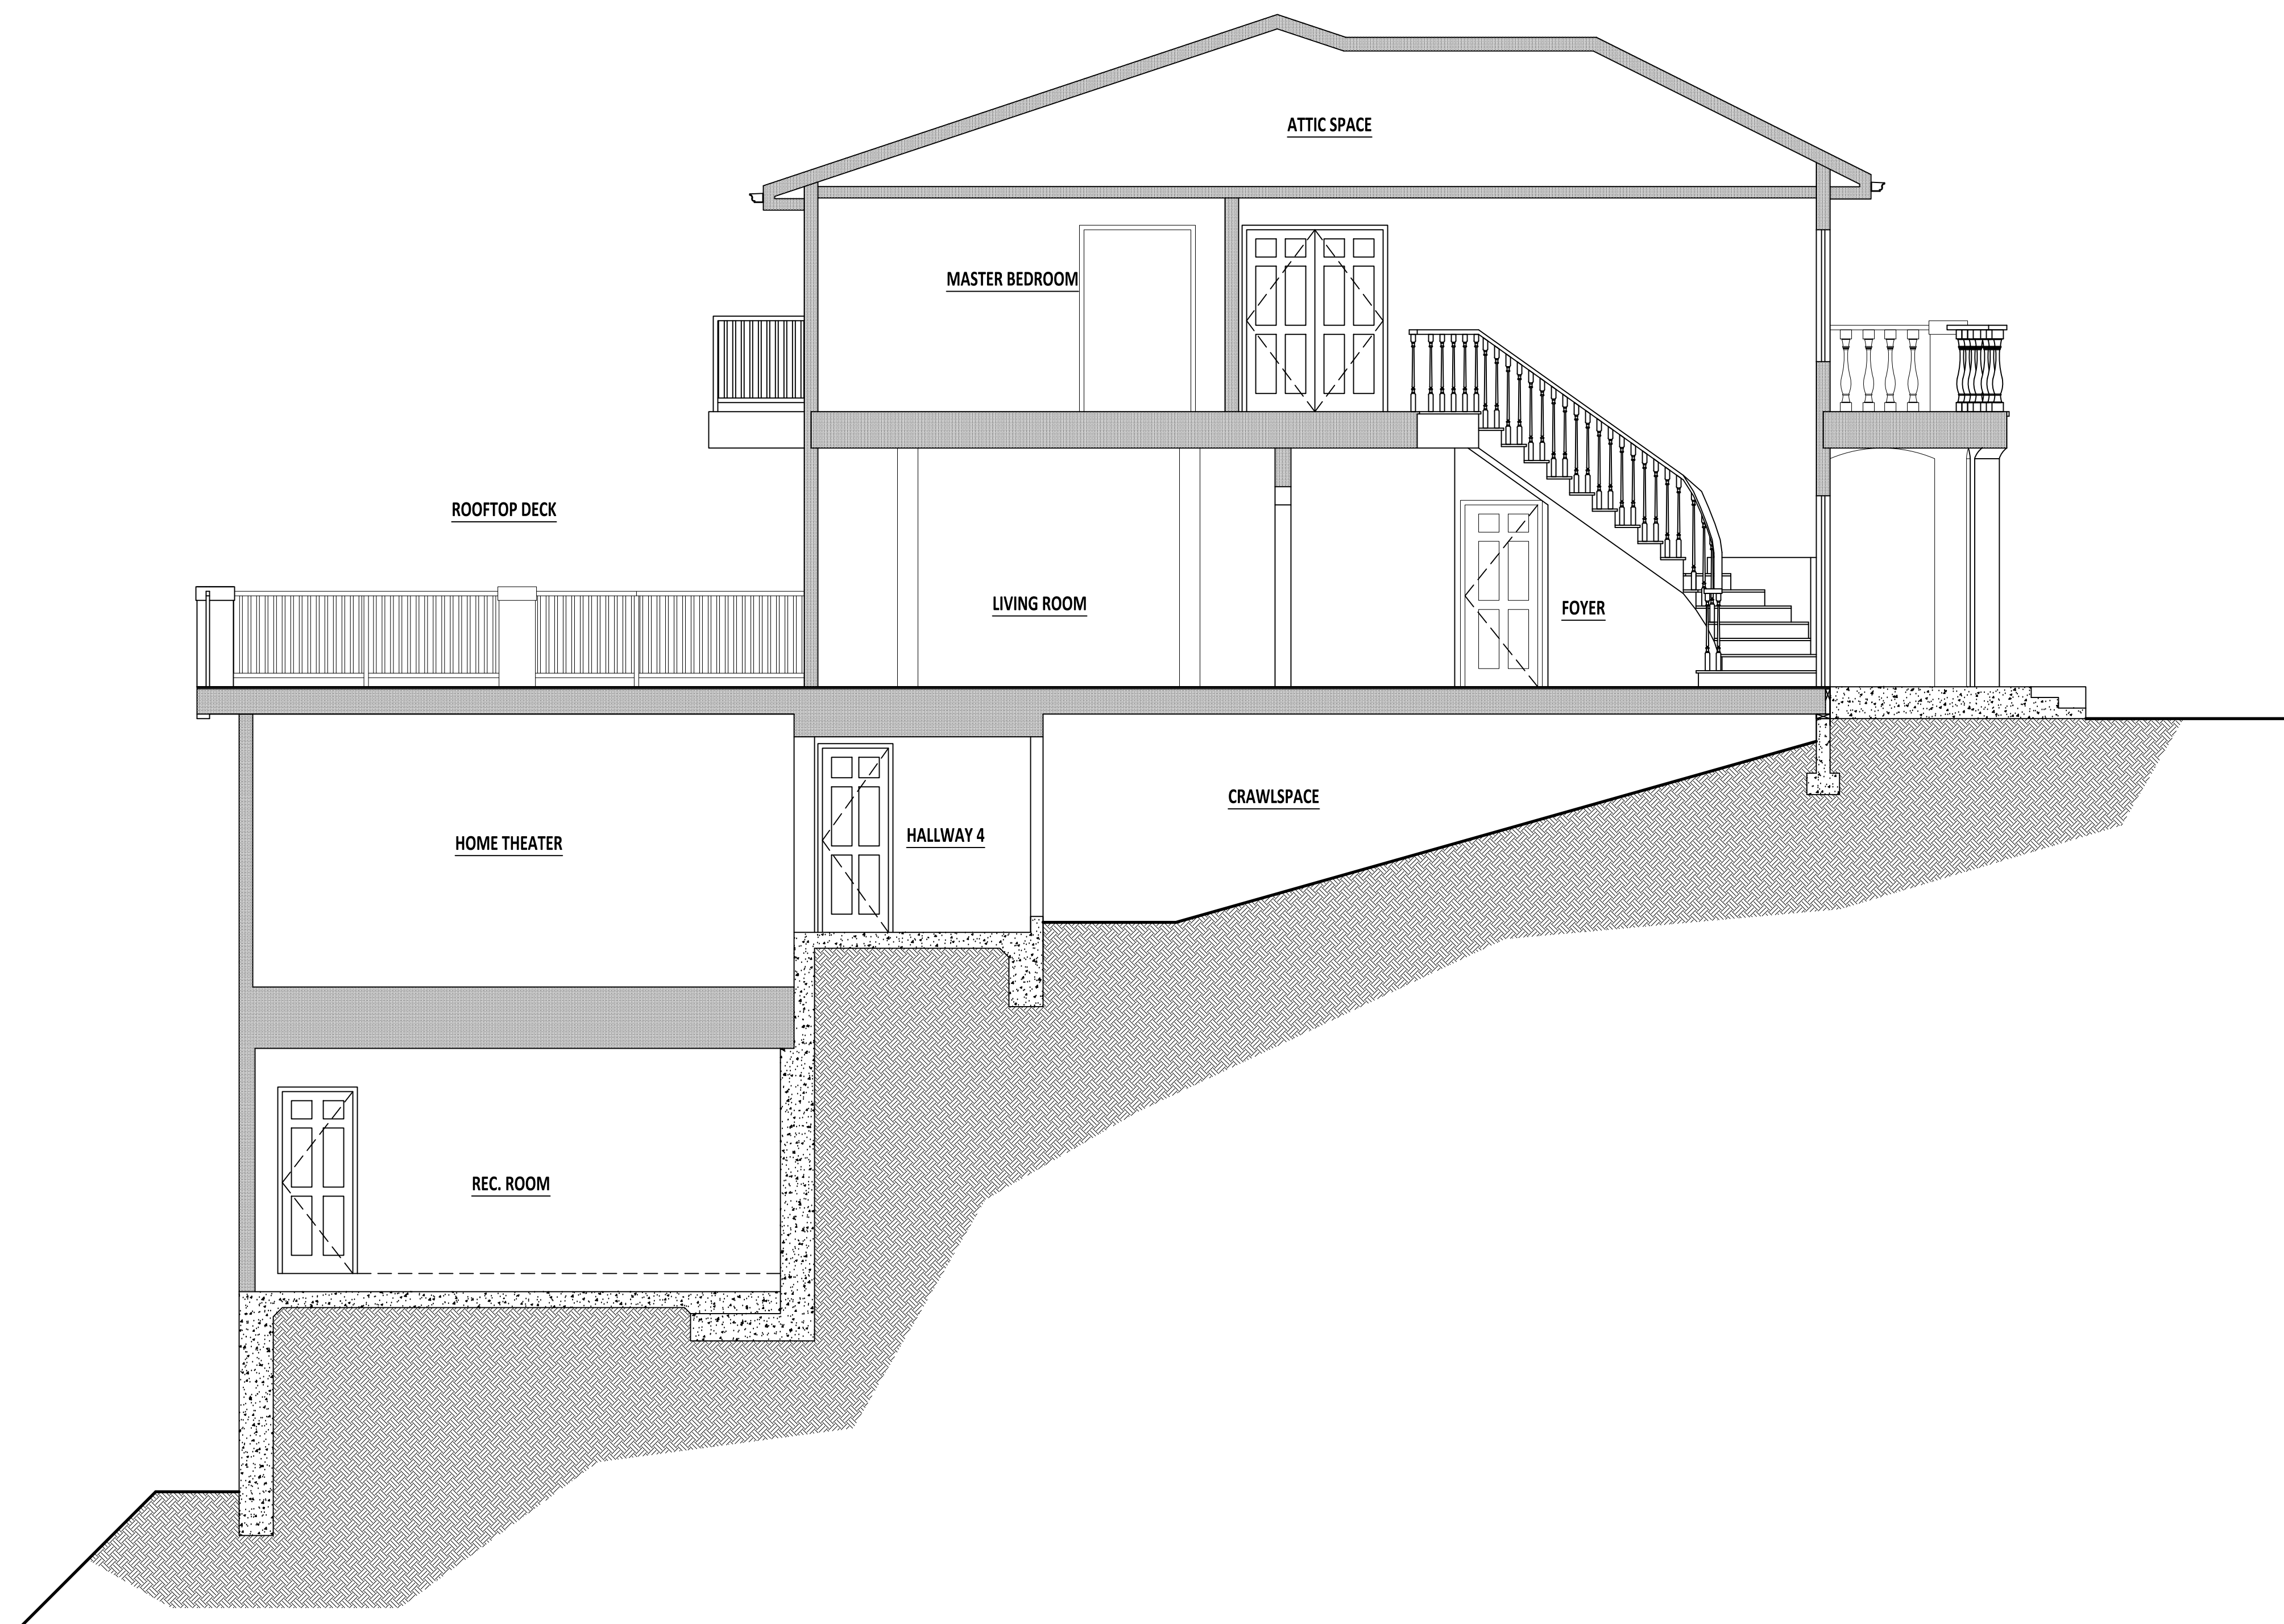


SECTION A-A



SCALE: 1/4" = 1'-0"

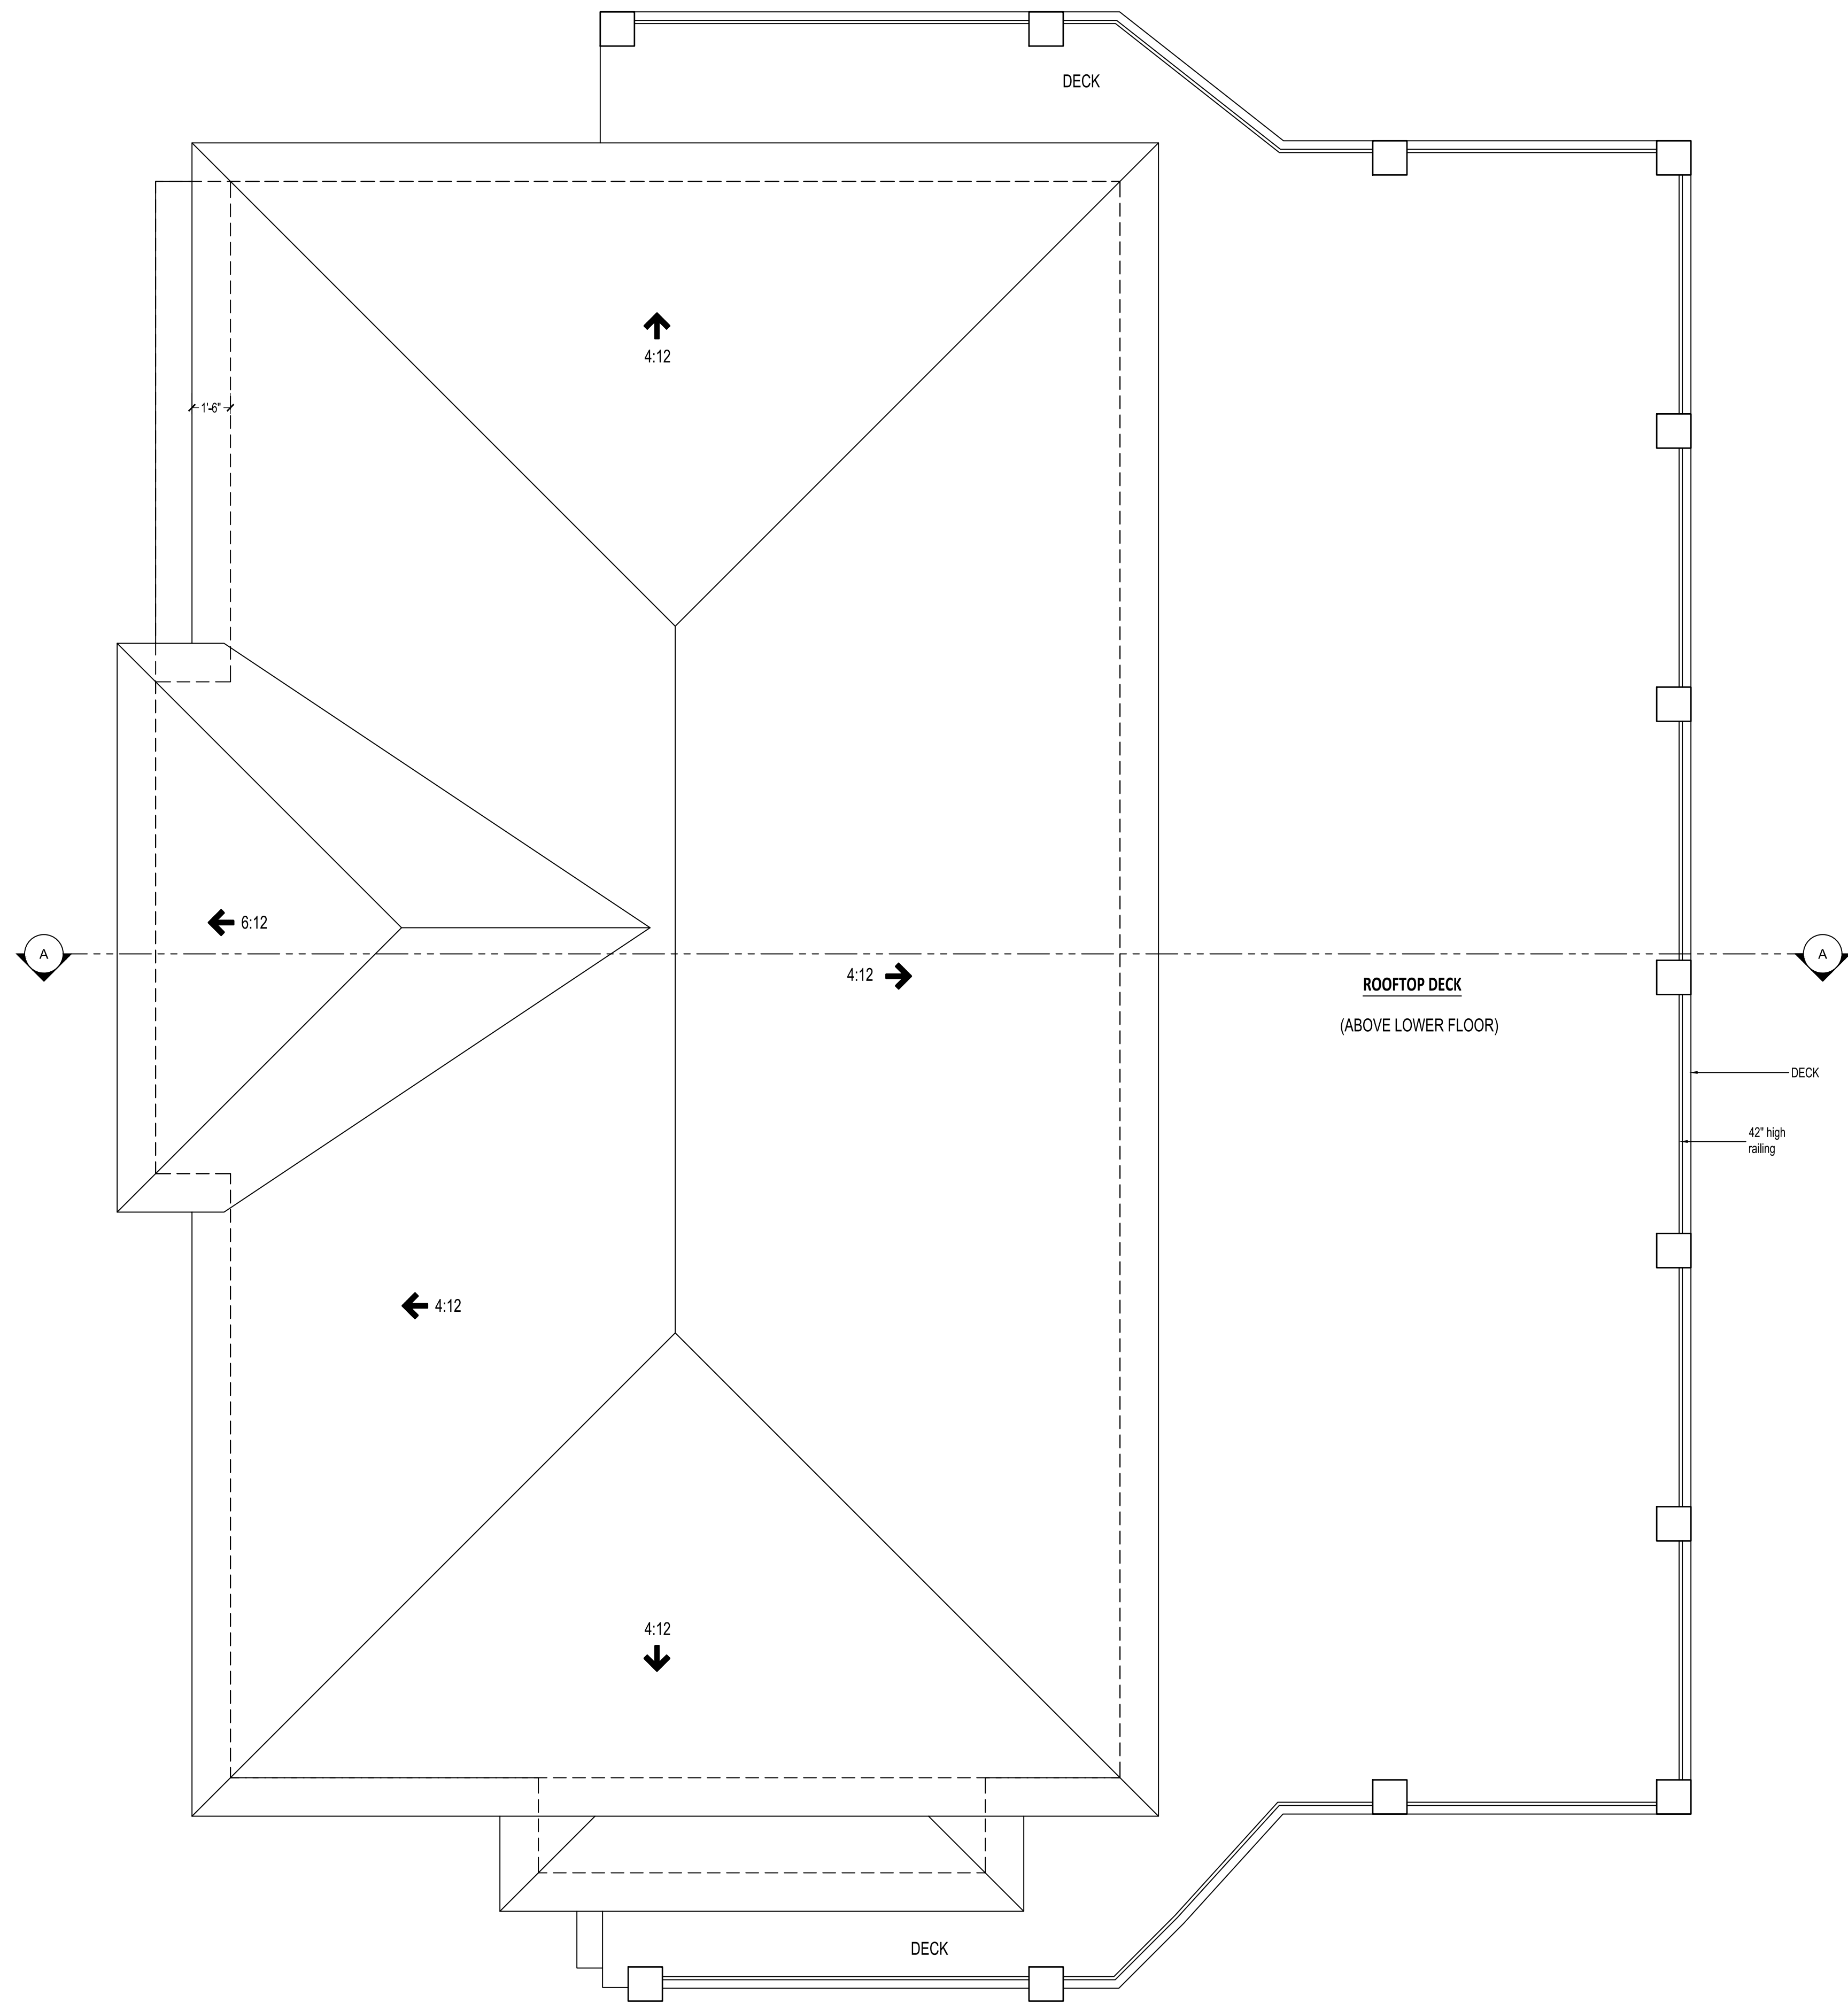

ROOF PLAN

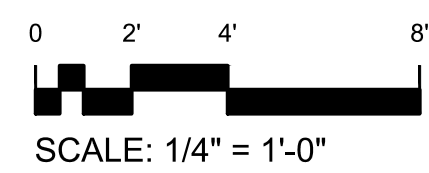

REVISIONS	BY

AS-BUILT
LOS ANGELES

Sheet content :
ROOF PLAN

Project :
1880 BEL AIR RD
LOS ANGELES CA 90077

Owner:

Date

Scale

Drawn

Job

Sheet

A-8