



PARKING LOT
 Assessor's ID No: 571-014-001
 Address: 571 S ANDERSON ST, LOS ANGELES CA 90033
 Property Boundary Description:
 TRACT # 207 S 23 AC COM N 196379' W
 235.59 FT FROM INTERSECTION OF NE LINE
 OF 6TH ST WITH SW LINE OF ANDERSON ST
 PER ORD # 10282 TH N 146379' W
 ...SEE MAPBOOK FOR MISSING PORTION...
 LOT 4

**THERE ARE NO
 PARKING STALL LINES**


**HYPERBLACK STUDIOS
 UNIT 2**
 Assessor's ID No: 571-011-002
 Address: 571 S ANDERSON ST, LOS ANGELES CA 90033
 Property Boundary Description:
 TRACT # 207 S 23 AC COM AT INTERSECTION
 OF NE LINE OF 6TH ST WITH SW LINE OF
 ANDERSON ST PER ORD # 10282 TH N 146379'
 235.59 FT FROM INTERSECTION OF NE LINE
 OF 6TH ST WITH SW LINE OF ANDERSON ST
 ...SEE MAPBOOK FOR MISSING PORTION...
 LOT 4

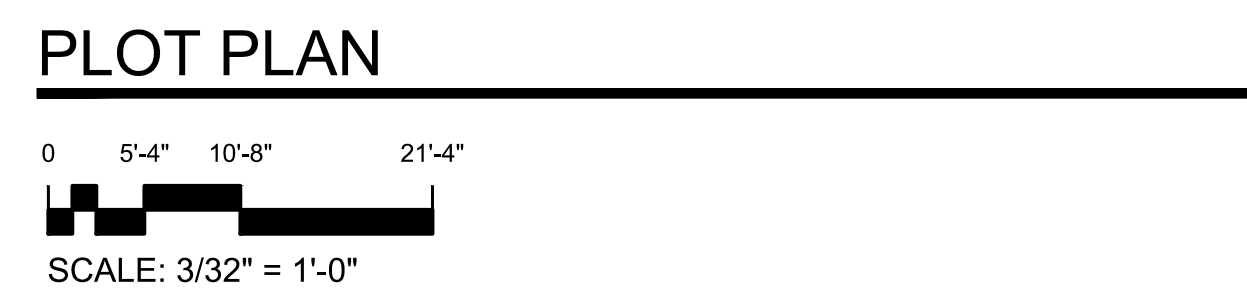

REVISIONS	BY
AS-BUILT LOS ANGELES	
Sheet content : PLOT PLAN	
Project :	571 S ANDERSON ST LOS ANGELES CA 90033
Owner:	
Date	
Scale	
Drawn	
Job	
Sheet	A-1

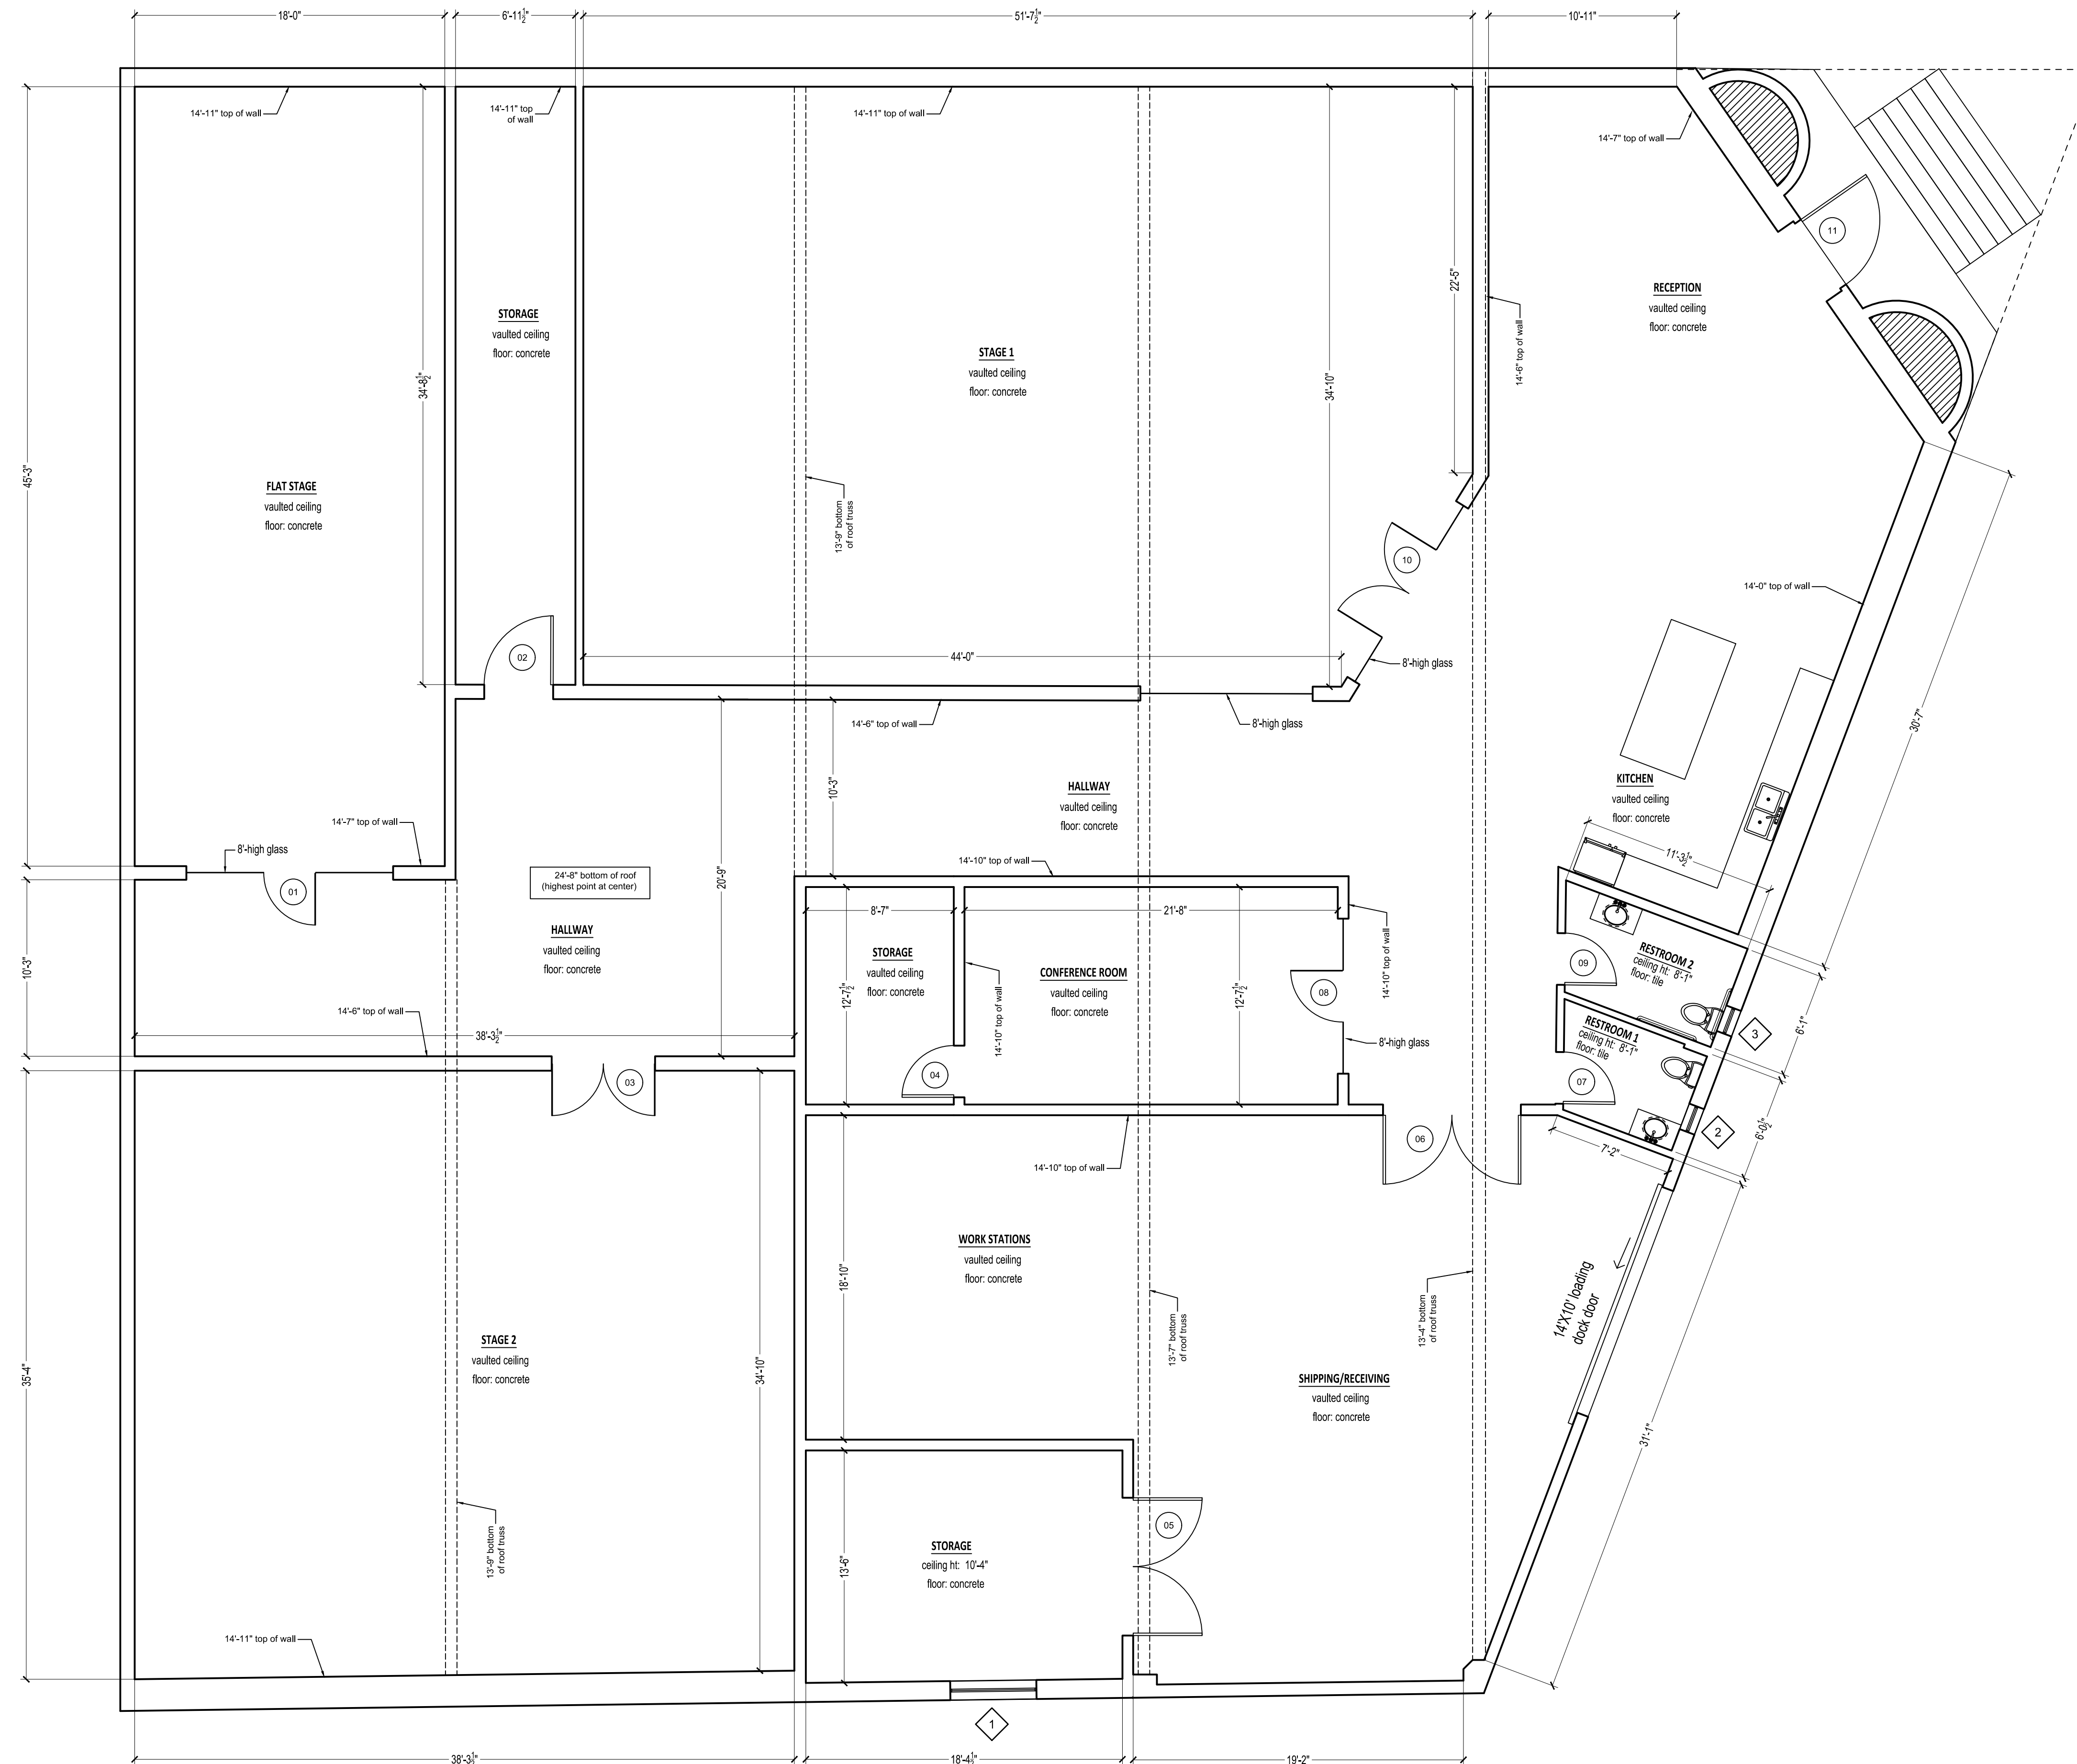

FLOOR PLAN

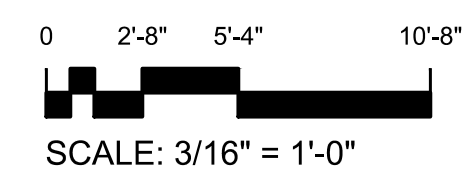

DOOR SCHEDULE				
MARK	DOOR SIZE		Type	NOTES
	WD	HGT		
1	3'-0"	6'-8"	GLASS	--
2	4'-0"	8'-0"	SWING	--
3	6'-0"	8'-0"	FRENCH DOUBLE	--
4	3'-0"	6'-8"	SWING	--
5	8'-0"	8'-0"	SWING DOUBLE	--
6	8'-0"	8'-0"	SWING DOUBLE	--
7	3'-0"	6'-8"	SWING	--
8	3'-0"	8'-0"	GLASS	--
9	3'-0"	6'-8"	SWING	--
10	6'-0"	8'-0"	FRENCH DOUBLE	--
11	4'-7"	7'-0"	FRENCH	--

WINDOW SCHEDULE					
MARK	SIZE		TYPE	Head Height	NOTES
	Width	HEIGHT			
1	5'-0"	5'-5"	FIXED	8'-2"	--
2	1'-7"	2'-6"	AWNING	7'-11"	--
3	1'-7"	2'-6"	AWNING	7'-11"	--

REVISIONS BY

AS-BUILT
LOS ANGELES

FLOOR PLAN

Sheet content :

Project : 571 S ANDERSON ST
LOS ANGELES CA 90033

Owner :

Date

Scale


Drawn

Job

Sheet

A-2

08.26.13

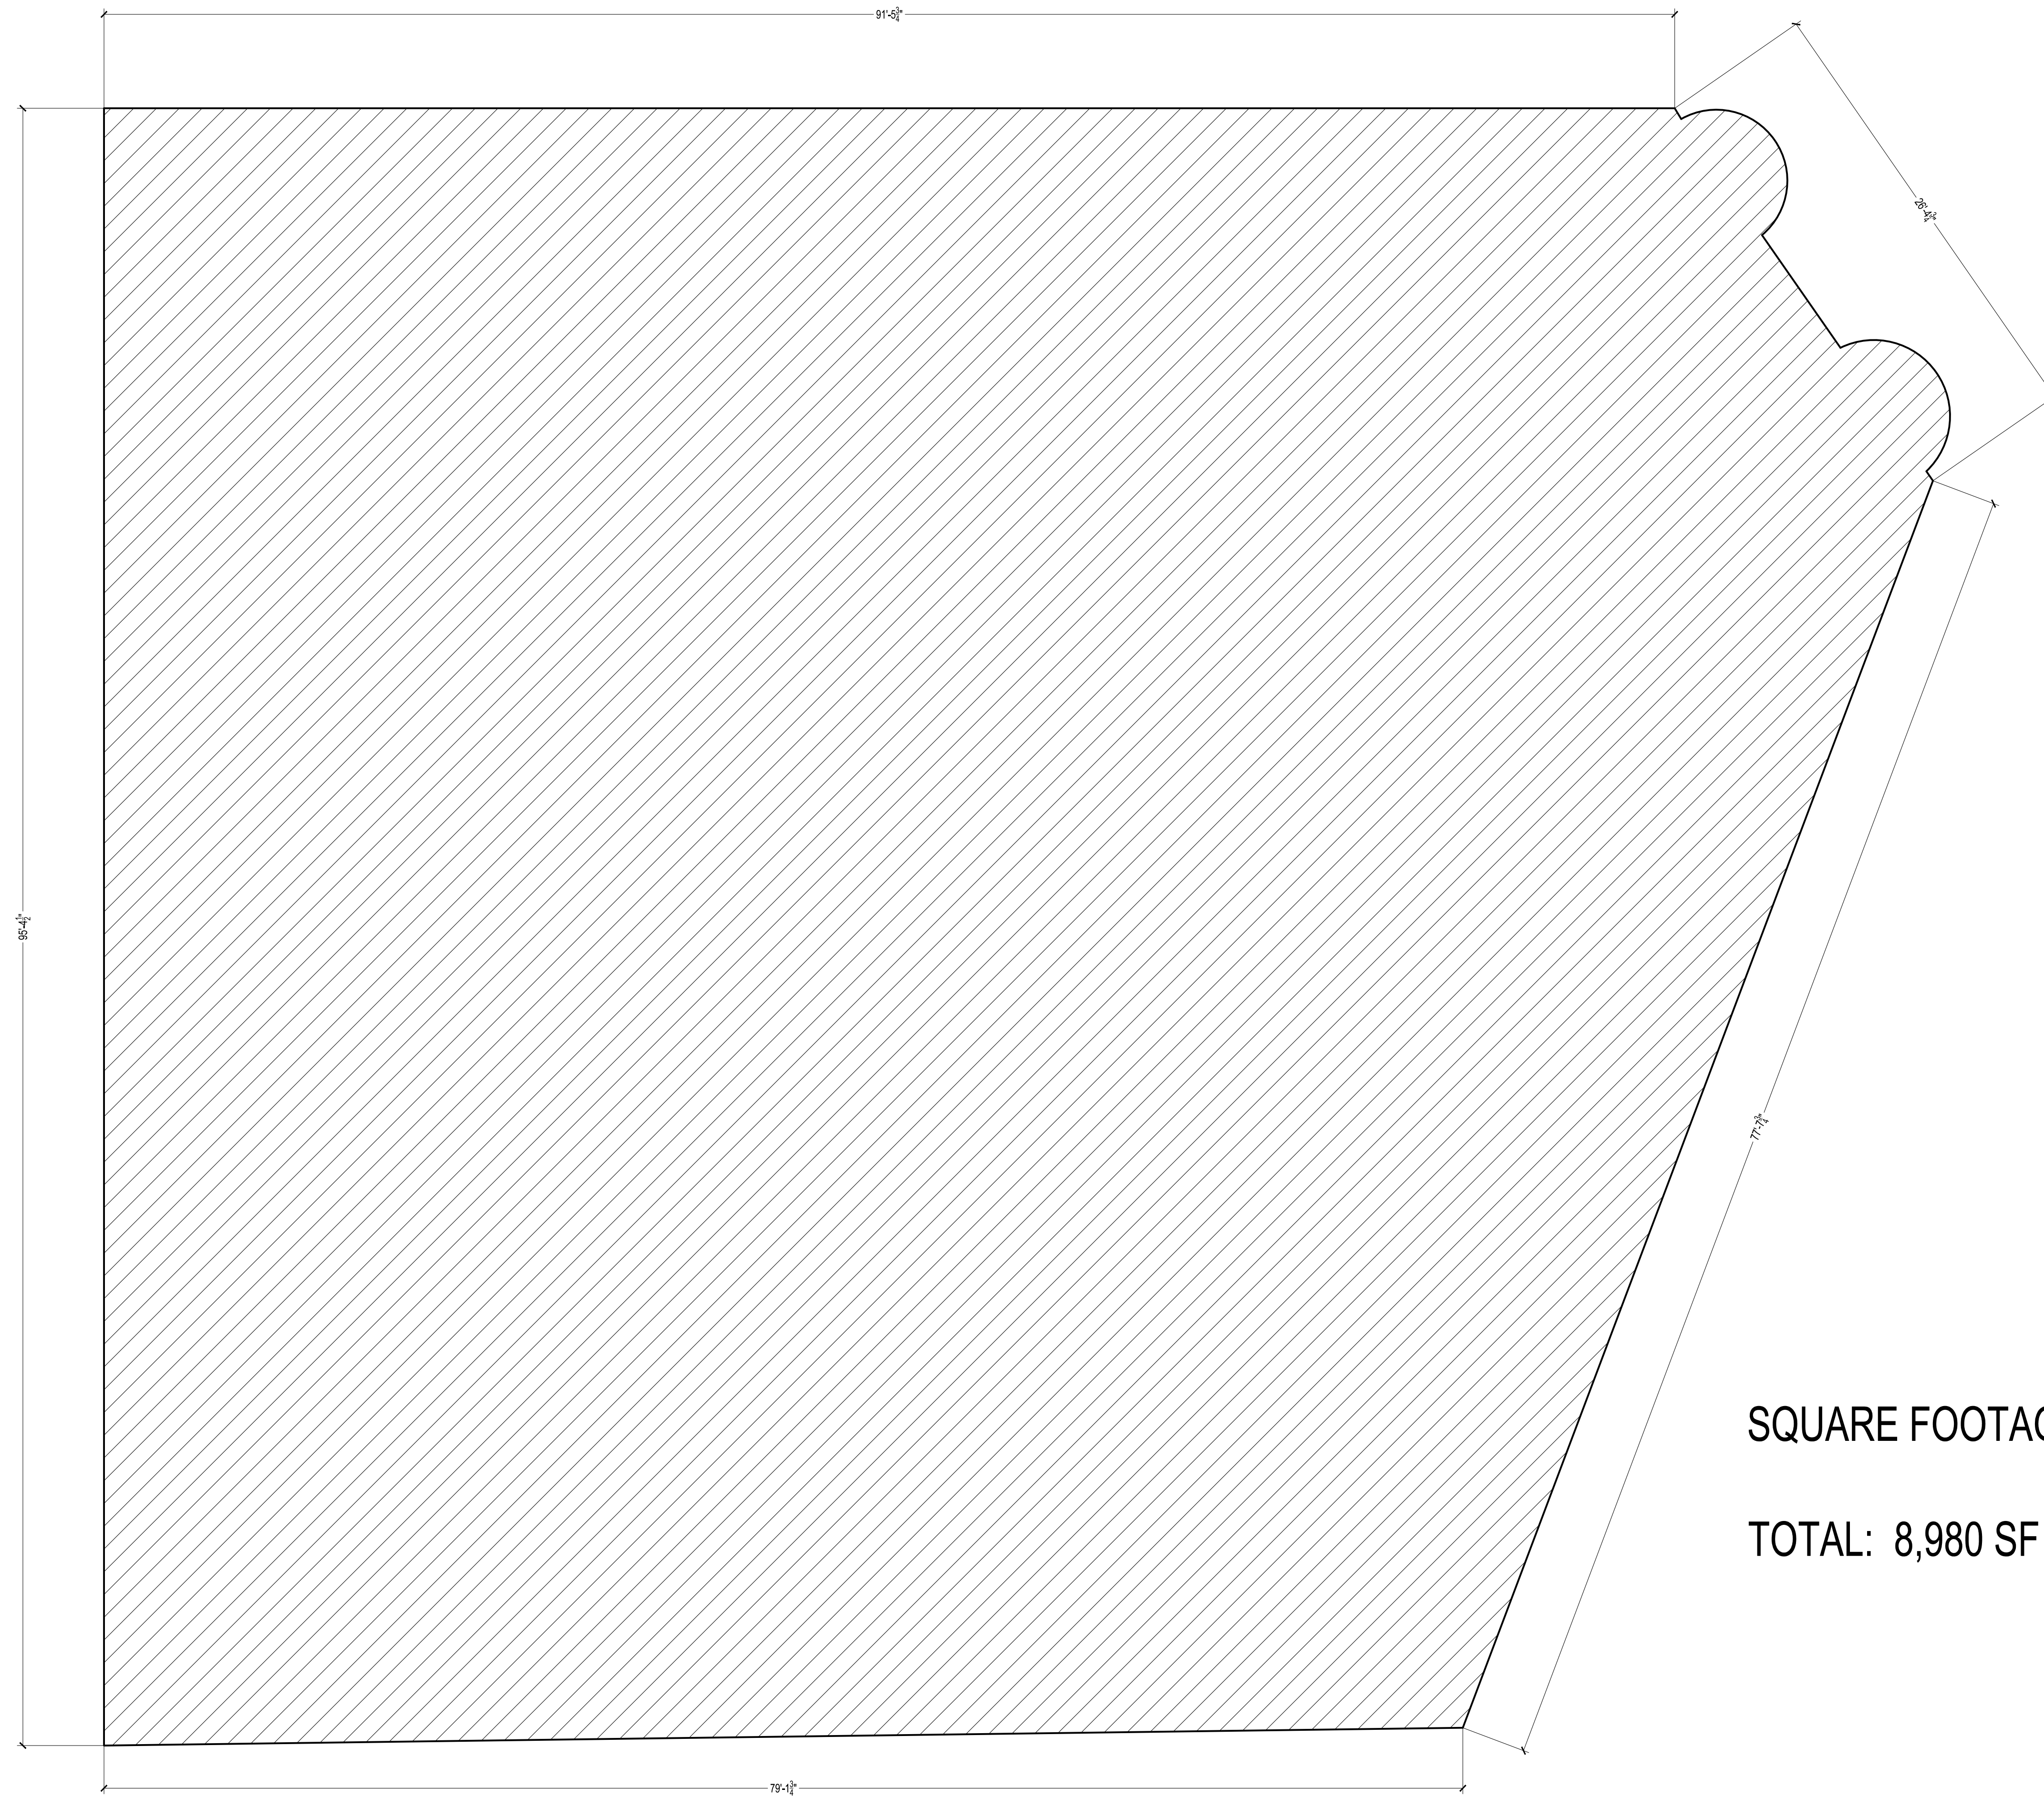

REVISIONS	BY
AS-BUILT LOS ANGELES	
Sheet content : SQUARE FOOTAGE CALCULATION	
Project : 571 S ANDERSON ST LOS ANGELES CA 90033	
Owner:	
Date	
Scale	
Drawn	
Job	
Sheet	A-3