



BEVERLY BLVD

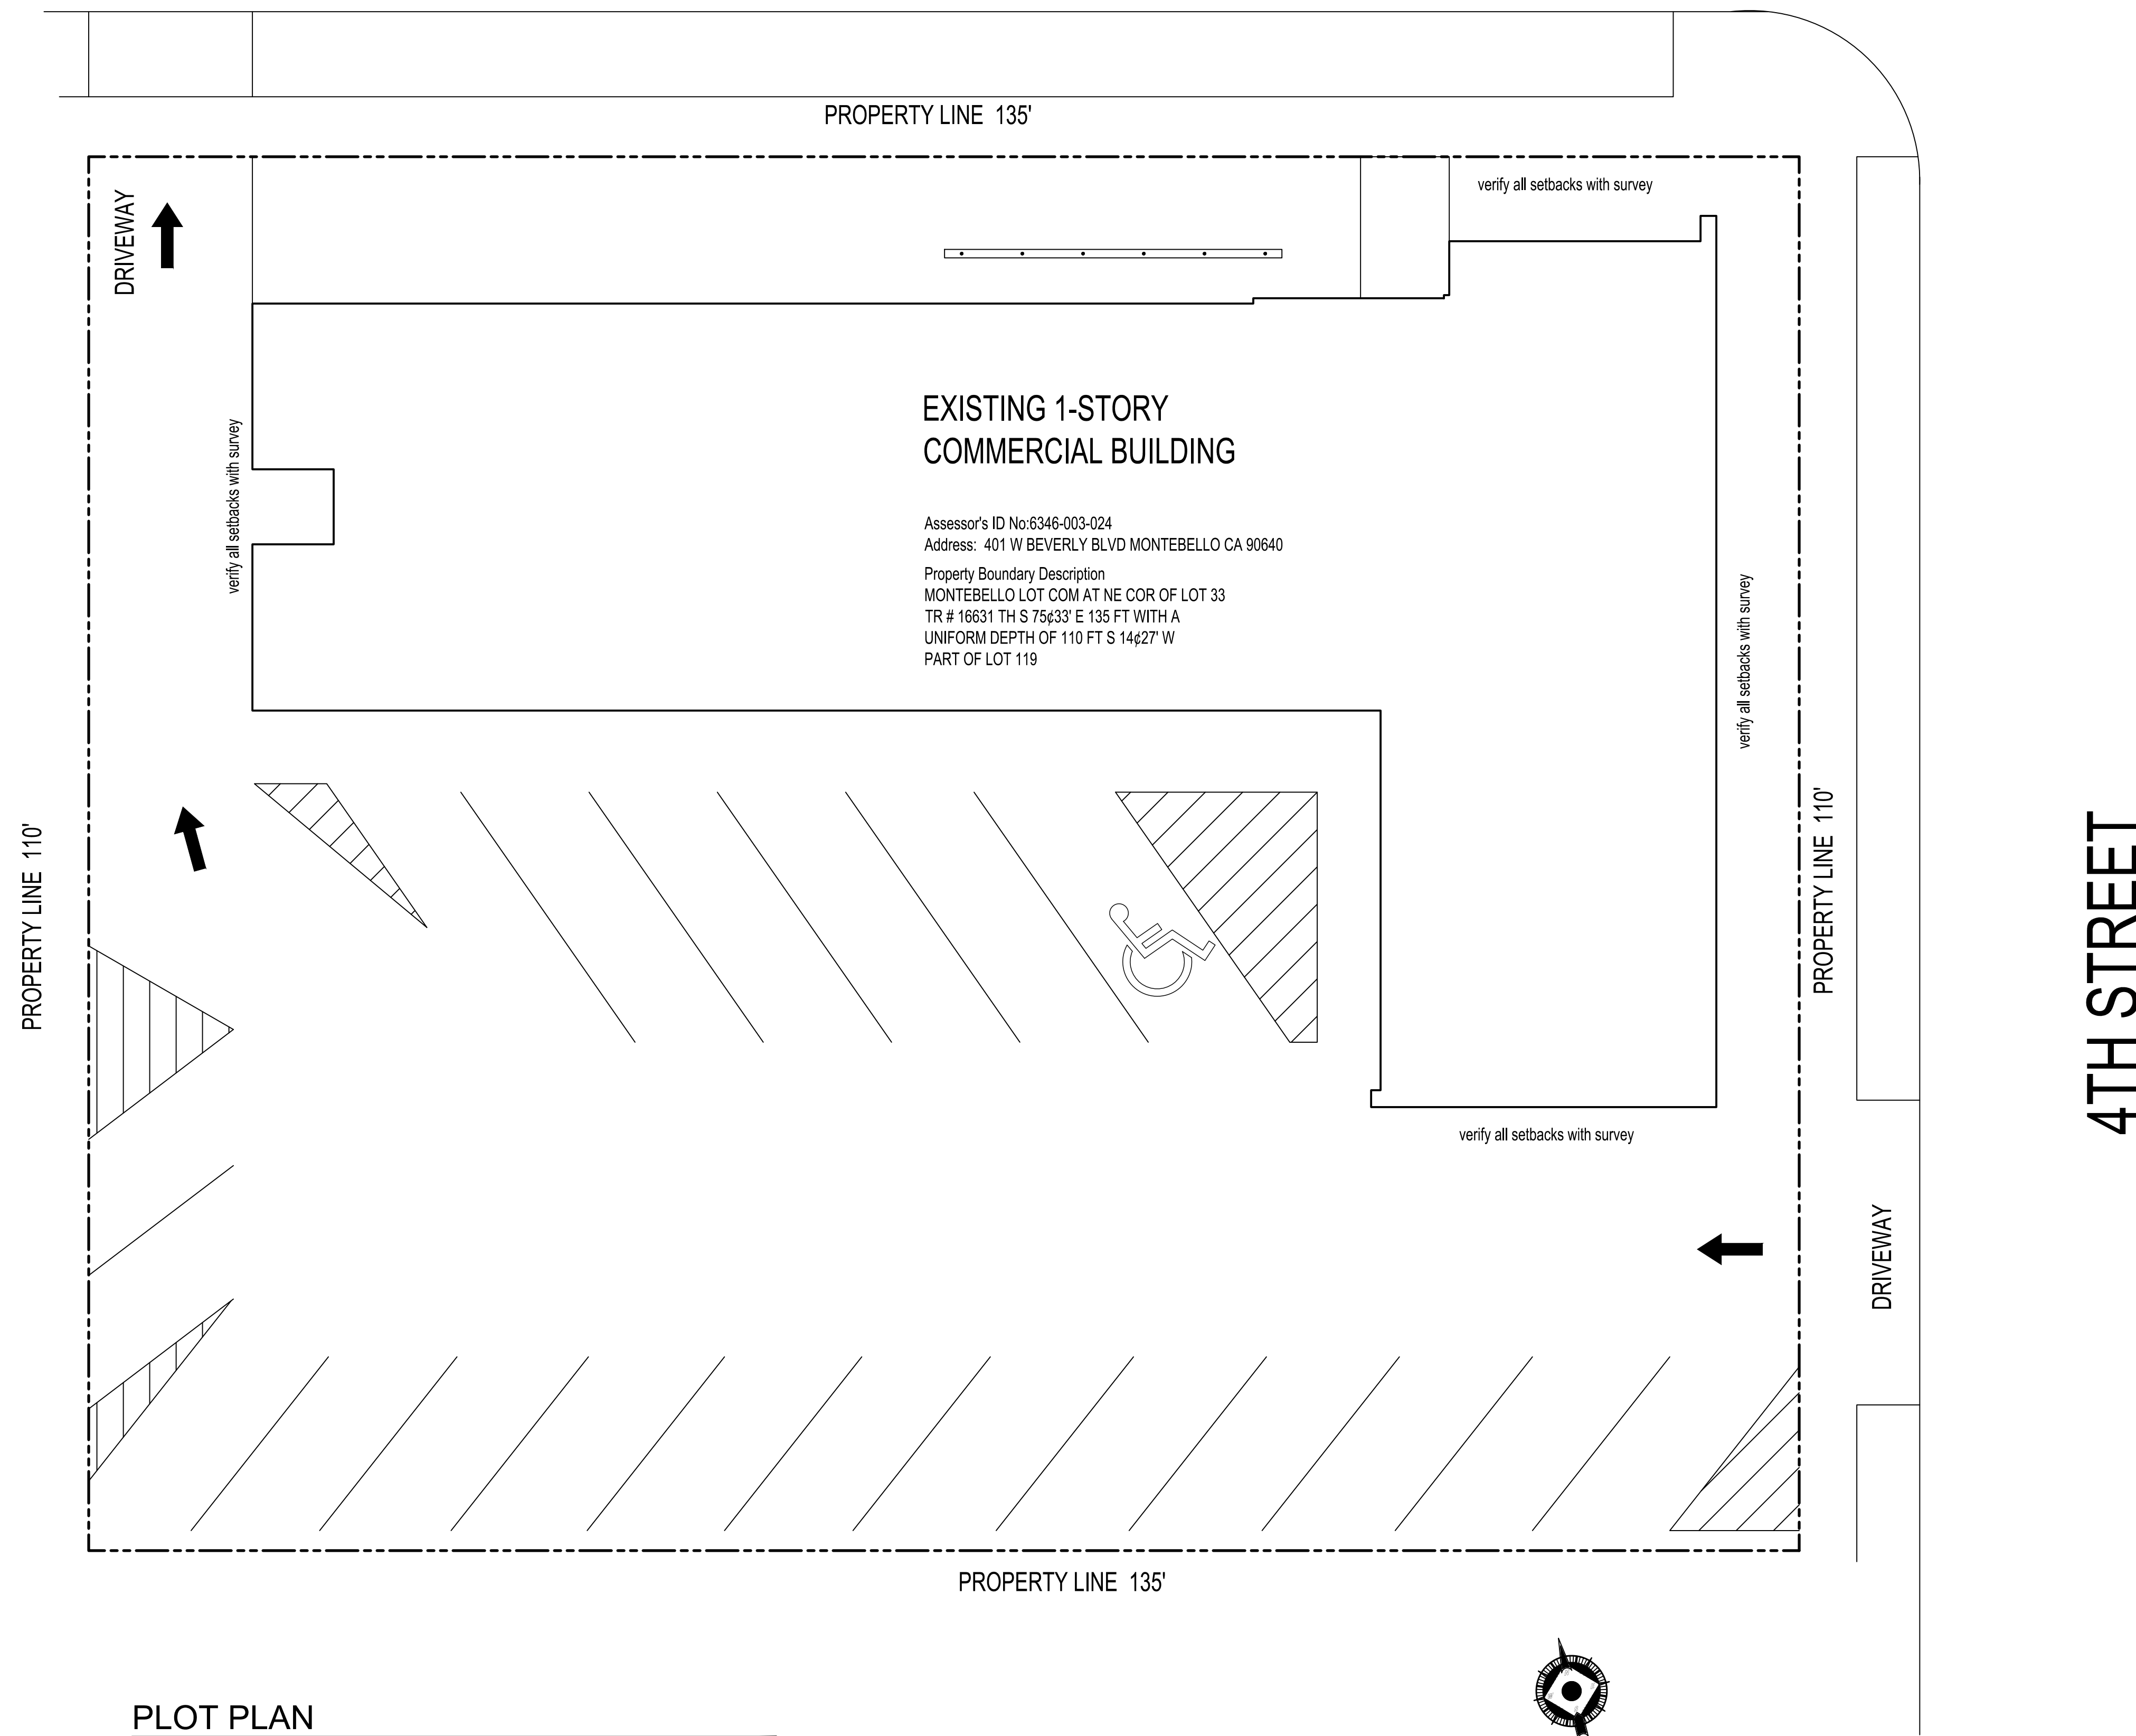

PLOT PLAN

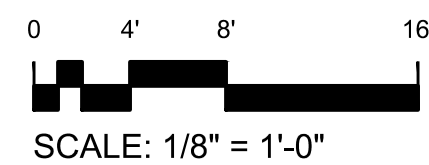

REVISIONS BY

AS-BUILT
LOS ANGELES

Sheet content:
PLOT PLAN

Project:
401 W BEVERLY BLVD
MONTEBELLO CA 90640

Owner:

Date

Scale

Drawn

Job

Sheet

A-1

REVISIONS	BY

AS-BUILT
LOS ANGELES

FLOOR PLAN

Sheet content:


Project: 401 W BEVERLY BLVD
MONTEBELLO CA 90640

Owner:

Date
Scale
Drawn
Job
Sheet


A-2

08.08.13

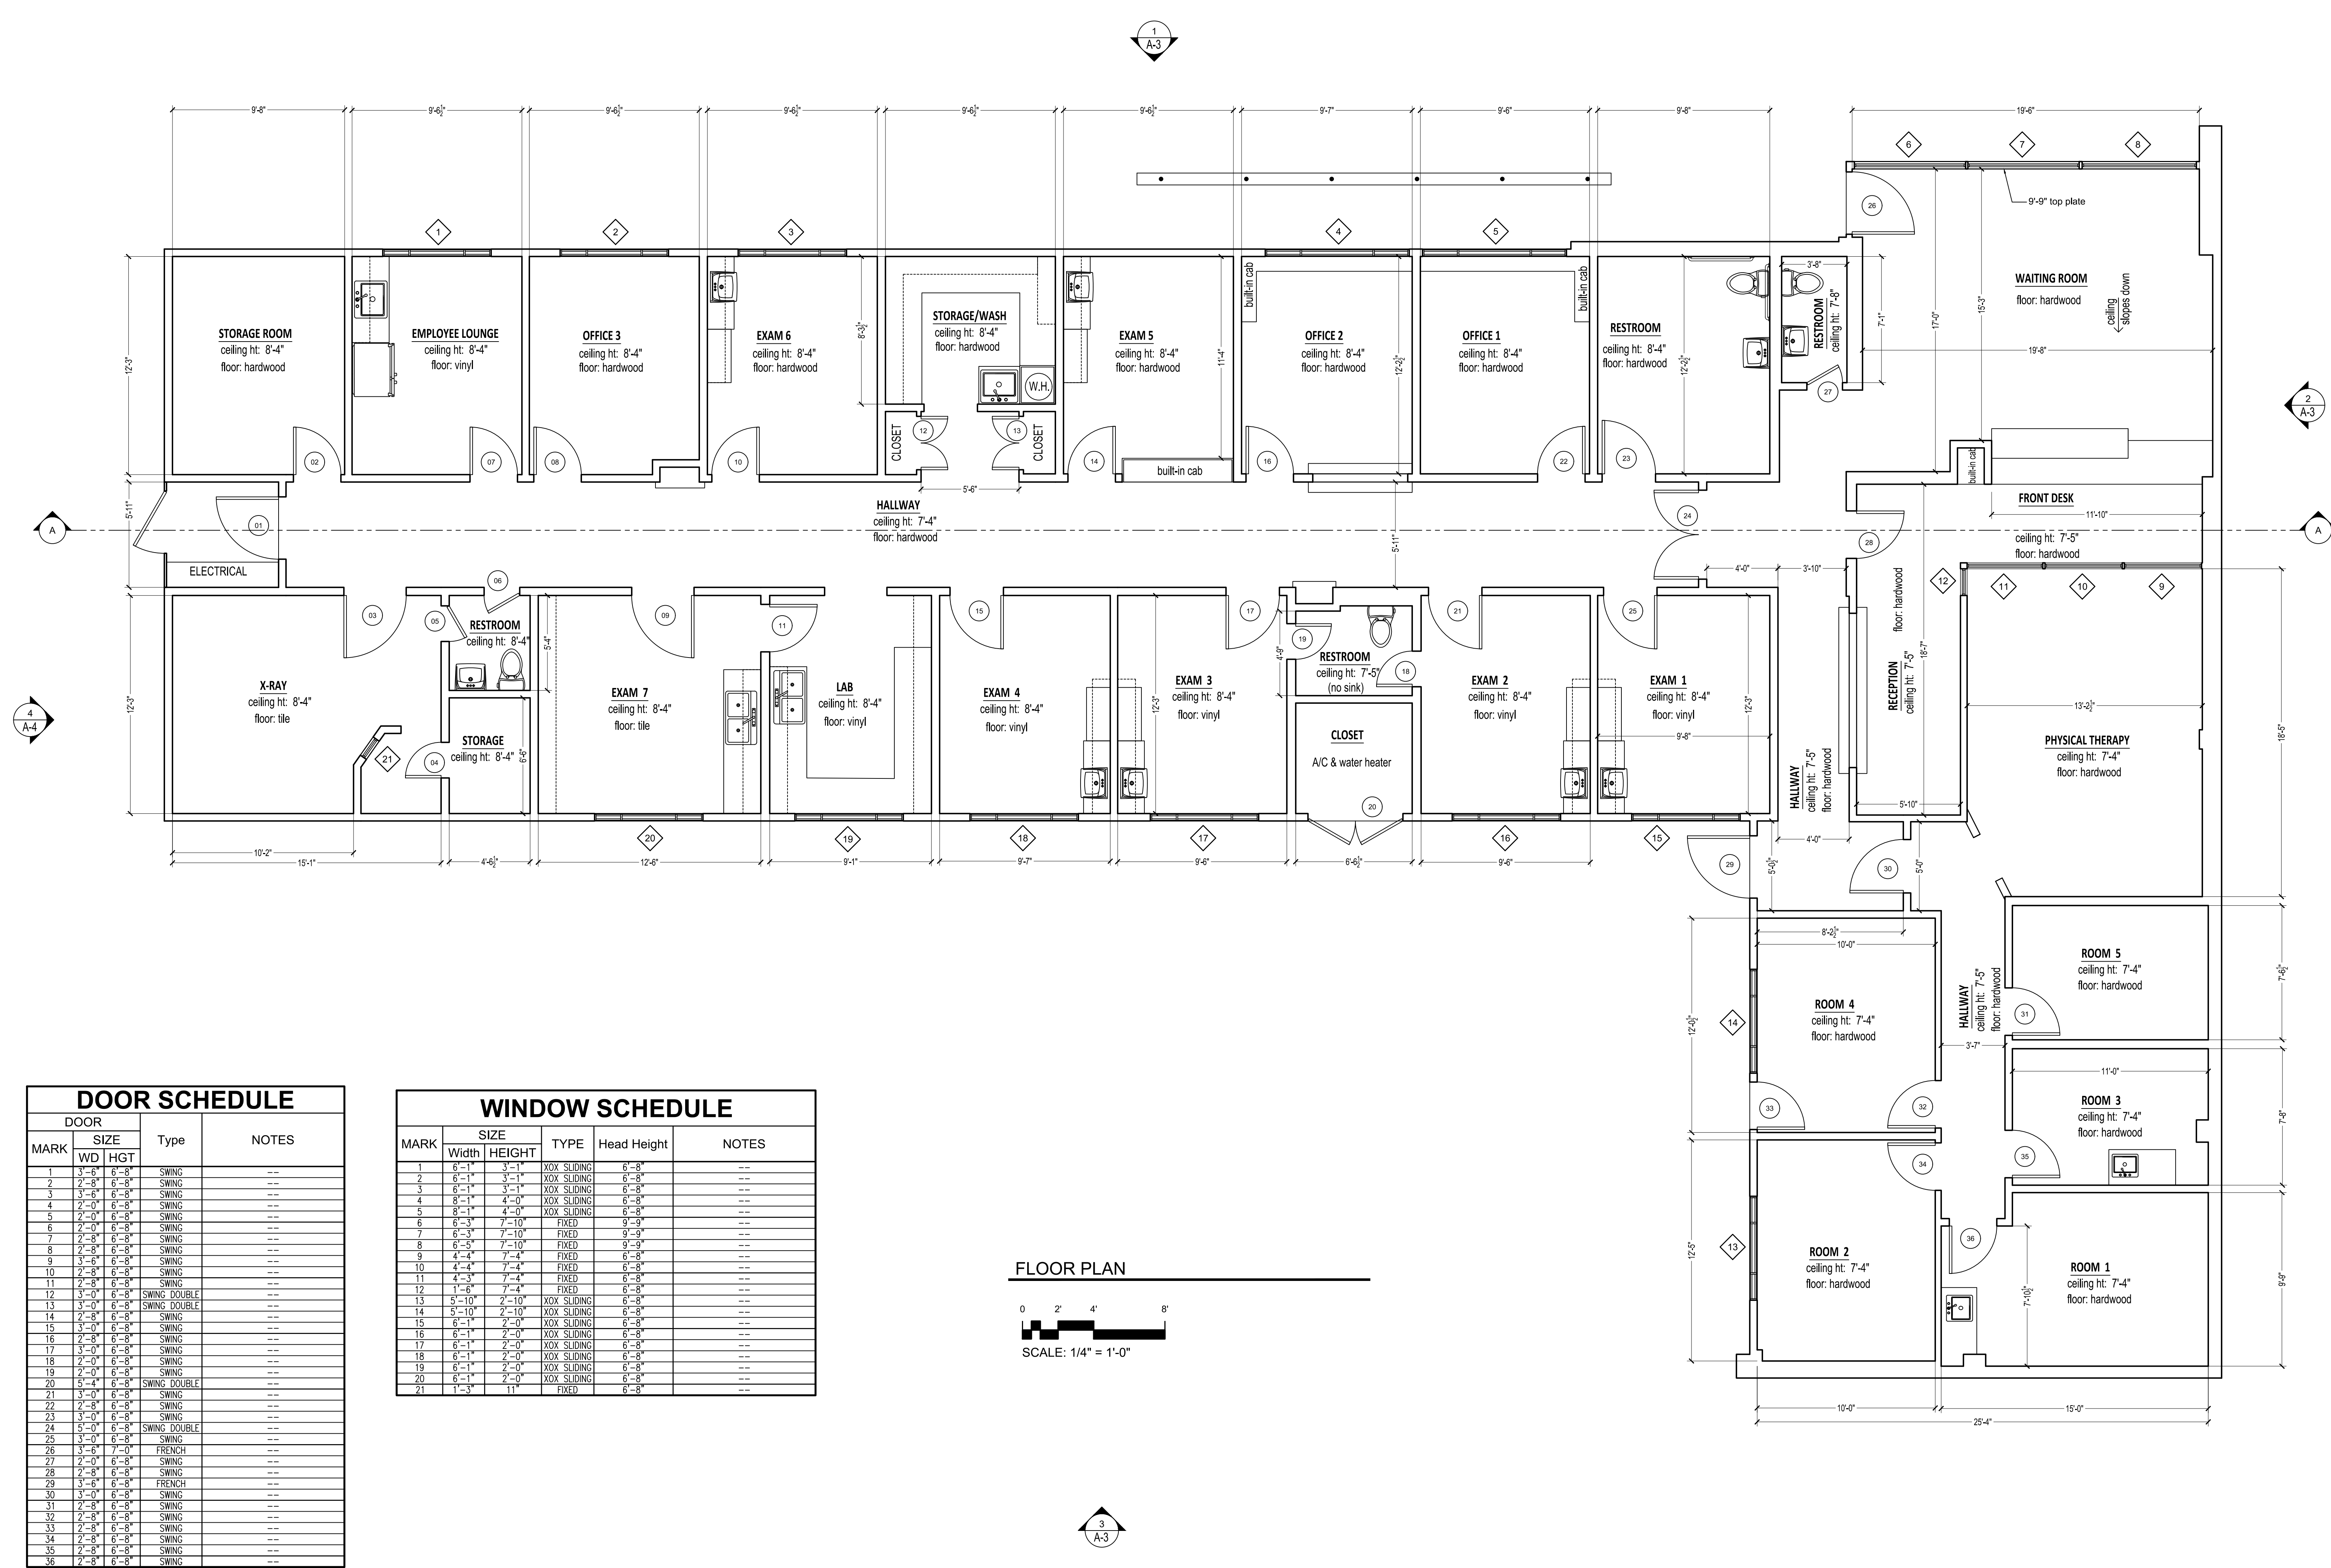


DOOR SCHEDULE				
MARK	DOOR SIZE		Type	NOTES
	WD	HGT		
1	3'-6"	6'-8"	SWING	---
2	2'-8"	6'-8"	SWING	---
3	3'-6"	6'-8"	SWING	---
4	2'-0"	6'-8"	SWING	---
5	2'-0"	6'-8"	SWING	---
6	2'-0"	6'-8"	SWING	---
7	2'-8"	6'-8"	SWING	---
8	2'-8"	6'-8"	SWING	---
9	3'-6"	6'-8"	SWING	---
10	2'-8"	6'-8"	SWING	---
11	2'-8"	6'-8"	SWING	---
12	3'-0"	6'-8"	SWING DOUBLE	---
13	3'-0"	6'-8"	SWING DOUBLE	---
14	2'-8"	6'-8"	SWING	---
15	3'-0"	6'-8"	SWING	---
16	2'-8"	6'-8"	SWING	---
17	3'-0"	6'-8"	SWING	---
18	2'-0"	6'-8"	SWING	---
19	2'-0"	6'-8"	SWING	---
20	5'-4"	6'-8"	SWING DOUBLE	---
21	3'-0"	6'-8"	SWING	---
22	2'-8"	6'-8"	SWING	---
23	3'-0"	6'-8"	SWING	---
24	5'-0"	6'-8"	SWING DOUBLE	---
25	3'-0"	6'-8"	SWING	---
26	3'-6"	7'-0"	FRENCH	---
27	2'-0"	6'-8"	SWING	---
28	2'-8"	6'-8"	SWING	---
29	3'-6"	6'-8"	FRENCH	---
30	3'-0"	6'-8"	SWING	---
31	2'-8"	6'-8"	SWING	---
32	2'-8"	6'-8"	SWING	---
33	2'-8"	6'-8"	SWING	---
34	2'-8"	6'-8"	SWING	---
35	2'-8"	6'-8"	SWING	---
36	2'-8"	6'-8"	SWING	---

WINDOW SCHEDULE					
MARK	SIZE		TYPE	Head Height	NOTES
	Width	HEIGHT			
1	6'-1"	3'-1"	XOX SLIDING	6'-8"	---
2	6'-1"	3'-1"	XOX SLIDING	6'-8"	---
3	6'-1"	3'-1"	XOX SLIDING	6'-8"	---
4	8'-1"	4'-0"	XOX SLIDING	6'-8"	---
5	8'-1"	4'-0"	XOX SLIDING	6'-8"	---
6	6'-3"	7'-10"	FIXED	9'-9"	---
7	6'-3"	7'-10"	FIXED	9'-9"	---
8	6'-5"	7'-10"	FIXED	9'-9"	---
9	4'-4"	7'-4"	FIXED	6'-8"	---
10	4'-4"	7'-4"	FIXED	6'-8"	---
11	4'-3"	7'-4"	FIXED	6'-8"	---
12	1'-6"	7'-4"	FIXED	6'-8"	---
13	5'-10"	2'-10"	XOX SLIDING	6'-8"	---
14	2'-10"	2'-10"	XOX SLIDING	6'-8"	---
15	6'-1"	2'-0"	XOX SLIDING	6'-8"	---
16	6'-1"	2'-0"	XOX SLIDING	6'-8"	---
17	6'-1"	2'-0"	XOX SLIDING	6'-8"	---
18	6'-1"	2'-0"	XOX SLIDING	6'-8"	---
19	6'-1"	2'-0"	XOX SLIDING	6'-8"	---
20	6'-1"	2'-0"	XOX SLIDING	6'-8"	---
21	1'-3"	11"	FIXED	6'-8"	---

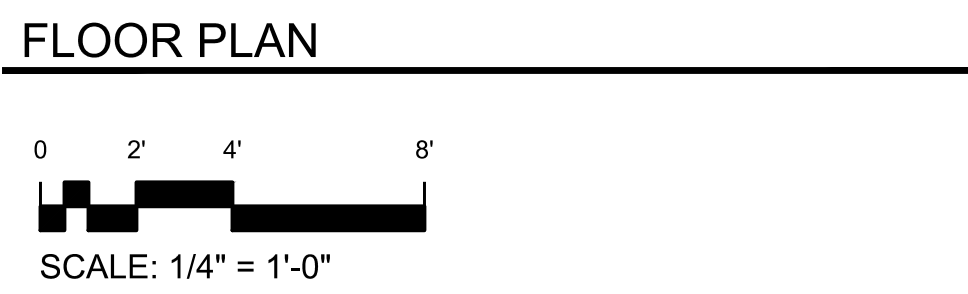


3
A-3

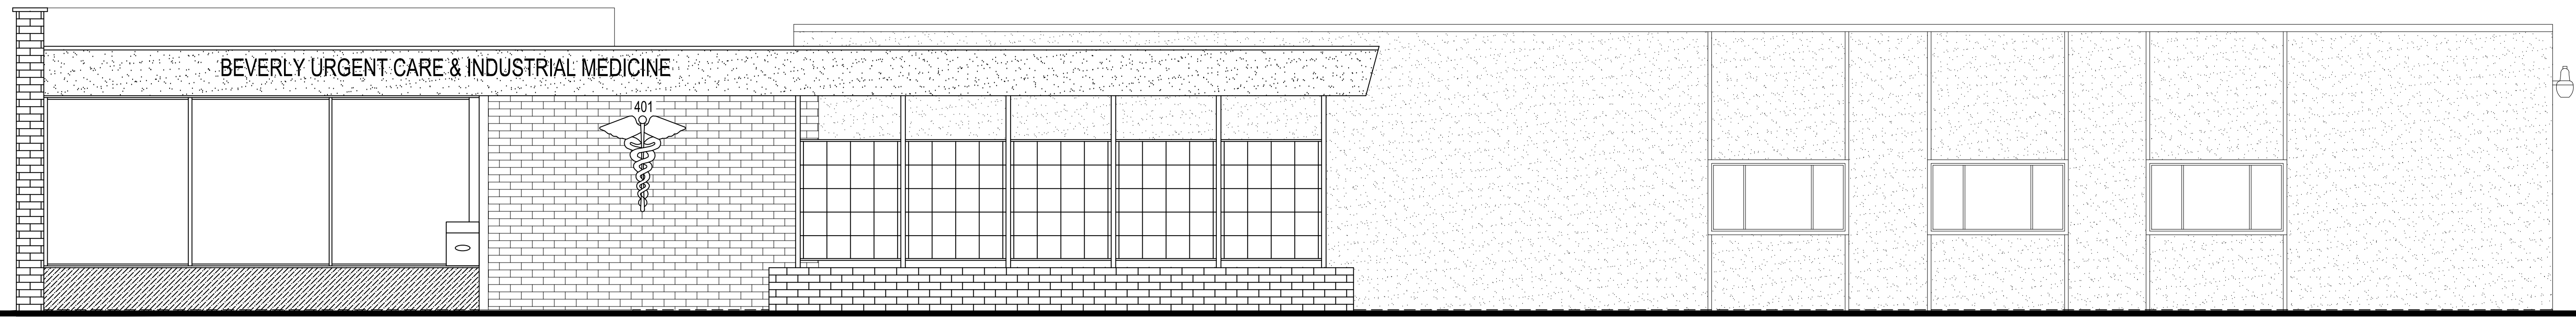


1 N. ELEVATION

SCALE: 1/4" = 1'-0"

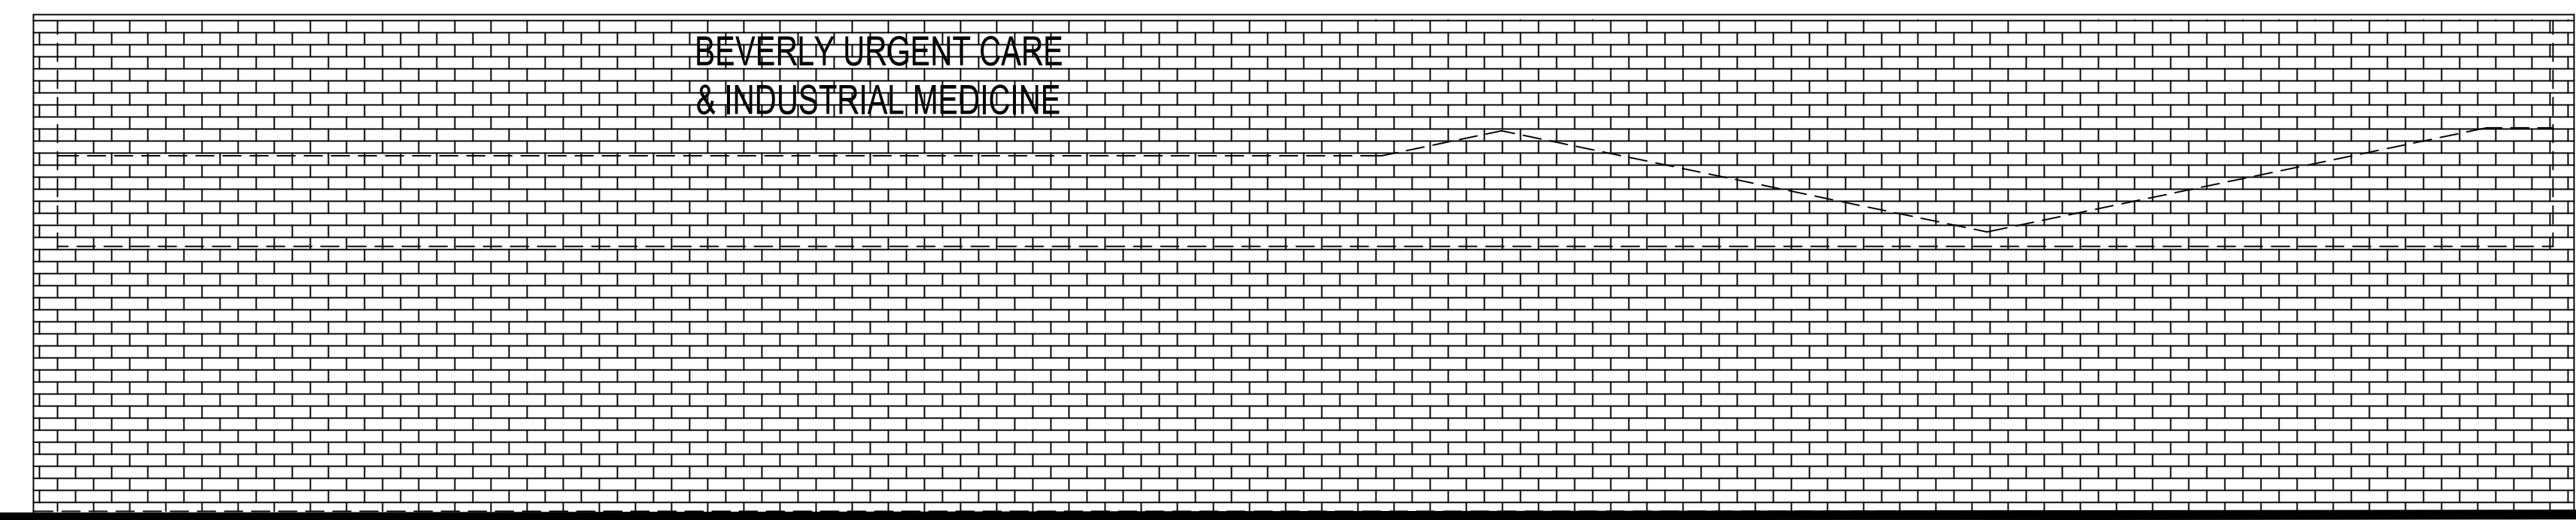

2 E. ELEVATION

SCALE: 1/4" = 1'-0"

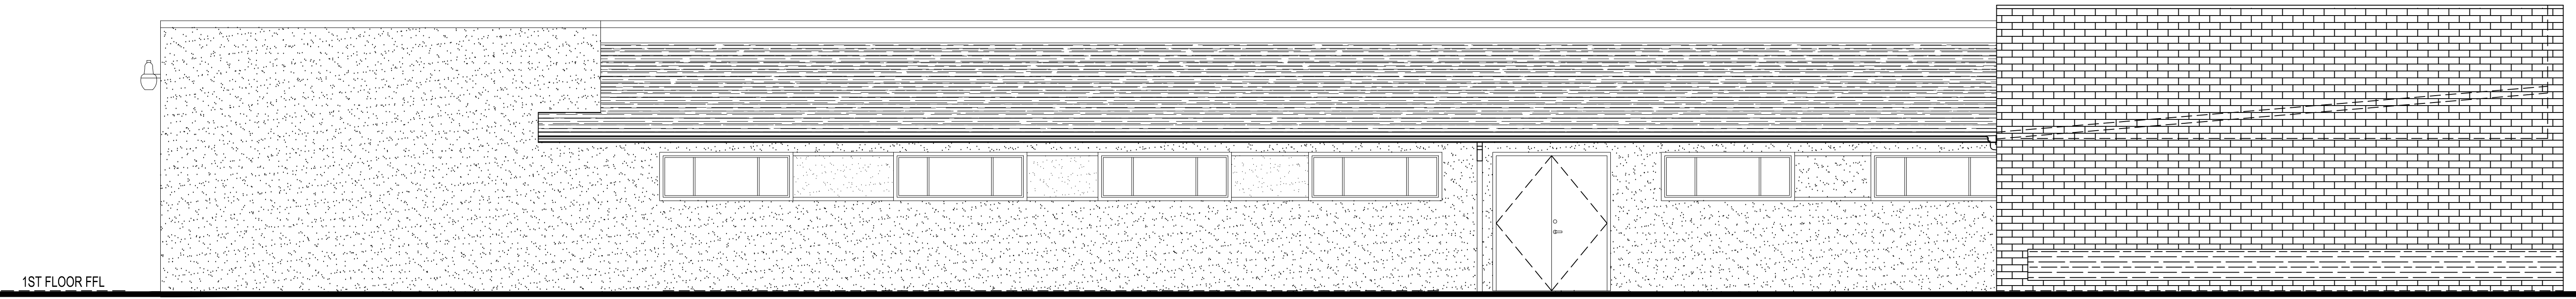

3 S. ELEVATION

SCALE: 1/4" = 1'-0"

REVISIONS	BY

AS-BUILT
LOS ANGELES

Sheet content:
ELEVATIONS


Project:
401 W BEVERLY BLVD
MONTEBELLO CA 90640

Owner:
Date
Scale
Drawn
Job
Sheet


A-3

REVISIONS	BY

AS-BUILT
LOS ANGELES

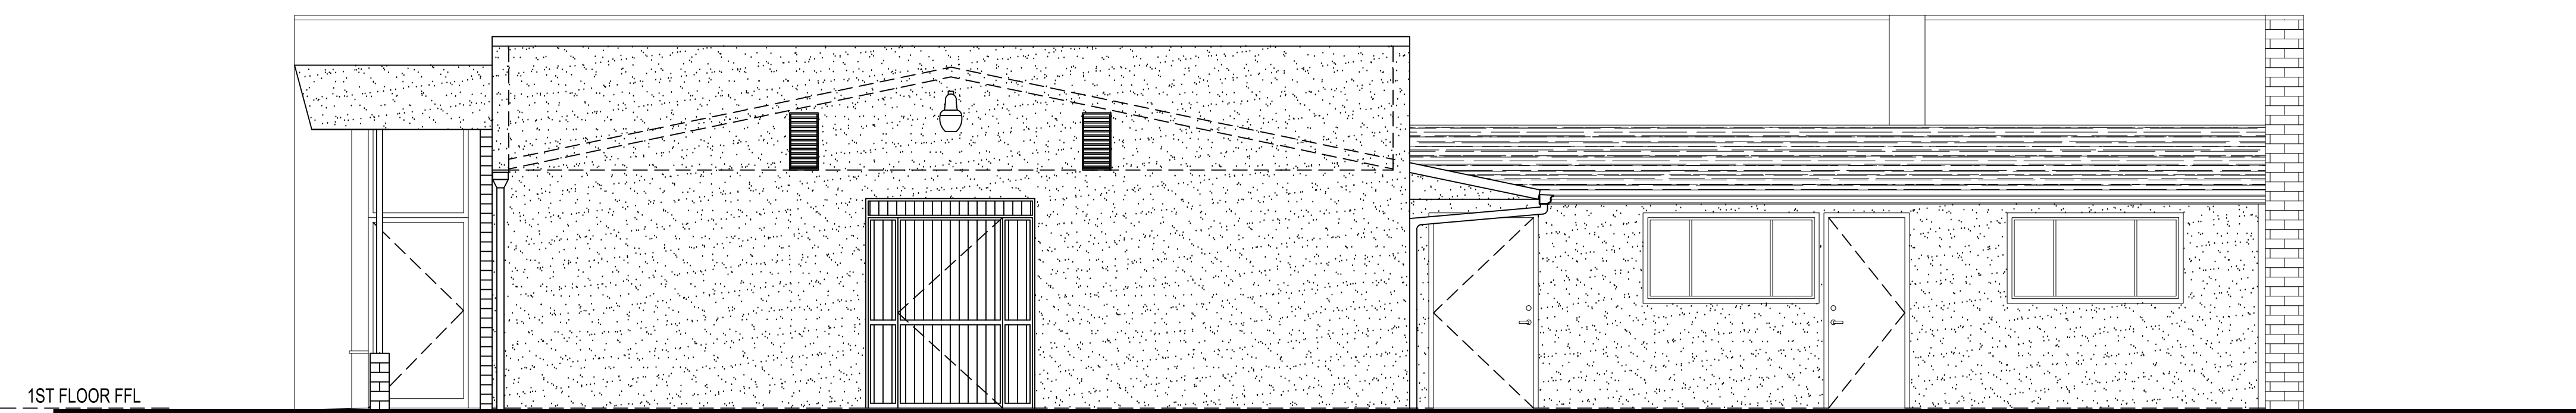

4 **W. ELEVATION**
0 2' 4' 8'
SCALE: 1/4" = 1'-0"

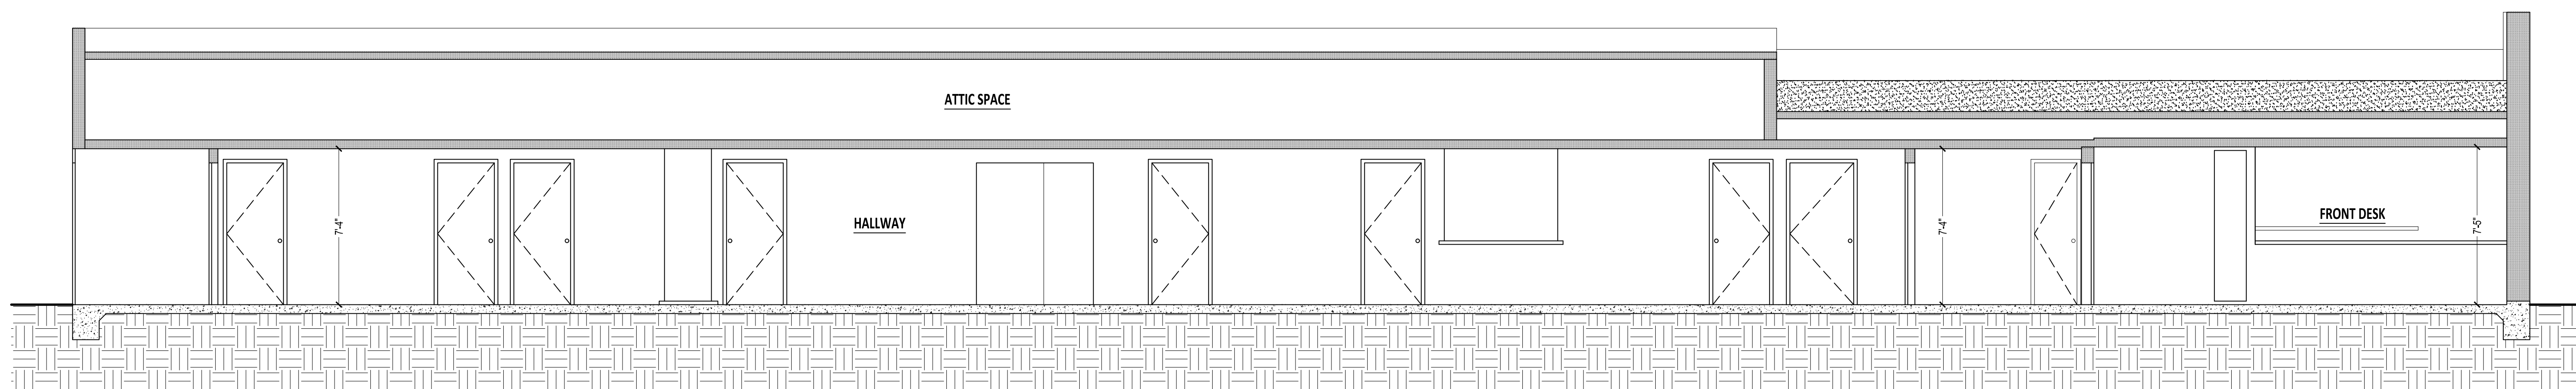

SECTION A-A
0 2' 4' 8'
SCALE: 1/4" = 1'-0"

ELEVATION
SECTION

Sheet content :

Project : 401 W BEVERLY BLVD
MONTEBELLO CA 90640

Owner:

Date

Scale


Drawn

Job

Sheet

A-4

08.08.13

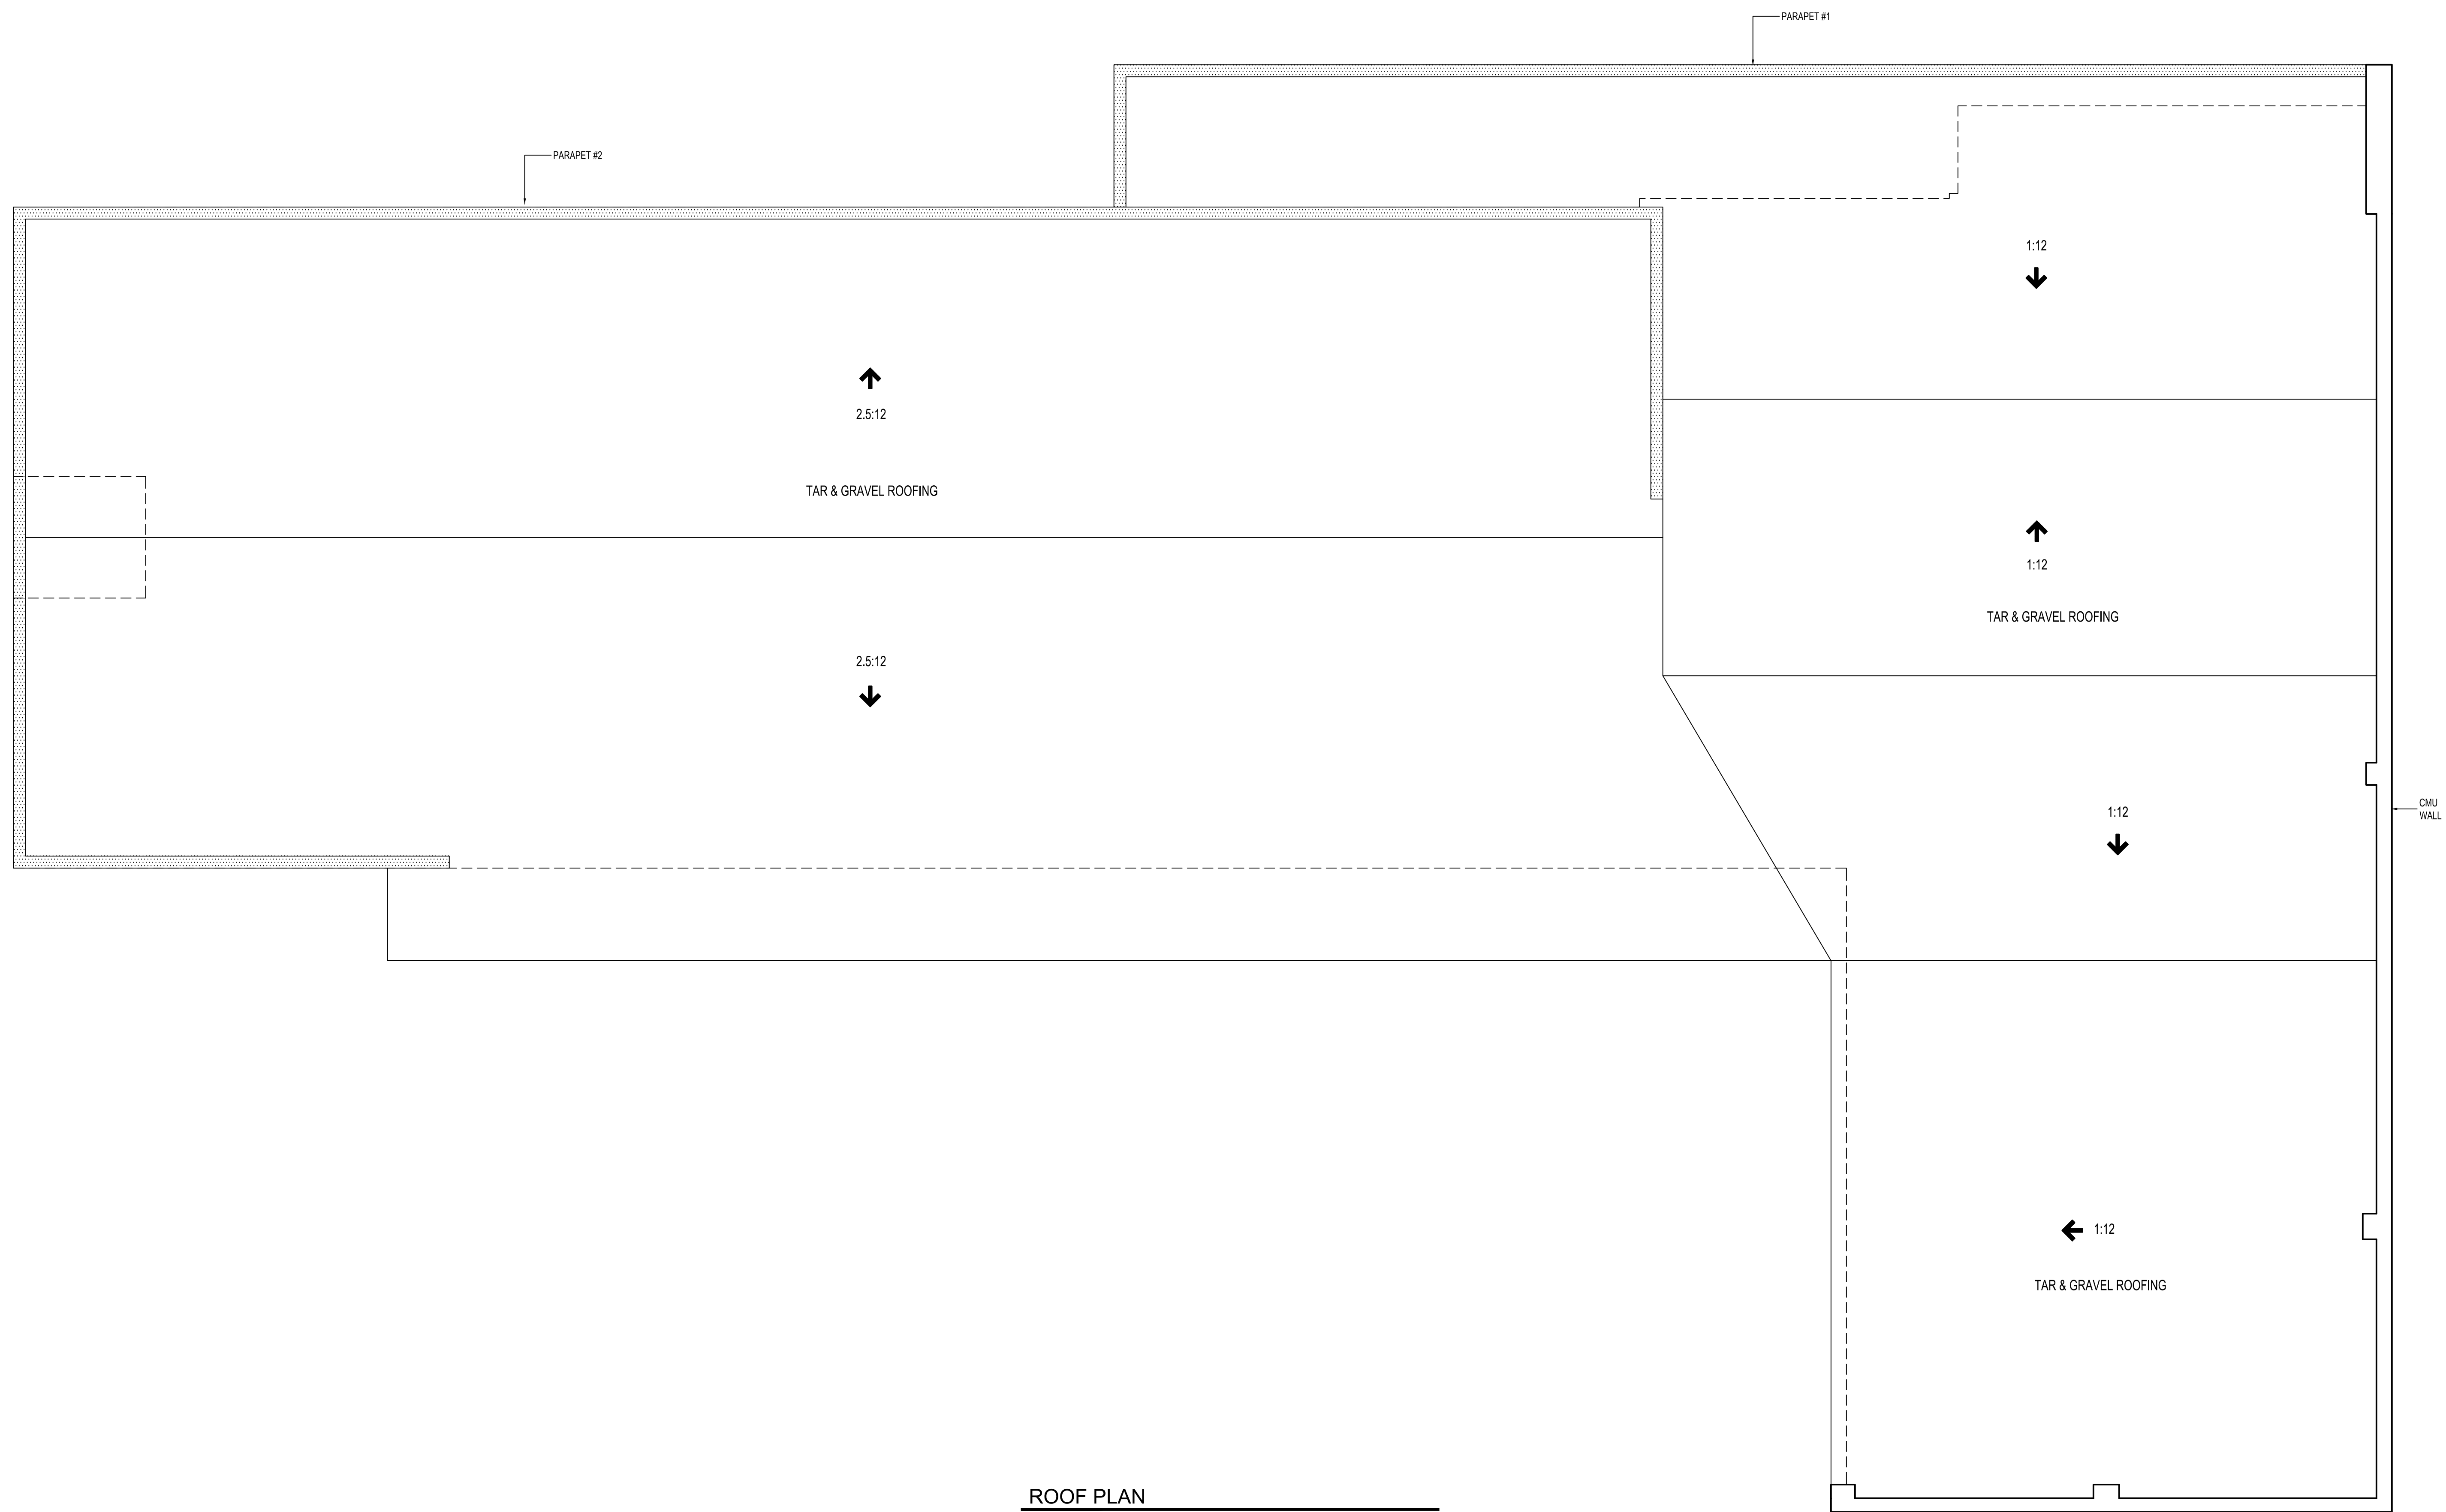

ROOF PLAN

SCALE: 1/4" = 1'-0"

REVISIONS	BY


AS-BUILT
LOS ANGELES

Sheet content :
ROOF PLAN

Project :
401 W BEVERLY BLVD
MONTEBELLO CA 90640

Owner:
Date
Scale
Drawn
Job
Sheet

A-5

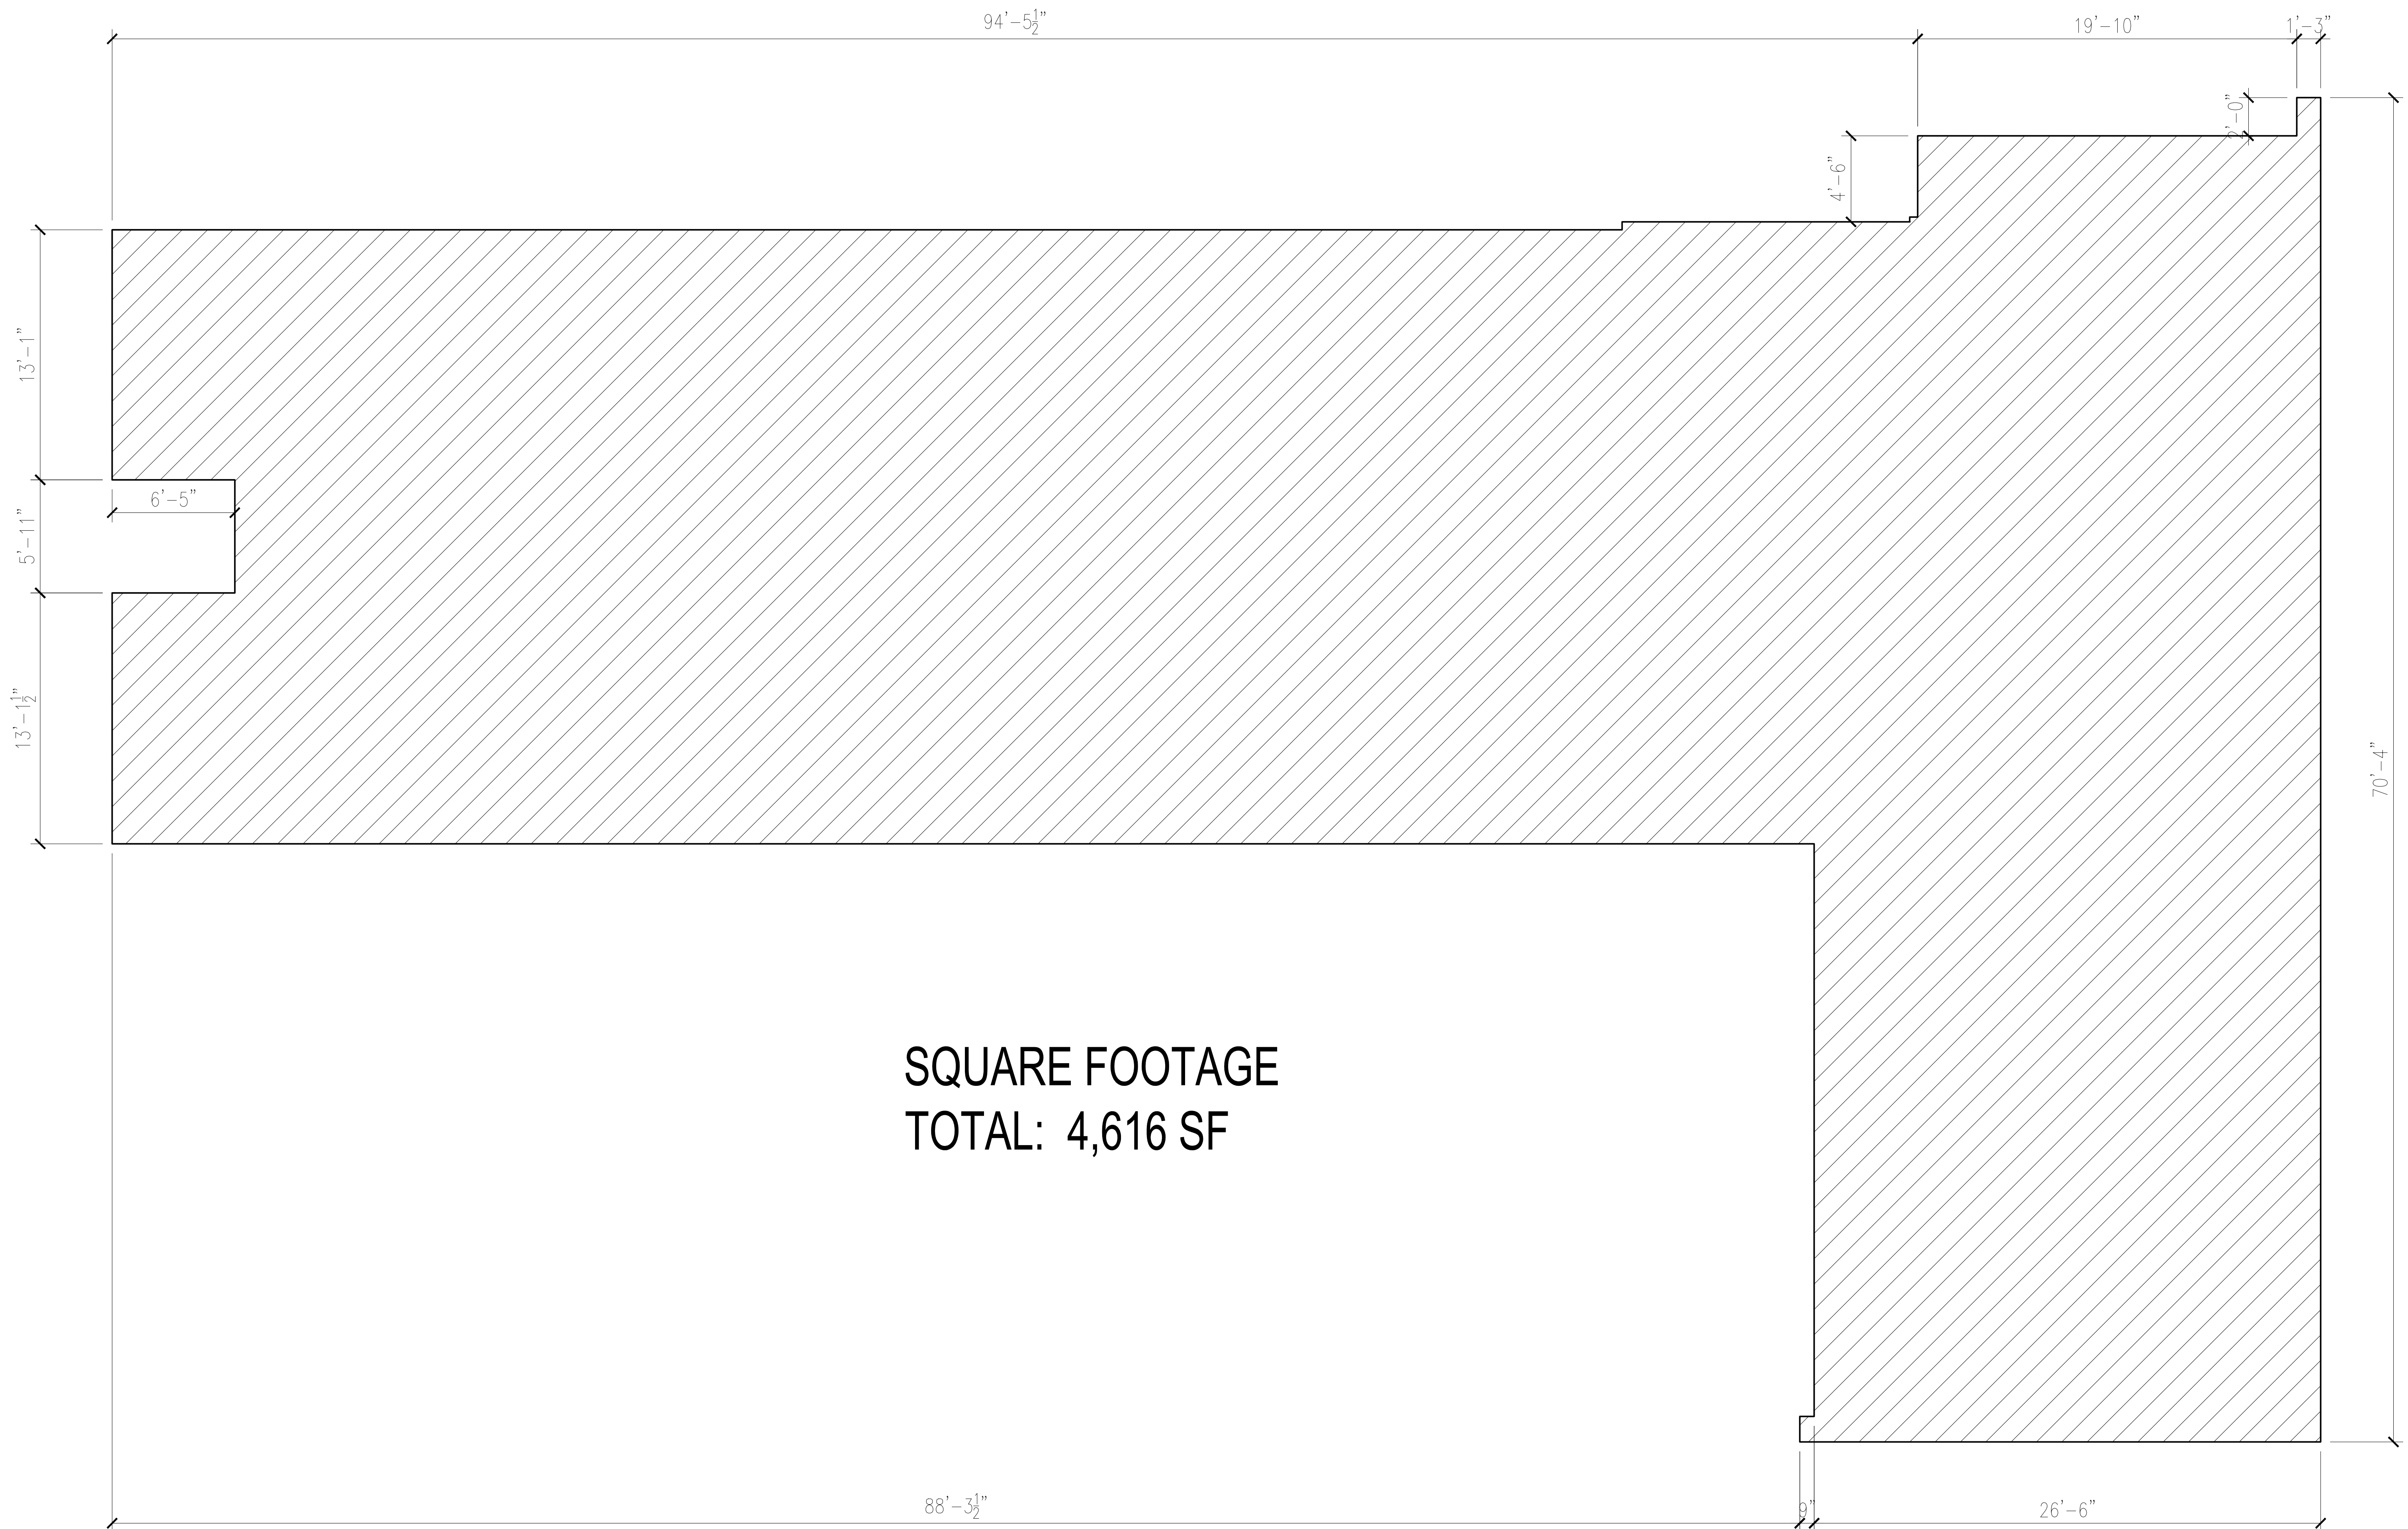

SQUARE FOOTAGE
TOTAL: 4,616 SF

REVISIONS BY

AS-BUILT
LOS ANGELES

Sheet content:
SQUARE FOOTAGE
CALCULATION

Project:
401 W BEVERLY BLVD
MONTEBELLO CA 90640

Owner:

Date

Scale

Drawn

Job

Sheet

A-6