

REVISIONS	BY

**AS-BUILT**  
LOS ANGELES

PLOT PLAN

Sheet content :

Project : 830 GREENRIDGE DR  
LA CANADA FLT CA 91011

Owner:

Date

Scale


Drawn

Job

Sheet

**A-1**

08.26.13

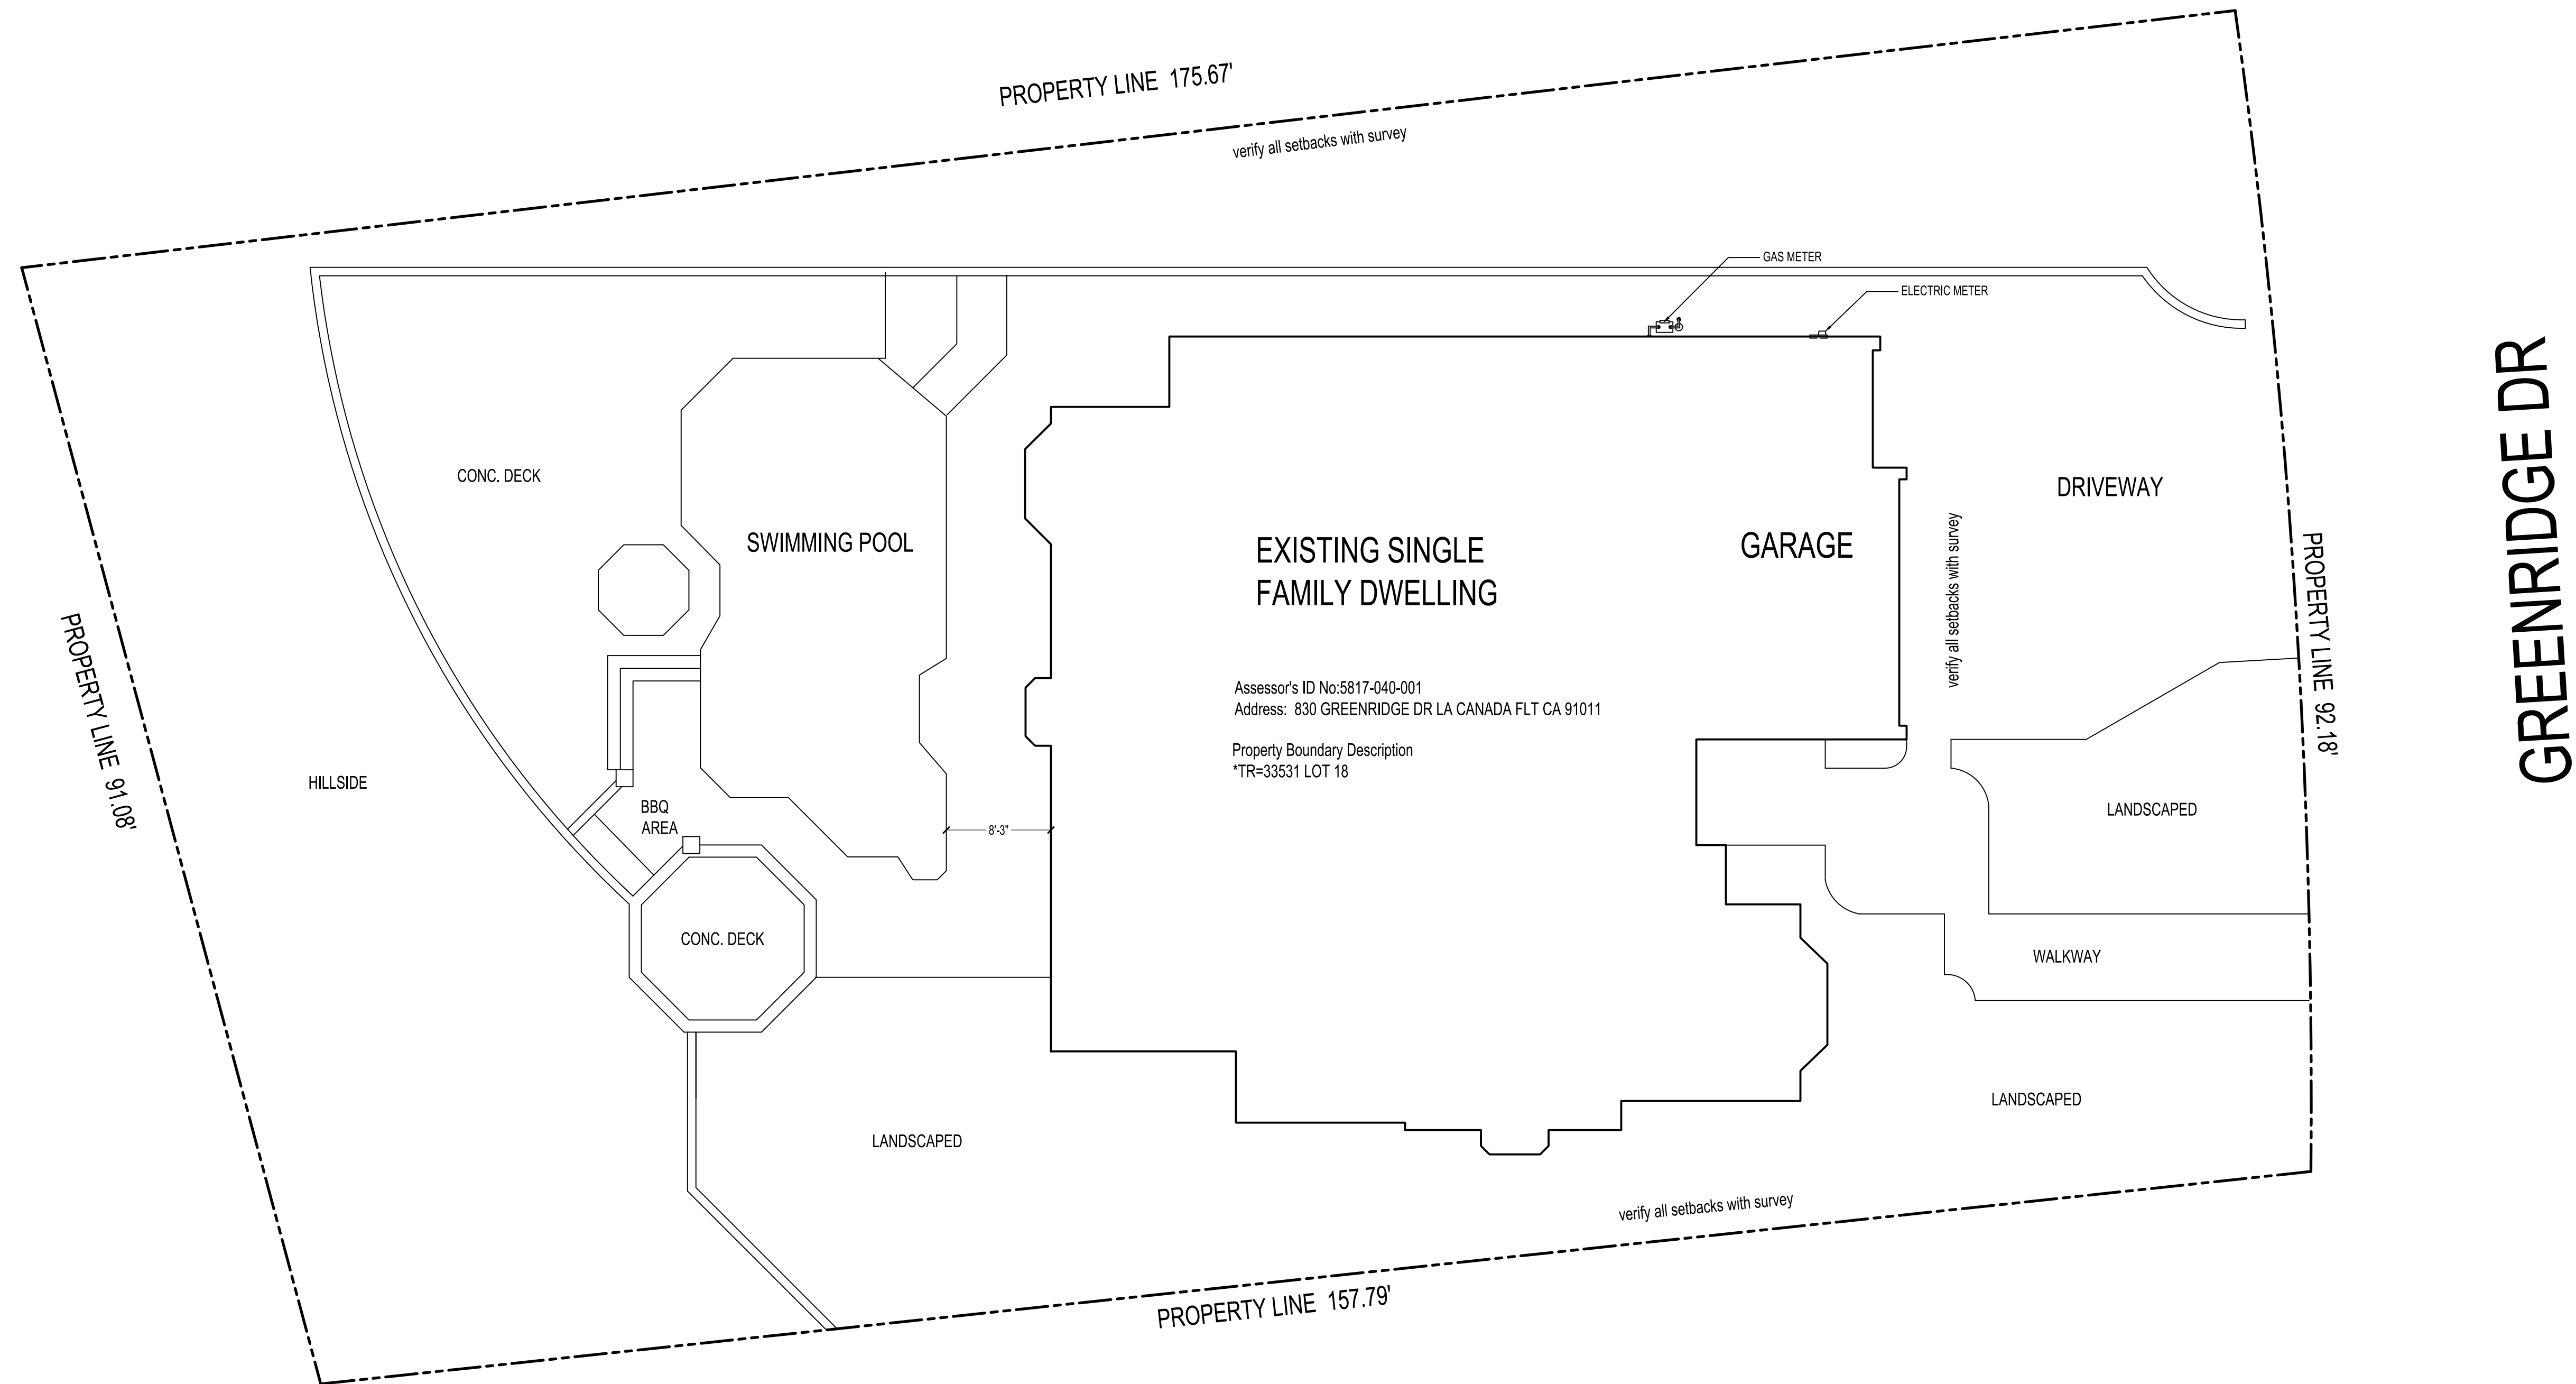


**PLOT PLAN**

0 4' 8' 16'



SCALE: 1/8" = 1'-0"

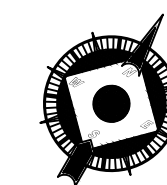



FLOOR PLAN

Sheet content:

Project: 830 GREENRIDGE DR  
LA CANADA FLT CA 91011

Owner:

Date

Scale

Drawn

Job

Sheet


A-2

### DOOR SCHEDULE





MARK	DOOR SIZE		Type	NOTES
	WD	HGT		
1	2'-8"	6'-8"	SWING	---
2	9'-0"	6'-8"	GARAGE DOOR	---
3	9'-0"	6'-8"	GARAGE DOOR	---
4	3'-6"	7'-0"	FRENCH	---
5	2'-8"	6'-8"	SWING	---
6	2'-8"	6'-8"	SWING	---
7	2'-8"	6'-8"	SWING	---
8	2'-8"	6'-8"	SWING	---
9	2'-8"	6'-8"	SWING	---
10	5'-10"	6'-8"	SLIDING DOUBLE	---
11	2'-8"	6'-8"	SWING	---
12	2'-8"	6'-8"	SWING	---
13	2'-8"	6'-8"	SWING	---
14	2'-8"	6'-8"	SWING	---
15	2'-0"	6'-8"	SWING	---
16	2'-8"	6'-8"	SWING	---
17	2'-8"	6'-8"	SWING	---
18	4'-0"	6'-8"	FRENCH DOUBLE	---
19	5'-0"	6'-8"	FRENCH DOUBLE	---
20	6'-0"	6'-8"	SLIDING DOUBLE	---
21	3'-0"	6'-8"	FRENCH DOUBLE	---
22	4'-11"	6'-8"	SLIDING DOUBLE	---
23	5'-0"	6'-8"	FRENCH DOUBLE	---
24	2'-8"	6'-8"	SWING	---
25	2'-8"	6'-8"	SWING	---
26	5'-4"	6'-8"	SWING DOUBLE	---
27	2'-8"	6'-8"	SWING	---
28	2'-8"	6'-8"	SWING	---
29	2'-8"	6'-8"	SWING	---
30	2'-8"	6'-8"	SWING	---
31	2'-8"	6'-8"	SWING	---
32	2'-8"	6'-8"	SWING	---

### WINDOW SCHEDULE

MARK	SIZE		TYPE	Head Height	NOTES
	Width	HEIGHT			
1	2'-8"	3'-7"	SINGLE HUNG	6'-8"	---
2	2'-8"	3'-7"	SINGLE HUNG	6'-8"	---
3	5'-0"	3'-8"	SLIDING	6'-8"	---
4	1'-4"	7'-0"	FIXED	7'-0"	---
5	1'-4"	7'-0"	FIXED	7'-0"	---
6	1'-8"	4'-6"	FIXED	6'-8"	---
7	1'-8"	4'-6"	SINGLE HUNG	6'-8"	---
8	5'-0"	4'-6"	FIXED	6'-8"	---
9	1'-8"	4'-6"	SINGLE HUNG	6'-8"	---
10	1'-8"	3'-10"	SINGLE HUNG	6'-8"	---
11	4'-4"	3'-10"	FIXED	6'-8"	---
12	1'-8"	3'-10"	SINGLE HUNG	6'-8"	---
13	1'-11"	4'-6"	SINGLE HUNG	6'-8"	---
14	1'-11"	4'-6"	SINGLE HUNG	6'-8"	---
15	1'-11"	4'-6"	SINGLE HUNG	6'-8"	---
16	1'-11"	4'-6"	SINGLE HUNG	6'-8"	---
17	5'-9"	5'-0"	FIXED	7'-4"	---
18	5'-10"	5'-0"	FIXED	7'-4"	---
19	4'-1"	5'-0"	FIXED	7'-7"	---
20	4'-6"	5'-0"	FIXED	7'-7"	---
21	4'-6"	5'-0"	FIXED	7'-7"	---
22	4'-6"	5'-0"	FIXED	7'-8"	---
23	3'-0"	5'-0"	FIXED	7'-8"	---
24	2'-3"	4'-6"	SINGLE HUNG	6'-8"	---
25	2'-3"	4'-6"	SINGLE HUNG	6'-8"	---
26	2'-3"	4'-6"	SINGLE HUNG	6'-8"	---
27	2'-3"	4'-6"	SINGLE HUNG	6'-8"	---
28	1'-8"	4'-6"	SINGLE HUNG	6'-8"	---
29	1'-8"	4'-6"	SINGLE HUNG	6'-8"	---
30	2'-7"	4'-6"	SINGLE HUNG	6'-8"	---
31	2'-7"	4'-6"	SINGLE HUNG	6'-8"	---
32	2'-0"	3'-0"	SINGLE HUNG	6'-8"	---
33	5'-8"	4'-3"	SLIDING	6'-8"	---
34	3'-9"	1'-9"	SLIDING	6'-8"	---
35	3'-9"	1'-9"	SLIDING	6'-8"	---
36	1'-7"	3'-10"	SINGLE HUNG	6'-8"	---
37	4'-4"	3'-10"	FIXED	6'-8"	---
38	1'-7"	3'-10"	SINGLE HUNG	6'-8"	---
39	5'-0"	8'-0"	FIXED	6'-8"	---
40	2'-8"	4'-6"	SINGLE HUNG	6'-8"	---
41	2'-4"	4'-6"	SINGLE HUNG	6'-8"	---
42	2'-4"	4'-6"	SINGLE HUNG	6'-8"	---
43	2'-4"	4'-6"	SINGLE HUNG	6'-8"	---
44	2'-4"	4'-6"	SINGLE HUNG	6'-8"	---
45	1'-7"	3'-9"	SINGLE HUNG	6'-8"	---
46	4'-4"	3'-9"	FIXED	6'-8"	---
47	1'-7"	3'-9"	SINGLE HUNG	6'-8"	---
48	2'-0"	4'-5"	SINGLE HUNG	6'-8"	---

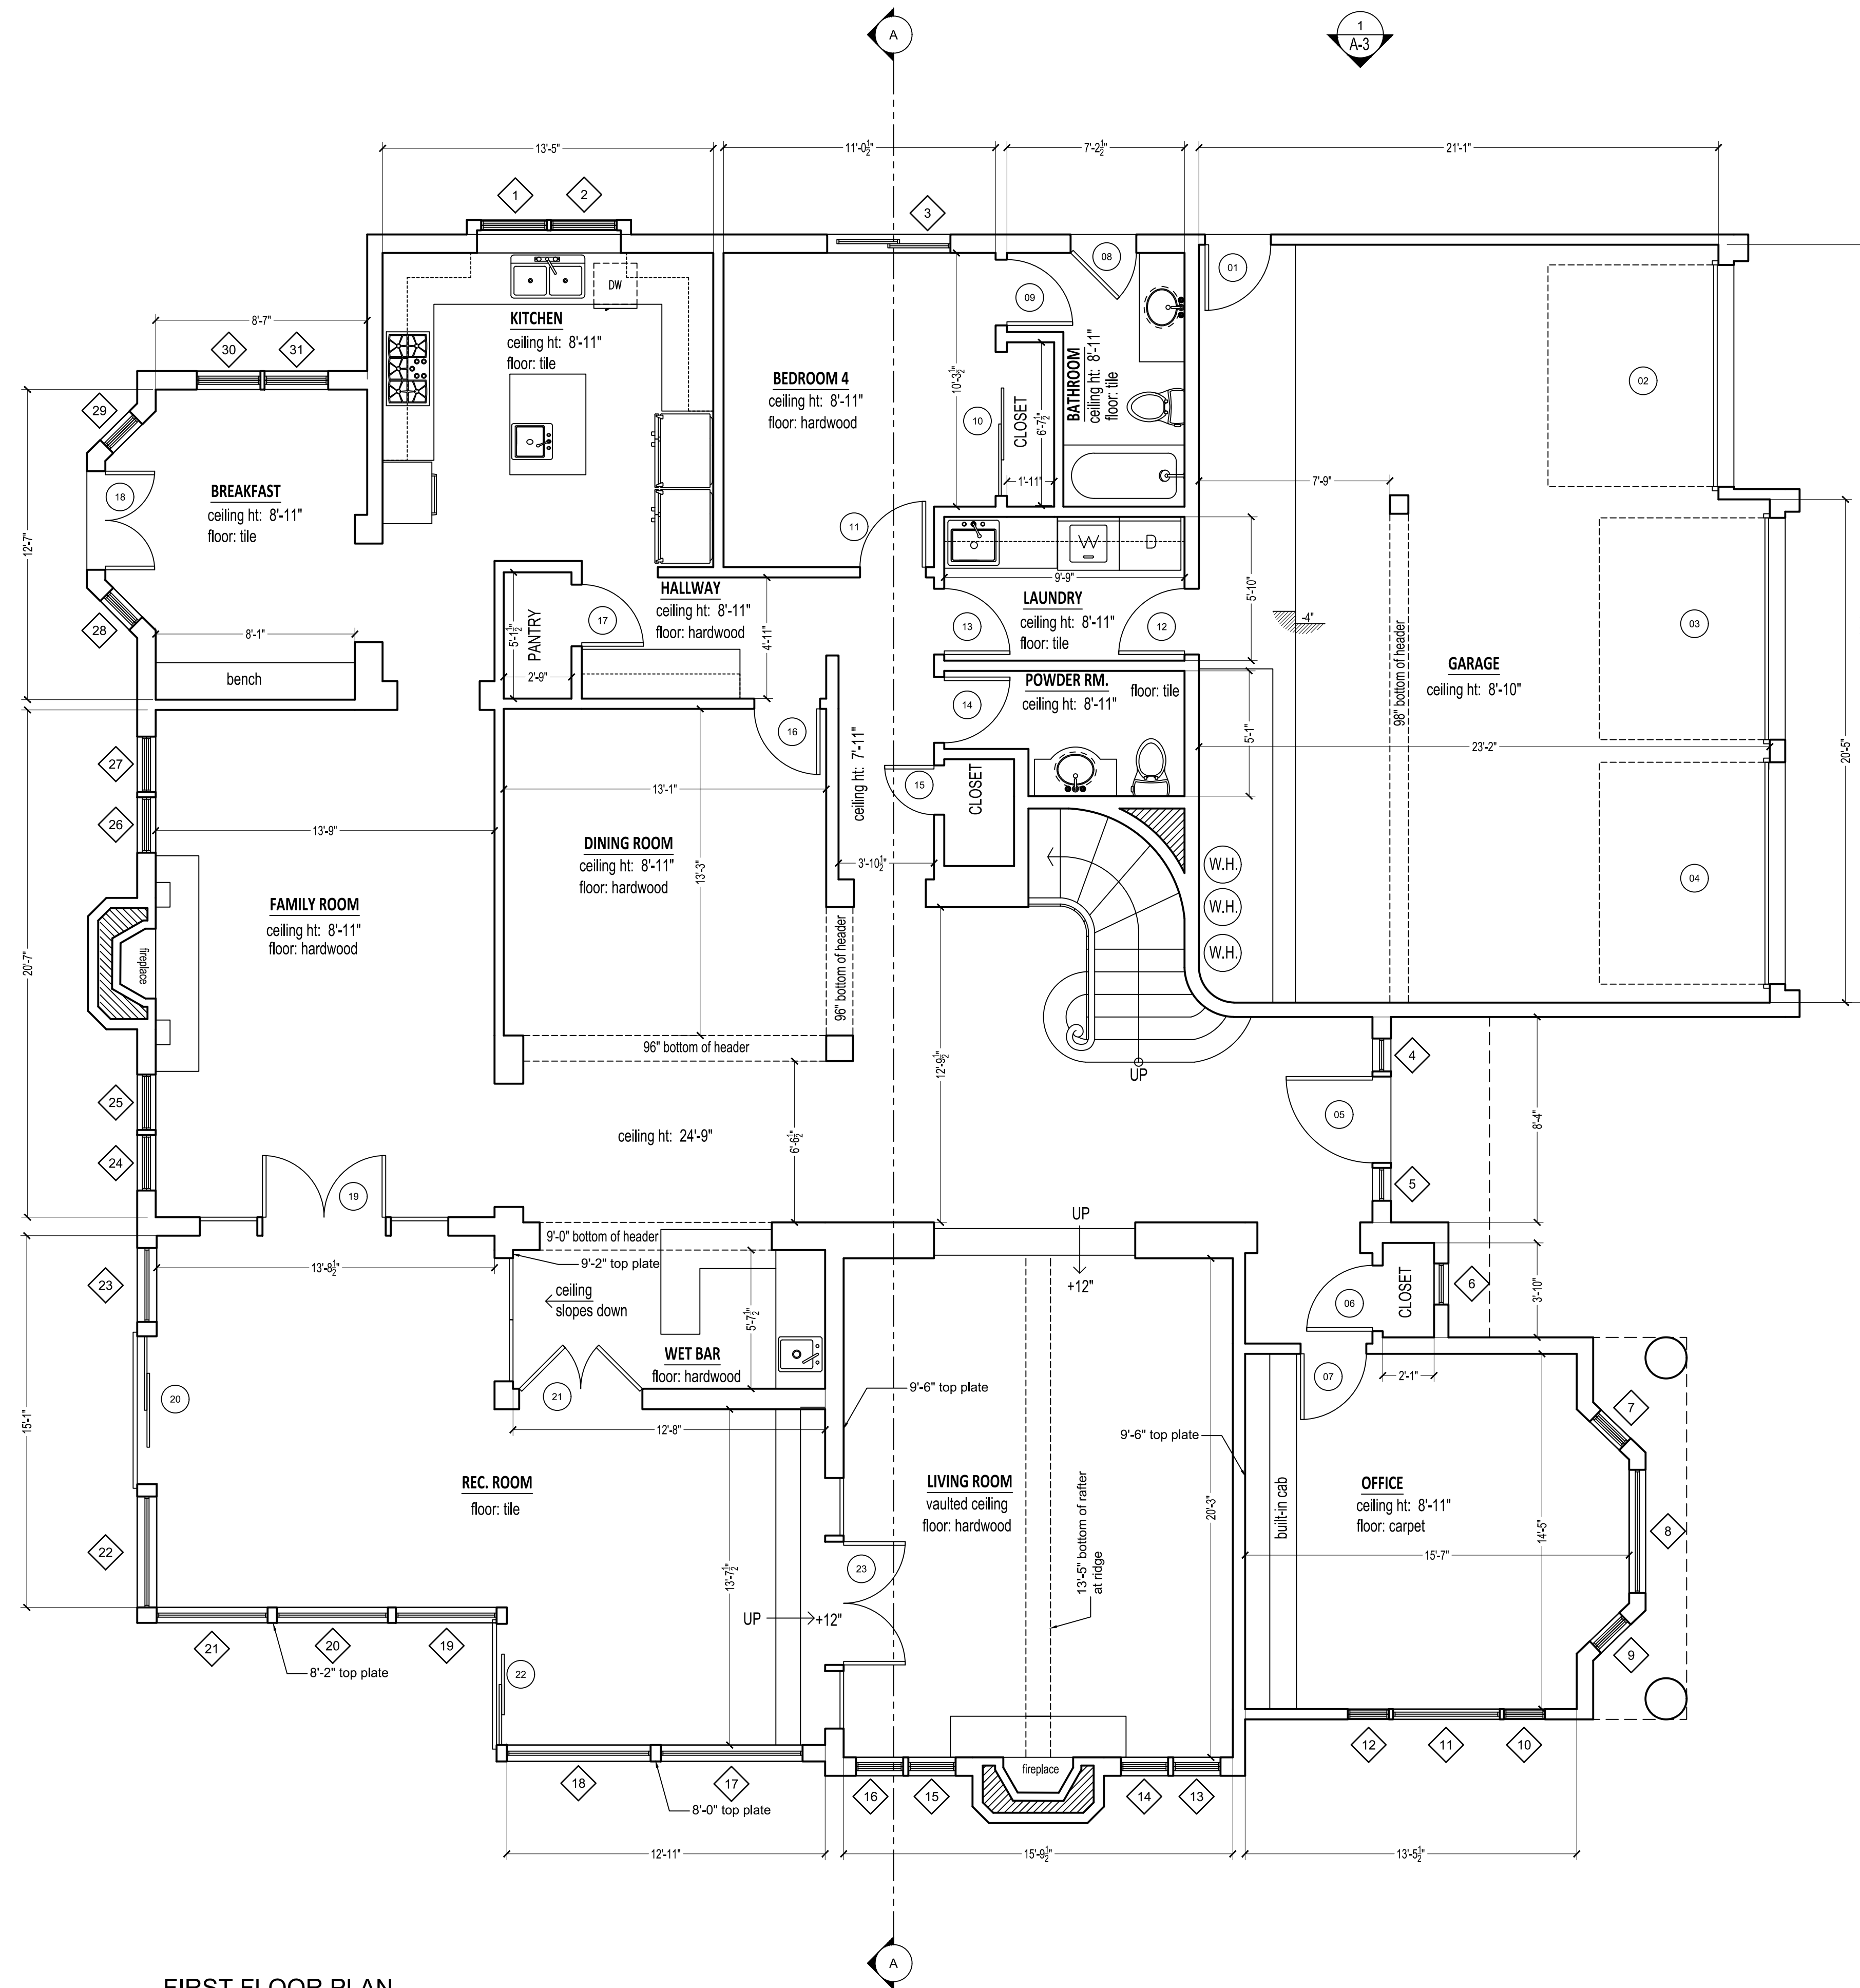

FIRST FLOOR PLAN

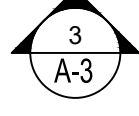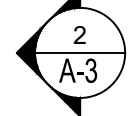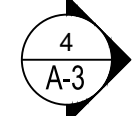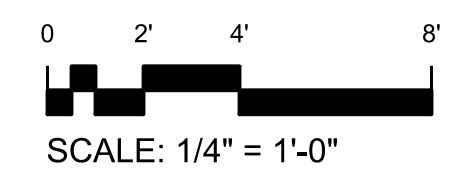

REVISIONS	BY


**AS-BUILT**  
LOS ANGELES

Sheet content :  
**SECOND FLOOR PLAN**


Project :  
830 GREENRIDGE DR  
LA CANADA FLT CA 91011


Owner:  
Date  
Scale  
Drawn  
Job  
Sheet

**A-3**

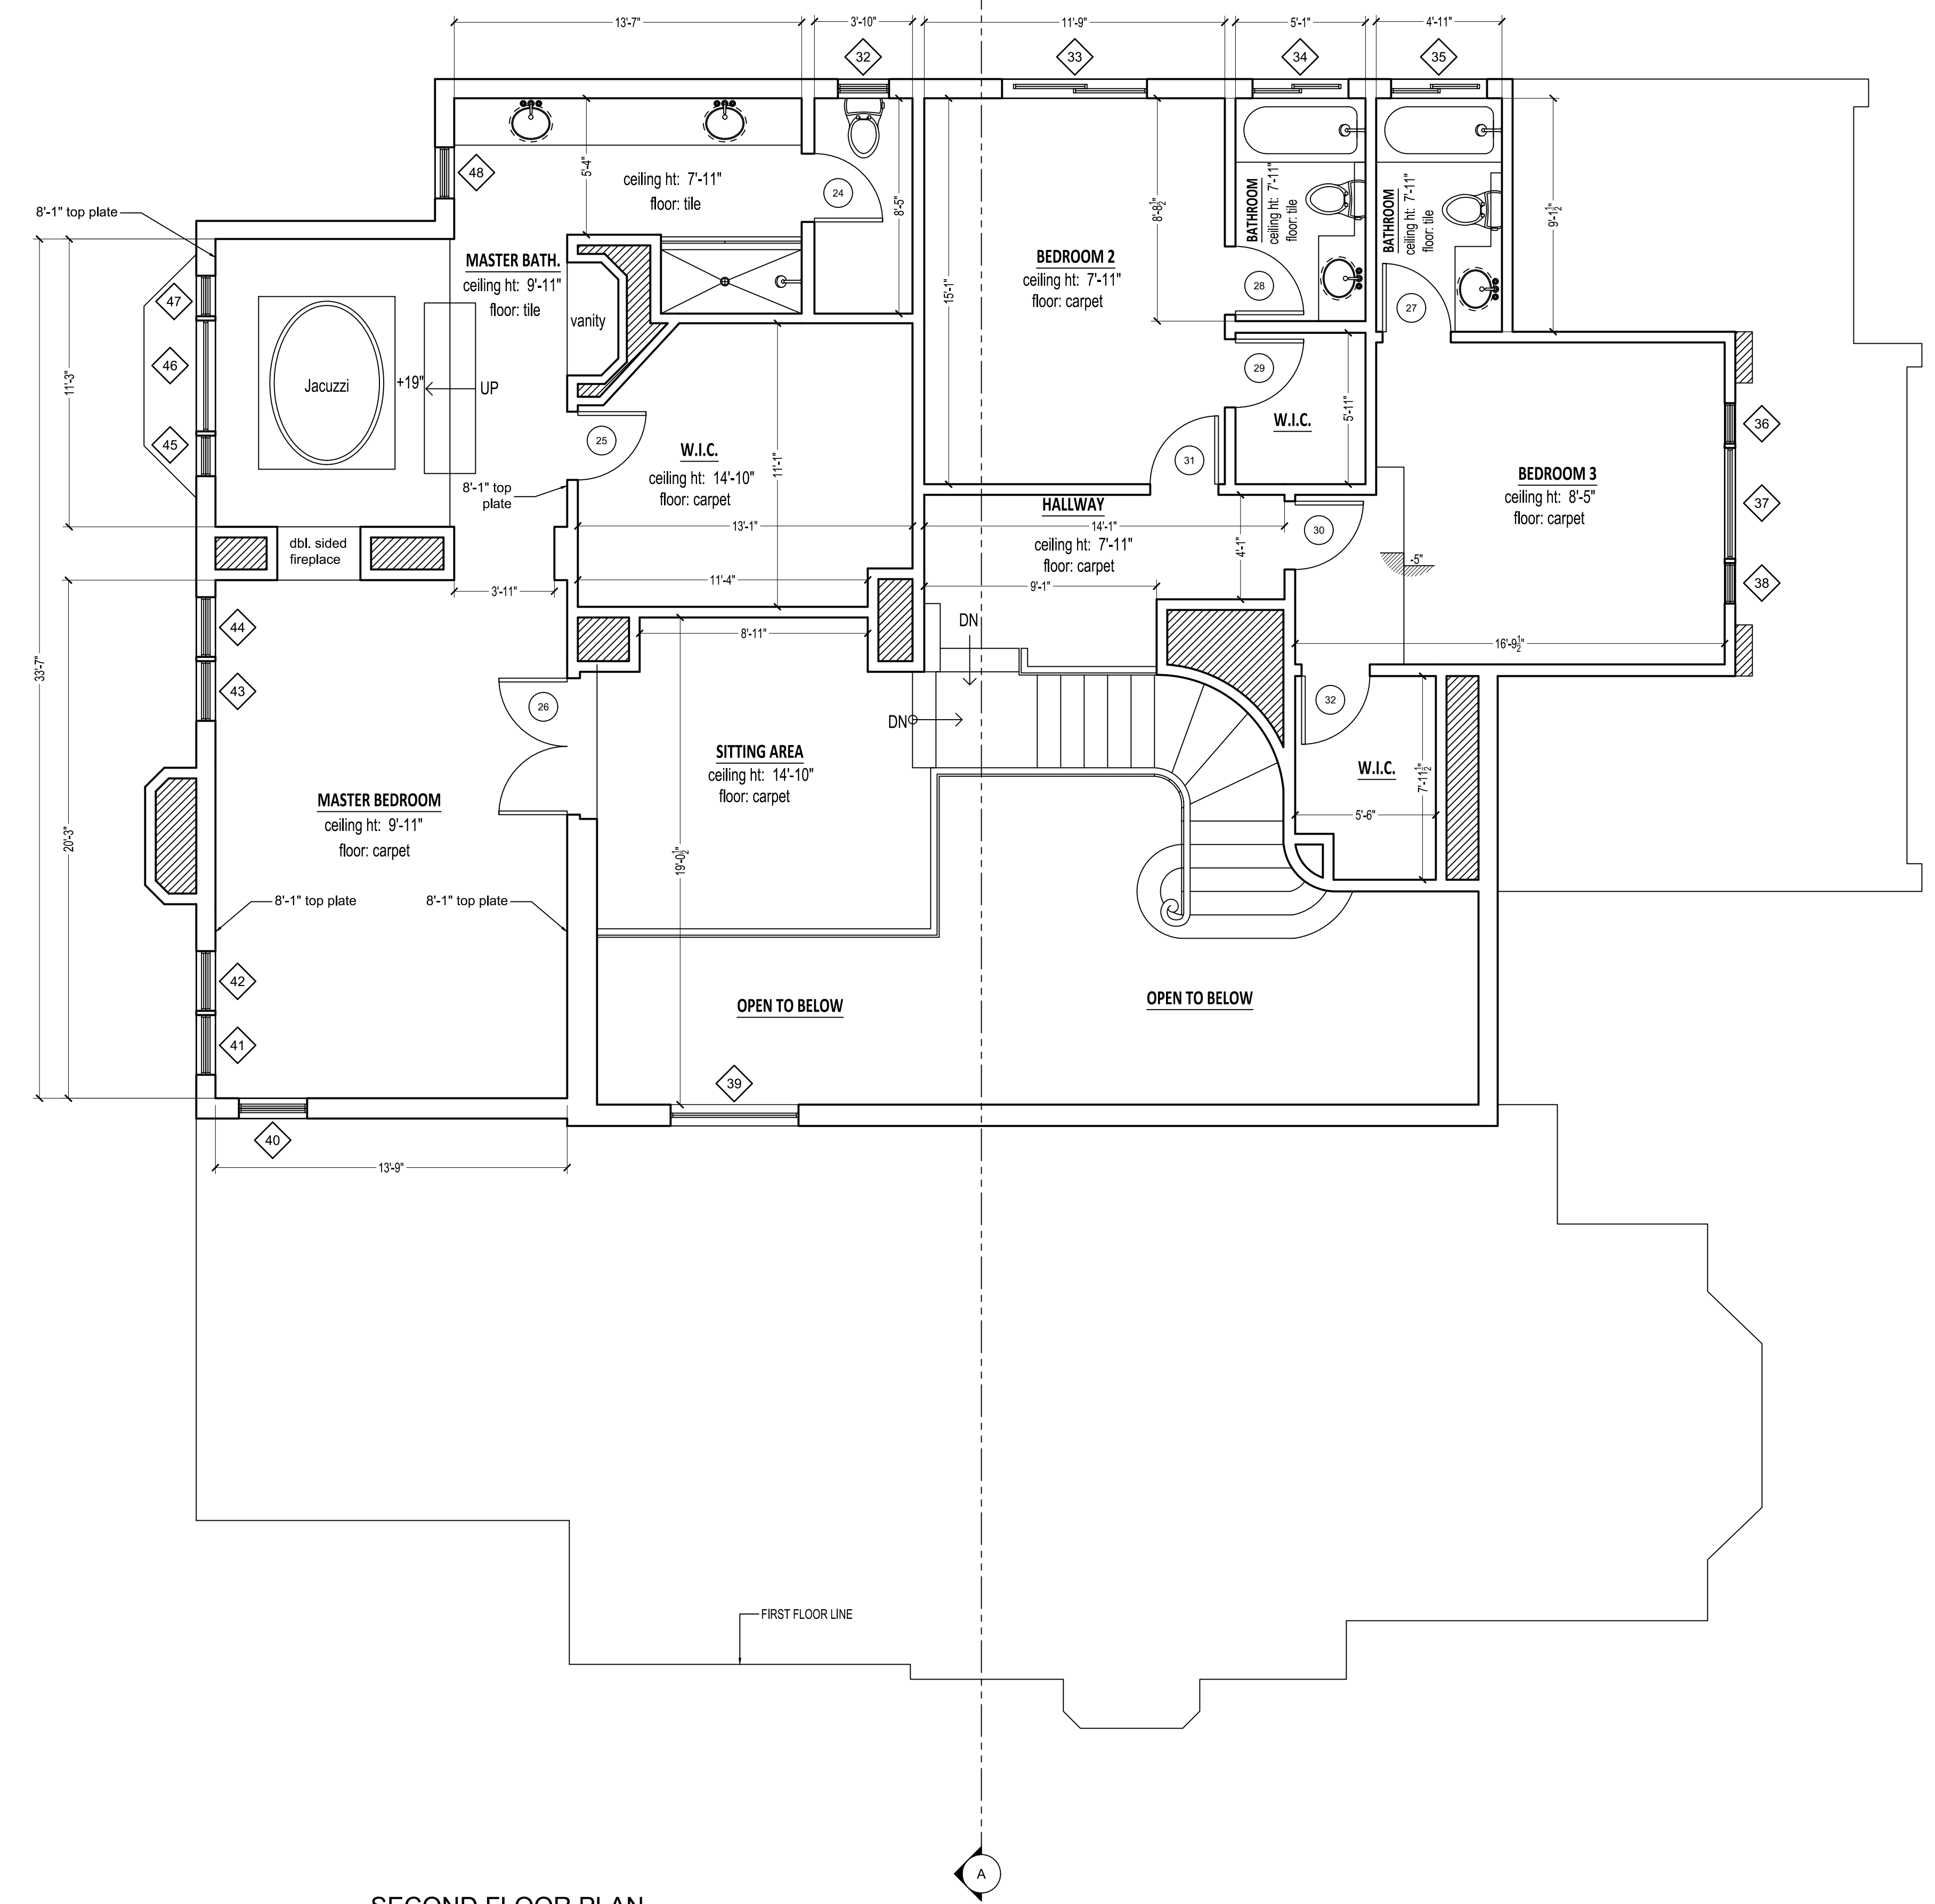


**SECOND FLOOR PLAN**

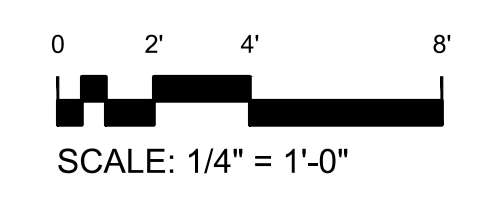


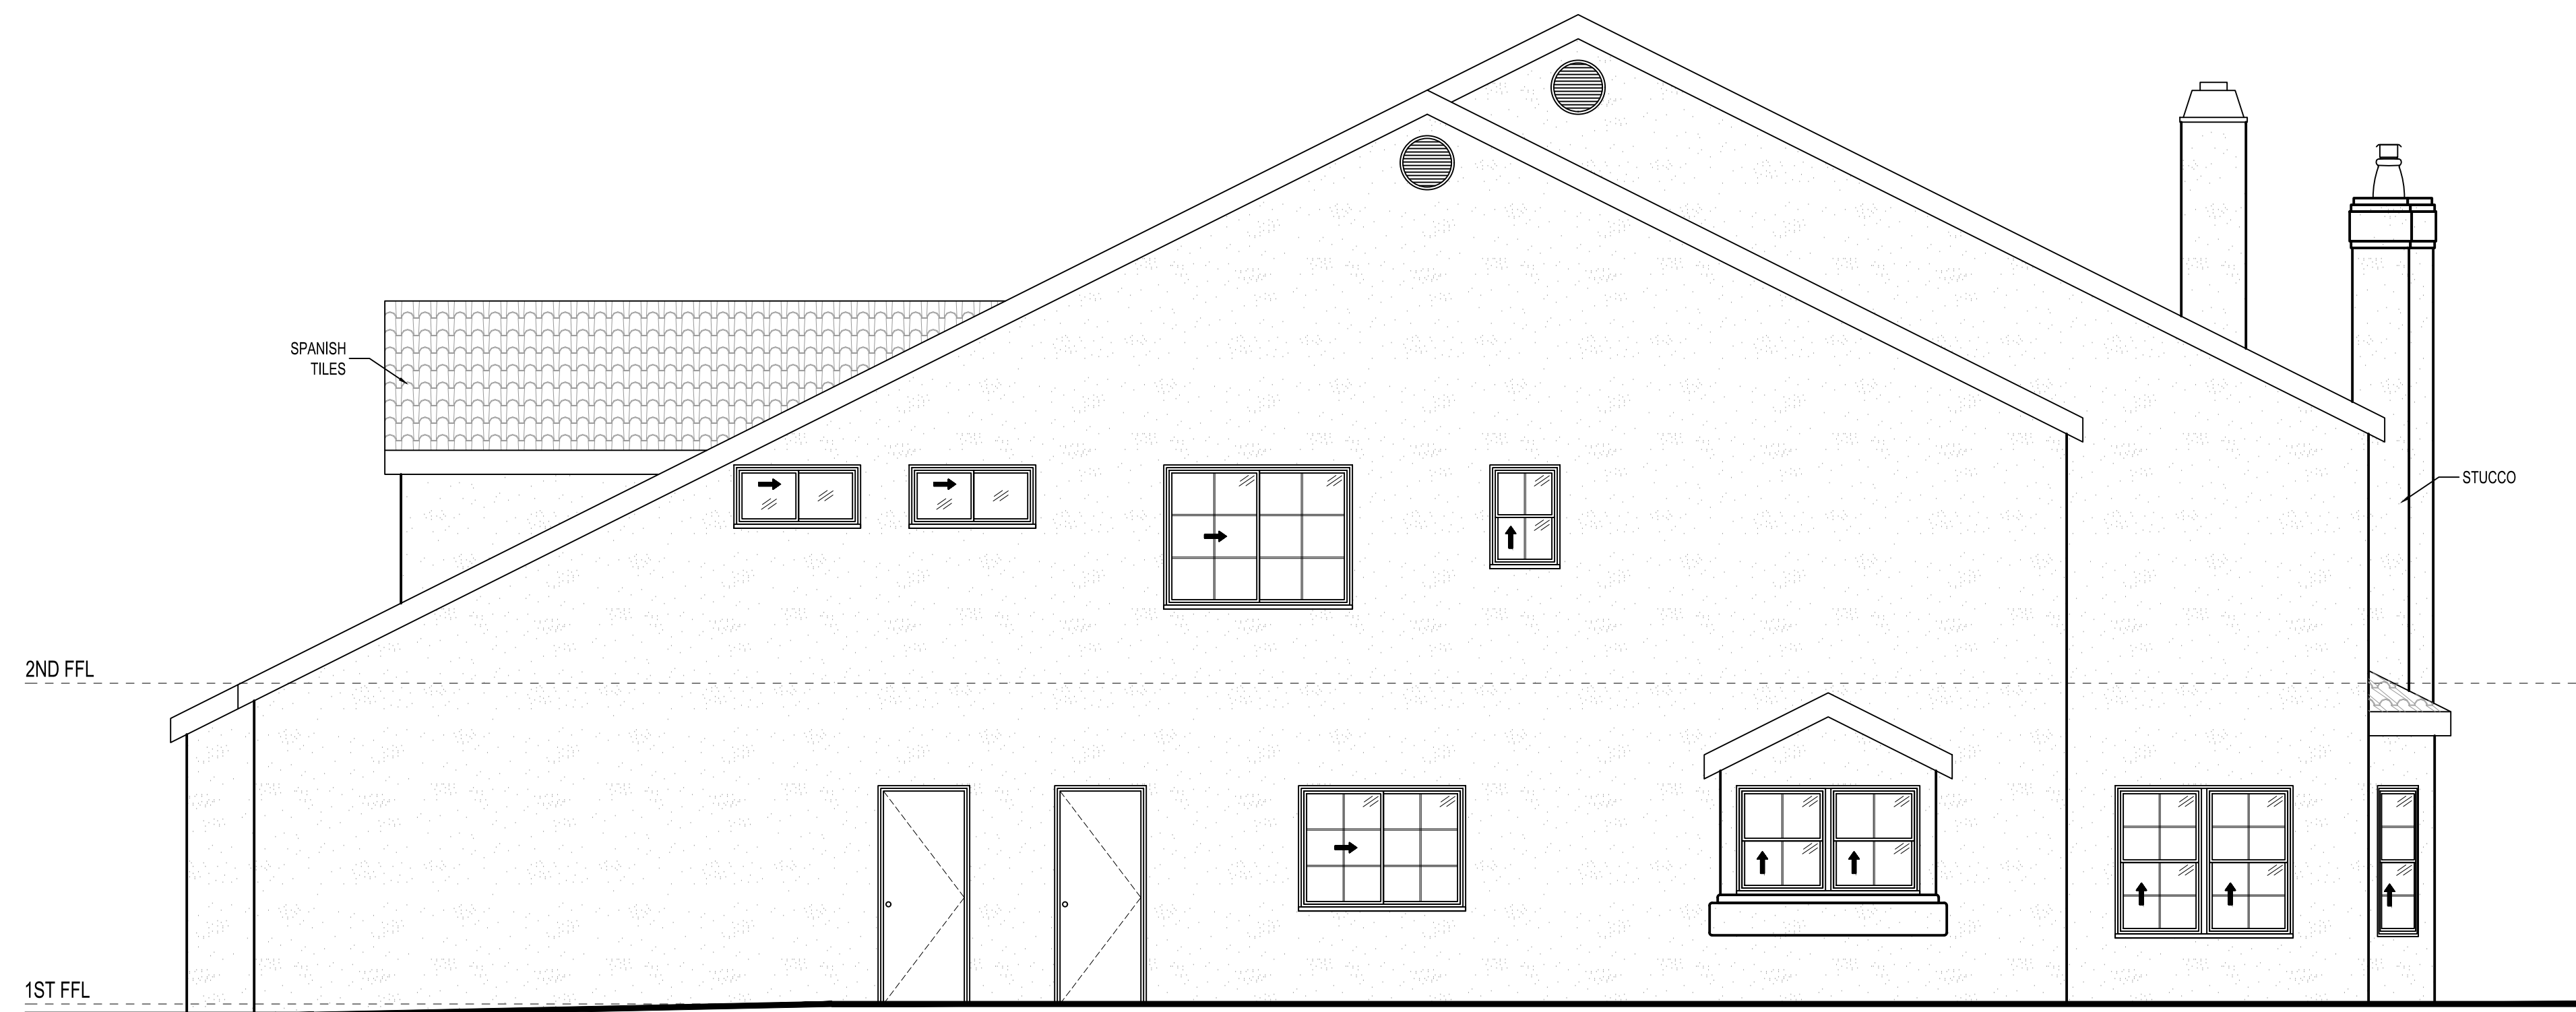


1 N. W. ELEVATION

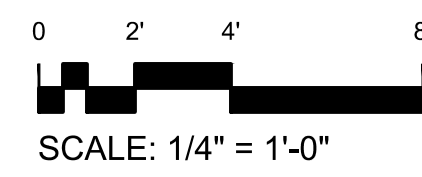


2 N. E. ELEVATION

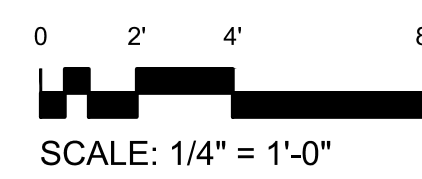



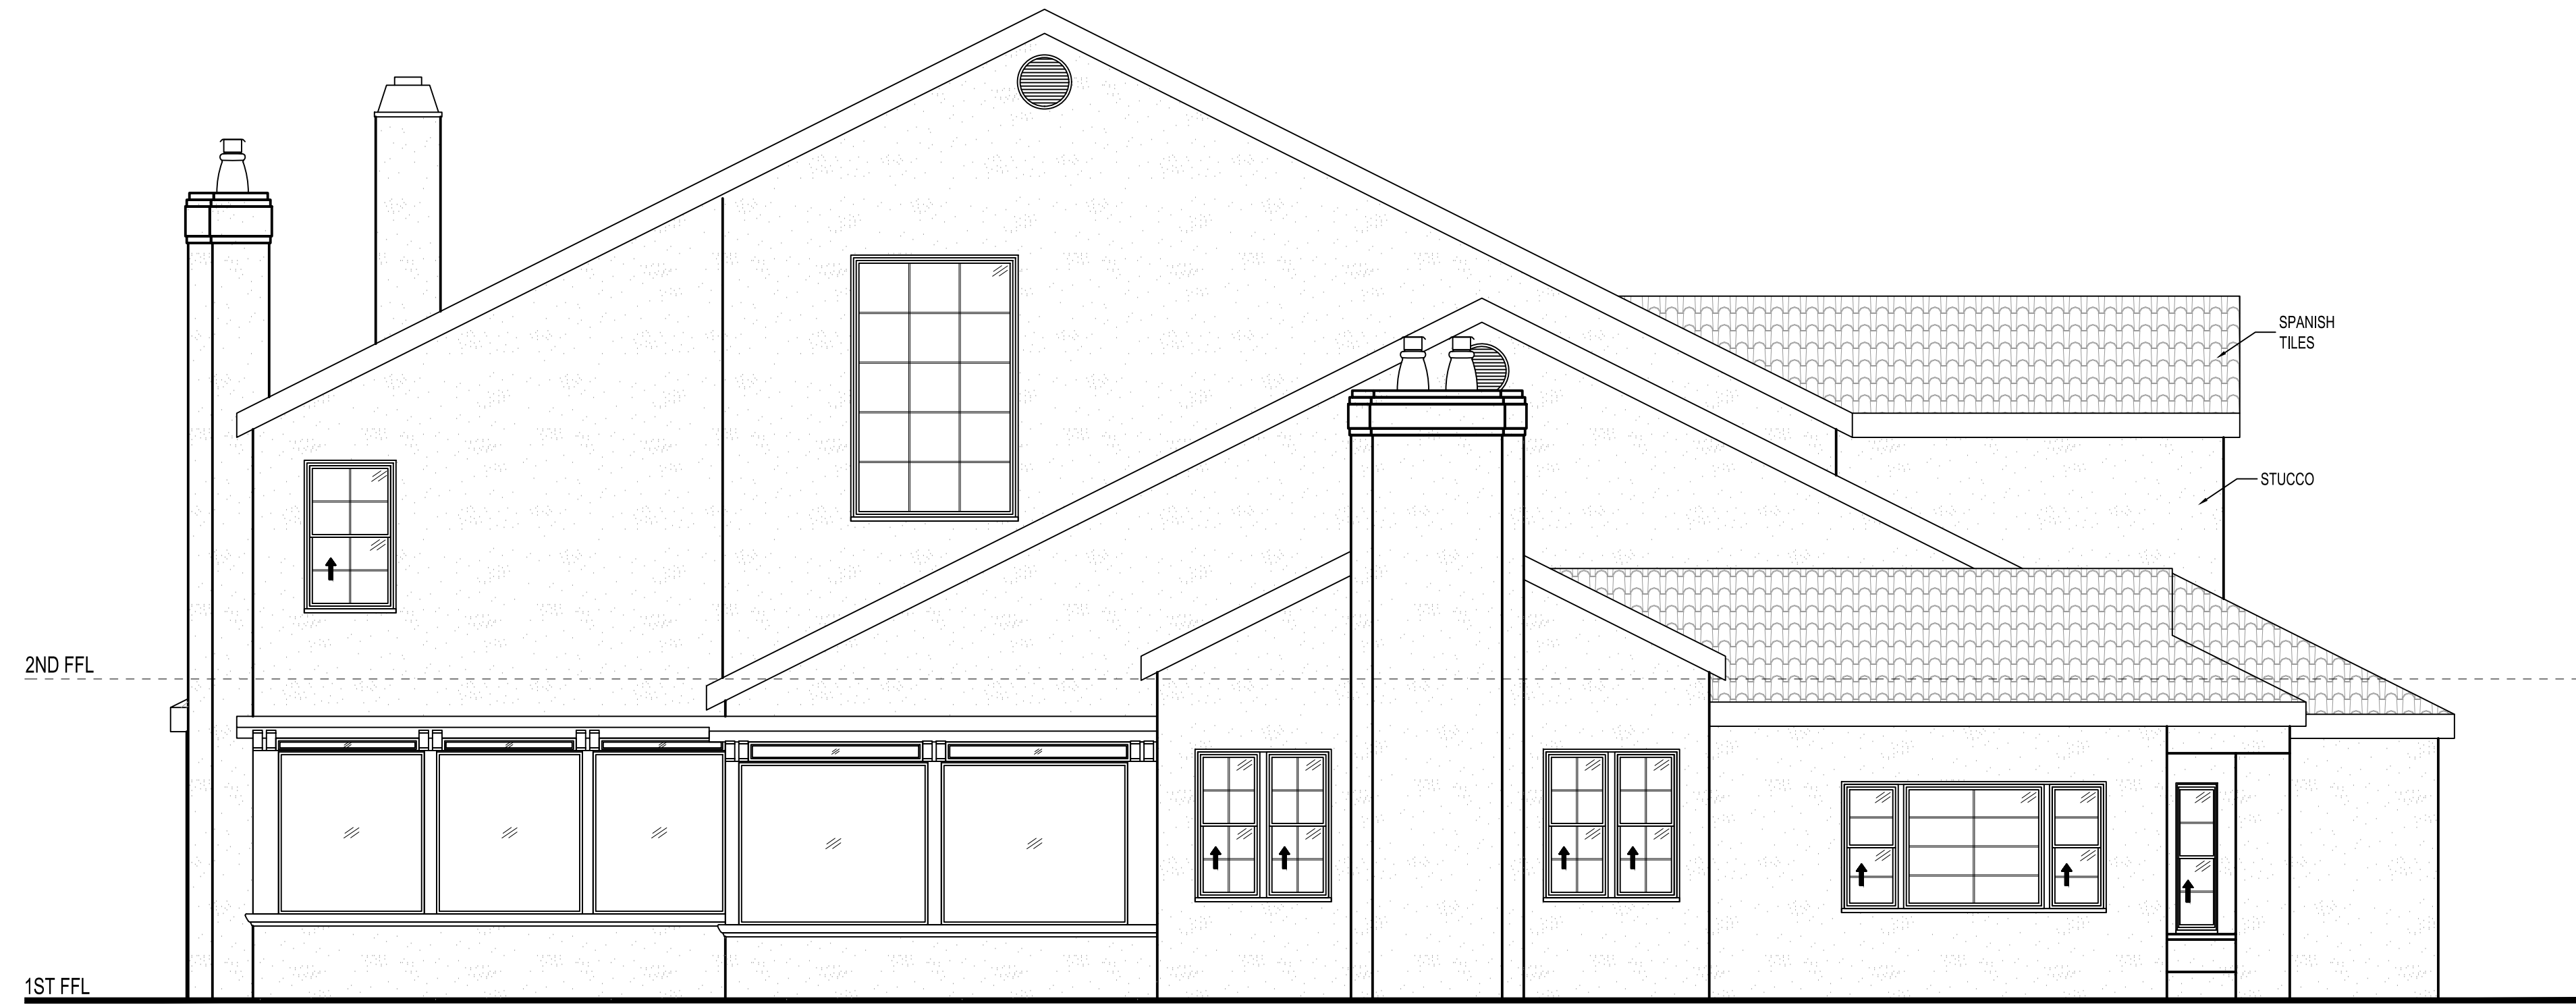


3 S. E. ELEVATION  
 0 2' 4' 8'  
 SCALE: 1/4" = 1'-0"

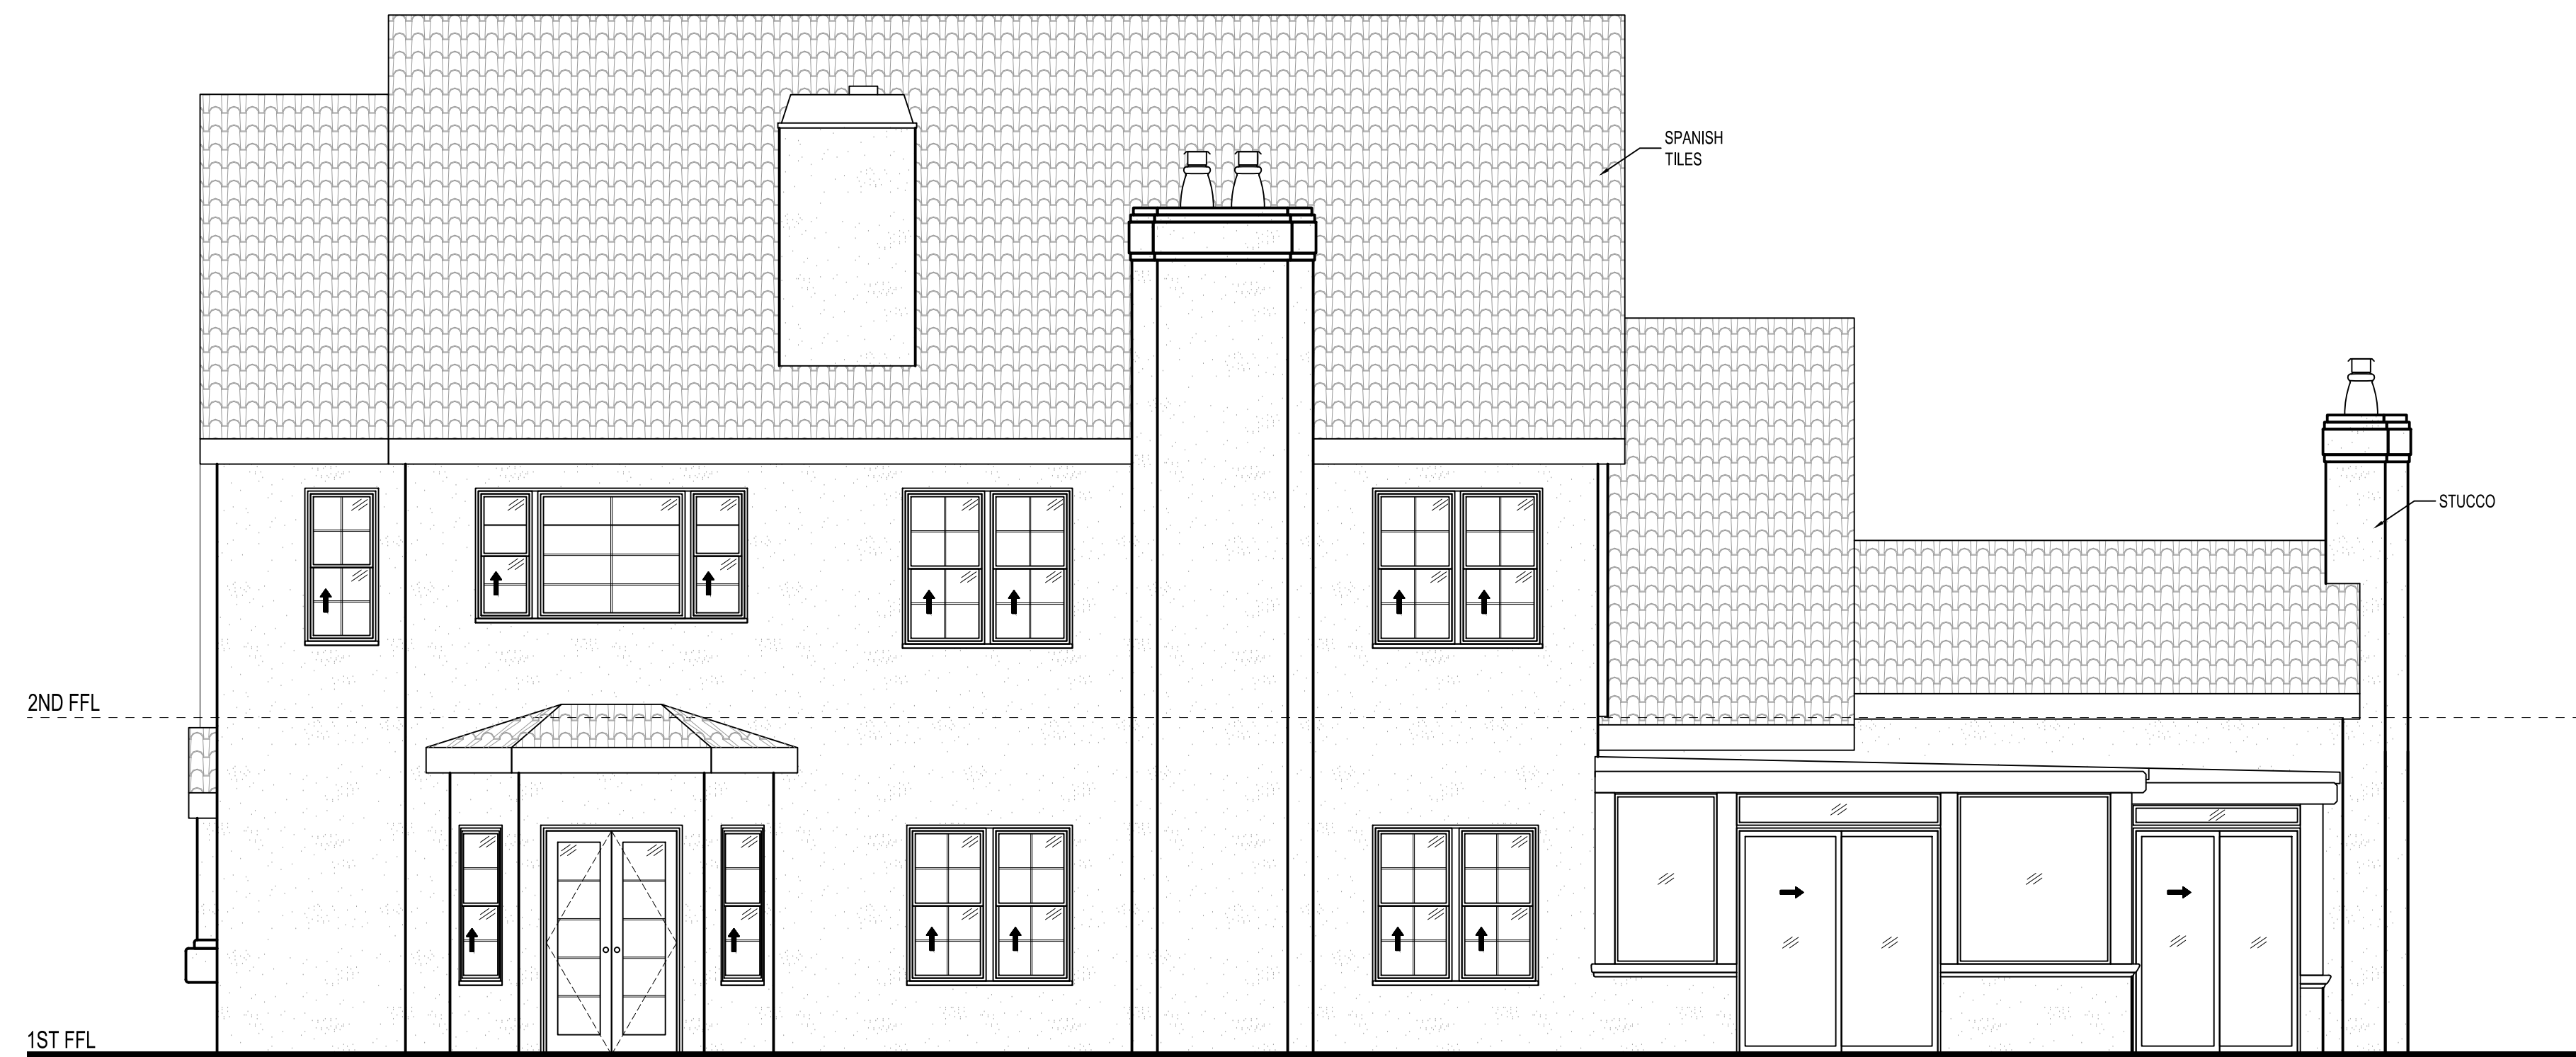


4 S. W. ELEVATION  
 0 2' 4' 8'  
 SCALE: 1/4" = 1'-0"

REVISIONS	BY

**AS-BUILT**  
LOS ANGELES

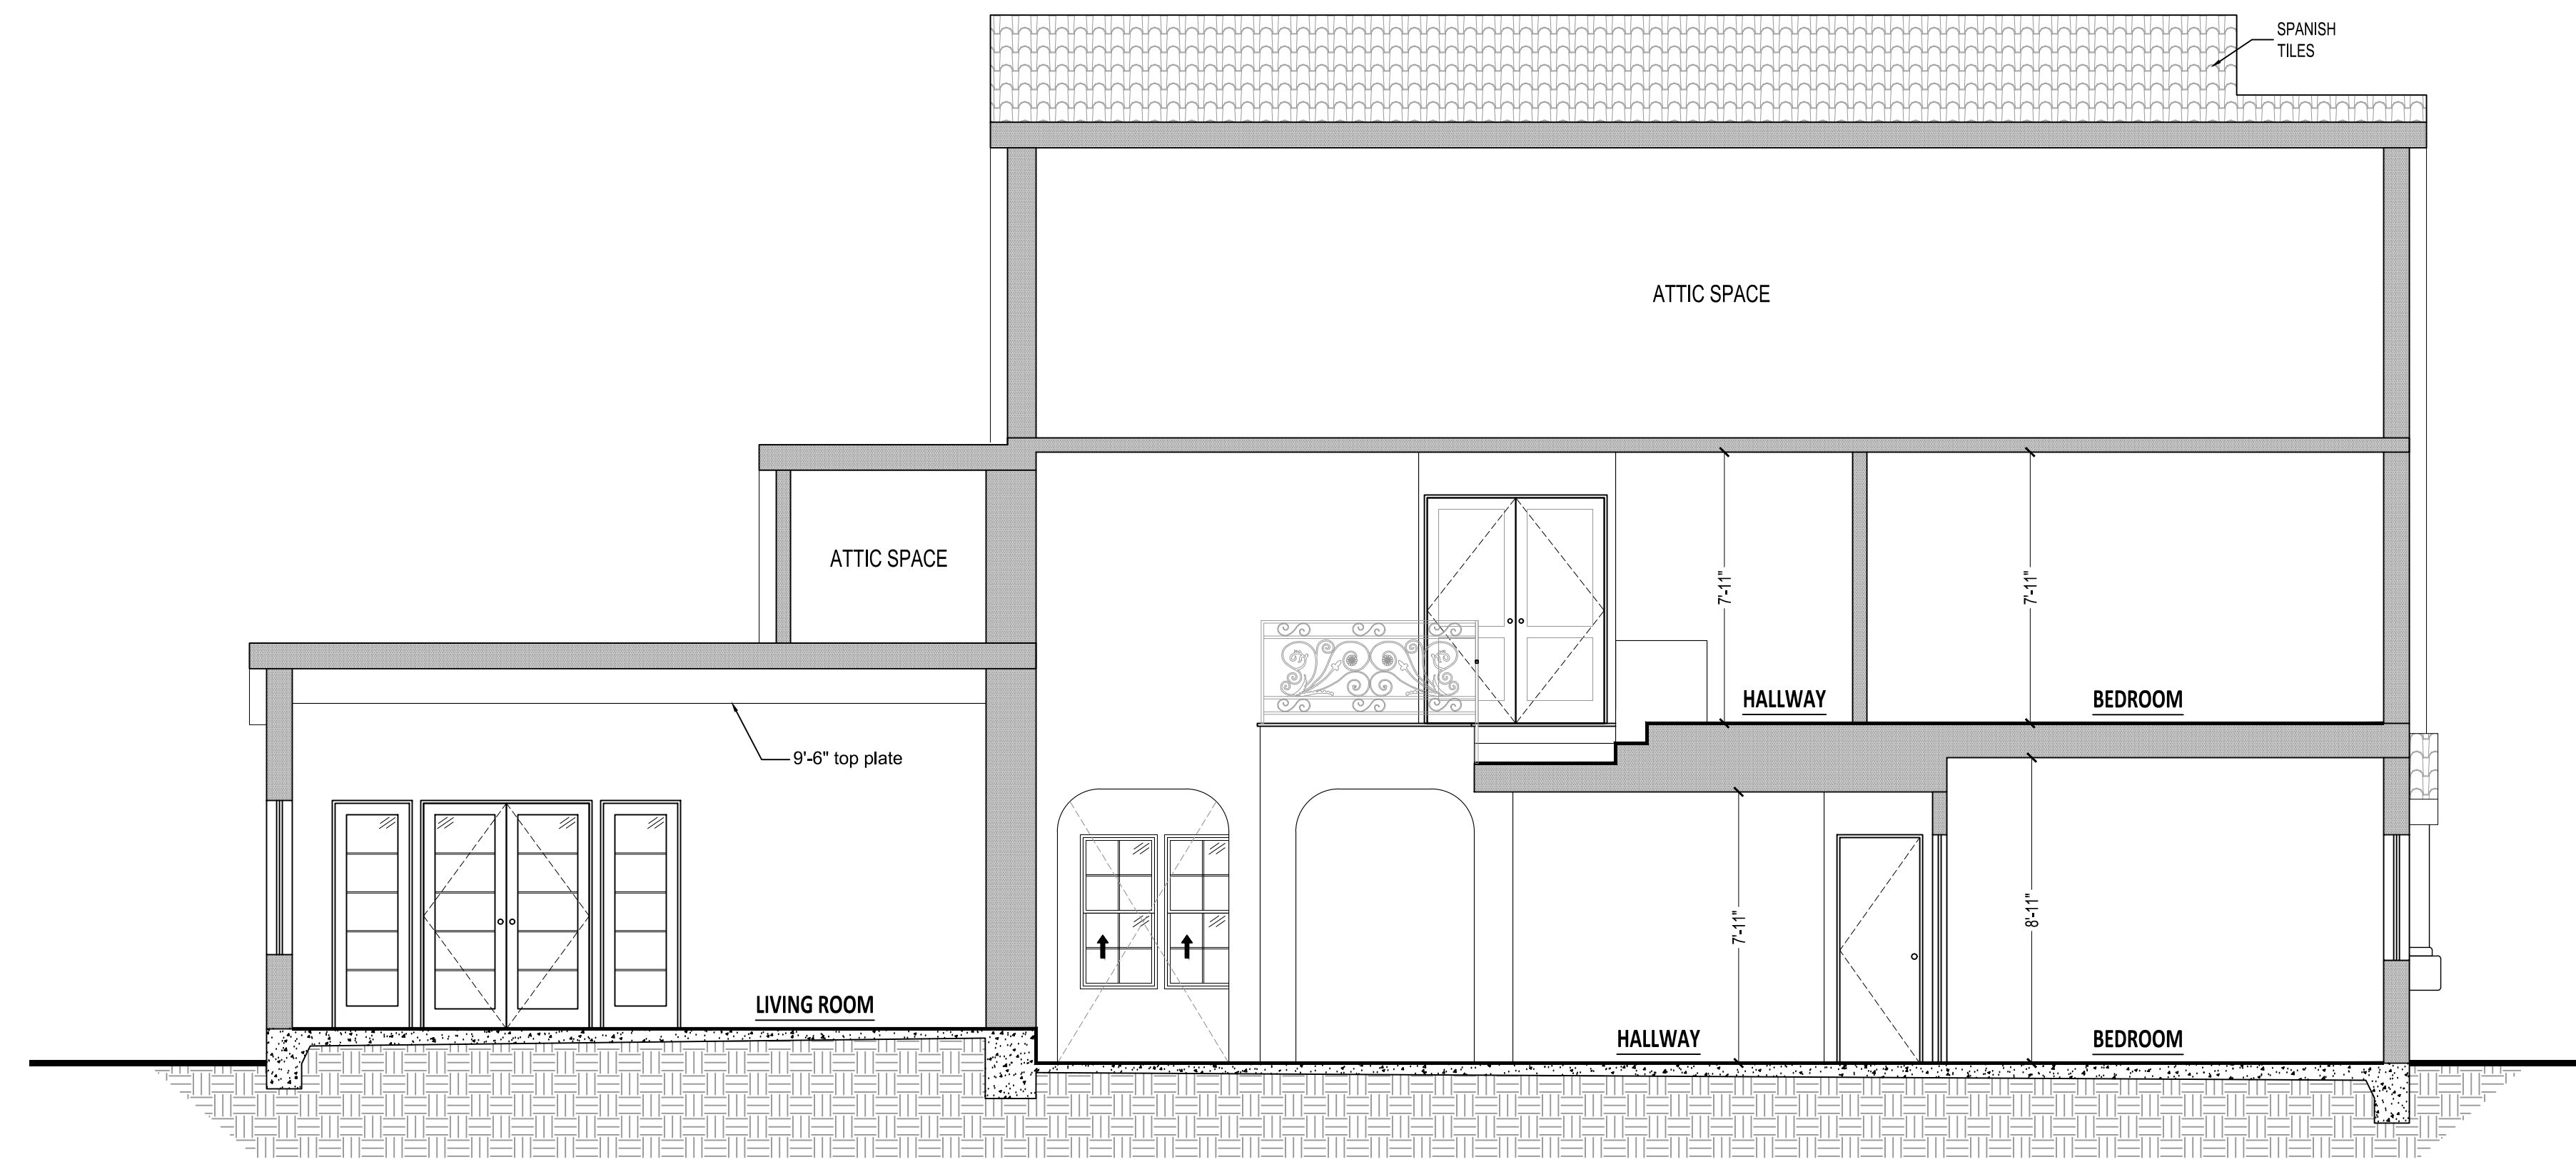

**SECTION A-A**

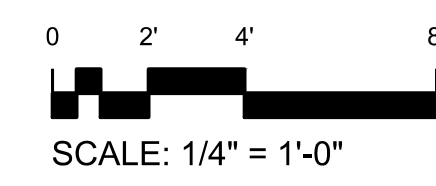

Sheet content :  
**SECTION**

Project :  
830 GREENRIDGE DR  
LA CANADA FLT CA 91011

Owner:

Date


Scale

Drawn


Job

Sheet



**A-6**

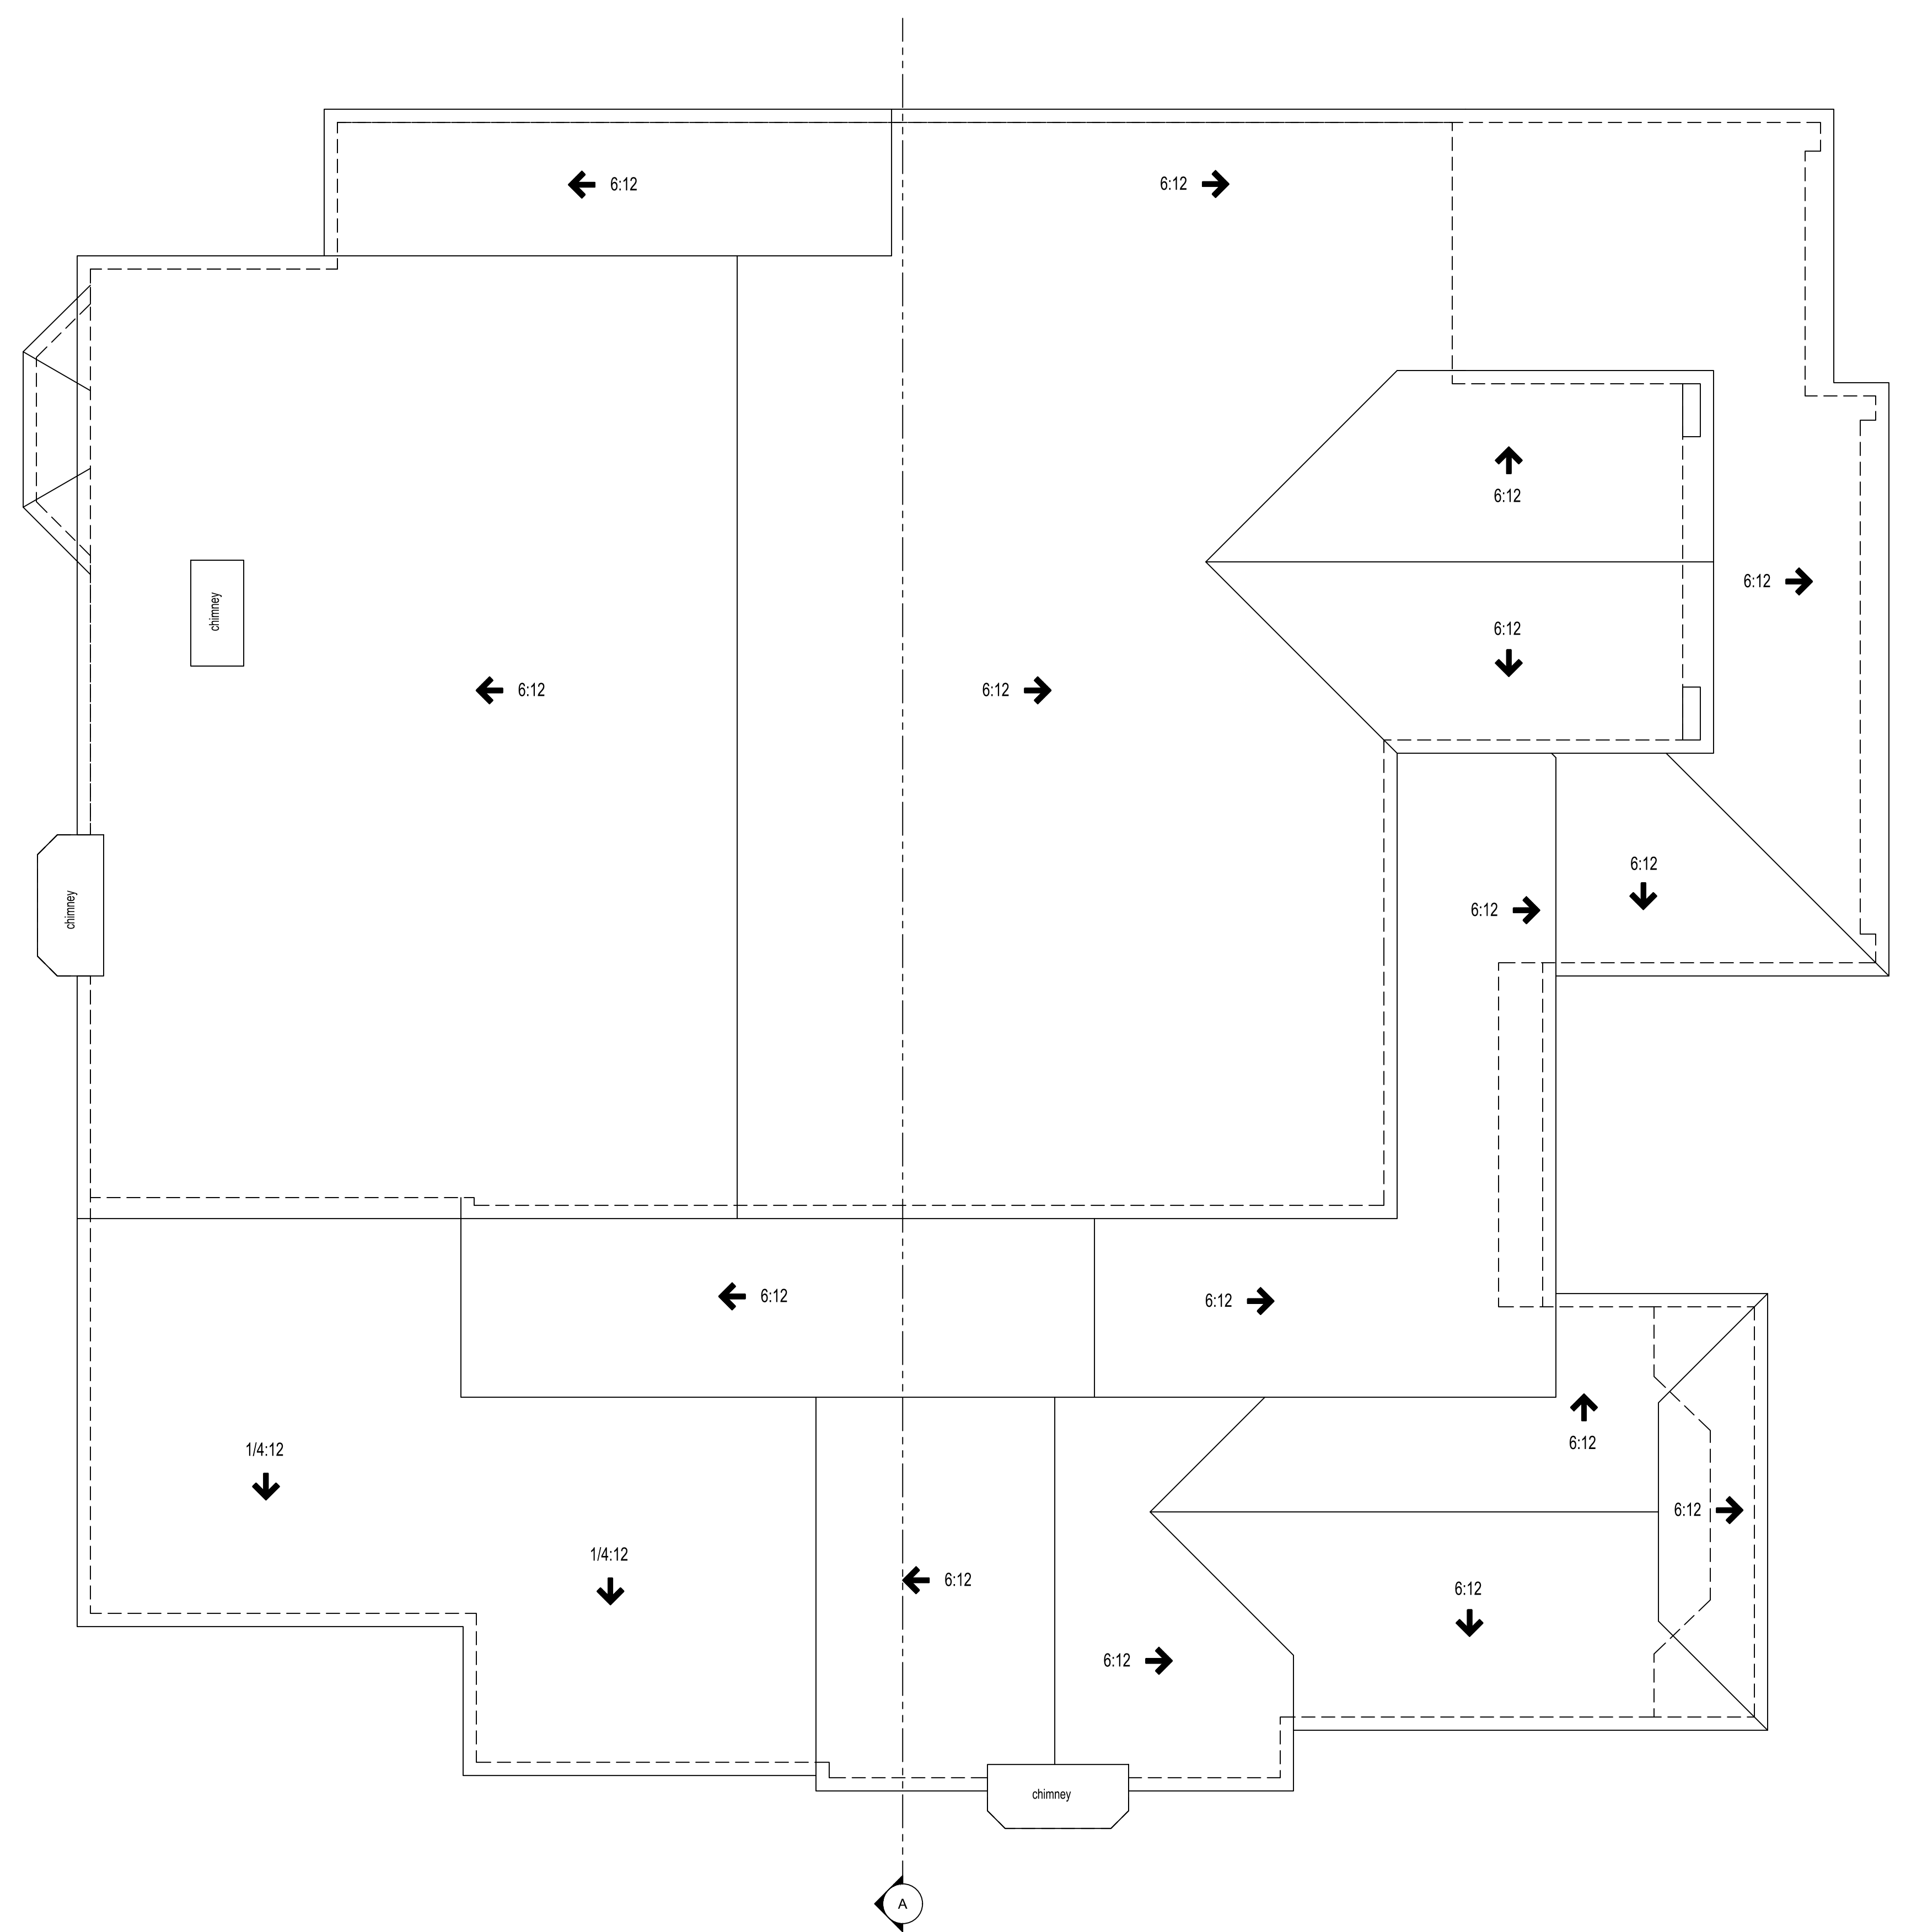

ROOF PLAN

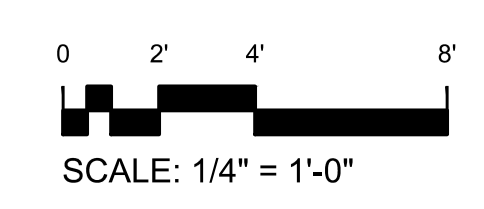

REVISIONS	BY
<b>AS-BUILT</b> LOS ANGELES	
Sheet content : ROOF PLAN	
Project : 830 GREENRIDGE DR LA CANADA FLT CA 91011	
Owner :	
Date	
Scale	
Drawn	
Job	
Sheet	
<b>A-7</b>	

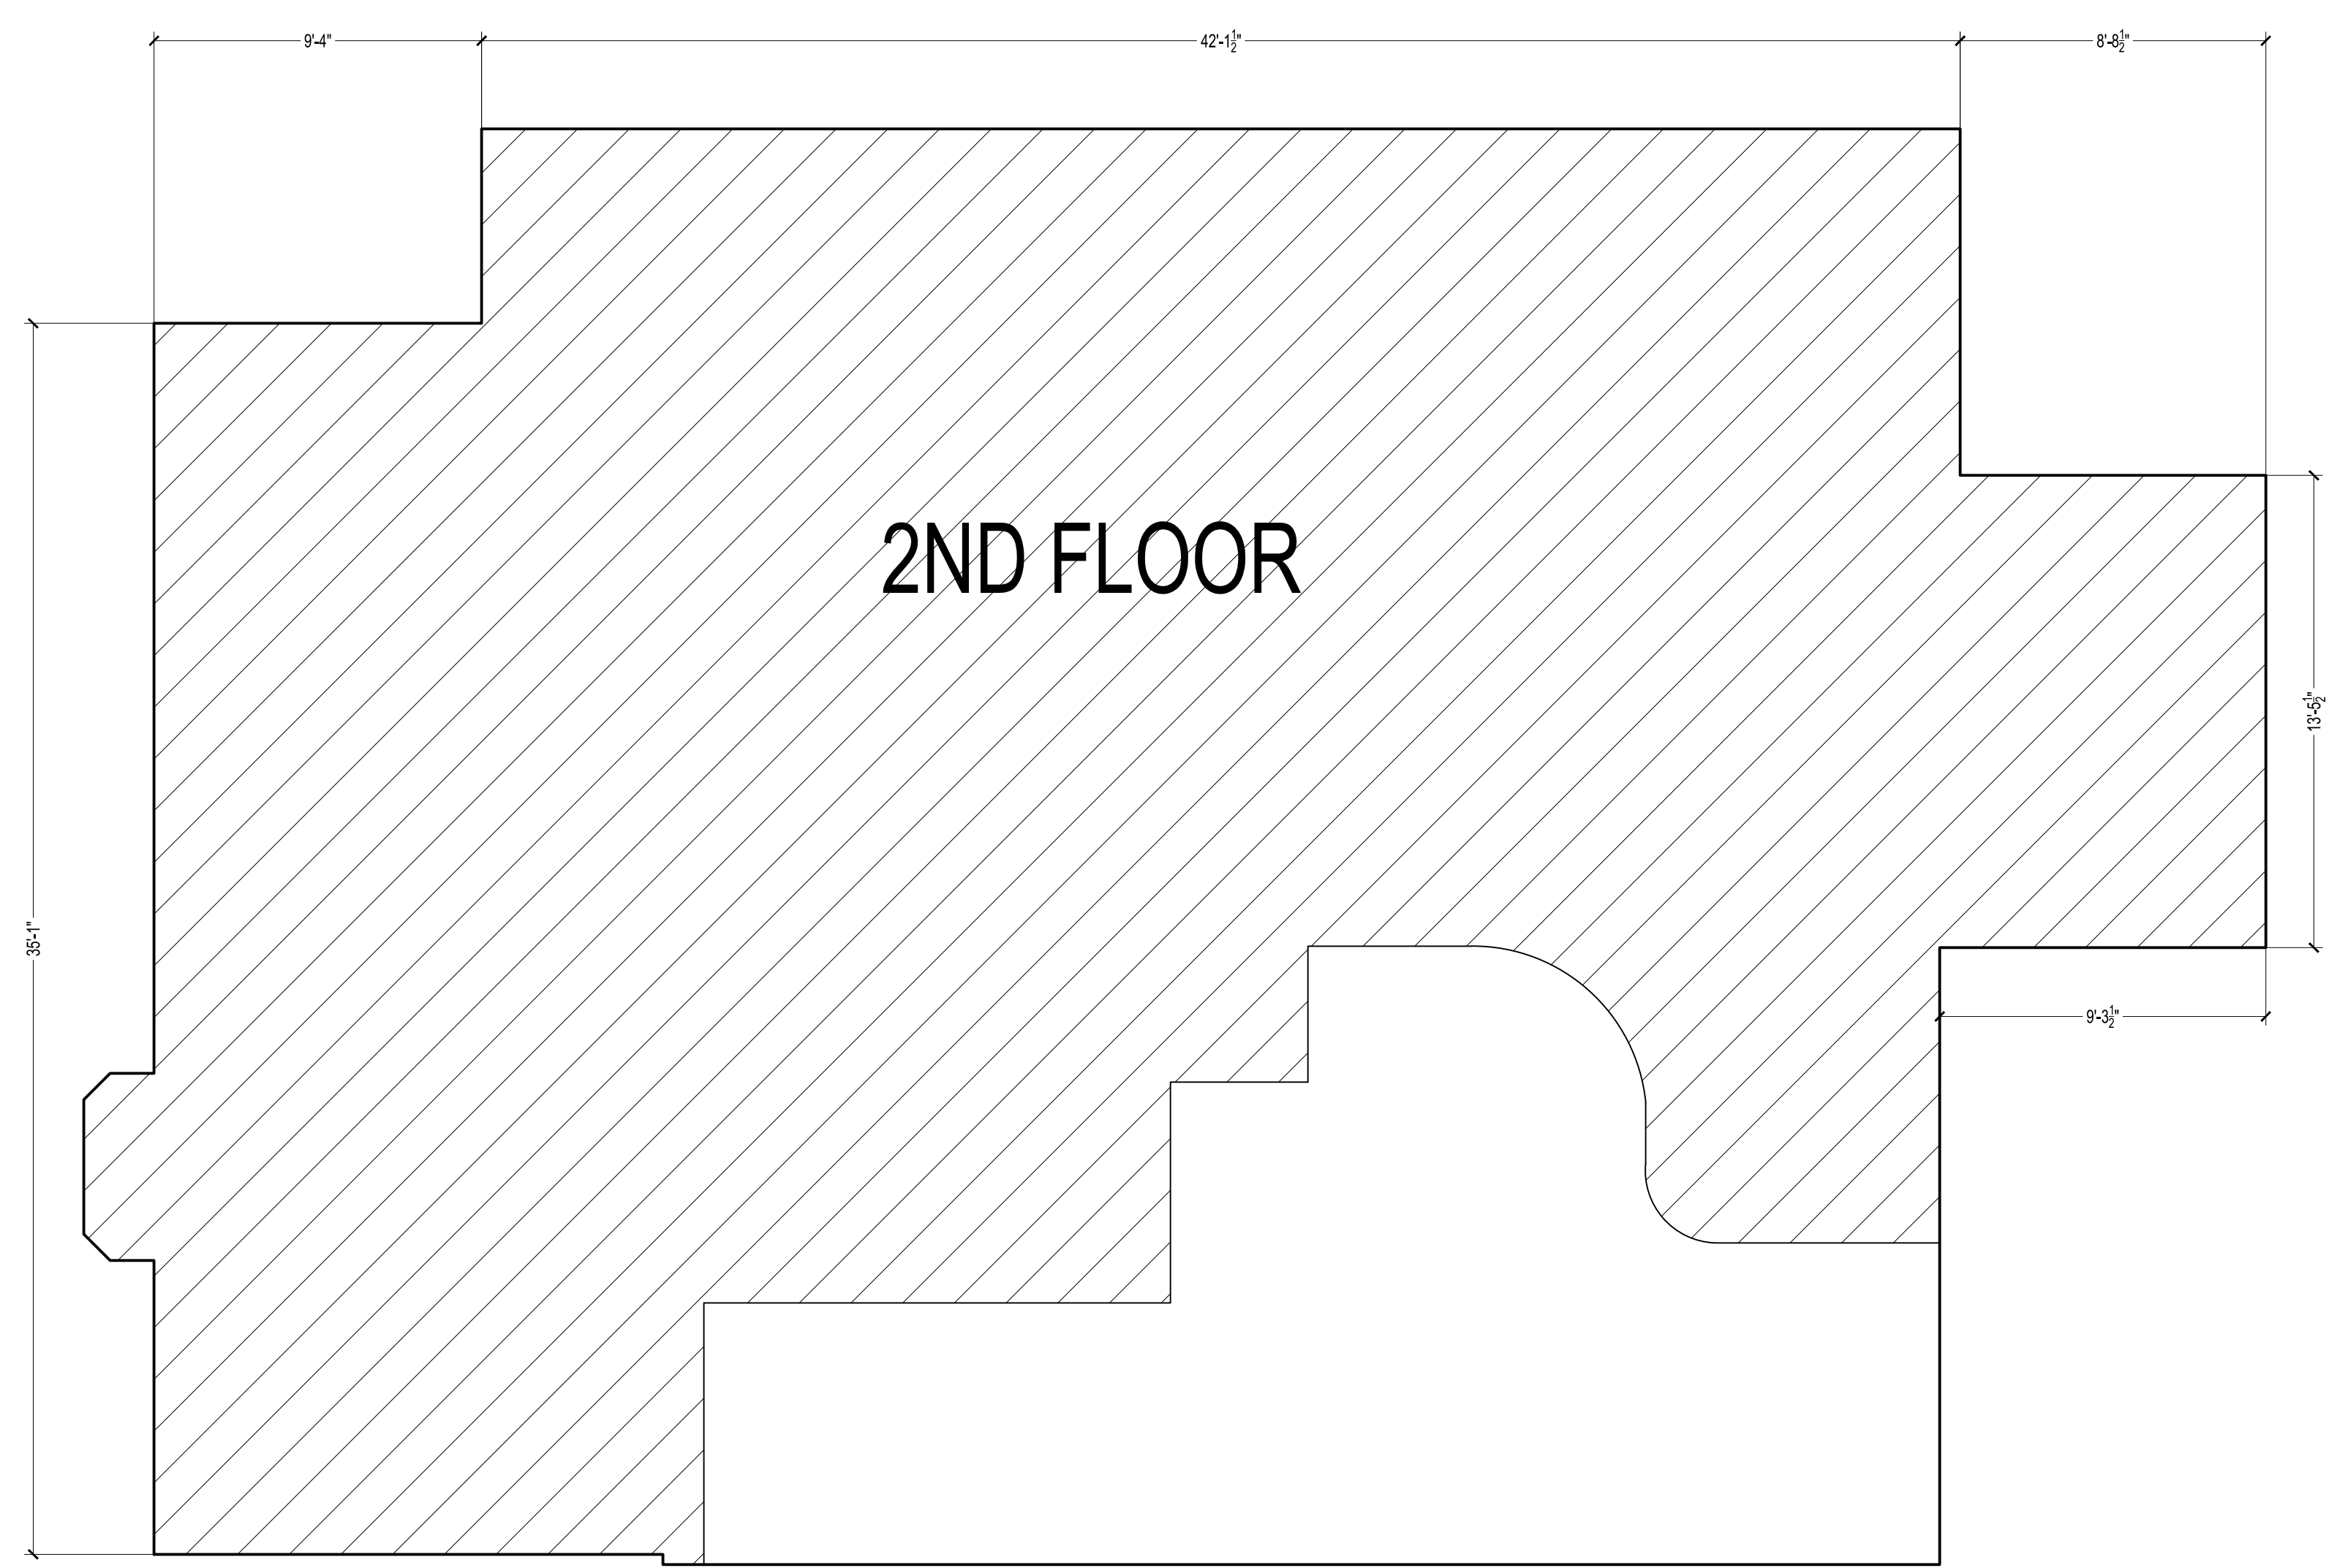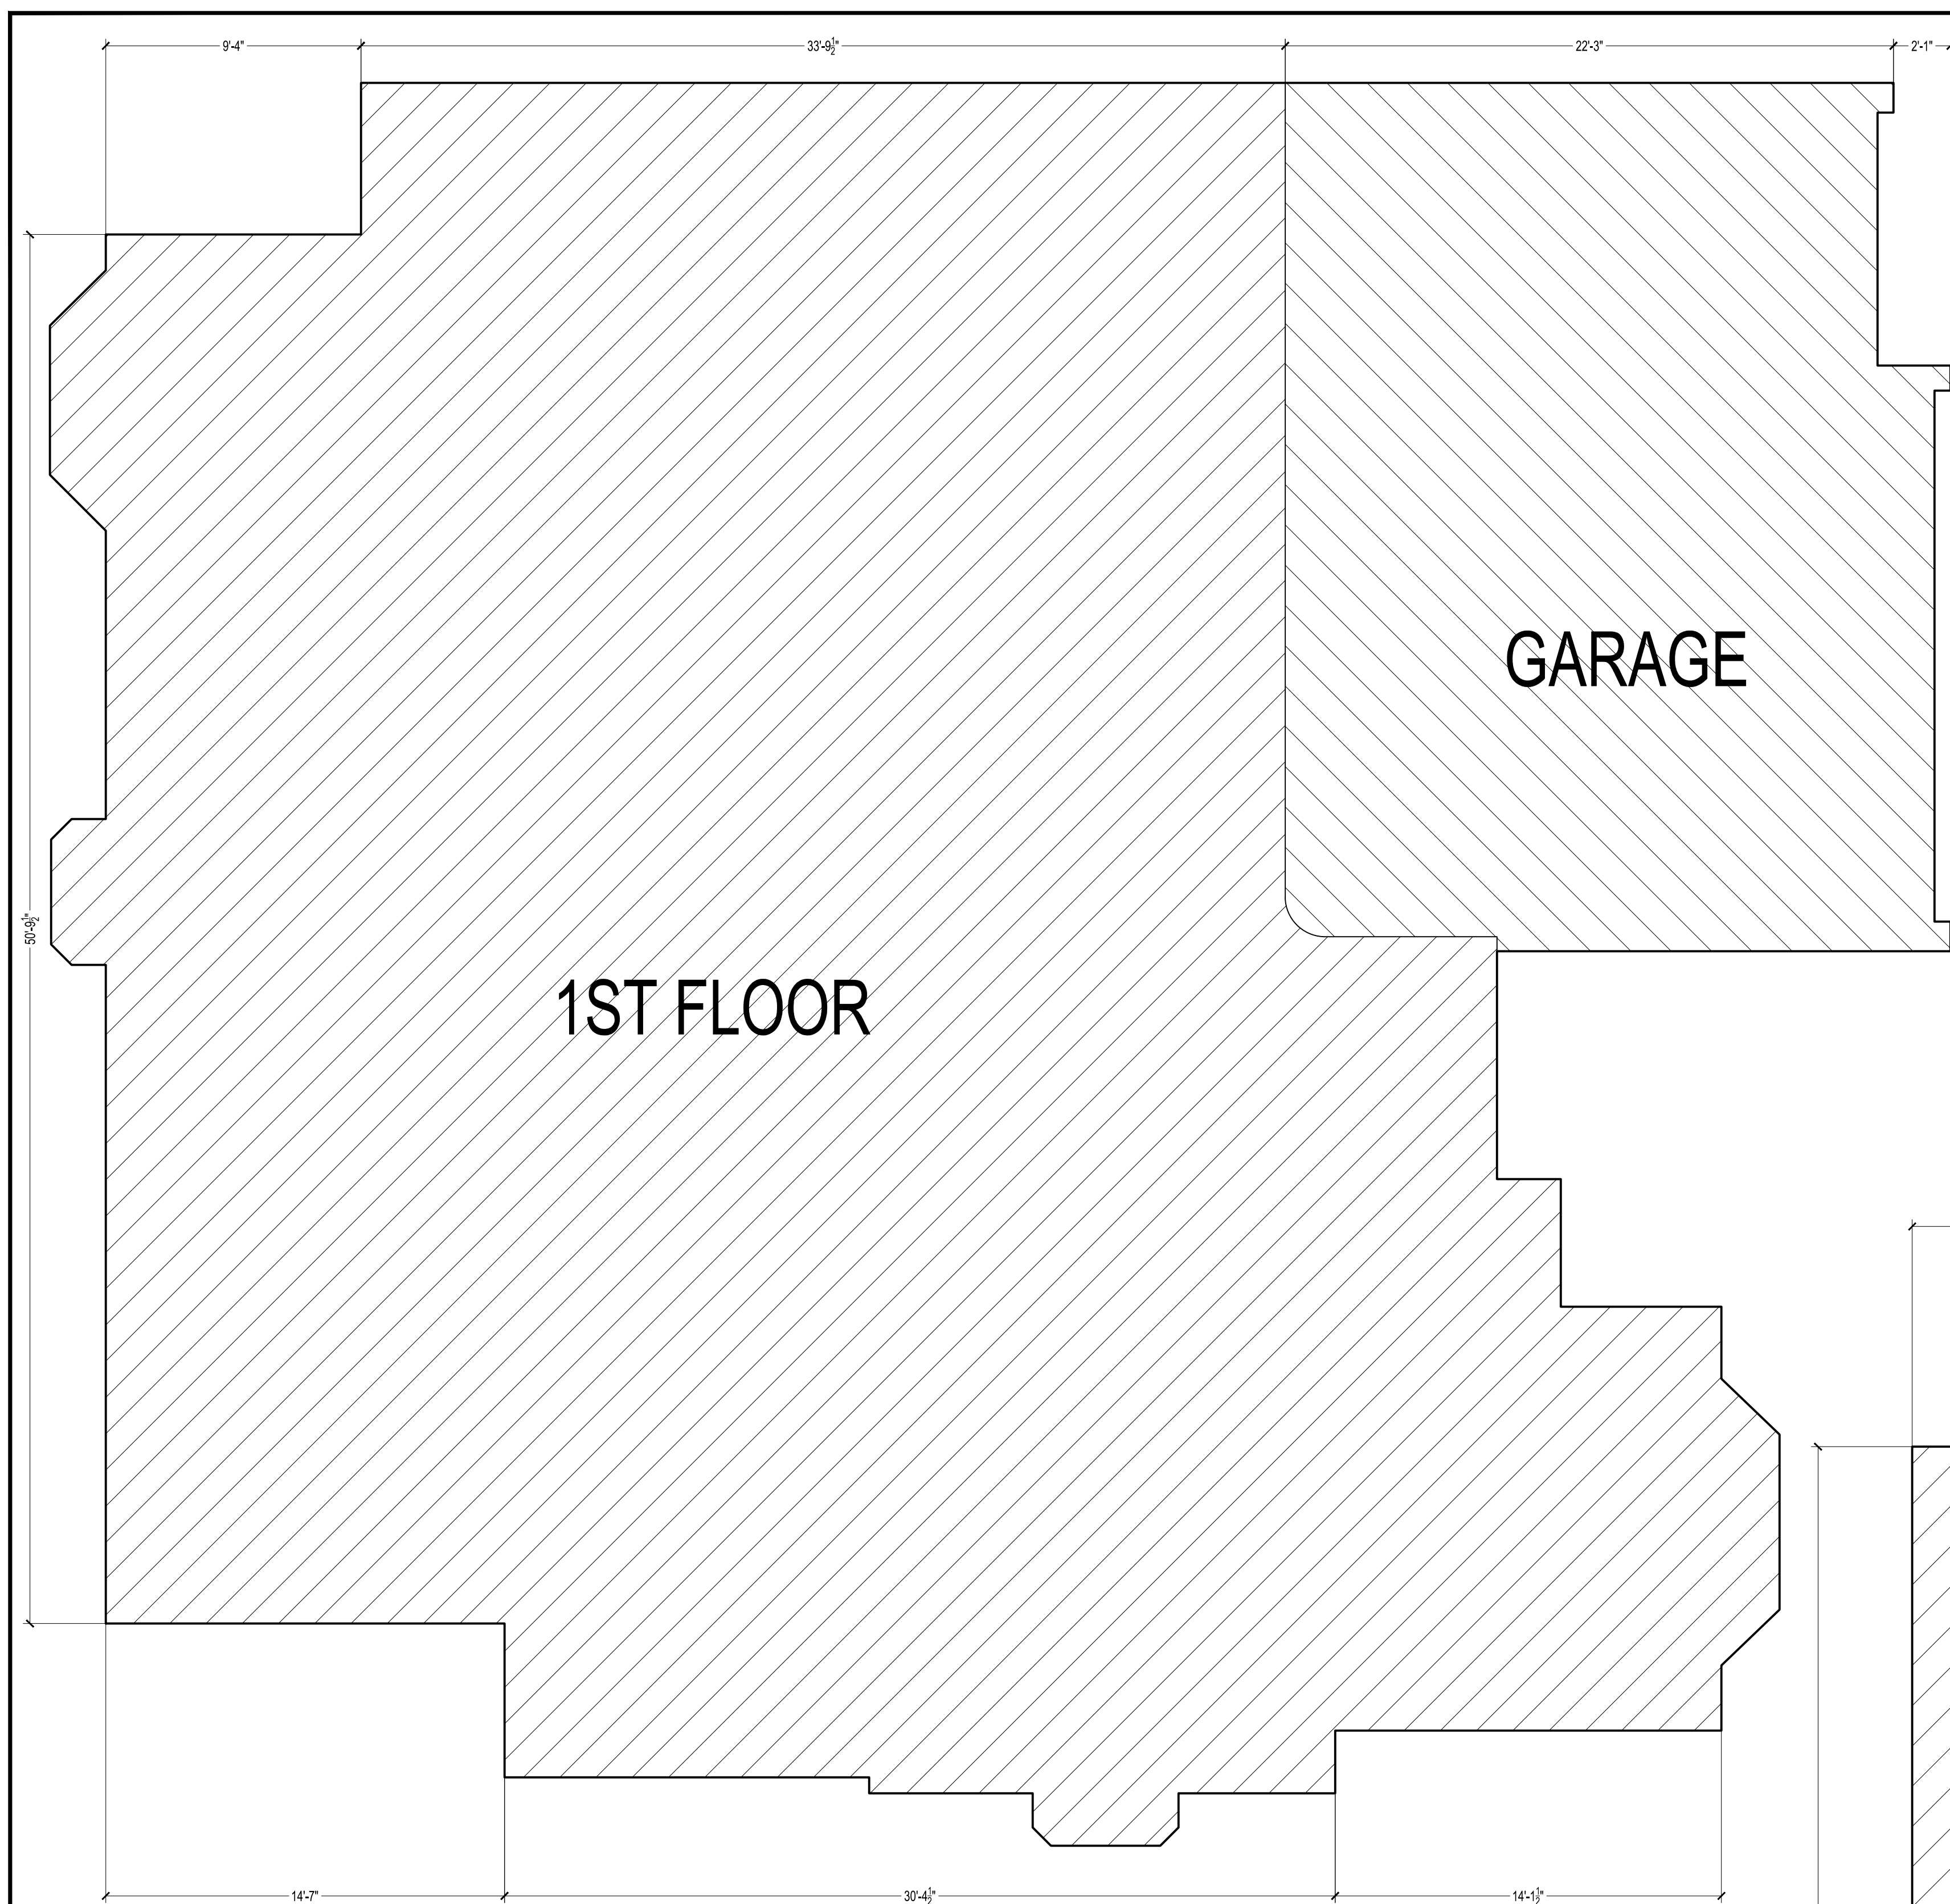

SQUARE FOOTAGE  
 FIRST FLOOR: 2968 SF  
 SECOND FLOOR: 1771 SF  
 GARAGE: 729 SF  
 TOTAL: 5,468 SF

REVISIONS	BY
<b>AS-BUILT</b> LOS ANGELES	
Sheet content : SQUARE FOOTAGE CALCULATION	
Project : 830 GREENRIDGE DR LA CANADA FLT CA 91011	
Owner:	
Date	
Scale	
Drawn	
Job	
Sheet	
<b>A-8</b>	