

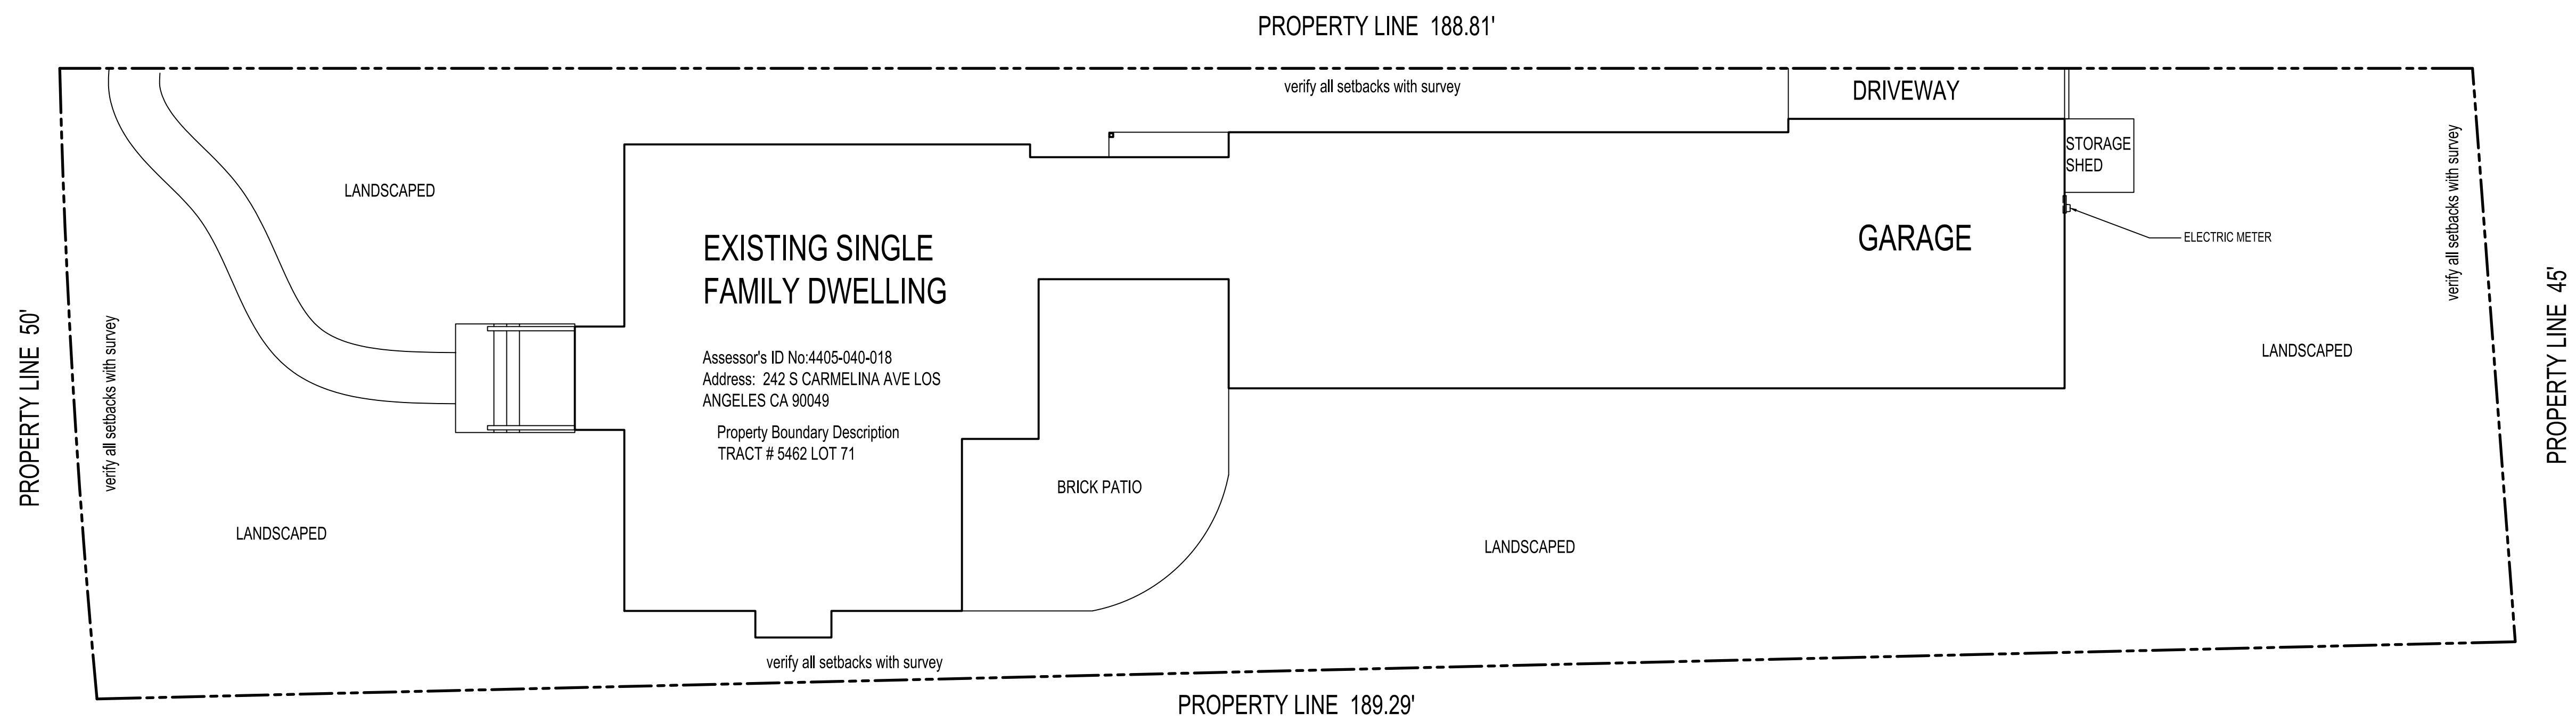


CARMELINA AVE

9TH HELENA DR

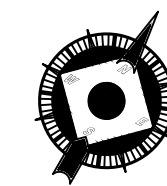

PLOT PLAN

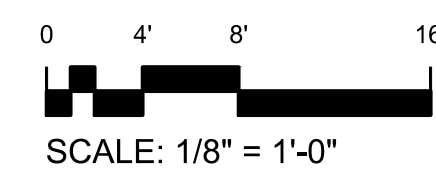

REVISIONS	BY

AS-BUILT
LOS ANGELES

Sheet content :
PLOT PLAN

Project :
242 S CARMELINA AVE
LOS ANGELES CA 90049

Owner:

Date


Scale

Drawn




Job

Sheet


A-1

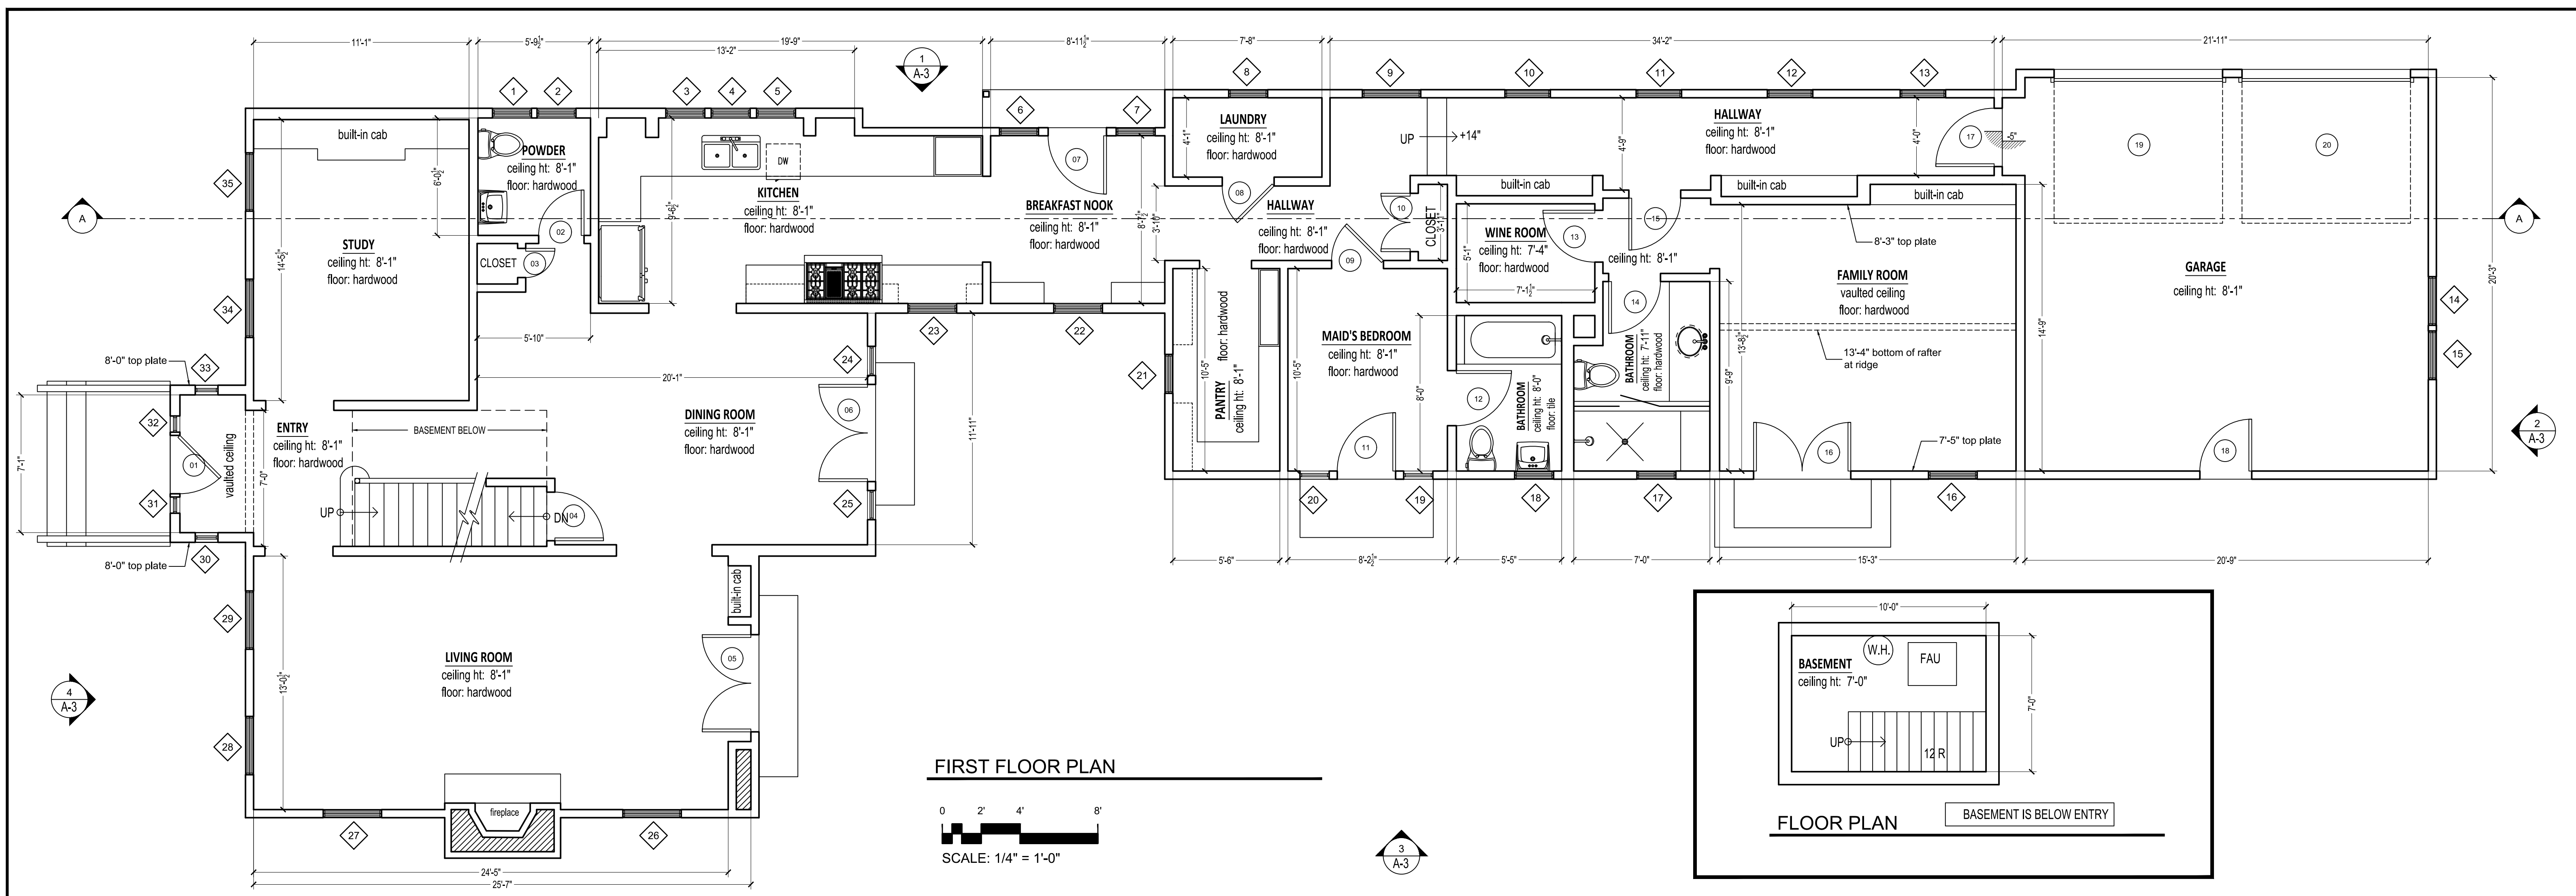

FIRST FLOOR PLAN

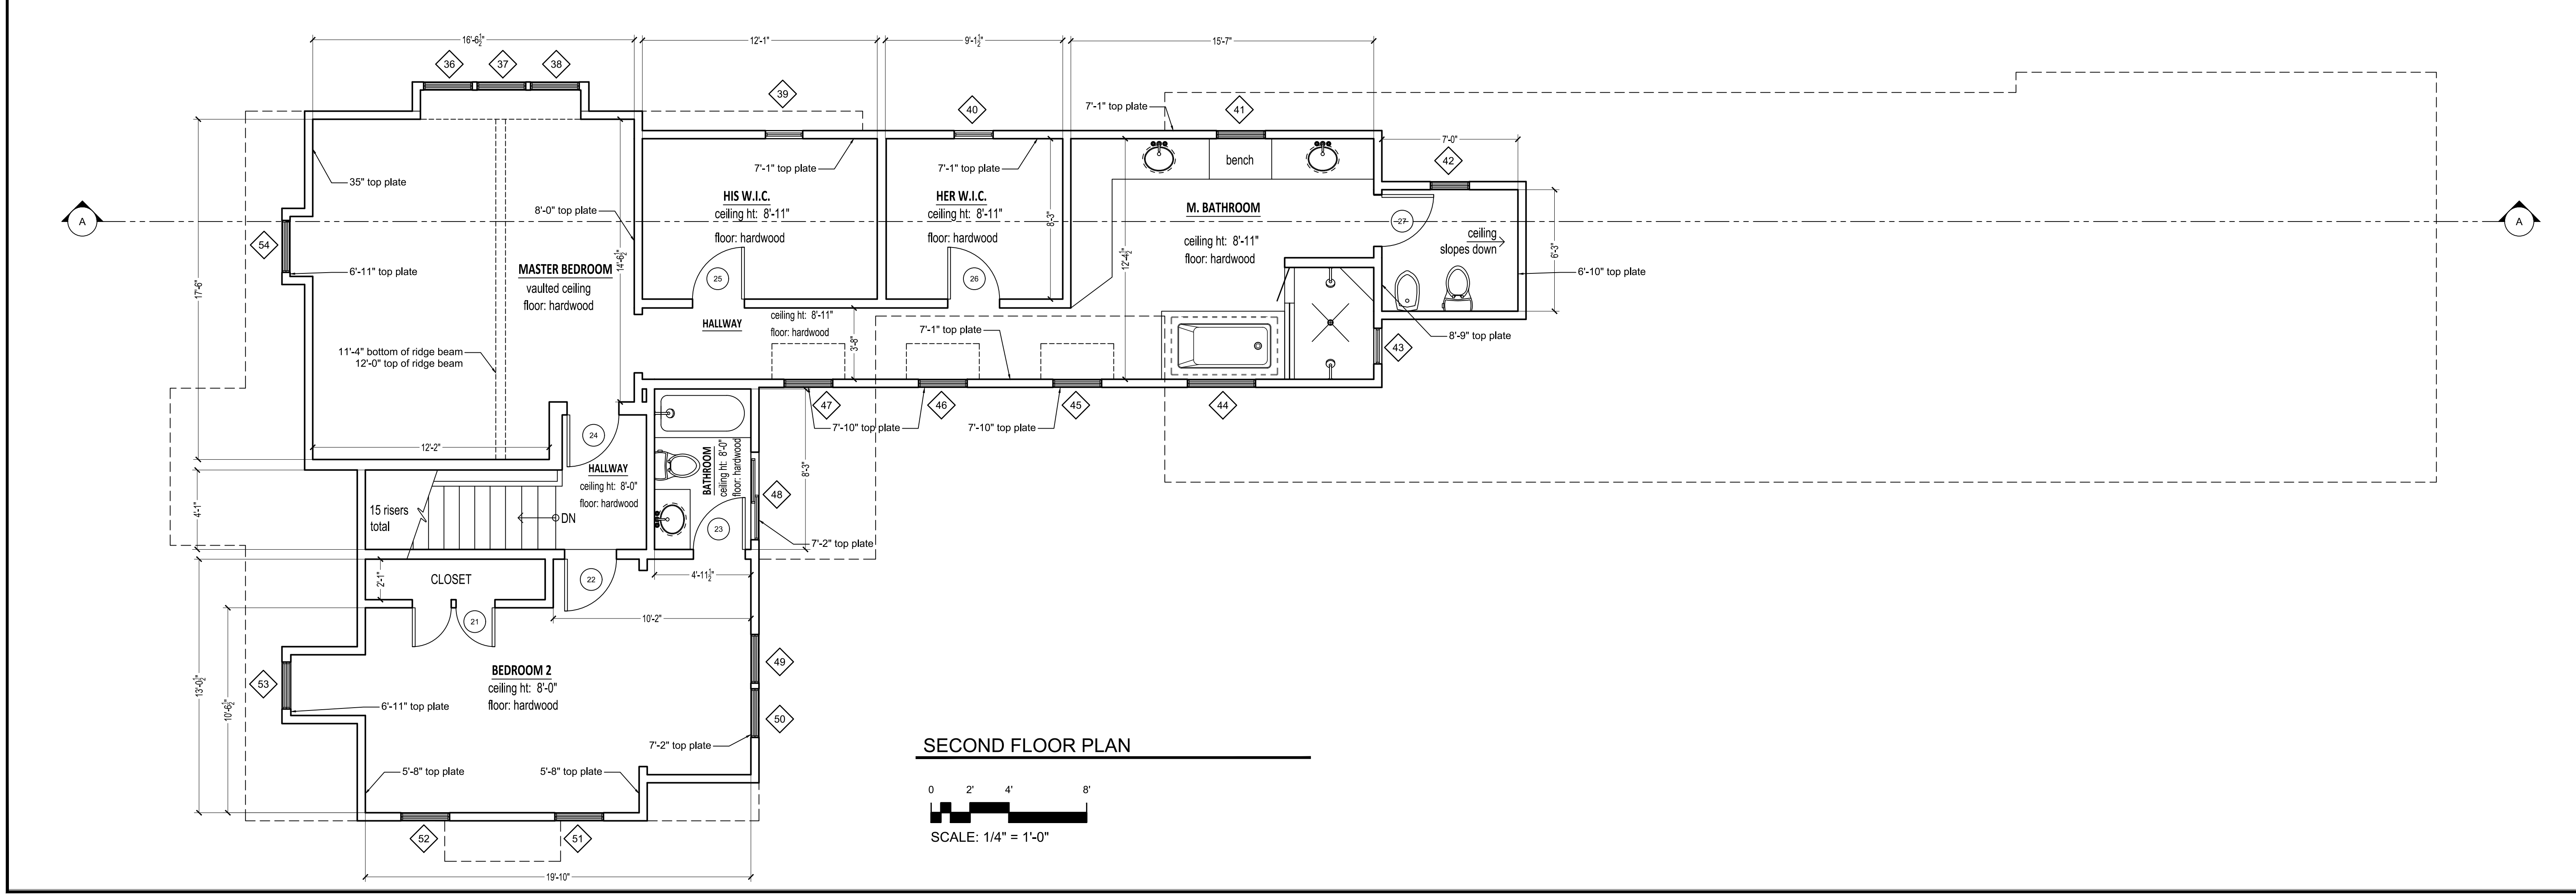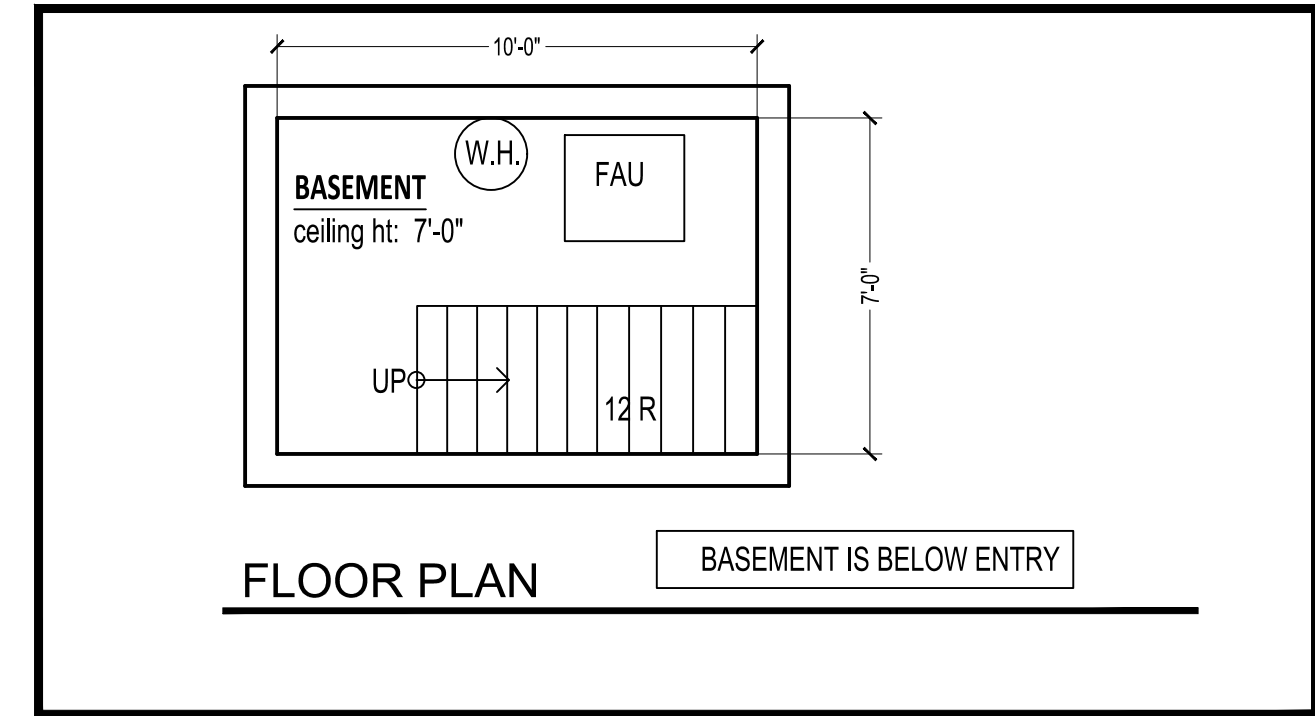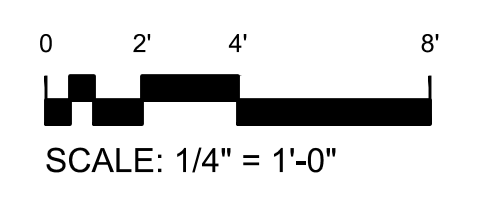

SECOND FLOOR PLAN

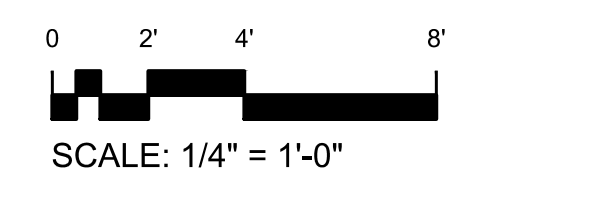

REVISIONS	BY
AS-BUILT LOS ANGELES	
FLOOR PLANS	
Sheet content :	
Project :	242 S CARMELINA AVE LOS ANGELES CA 90049
Owner:	
Date	
Scale	
Drawn	
Job	
Sheet	A-2



1 N. W. ELEVATION
 0 2' 4' 8'
 SCALE: 1/4" = 1'-0"

WINDOW SCHEDULE					
MARK	SIZE		TYPE	Head Height	NOTES
	Width	HEIGHT			
1	2'-0"	3'-5"	SINGLE HUNG	7'-0"	---
2	2'-0"	3'-5"	SINGLE HUNG	7'-0"	---
3	2'-0"	3'-5"	SINGLE HUNG	7'-0"	---
4	2'-0"	3'-5"	SINGLE HUNG	7'-0"	---
5	2'-0"	3'-5"	SINGLE HUNG	7'-0"	---
6	2'-0"	3'-5"	SINGLE HUNG	7'-0"	---
7	2'-0"	3'-5"	SINGLE HUNG	7'-0"	---
8	2'-0"	3'-5"	SINGLE HUNG	6'-10"	---
9	3'-0"	3'-10"	SINGLE HUNG	6'-8"	---
10	2'-4"	5'-0"	SINGLE HUNG	6'-8"	---
11	2'-4"	5'-0"	SINGLE HUNG	6'-8"	---
12	2'-4"	5'-0"	SINGLE HUNG	6'-8"	---
13	2'-4"	5'-0"	SINGLE HUNG	6'-8"	---
14	2'-6"	2'-6"	SINGLE HUNG	7'-4"	---
15	2'-6"	2'-6"	SINGLE HUNG	7'-4"	---
16	2'-6"	3'-11"	SINGLE HUNG	7'-0"	---
17	2'-0"	2'-5"	SINGLE HUNG	7'-0"	---
18	2'-0"	2'-11"	SINGLE HUNG	7'-0"	---
19	1'-6"	7'-1"	FIXED	7'-1"	---
20	1'-6"	7'-1"	FIXED	7'-1"	---
21	2'-0"	2'-11"	SINGLE HUNG	7'-0"	---
22	2'-6"	3'-5"	SINGLE HUNG	7'-0"	---
23	2'-6"	3'-5"	SINGLE HUNG	7'-0"	---
24	1'-6"	7'-1"	FIXED	7'-1"	---
25	1'-6"	7'-1"	FIXED	7'-1"	---
26	3'-0"	5'-0"	SINGLE HUNG	7'-0"	---
27	3'-0"	5'-0"	SINGLE HUNG	7'-0"	---
28	3'-0"	5'-0"	SINGLE HUNG	7'-0"	---
29	3'-0"	5'-0"	SINGLE HUNG	7'-0"	---
30	1'-2"	4'-11"	FIXED	7'-2"	---
31	10"	7'-1"	FIXED	7'-1"	---
32	10"	7'-1"	FIXED	7'-1"	---
33	1'-2"	4'-11"	FIXED	7'-2"	---
34	3'-0"	5'-0"	SINGLE HUNG	7'-0"	---
35	3'-0"	5'-0"	SINGLE HUNG	7'-0"	---
36	2'-6"	4'-11"	SINGLE HUNG	6'-8"	---
37	2'-6"	4'-11"	SINGLE HUNG	6'-8"	---
38	2'-6"	4'-11"	SINGLE HUNG	6'-8"	---
39	1'-11"	1'-1"	FIXED	6'-8"	---
40	2'-0"	4'-0"	FIXED	6'-10"	---
41	2'-6"	3'-11"	SINGLE HUNG	6'-10"	---
42	2'-0"	3'-5"	SINGLE HUNG	6'-7"	---
43	1'-10"	1'-10"	AWNING	6'-9"	---
44	3'-6"	4'-11"	SINGLE HUNG	6'-10"	---
45	2'-6"	3'-11"	SINGLE HUNG	6'-9"	---
46	2'-6"	3'-11"	SINGLE HUNG	6'-9"	---
47	2'-6"	3'-11"	SINGLE HUNG	6'-9"	---
48	4'-6"	2'-0"	SLIDING	6'-5"	---
49	2'-6"	3'-11"	SINGLE HUNG	6'-9"	---
50	2'-6"	3'-11"	SINGLE HUNG	6'-9"	---
51	2'-6"	3'-11"	SINGLE HUNG	6'-6"	---
52	2'-6"	3'-11"	SINGLE HUNG	6'-6"	---
53	2'-5"	3'-10"	SINGLE HUNG	6'-7"	---
54	2'-8"	3'-11"	SINGLE HUNG	6'-8"	---

DOOR SCHEDULE				
MARK	SIZE		Type	NOTES
	WD	HGT		
1	3'-0"	7'-1"	SWING	---
2	2'-4"	6'-8"	SWING	---
3	1'-6"	6'-8"	SWING	---
4	2'-6"	6'-8"	SWING	---
5	5'-0"	7'-0"	FRENCH DOUBLE	---
6	5'-0"	7'-1"	FRENCH DOUBLE	---
7	3'-0"	7'-1"	SWING	---
8	2'-8"	6'-8"	SWING	---
9	2'-8"	6'-8"	SWING	---
10	3'-0"	6'-8"	SWING DOUBLE	---
11	3'-0"	7'-1"	SWING	---
12	2'-10"	6'-8"	SWING	---
13	2'-8"	6'-8"	SWING	---
14	2'-8"	6'-8"	SWING	---
15	2'-8"	6'-8"	SWING	---
16	5'-0"	7'-1"	SWING DOUBLE	---
17	3'-0"	6'-8"	SWING	---
18	2'-8"	6'-8"	SWING	---
19	8'-8"	7'-3"	GARAGE DOOR	---
20	8'-8"	7'-3"	GARAGE DOOR	---
21	2'-0"	6'-8"	SWING	---
22	2'-8"	6'-8"	SWING	---
23	2'-8"	6'-8"	SWING	---
24	2'-8"	6'-8"	SWING	---
25	2'-8"	6'-8"	SWING	---
26	2'-8"	6'-8"	SWING	---
27	2'-8"	6'-8"	SWING	---



2 N. E. ELEVATION
 0 2' 4' 8'
 SCALE: 1/4" = 1'-0"

REVISIONS BY

AS-BUILT
 LOS ANGELES

ELEVATIONS

Sheet content :

Project : 242 S CARMELINA AVE
 LOS ANGELES CA 90049

Owner :

Date
 Scale
 Drawn
 Job
 Sheet

A-3

08.08.13



3 S.E. ELEVATION

0 2' 4' 8'

SCALE: 1/4" = 1'-0"




4 S. W. ELEVATION

0 2' 4' 8'


SCALE: 1/4" = 1'-0"

REVISIONS	BY

AS-BUILT
LOS ANGELES

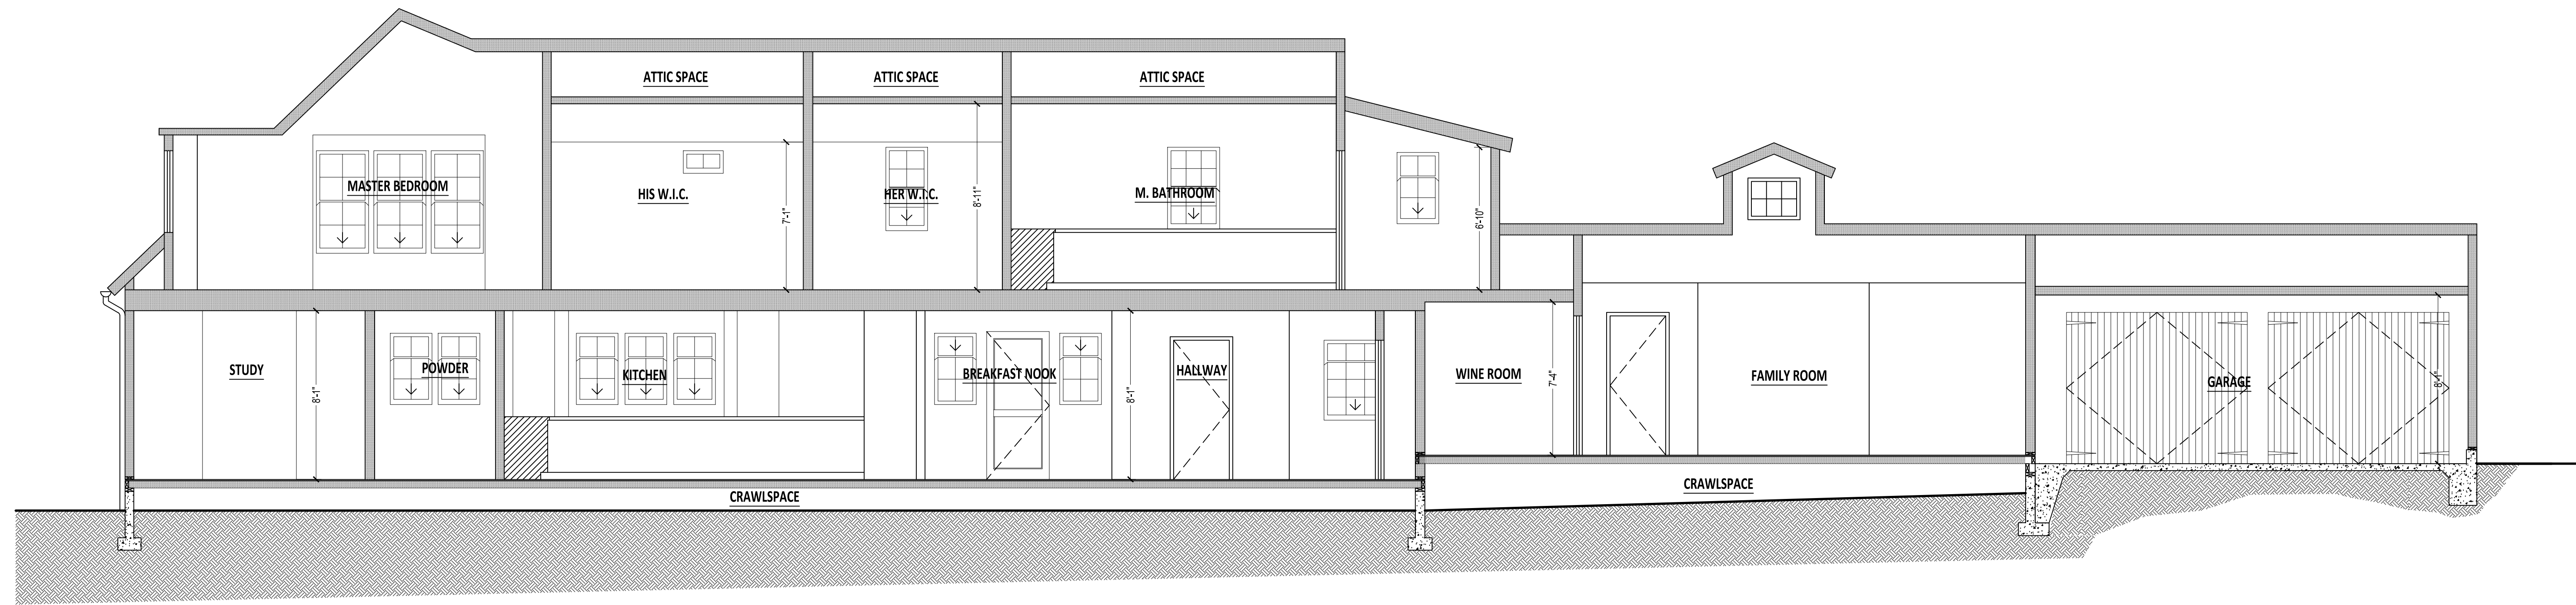

SECTION A-A

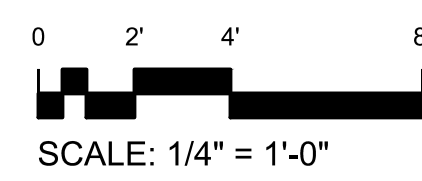

Sheet content :
SECTION A-A

Project :
242 S CARMELINA AVE
LOS ANGELES CA 90049

Owner:

Date

Scale

Drawn

Job

Sheet

A-5

REVISIONS	BY

AS-BUILT
LOS ANGELES

Sheet content :
ROOF PLAN

Project :
242 S CARMELINA AVE
LOS ANGELES CA 90049

Owner:

Date

Scale


Drawn


Job

Sheet

A-6

08.28.13

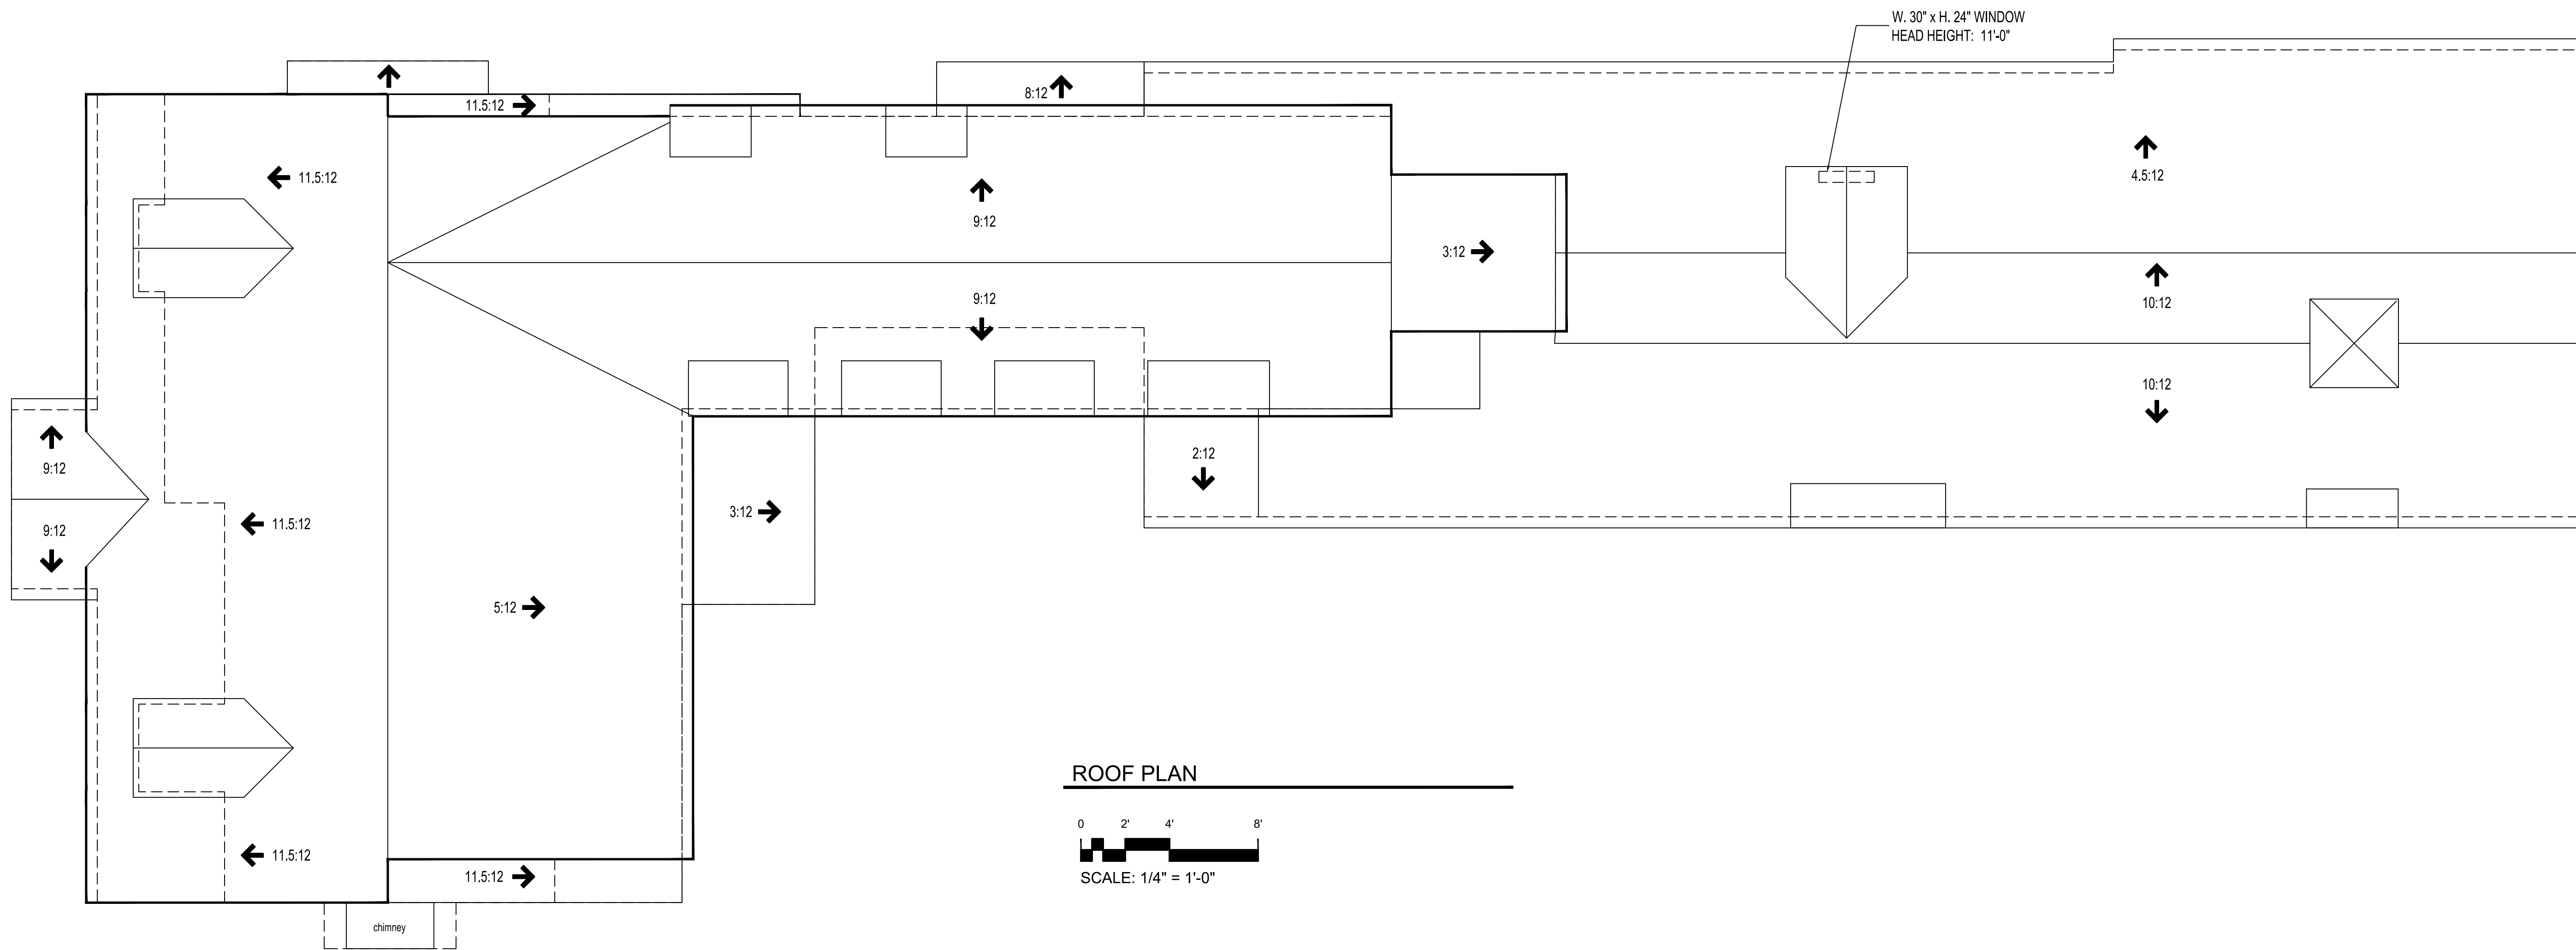

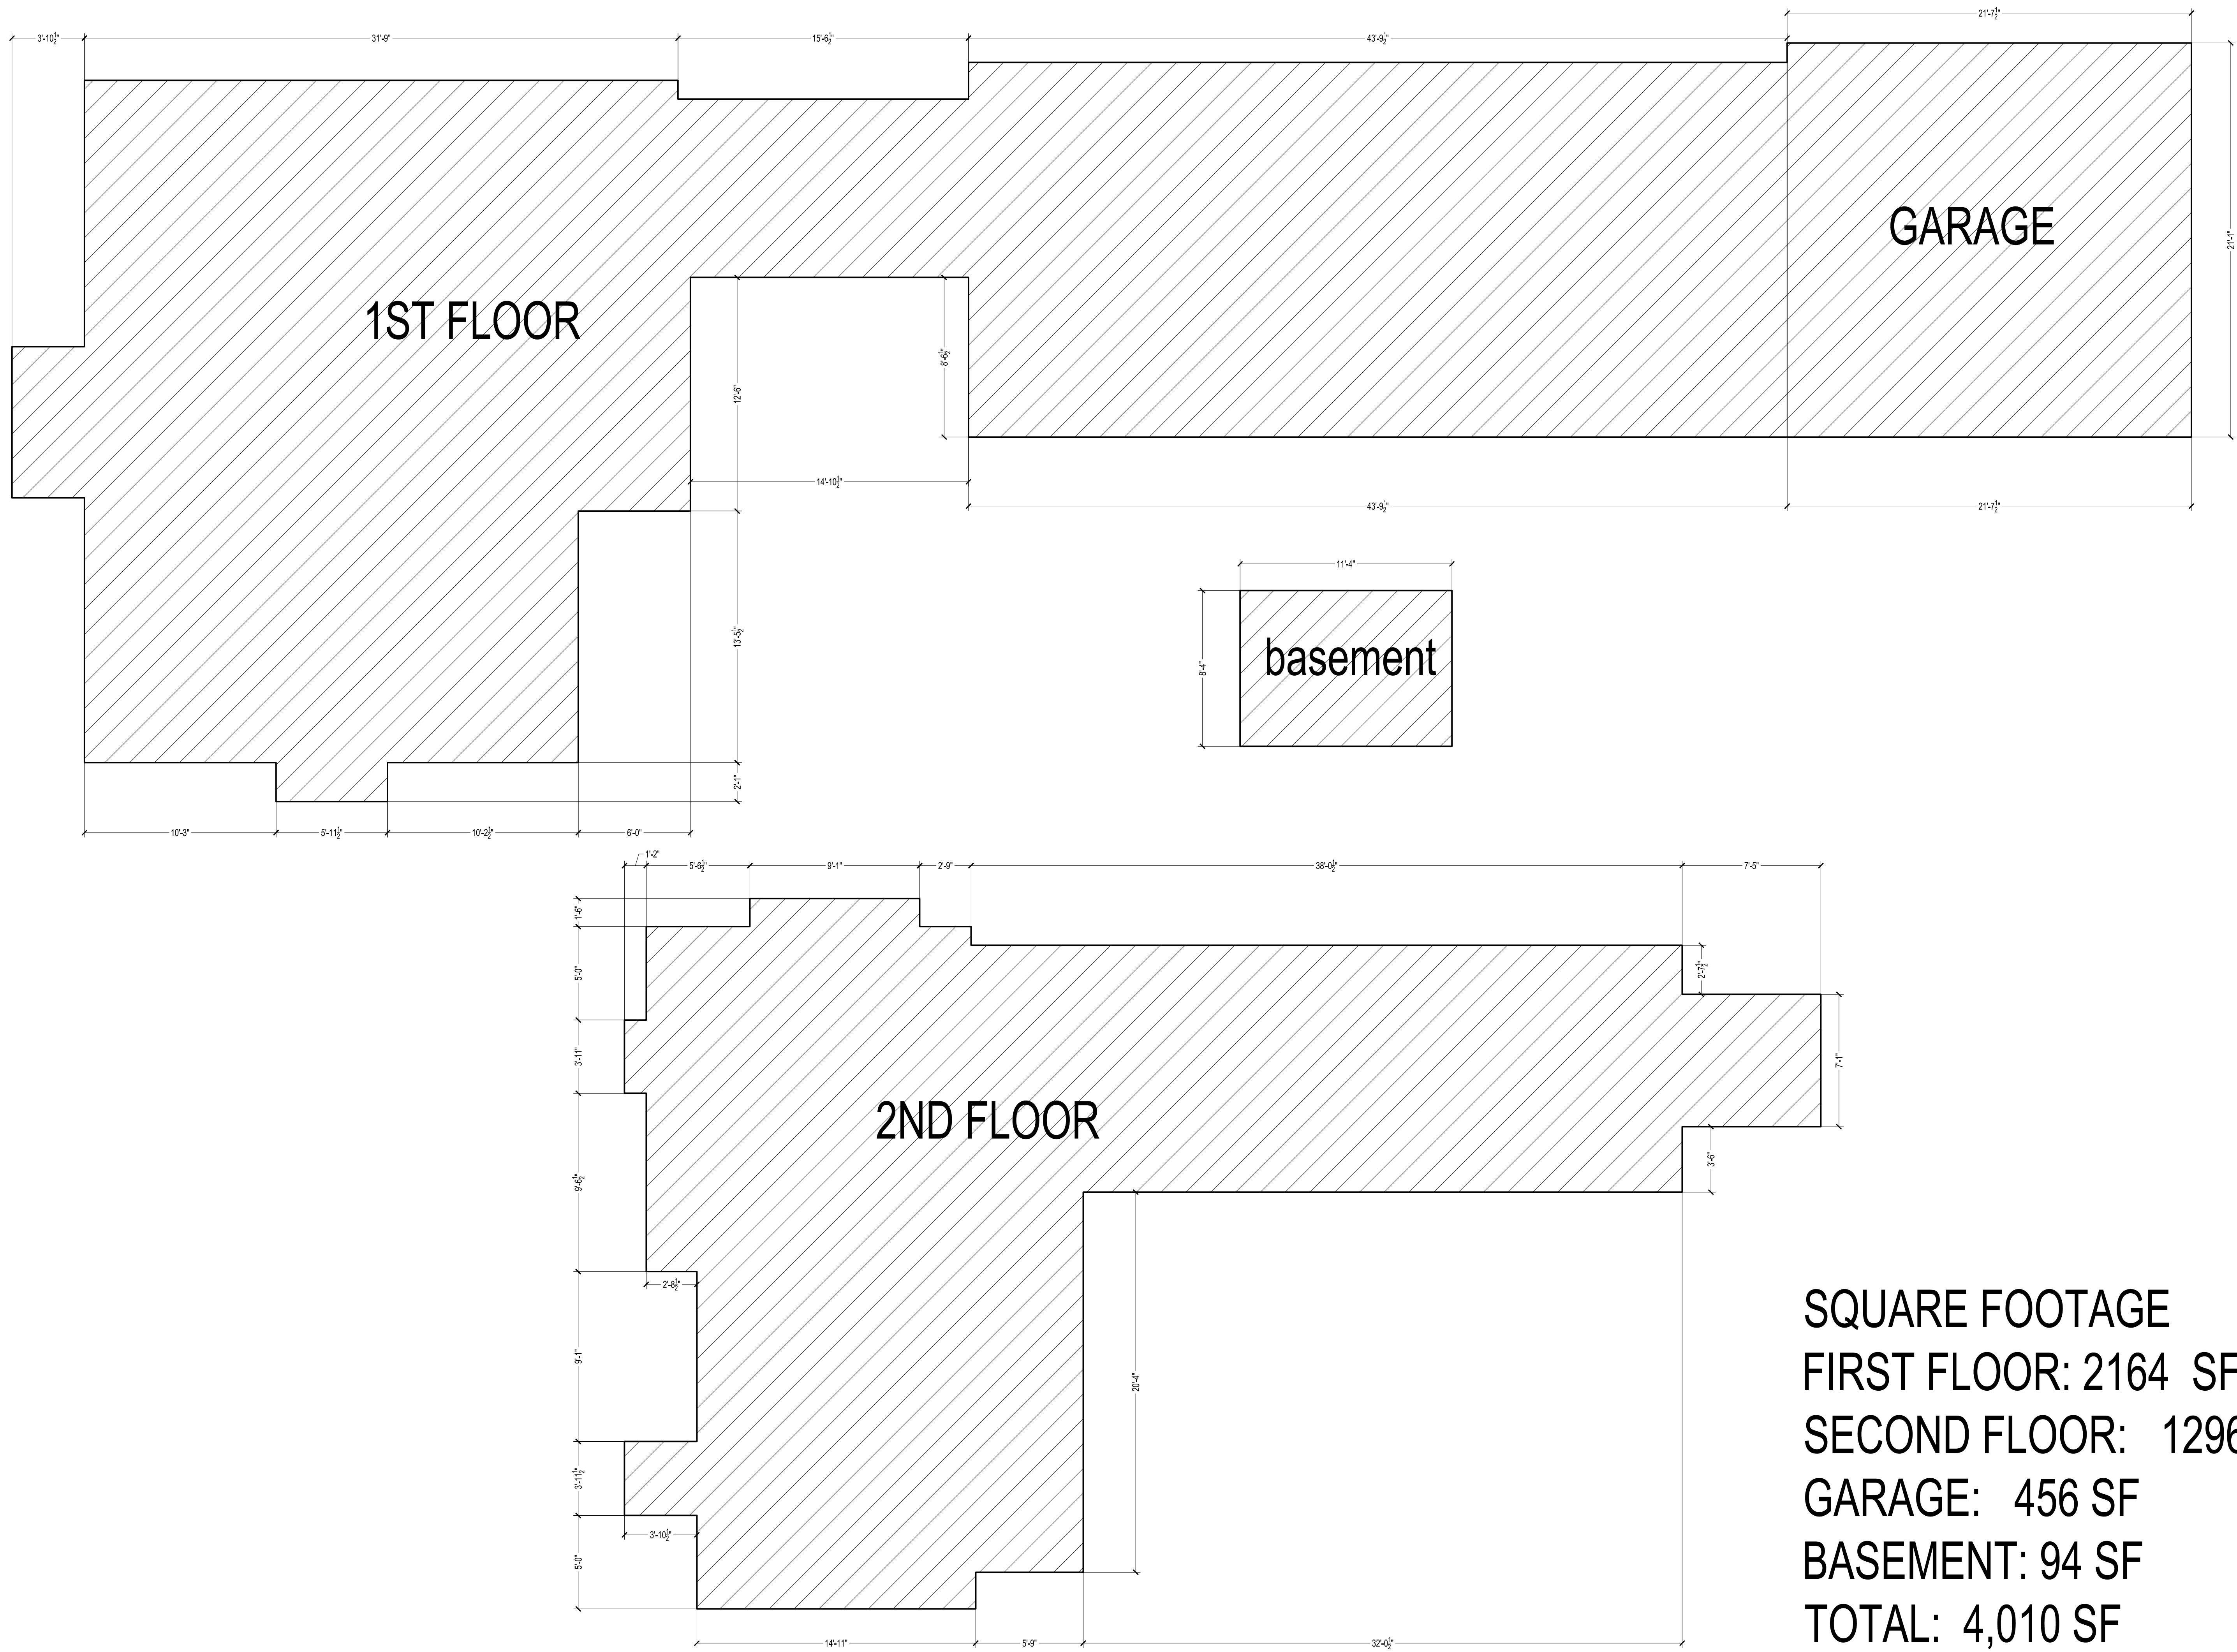

SQUARE FOOTAGE
FIRST FLOOR: 2164 SF
SECOND FLOOR: 1296 SF
GARAGE: 456 SF
BASEMENT: 94 SF
TOTAL: 4,010 SF

REVISIONS	BY
AS-BUILT LOS ANGELES	
Sheet content : SQUARE FOOTAGE CALCULATION	
Project :	242 S CARMELINA AVE LOS ANGELES CA 90049
Owner:	
Date	
Scale	
Drawn	
Job	
Sheet	A-7