

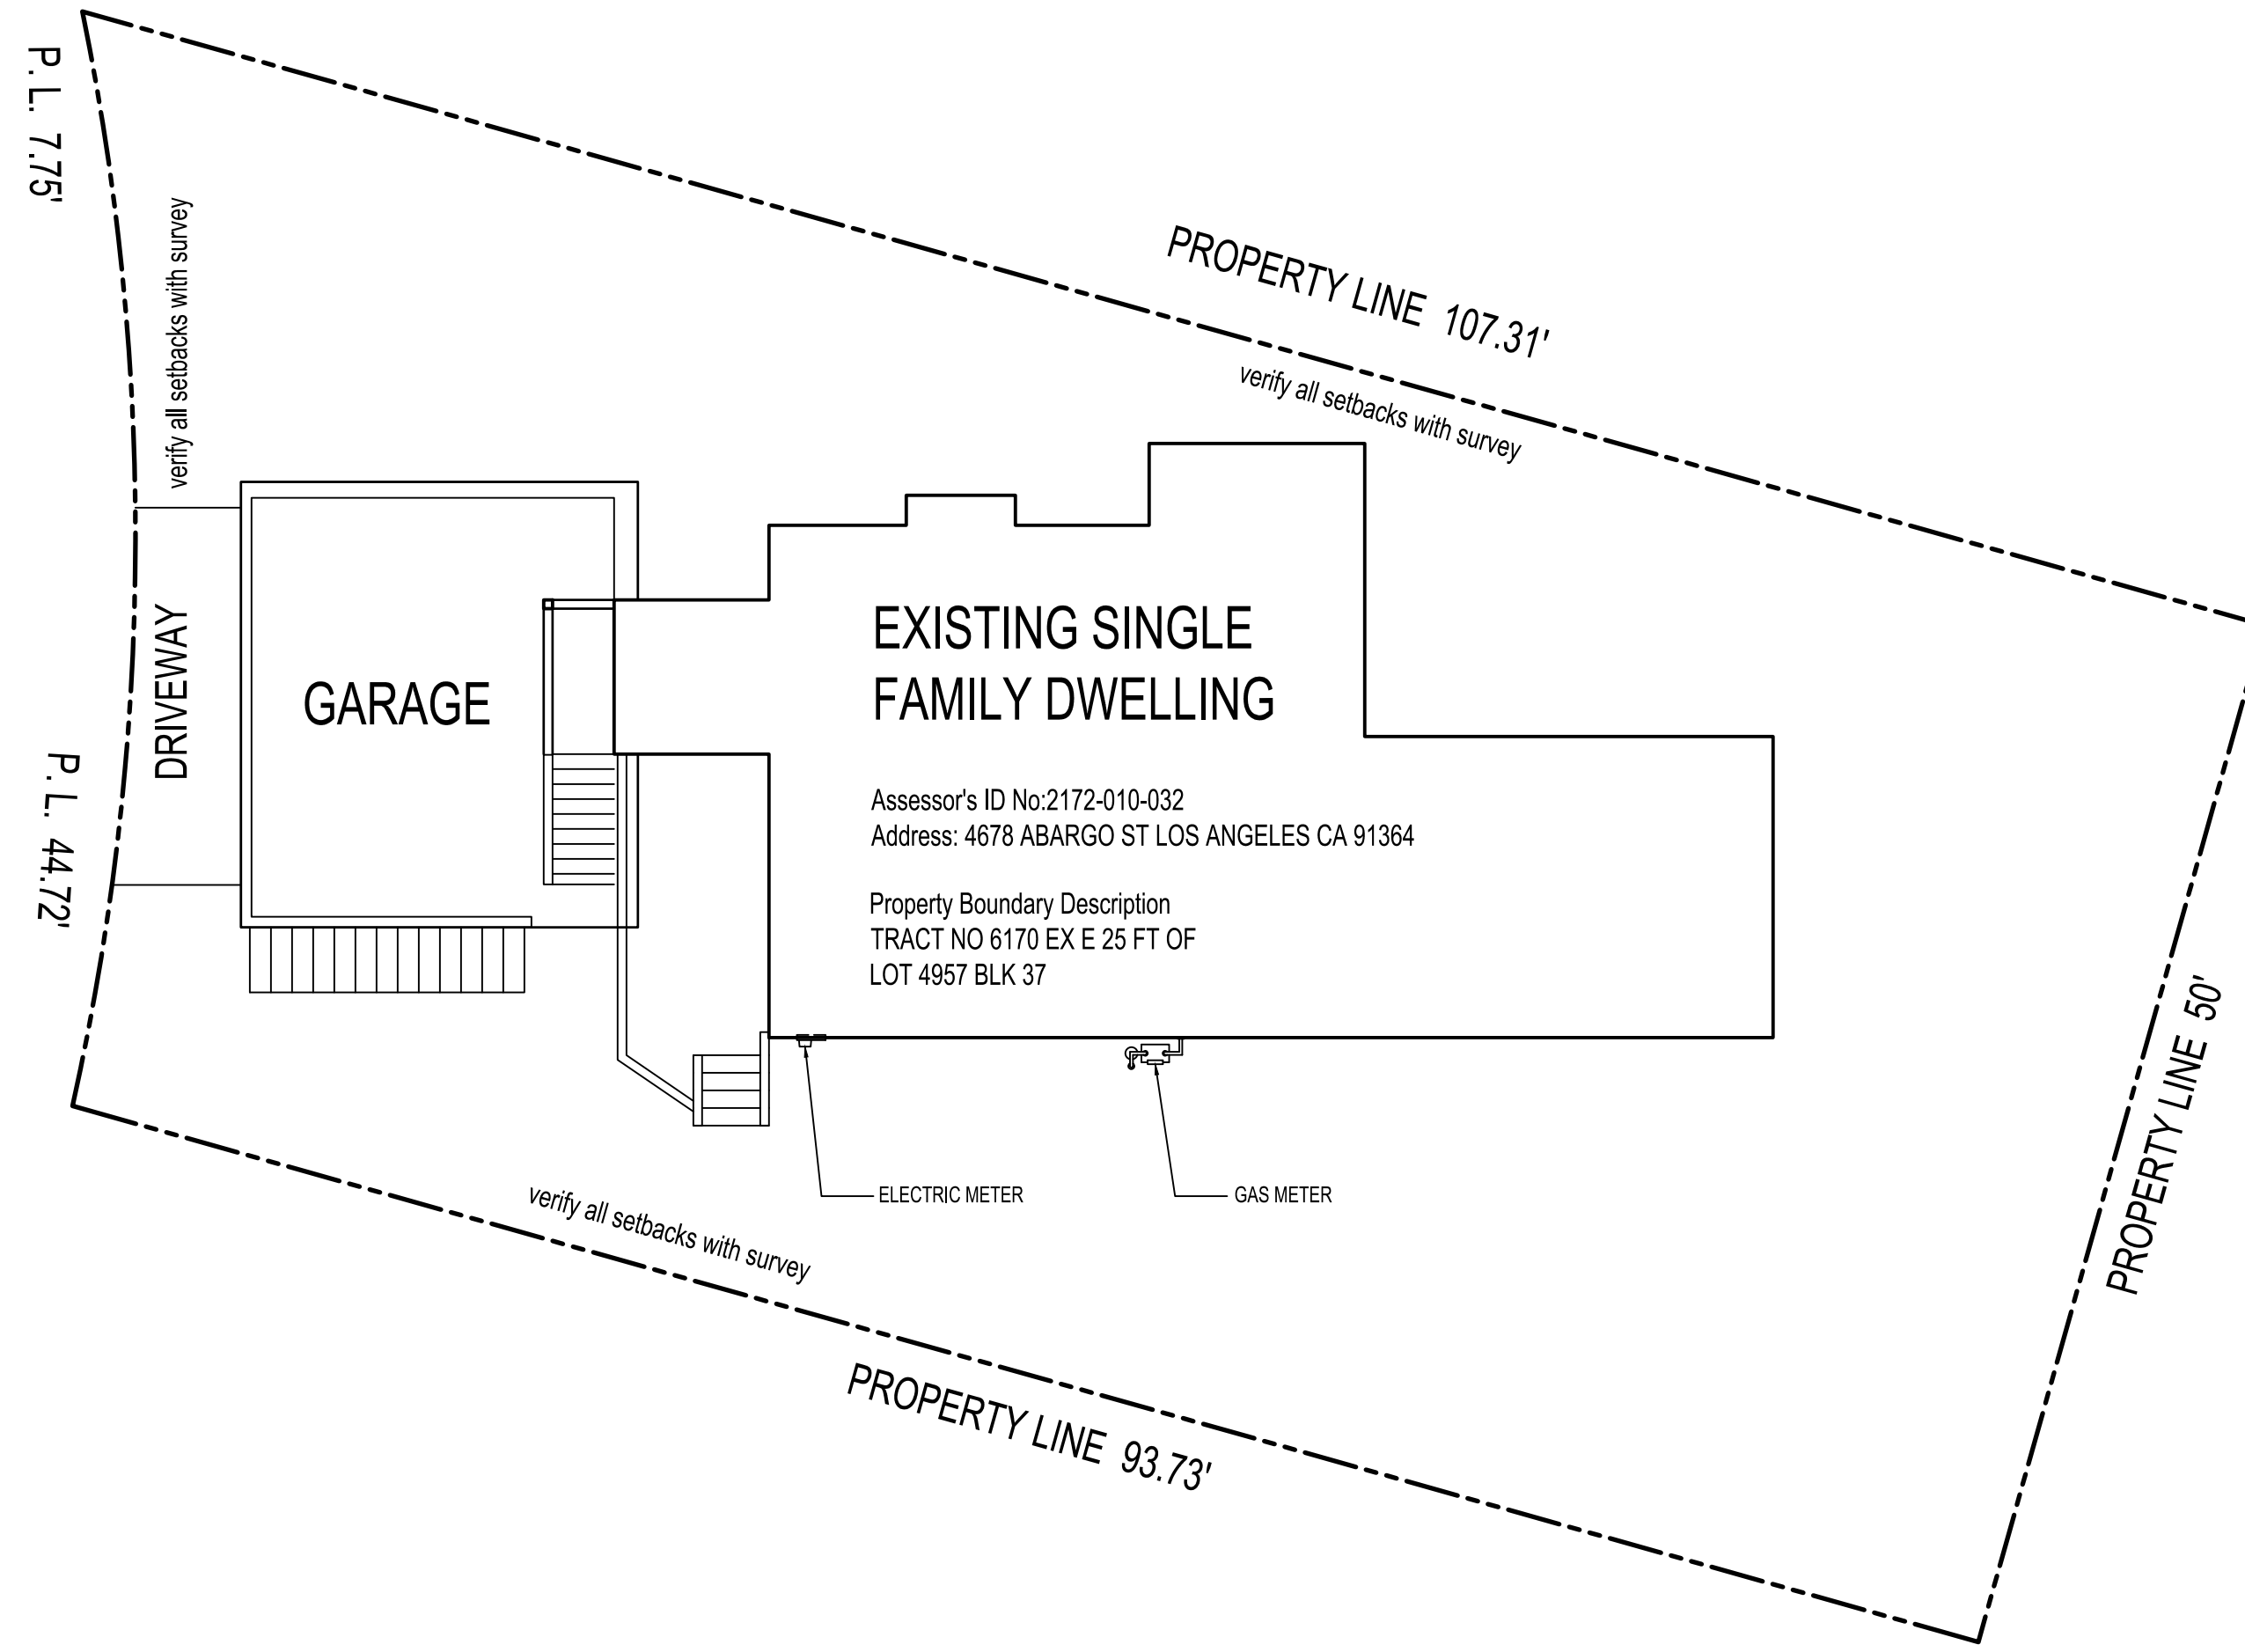


ABARGO ST

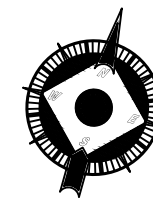

PLOT PLAN

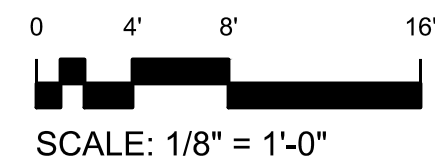

REVISIONS	BY

AS-BUILT
LOS ANGELES

Sheet content :
PLOT PLAN

Project :
4678 ABARGO ST
LOS ANGELES CA 91364

Owner:

Date


Scale

Drawn



Job

Sheet


A-1

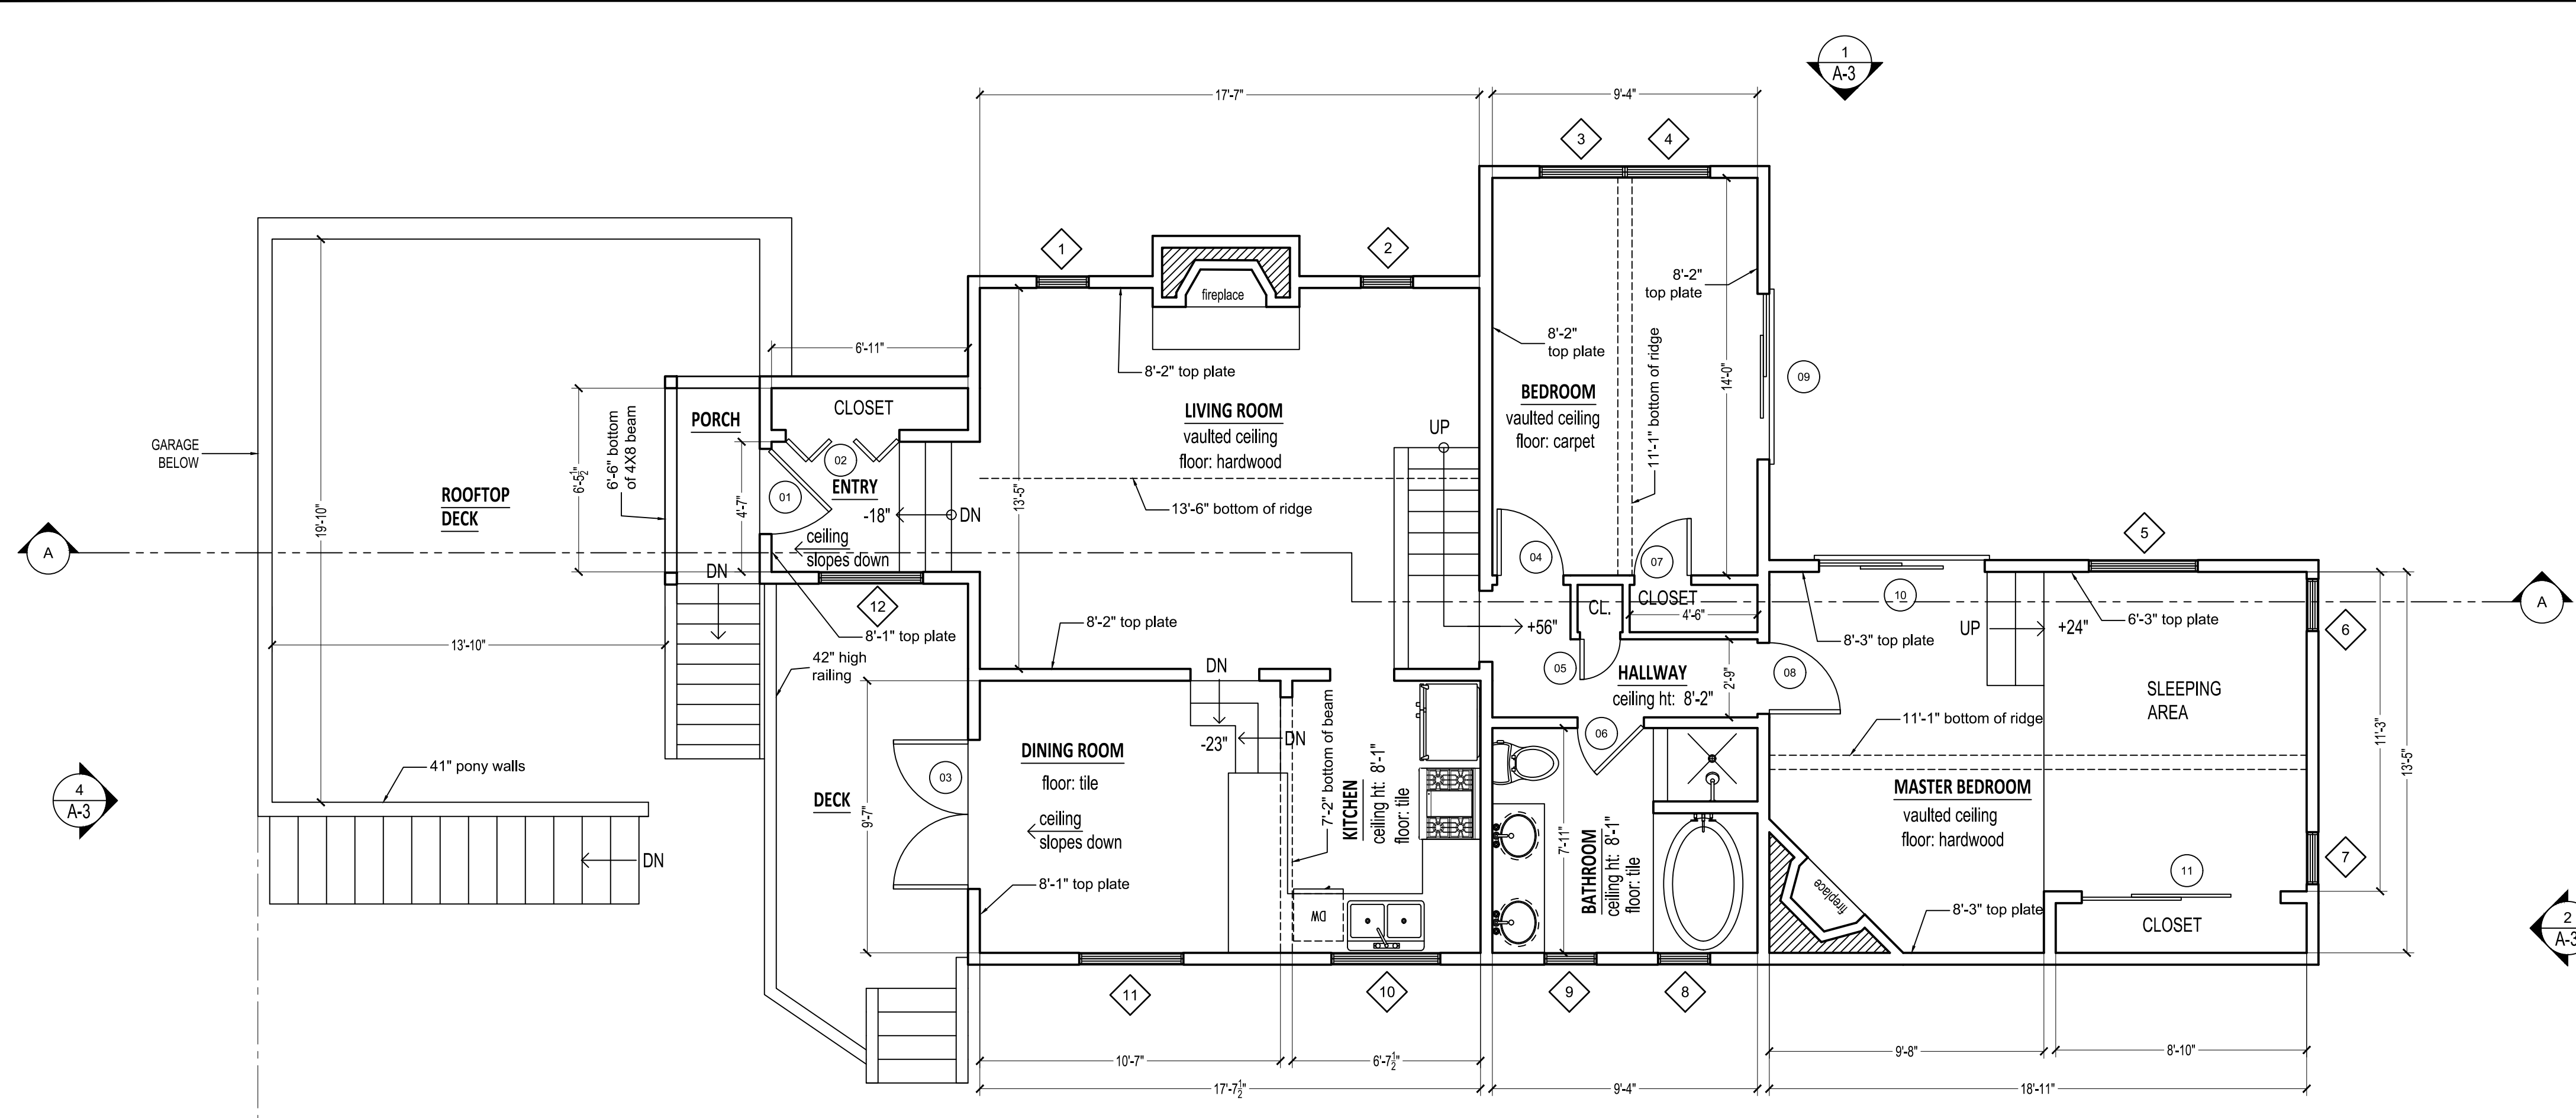

FLOOR PLAN



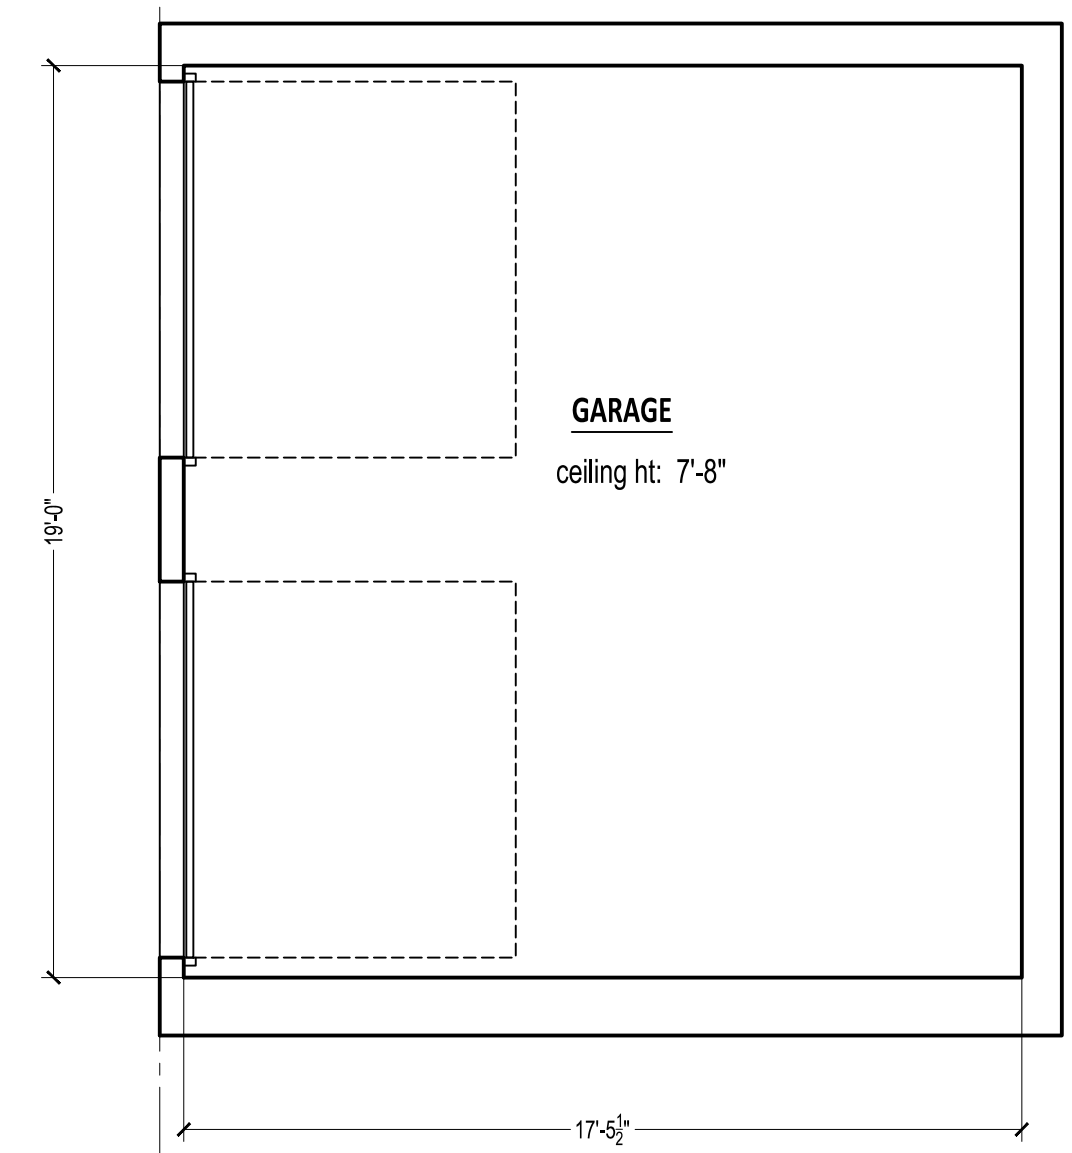
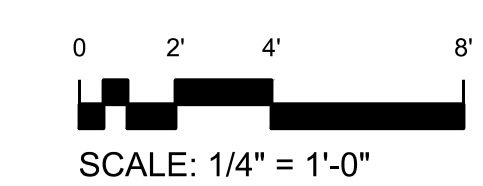


GARAGE FLOOR PLAN

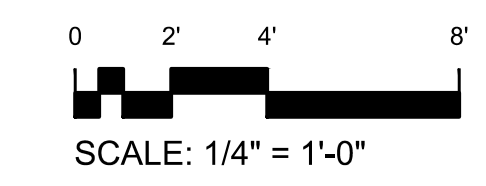

DOOR SCHEDULE				
MARK	DOOR SIZE		Type	NOTES
	WD	HGT		
1	3'-0"	6'-8"	SWING	--
2	4'-0"	6'-8"	BI-FOLD DOUBLE	--
3	5'-3"	6'-8"	FRENCH DOUBLE	--
4	2'-4"	6'-8"	SWING	--
5	1'-5"	6'-8"	SWING	--
6	2'-4"	6'-8"	SWING	--
7	2'-0"	6'-8"	SWING	--
8	2'-6"	6'-8"	SWING	--
9	5'-10"	6'-8"	SLIDING DOUBLE	--
10	5'-10"	6'-8"	SLIDING DOUBLE	--
11	7'-0"	6'-8"	SLIDING - DOUBLE	--

WINDOW SCHEDULE					
MARK	SIZE		TYPE	Head Height	NOTES
	Width	HEIGHT			
1	1'-10"	3'-10"	SINGLE HUNG	6'-8"	--
2	1'-10"	3'-10"	SINGLE HUNG	6'-8"	--
3	3'-0"	4'-0"	SINGLE HUNG	6'-8"	--
4	3'-0"	4'-0"	SINGLE HUNG	6'-8"	--
5	3'-10"	3'-11"	SINGLE HUNG	6'-8"	--
6	1'-10"	3'-11"	SINGLE HUNG	6'-8"	--
7	1'-10"	3'-11"	SINGLE HUNG	6'-8"	--
8	1'-10"	2'-10"	SINGLE HUNG	6'-8"	--
9	1'-10"	2'-10"	SINGLE HUNG	6'-8"	--
10	3'-10"	3'-11"	SINGLE HUNG	6'-8"	--
11	3'-8"	3'-9"	SINGLE HUNG	6'-8"	--
12	3'-8"	3'-9"	SINGLE HUNG	6'-8"	--

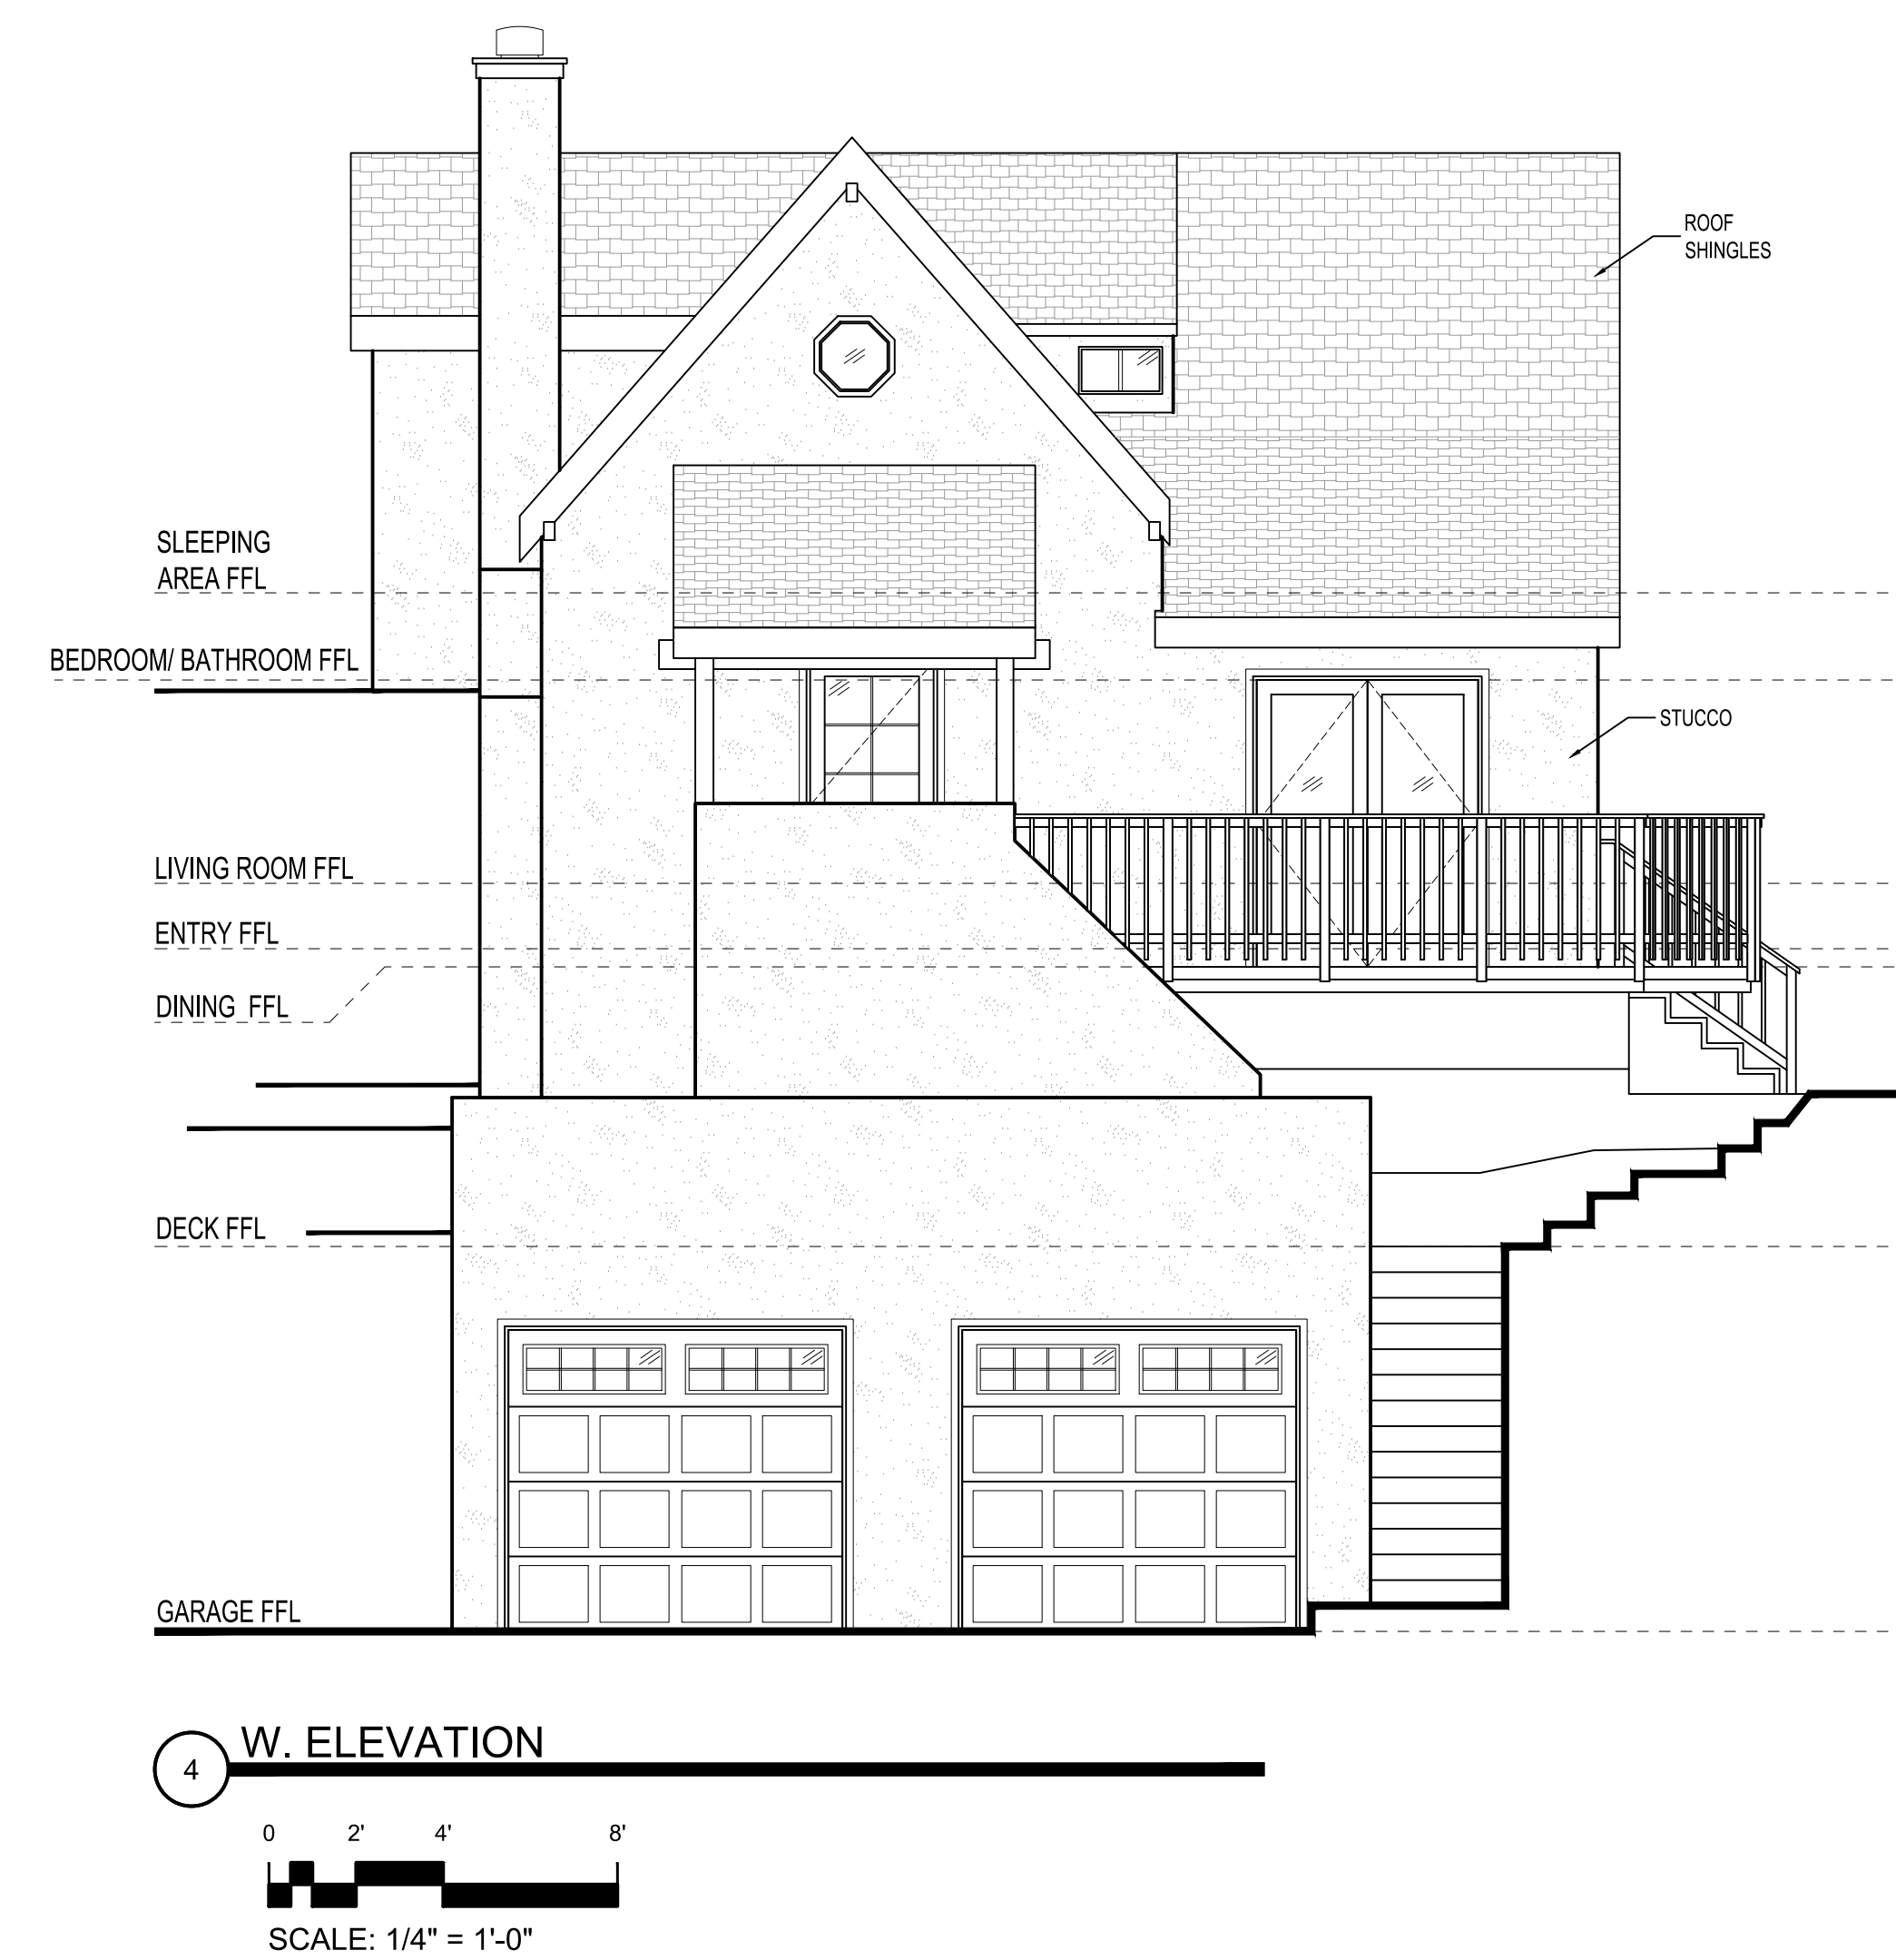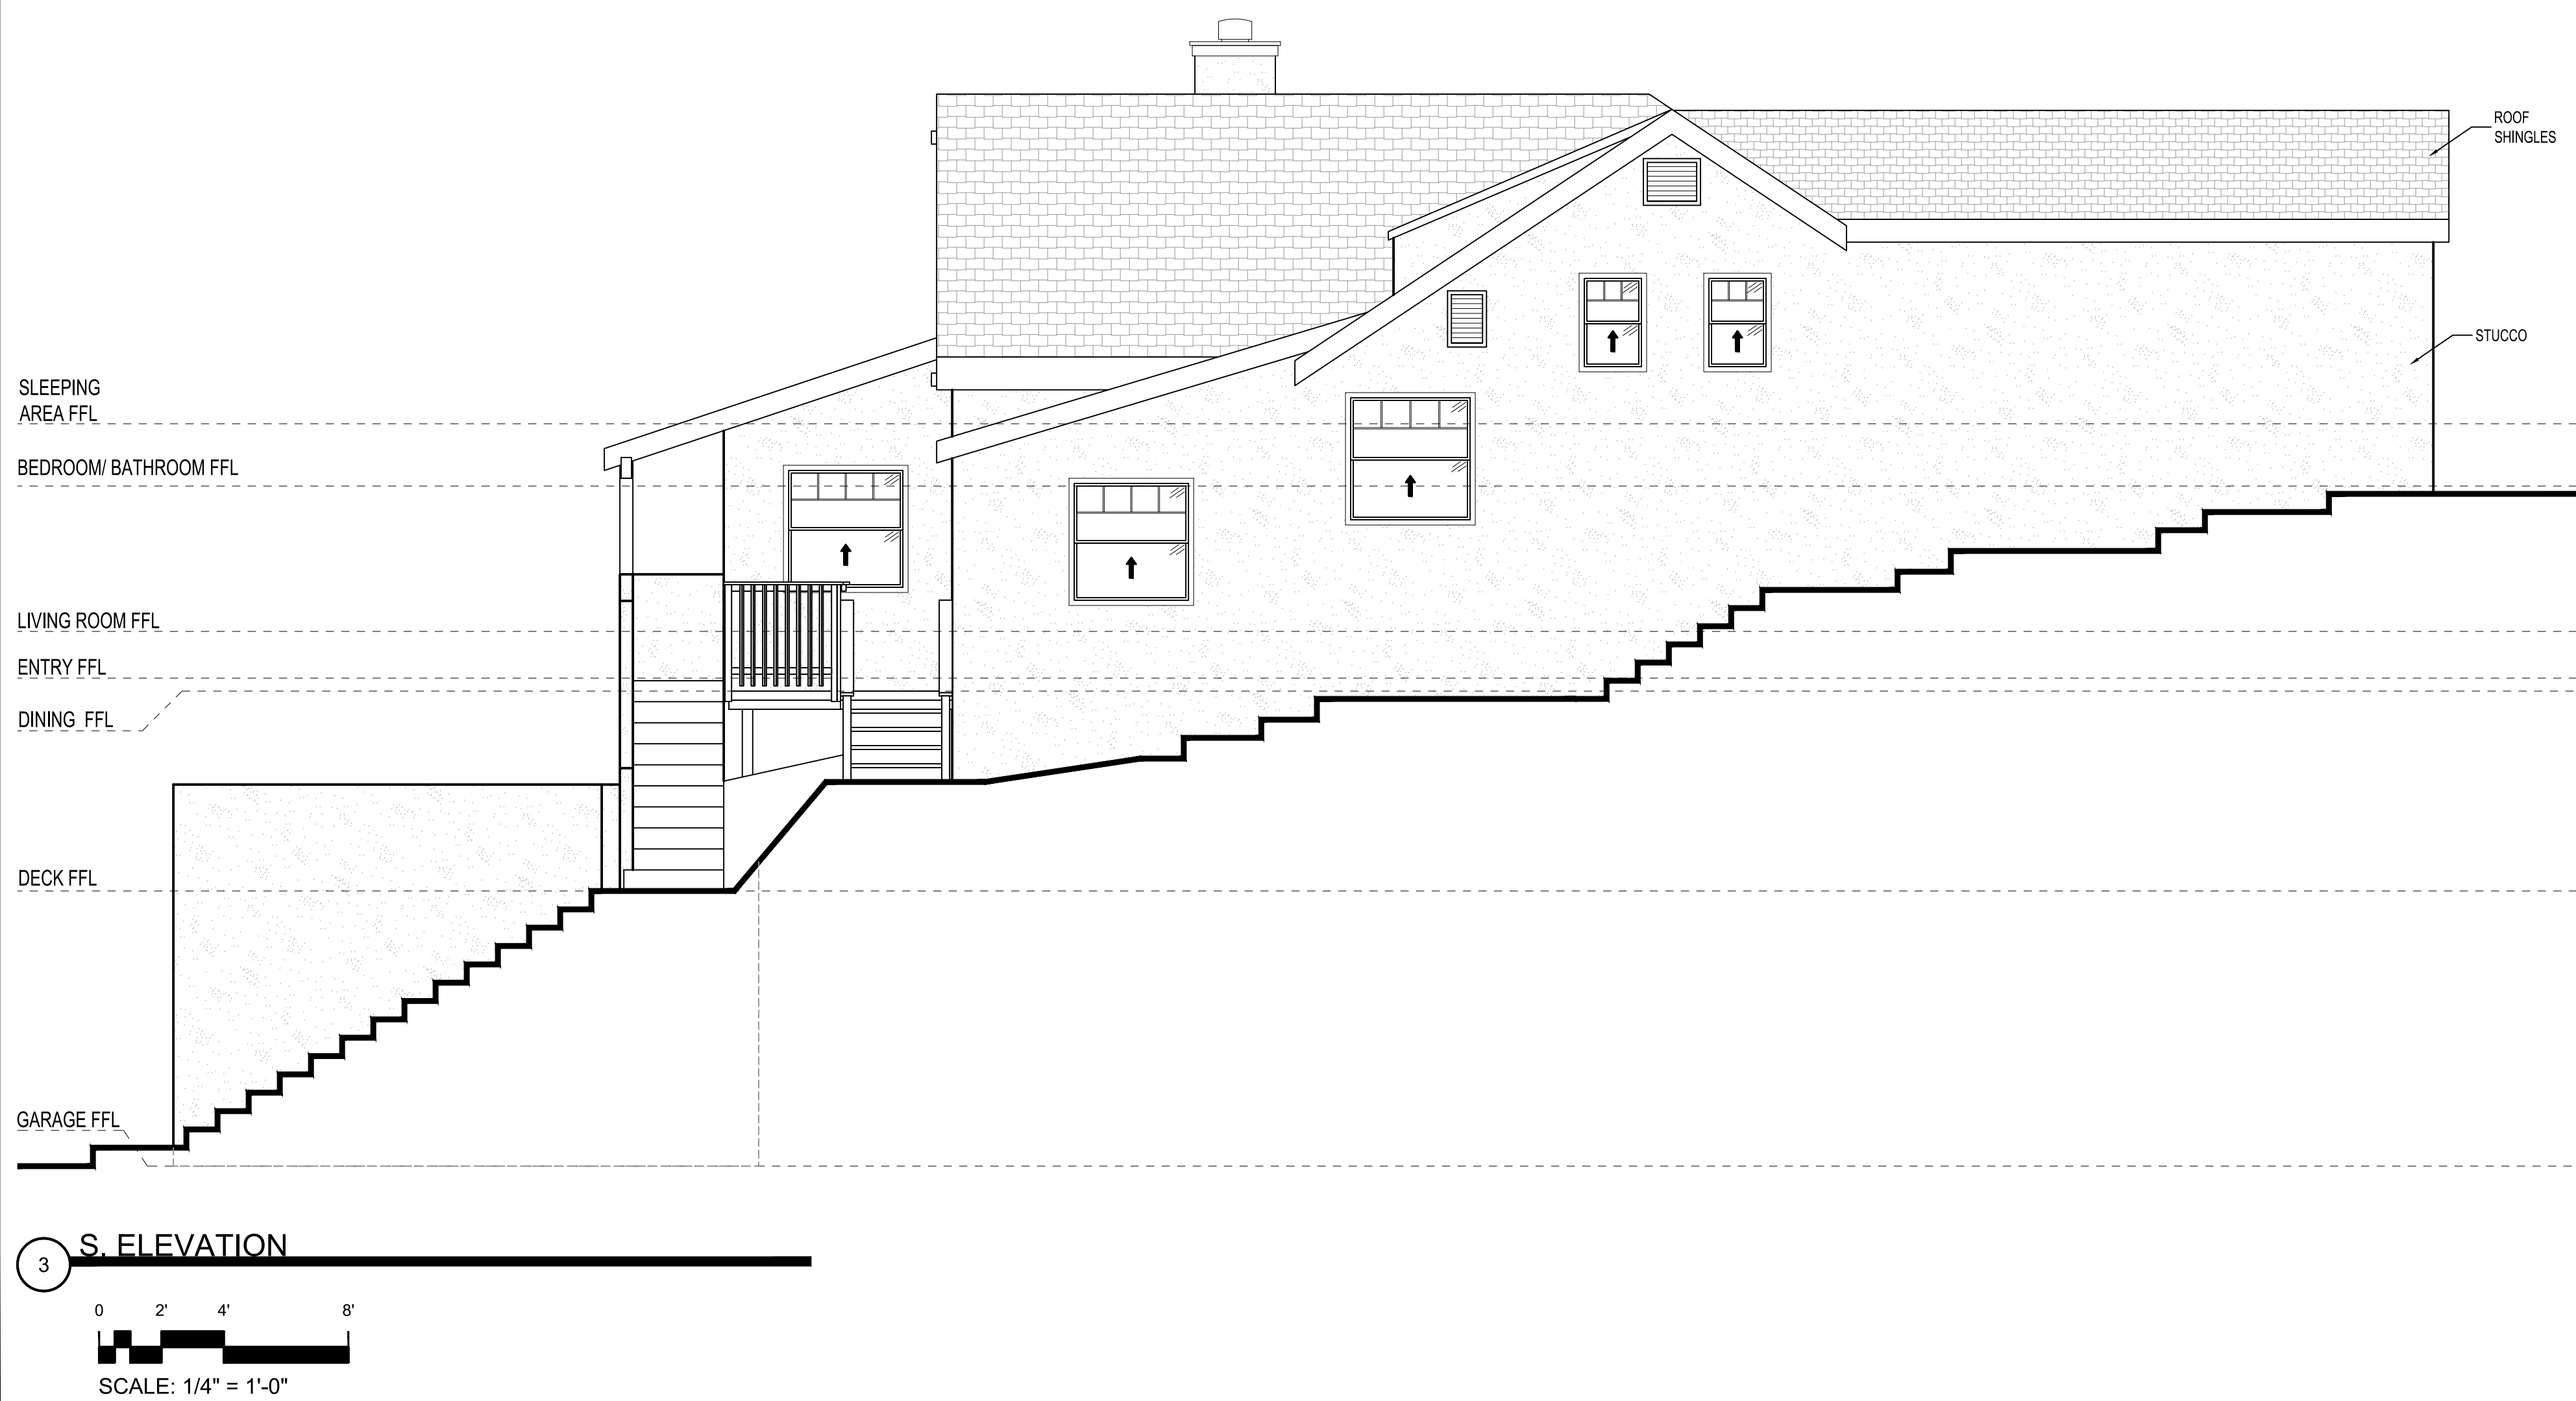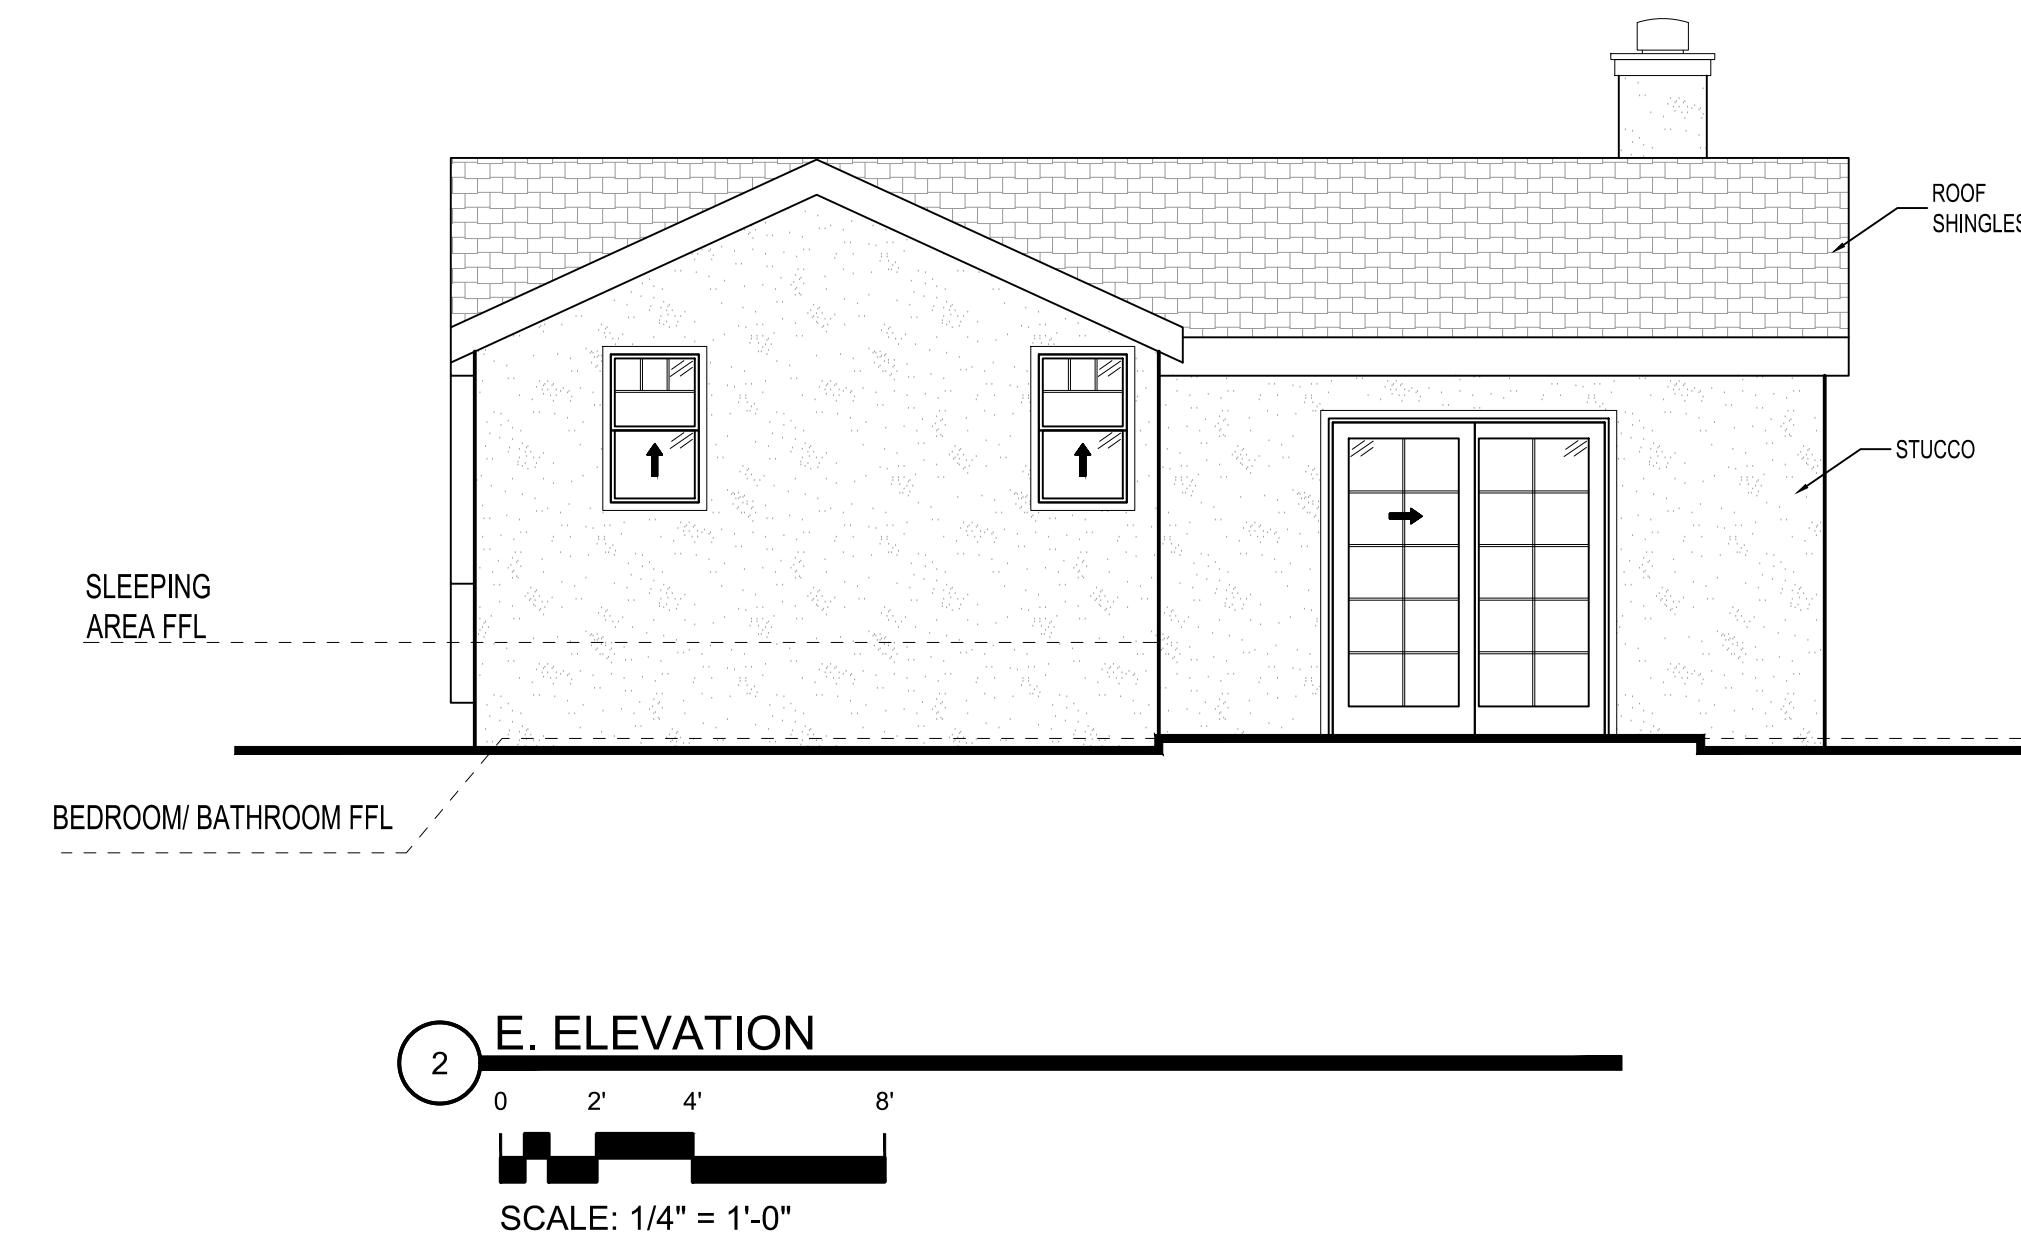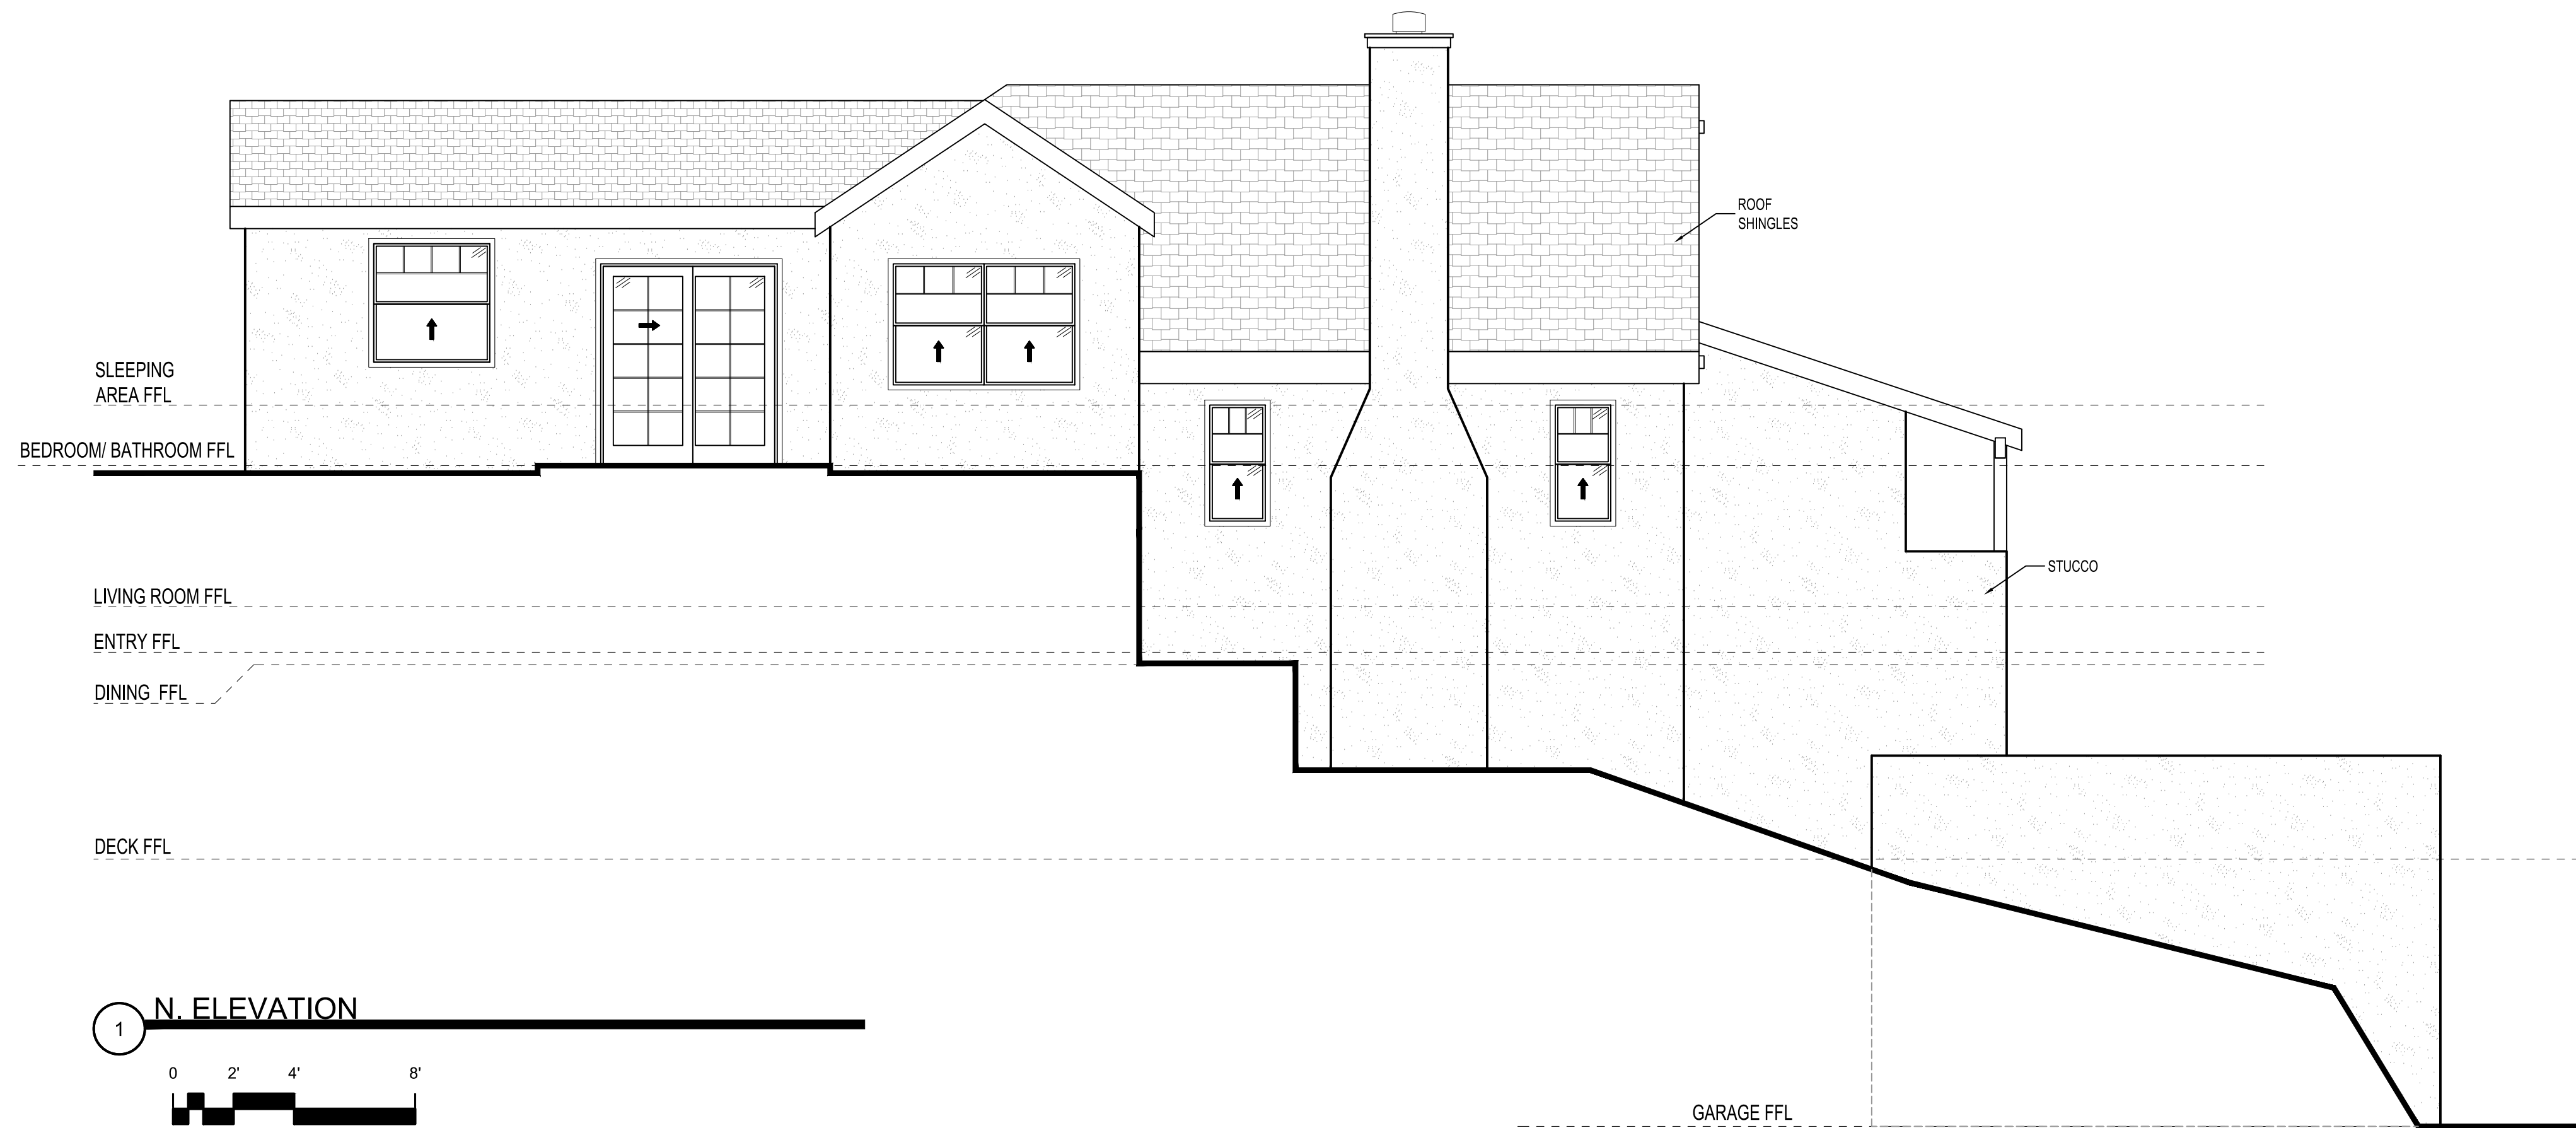

REVISIONS	BY

AS-BUILT
LOS ANGELES

Sheet content:
ROOF PLAN
SECTION

Project:
4678 ABARGO ST
LOS ANGELES CA 91364

Owner:

Date

Scale


Drawn

Job



Sheet

A-4


08.06.13


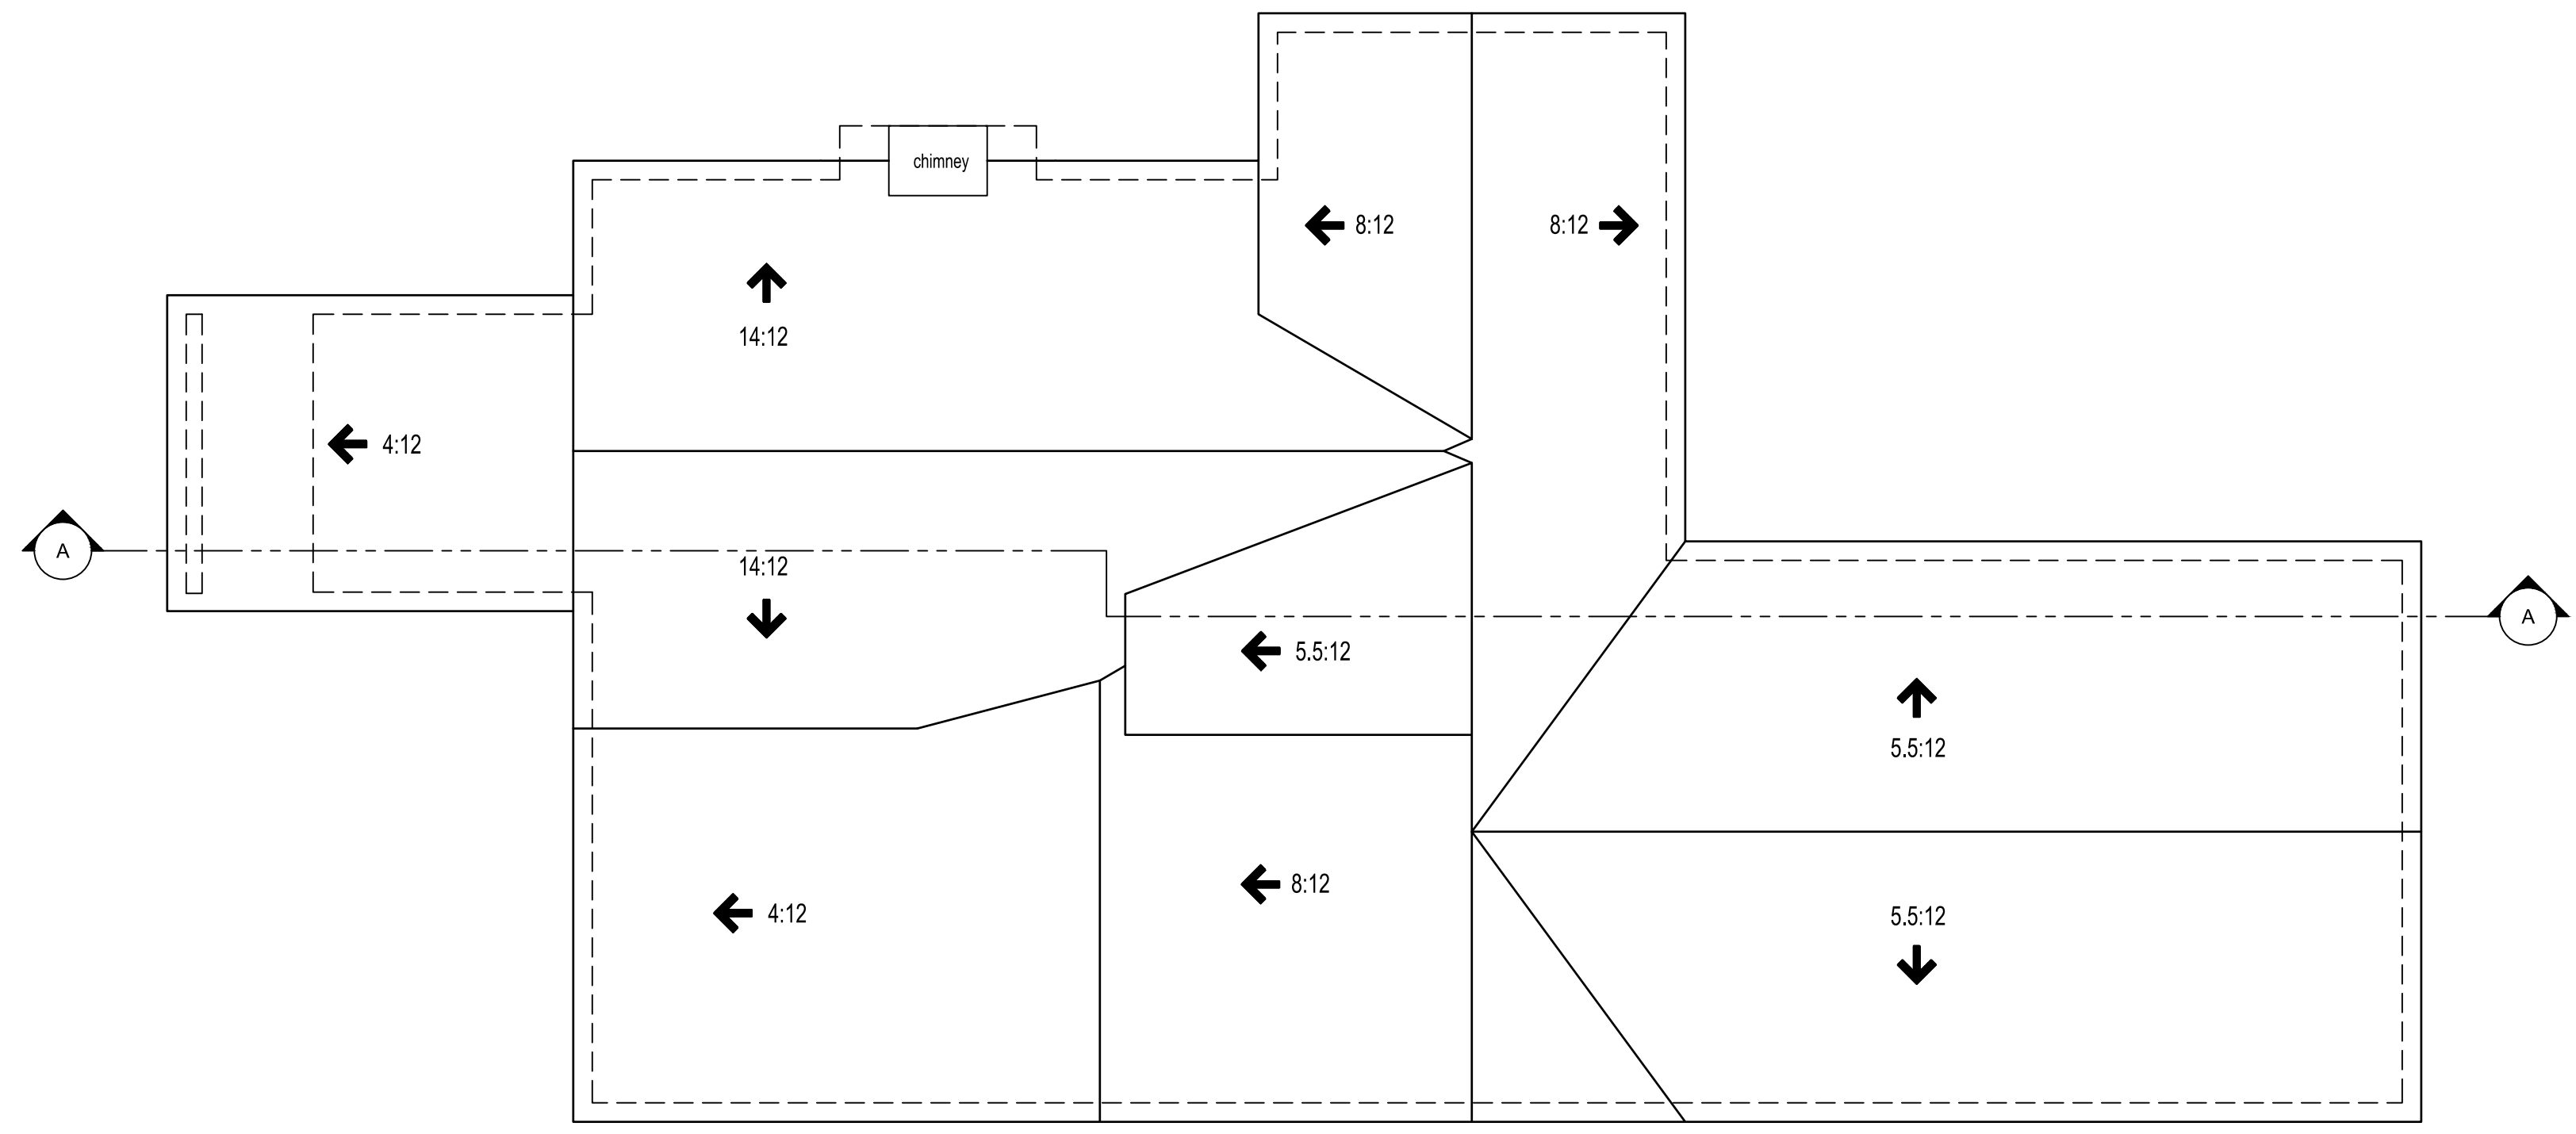


ROOF PLAN

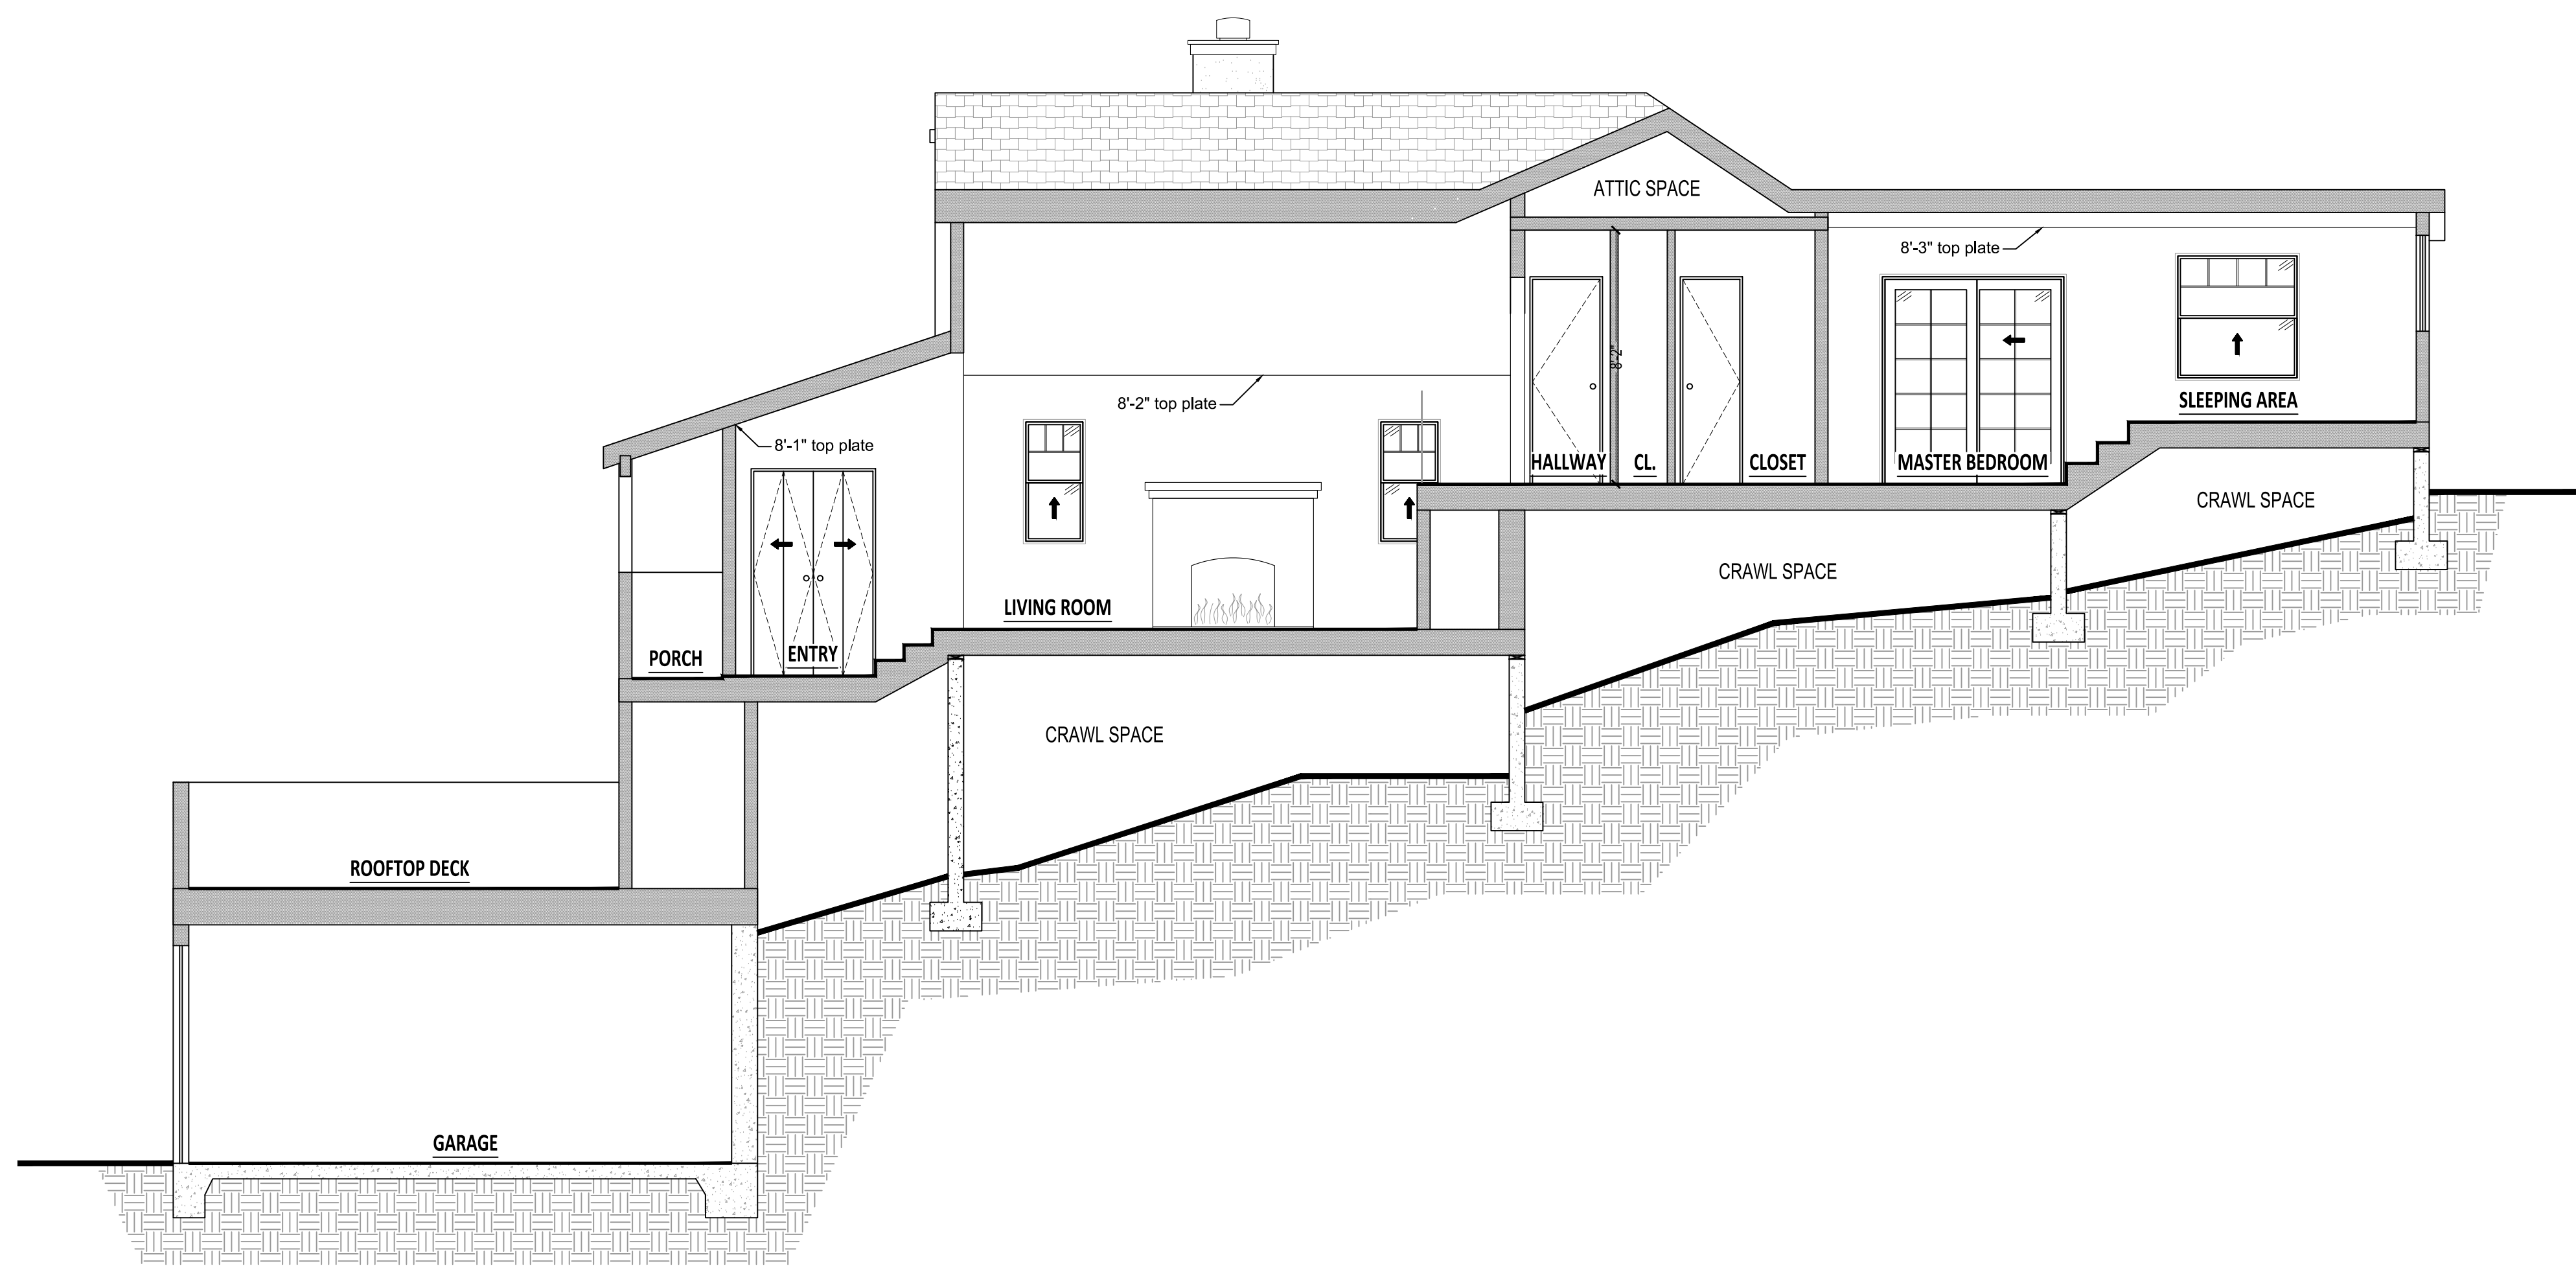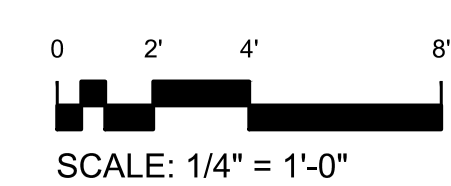

SECTION A-A

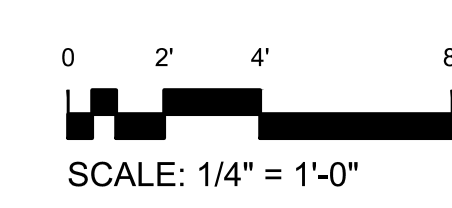

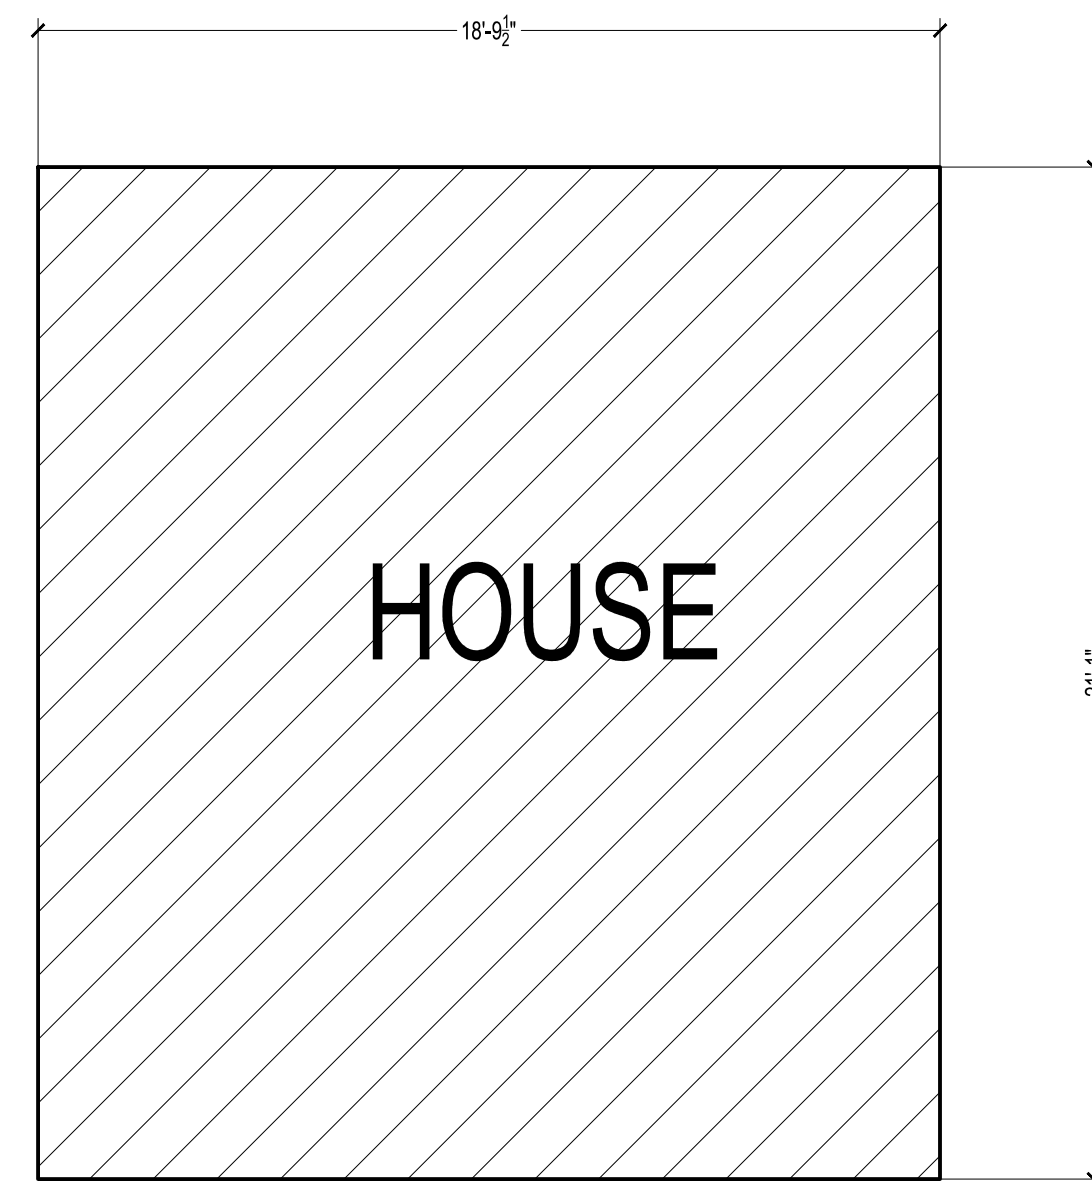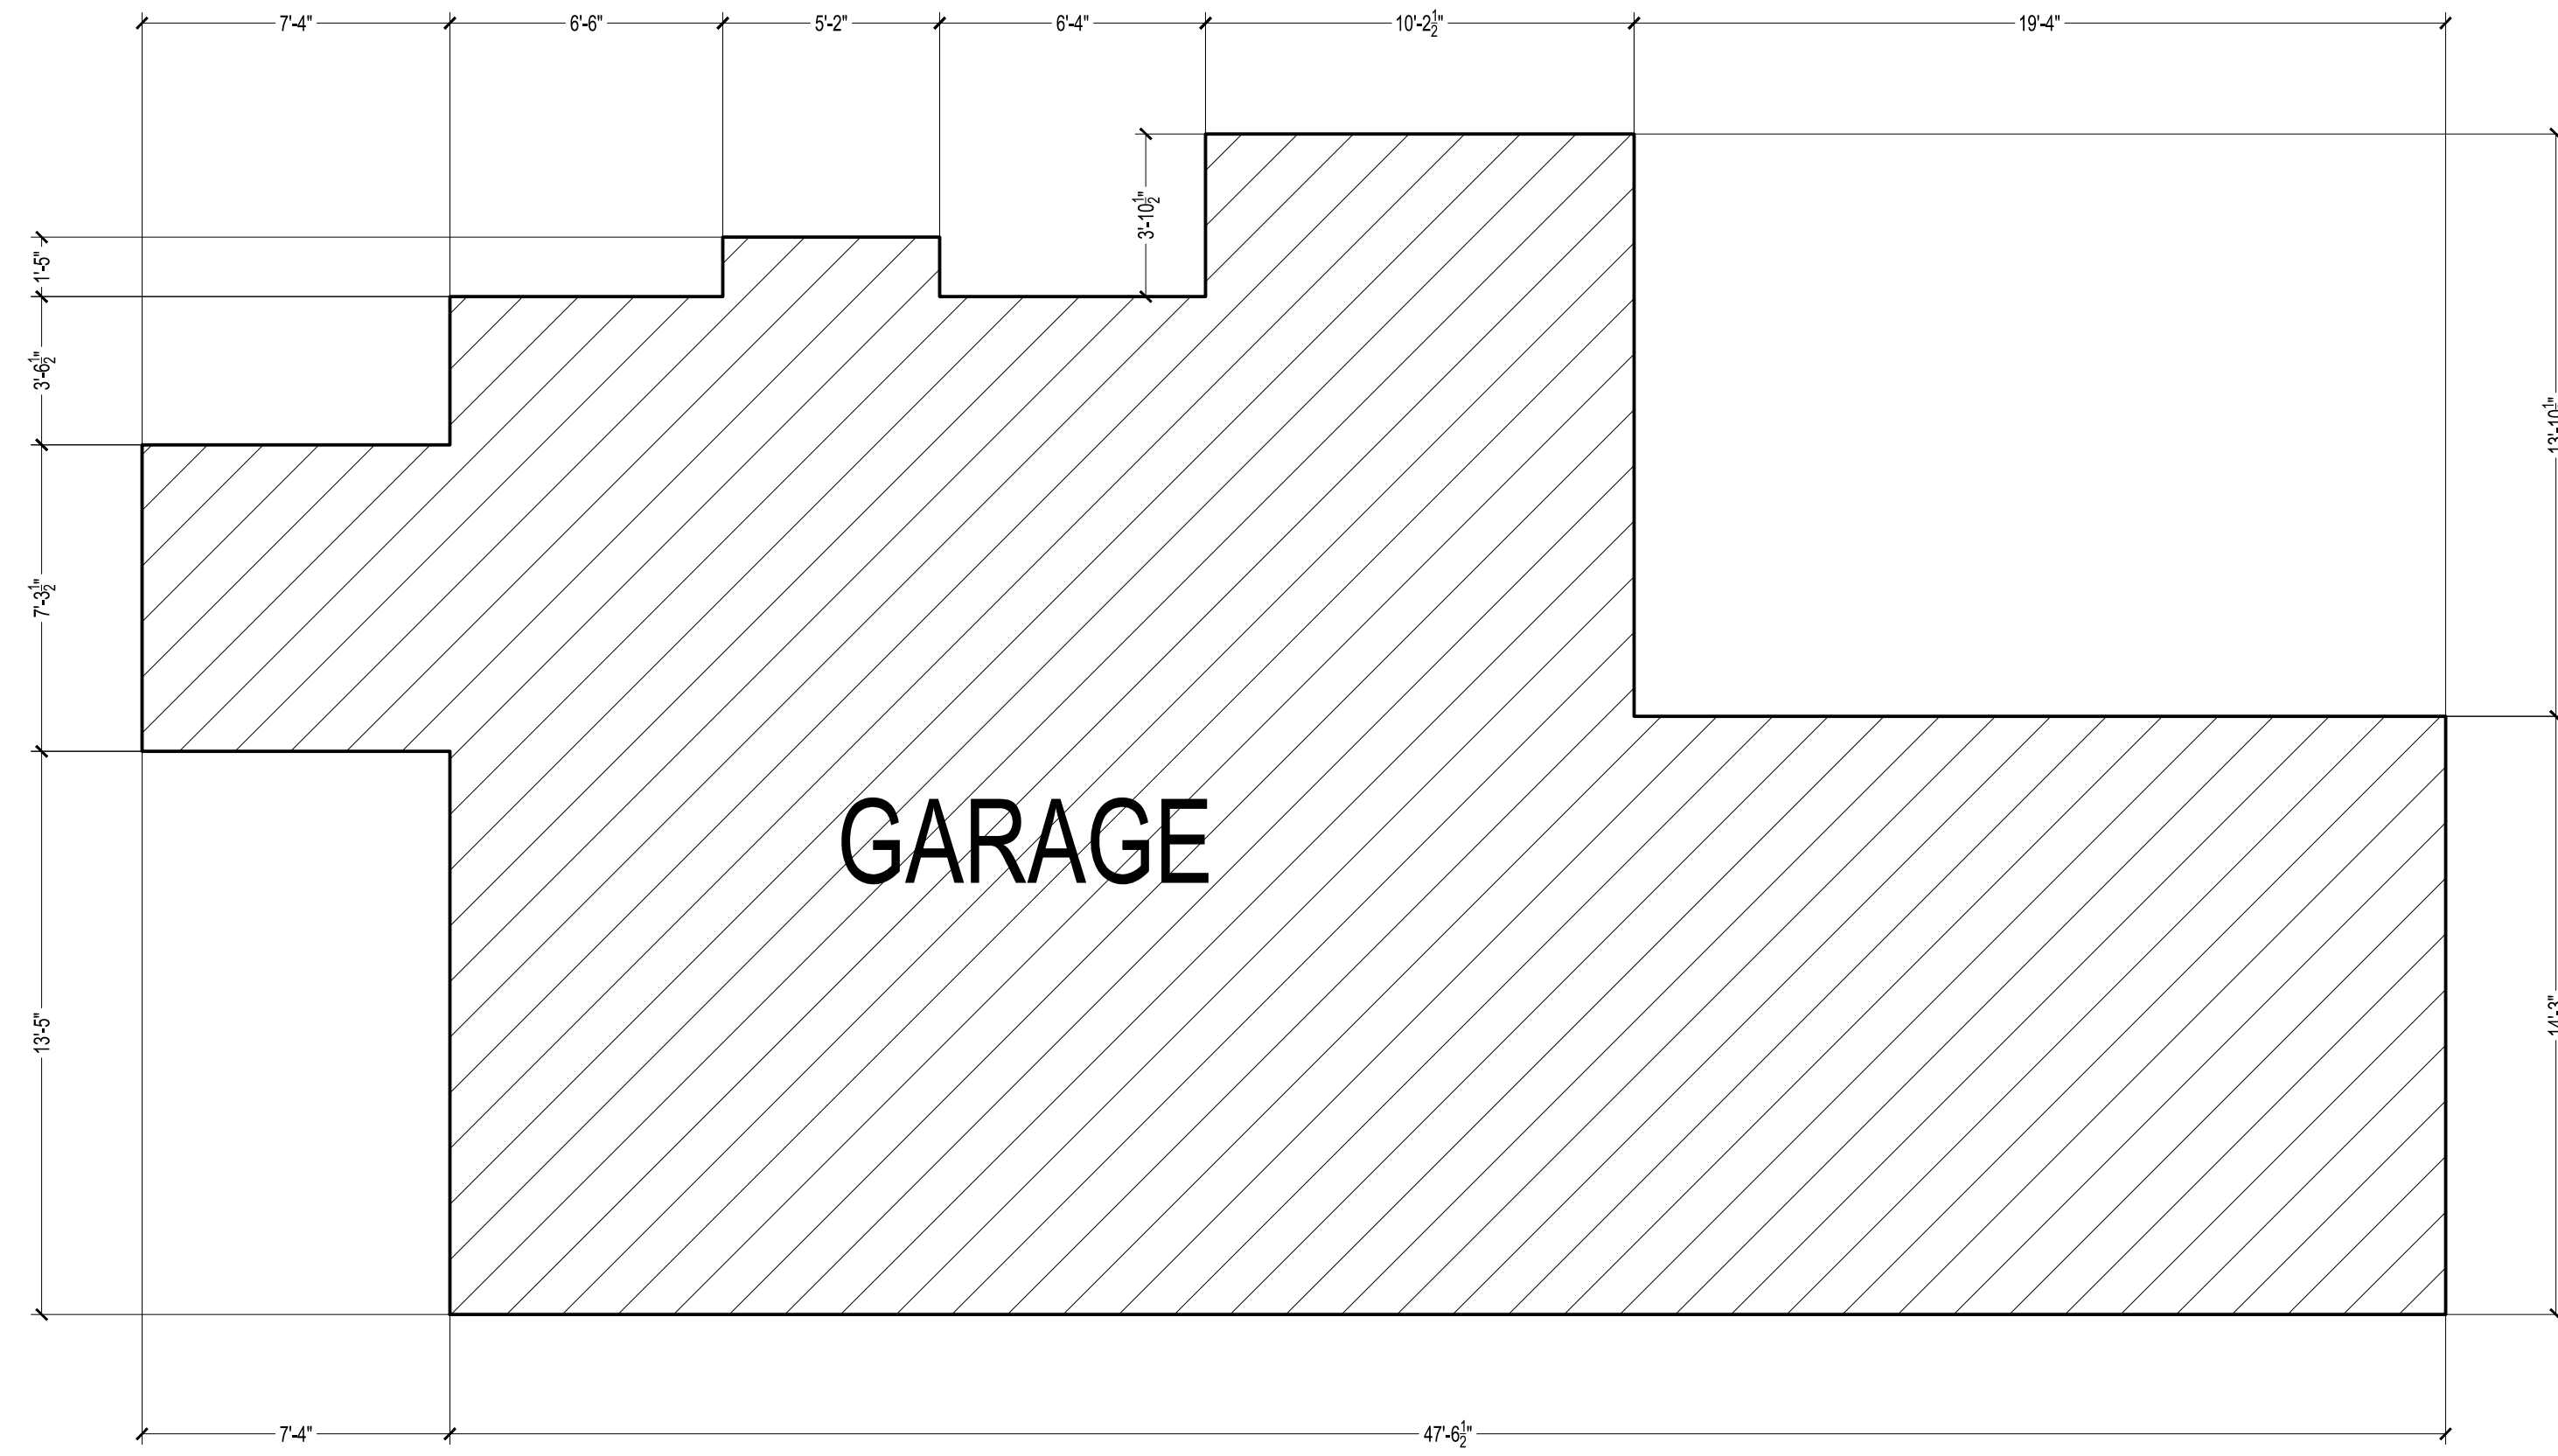

SQUARE FOOTAGE
 HOUSE: 1060 SF
 GARAGE: 396 SF
 TOTAL: 1,456 SF

REVISIONS	BY
AS-BUILT LOS ANGELES	
Sheet content : SQUARE FOOTAGE CALCULATION	
Project : 4678 ABARGO ST LOS ANGELES CA 91364	
Owner:	
Date	
Scale	
Drawn	
Job	
Sheet	
A-5	