


# ABBOT KINNEY

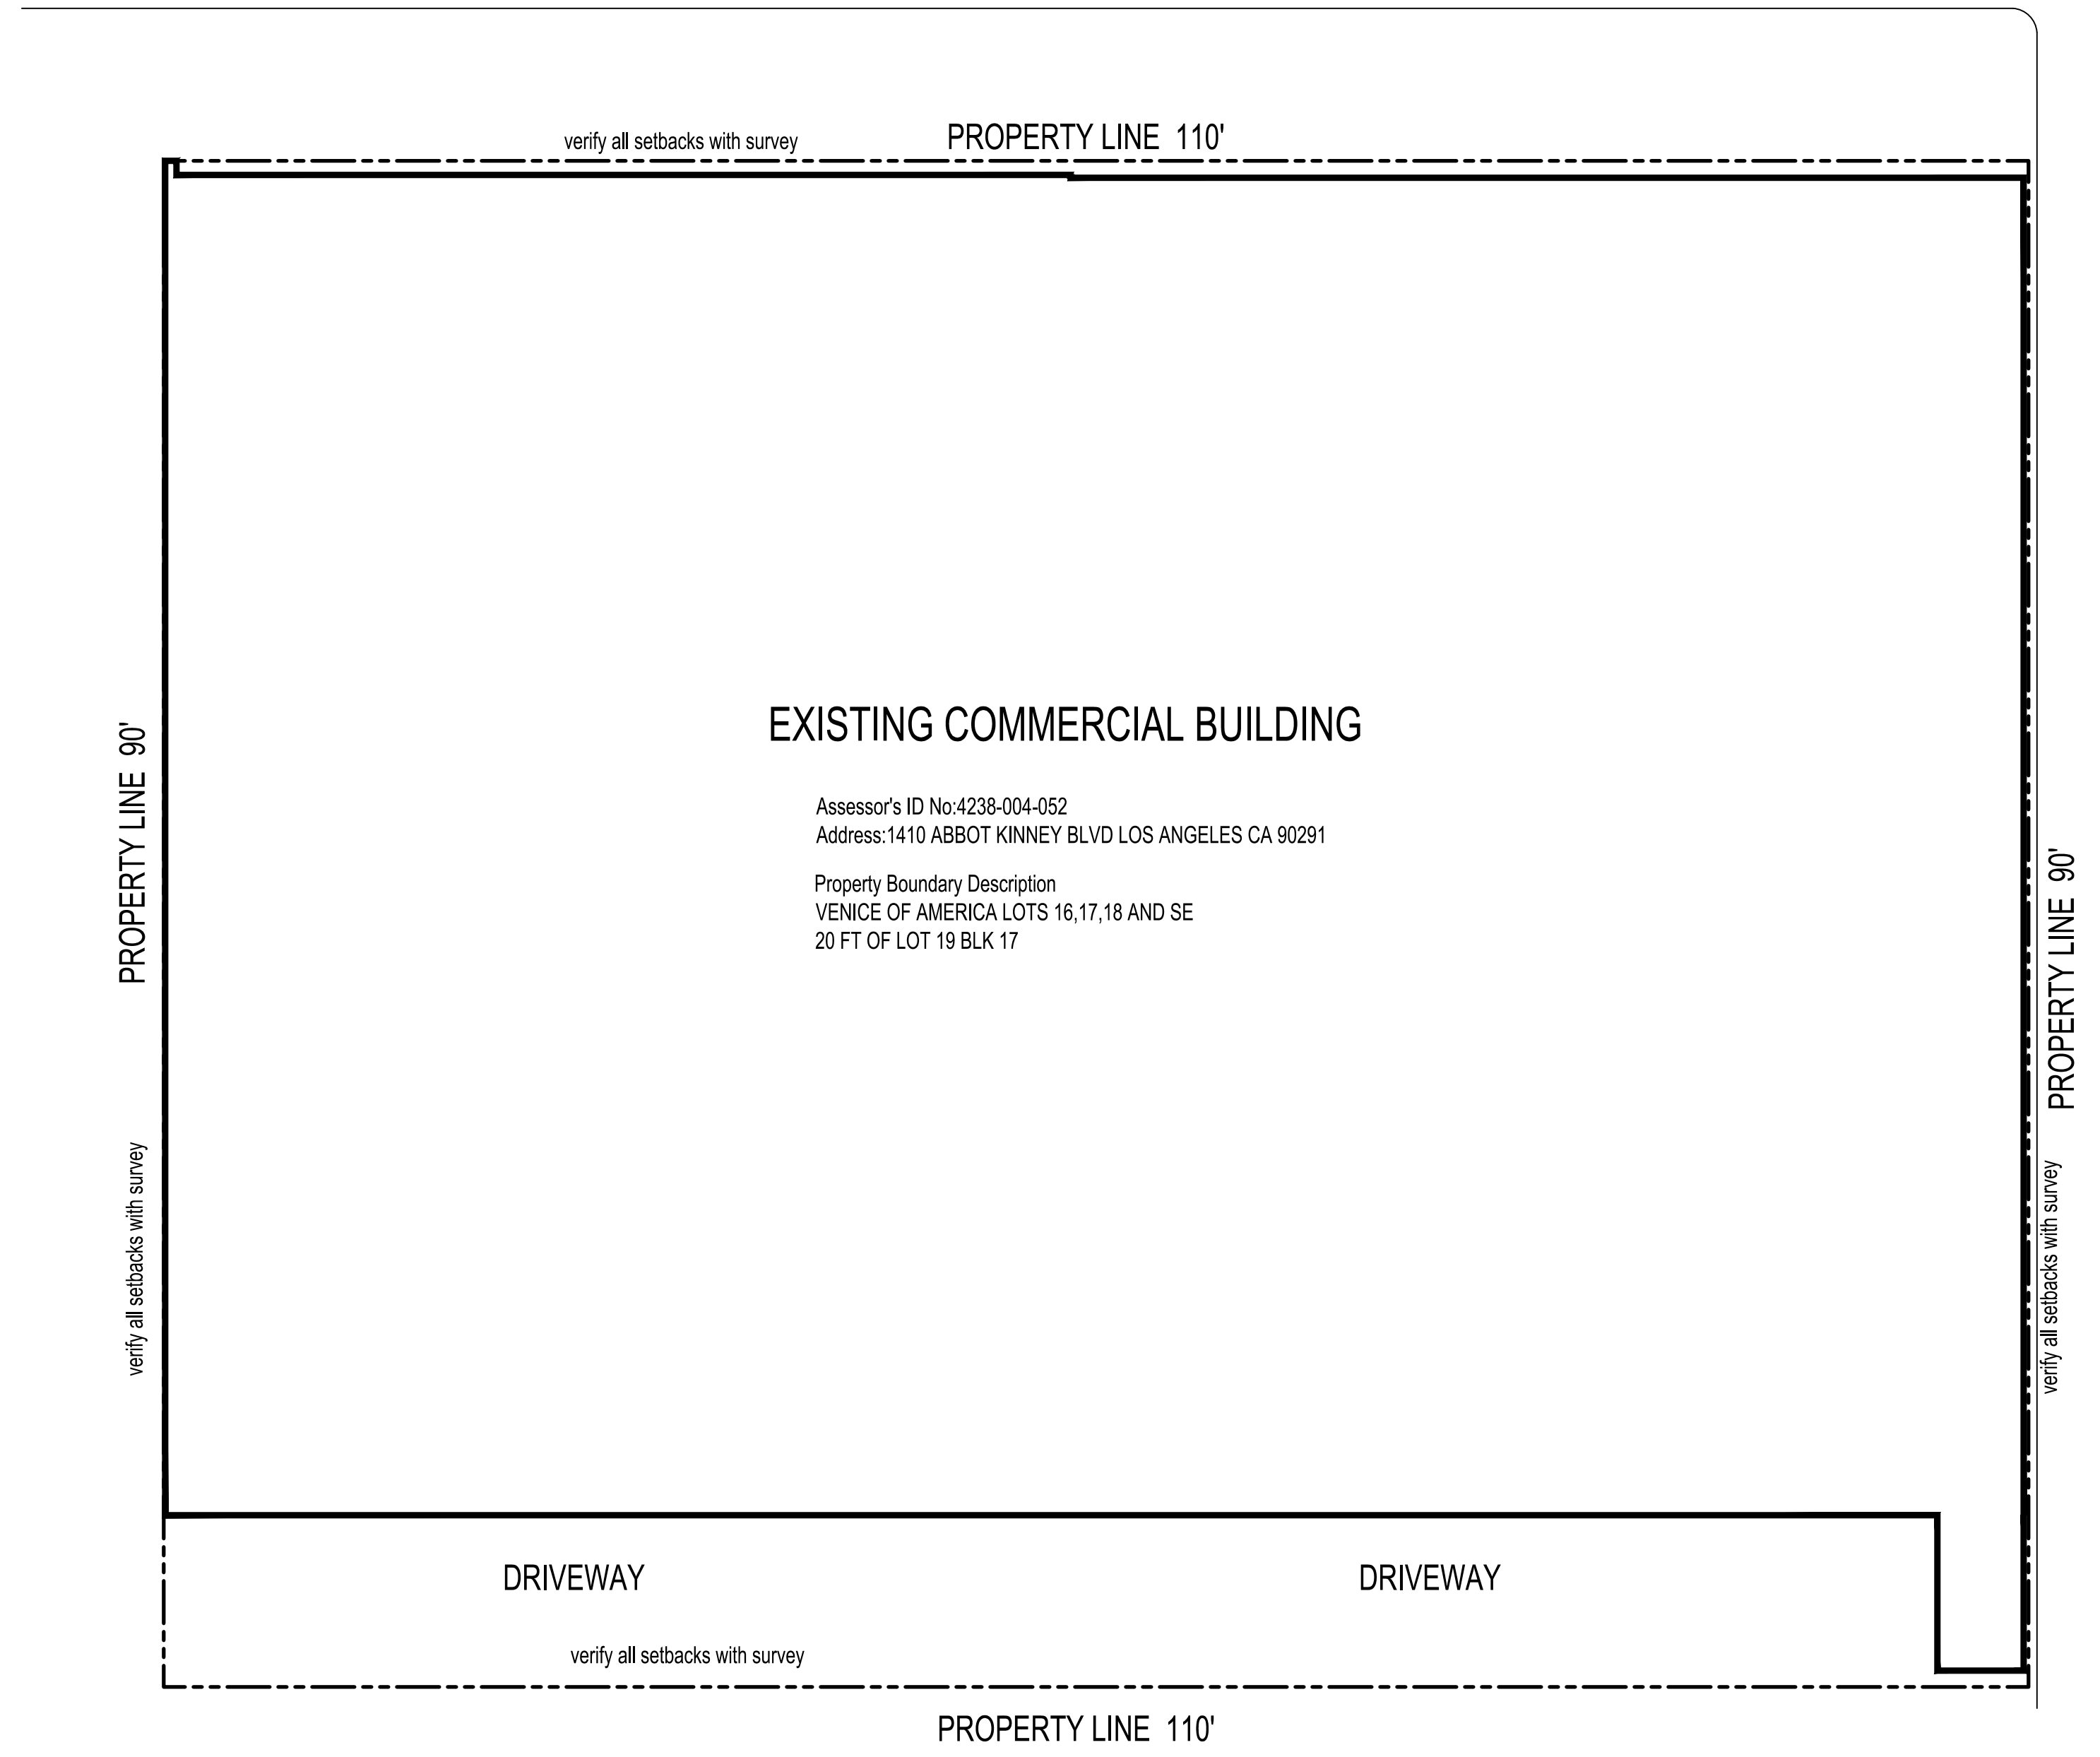

EXISTING COMMERCIAL BUILDING

Assessor's ID No:4238-004-052  
Address:1410 ABBOT KINNEY BLVD LOS ANGELES CA 90291  
Property Boundary Description  
VENICE OF AMERICA LOTS 16,17,18 AND SE  
20 FT OF LOT 19 BLK 17


DRIVEWAY

DRIVEWAY


# ALHAMBRA CT

# NAVARRE CT

## PLOT PLAN

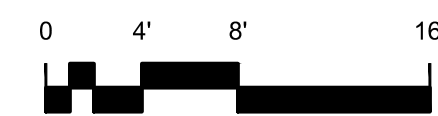

SCALE: 1/8" = 1'-0"

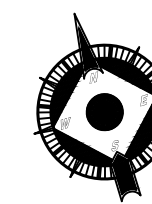

REVISIONS	BY

**AS-BUILT**  
LOS ANGELES

Sheet content :  
PLOT PLAN

Project :  
1410 ABBOT KINNEY BLVD  
LOS ANGELES CA 90291

Owner:

Date

Scale

Drawn

Job

Sheet

**A-1**

REVISIONS	BY

**AS-BUILT**  
LOS ANGELES

FLOOR PLAN

Sheet content :

Project : 1410 ABBOT KINNEY BLVD  
LOS ANGELES CA 90291

Owner :

Date

Scale


Drawn

Job


Sheet

**A-2**


08.28.13

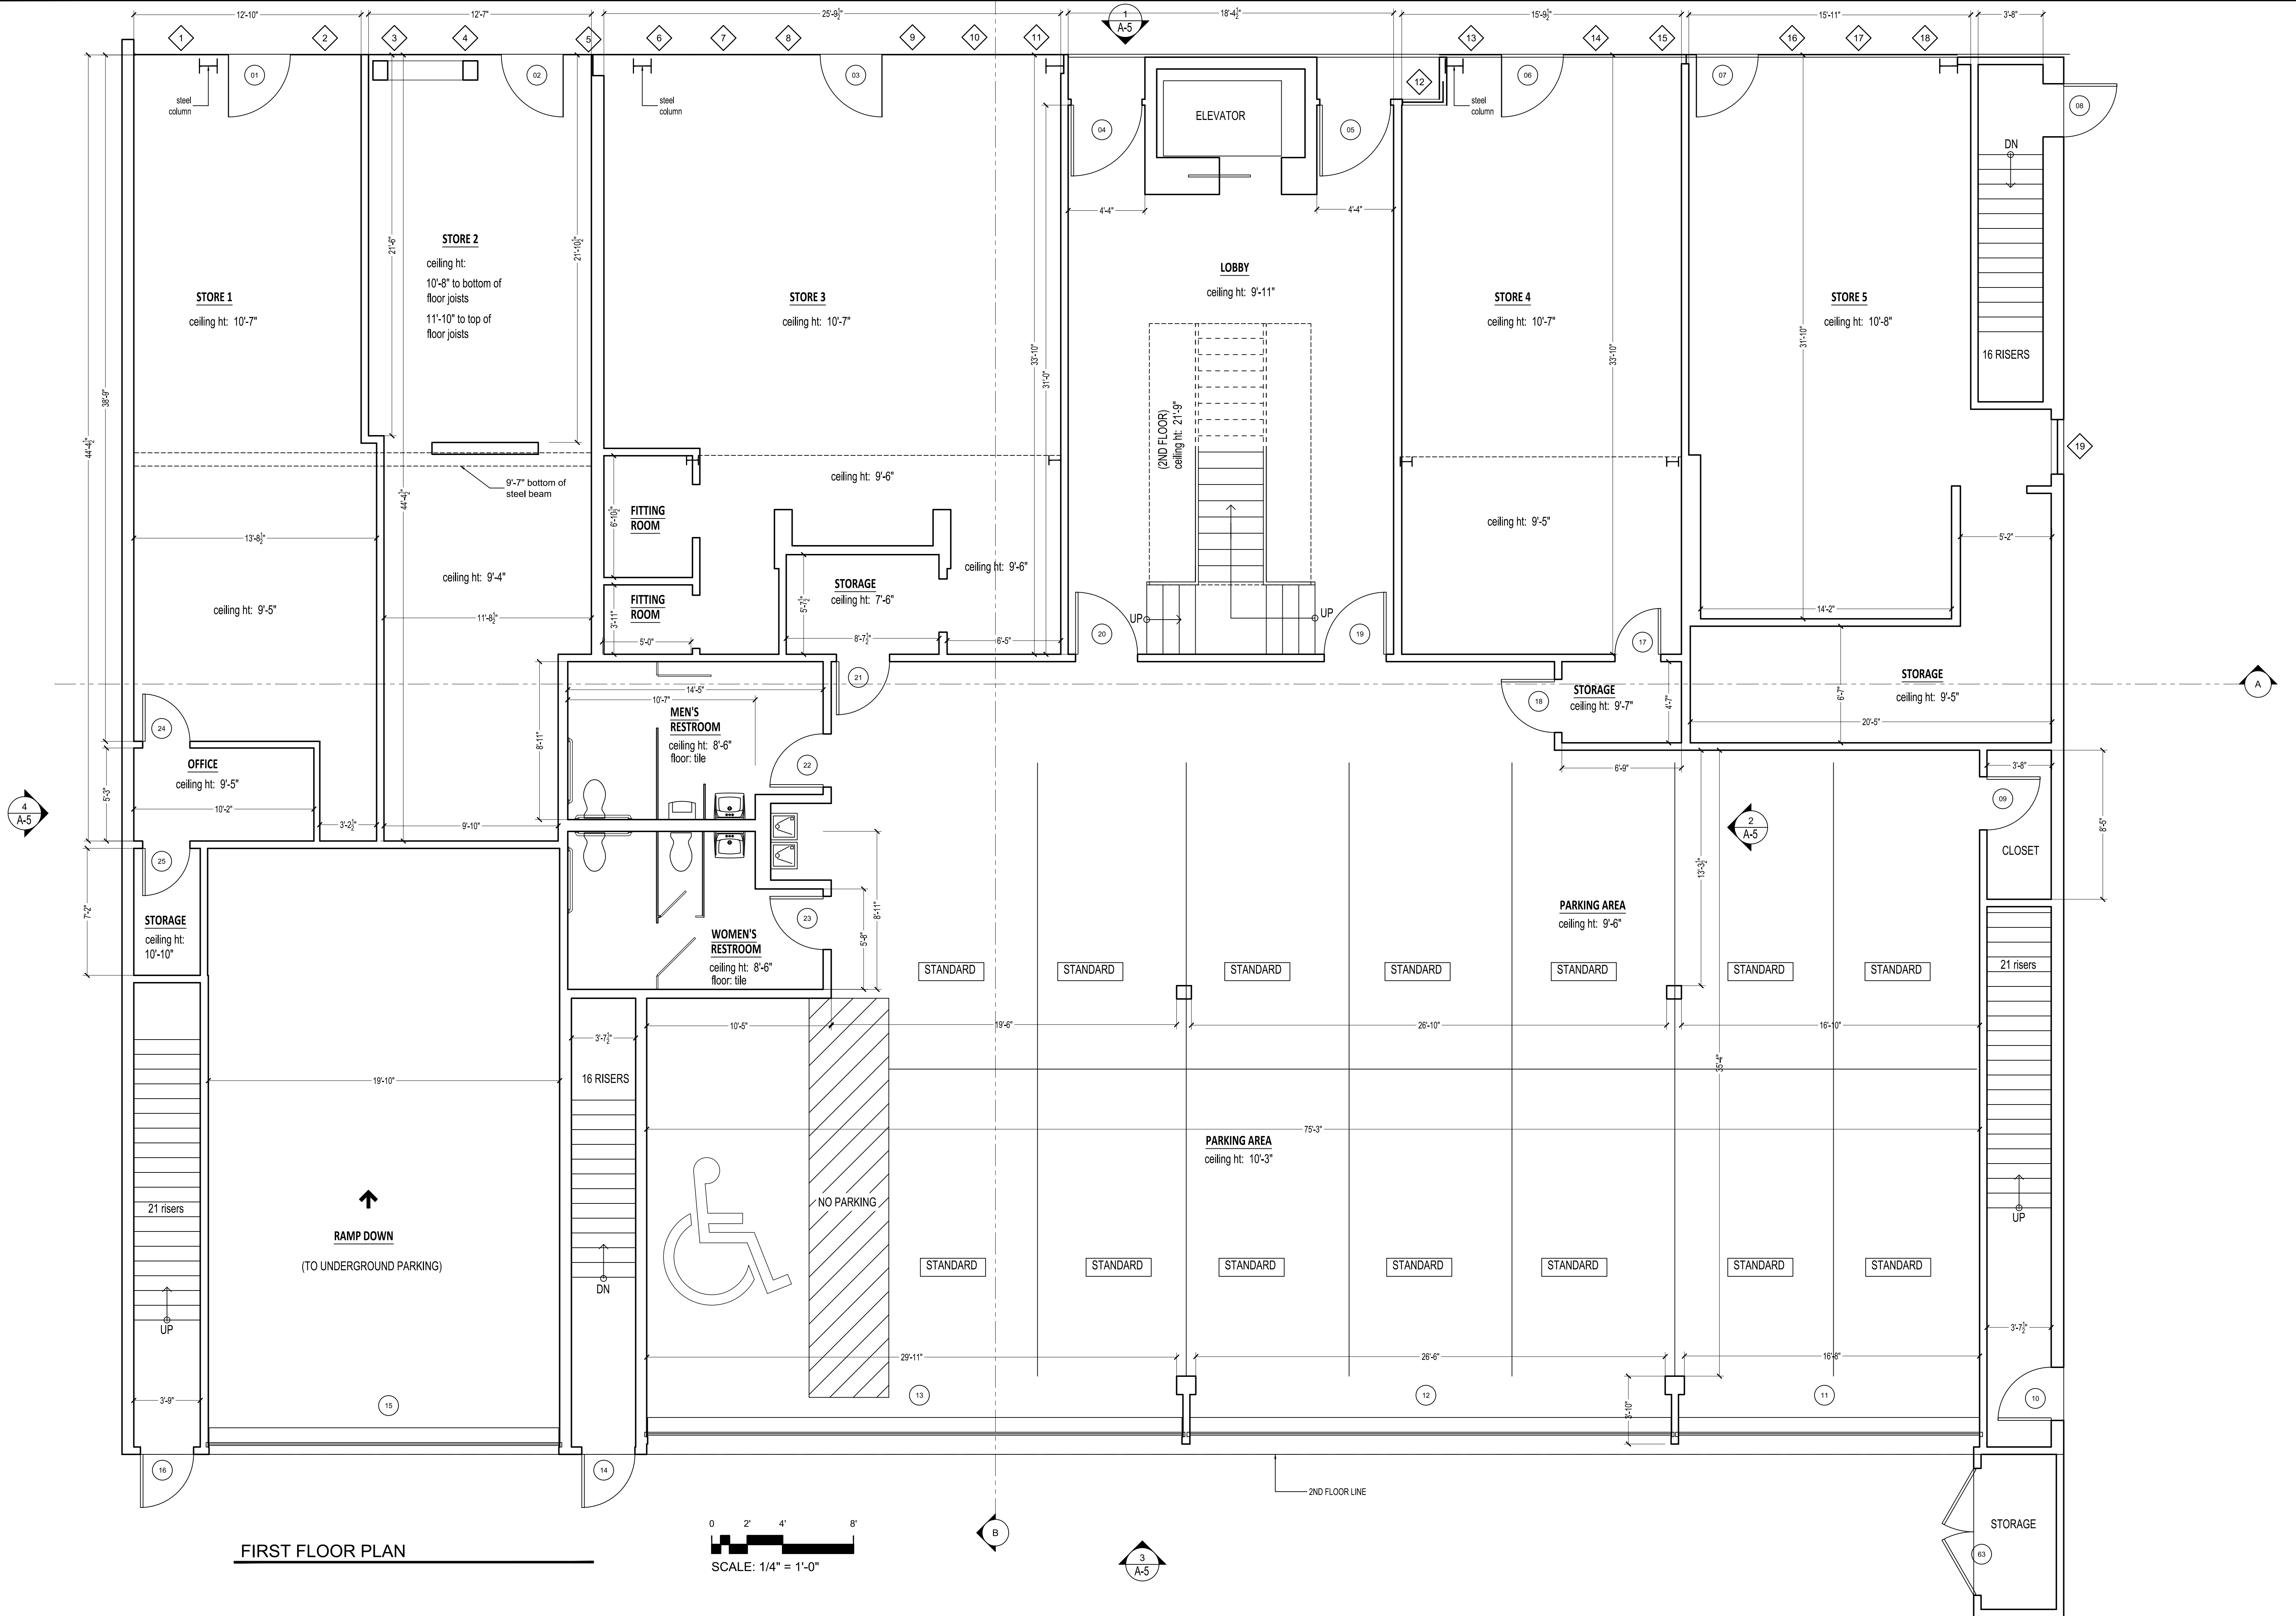


FIRST FLOOR PLAN

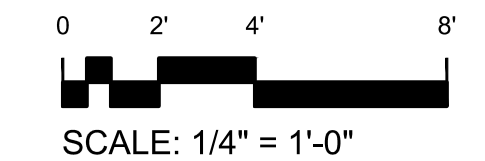

3  
A-5

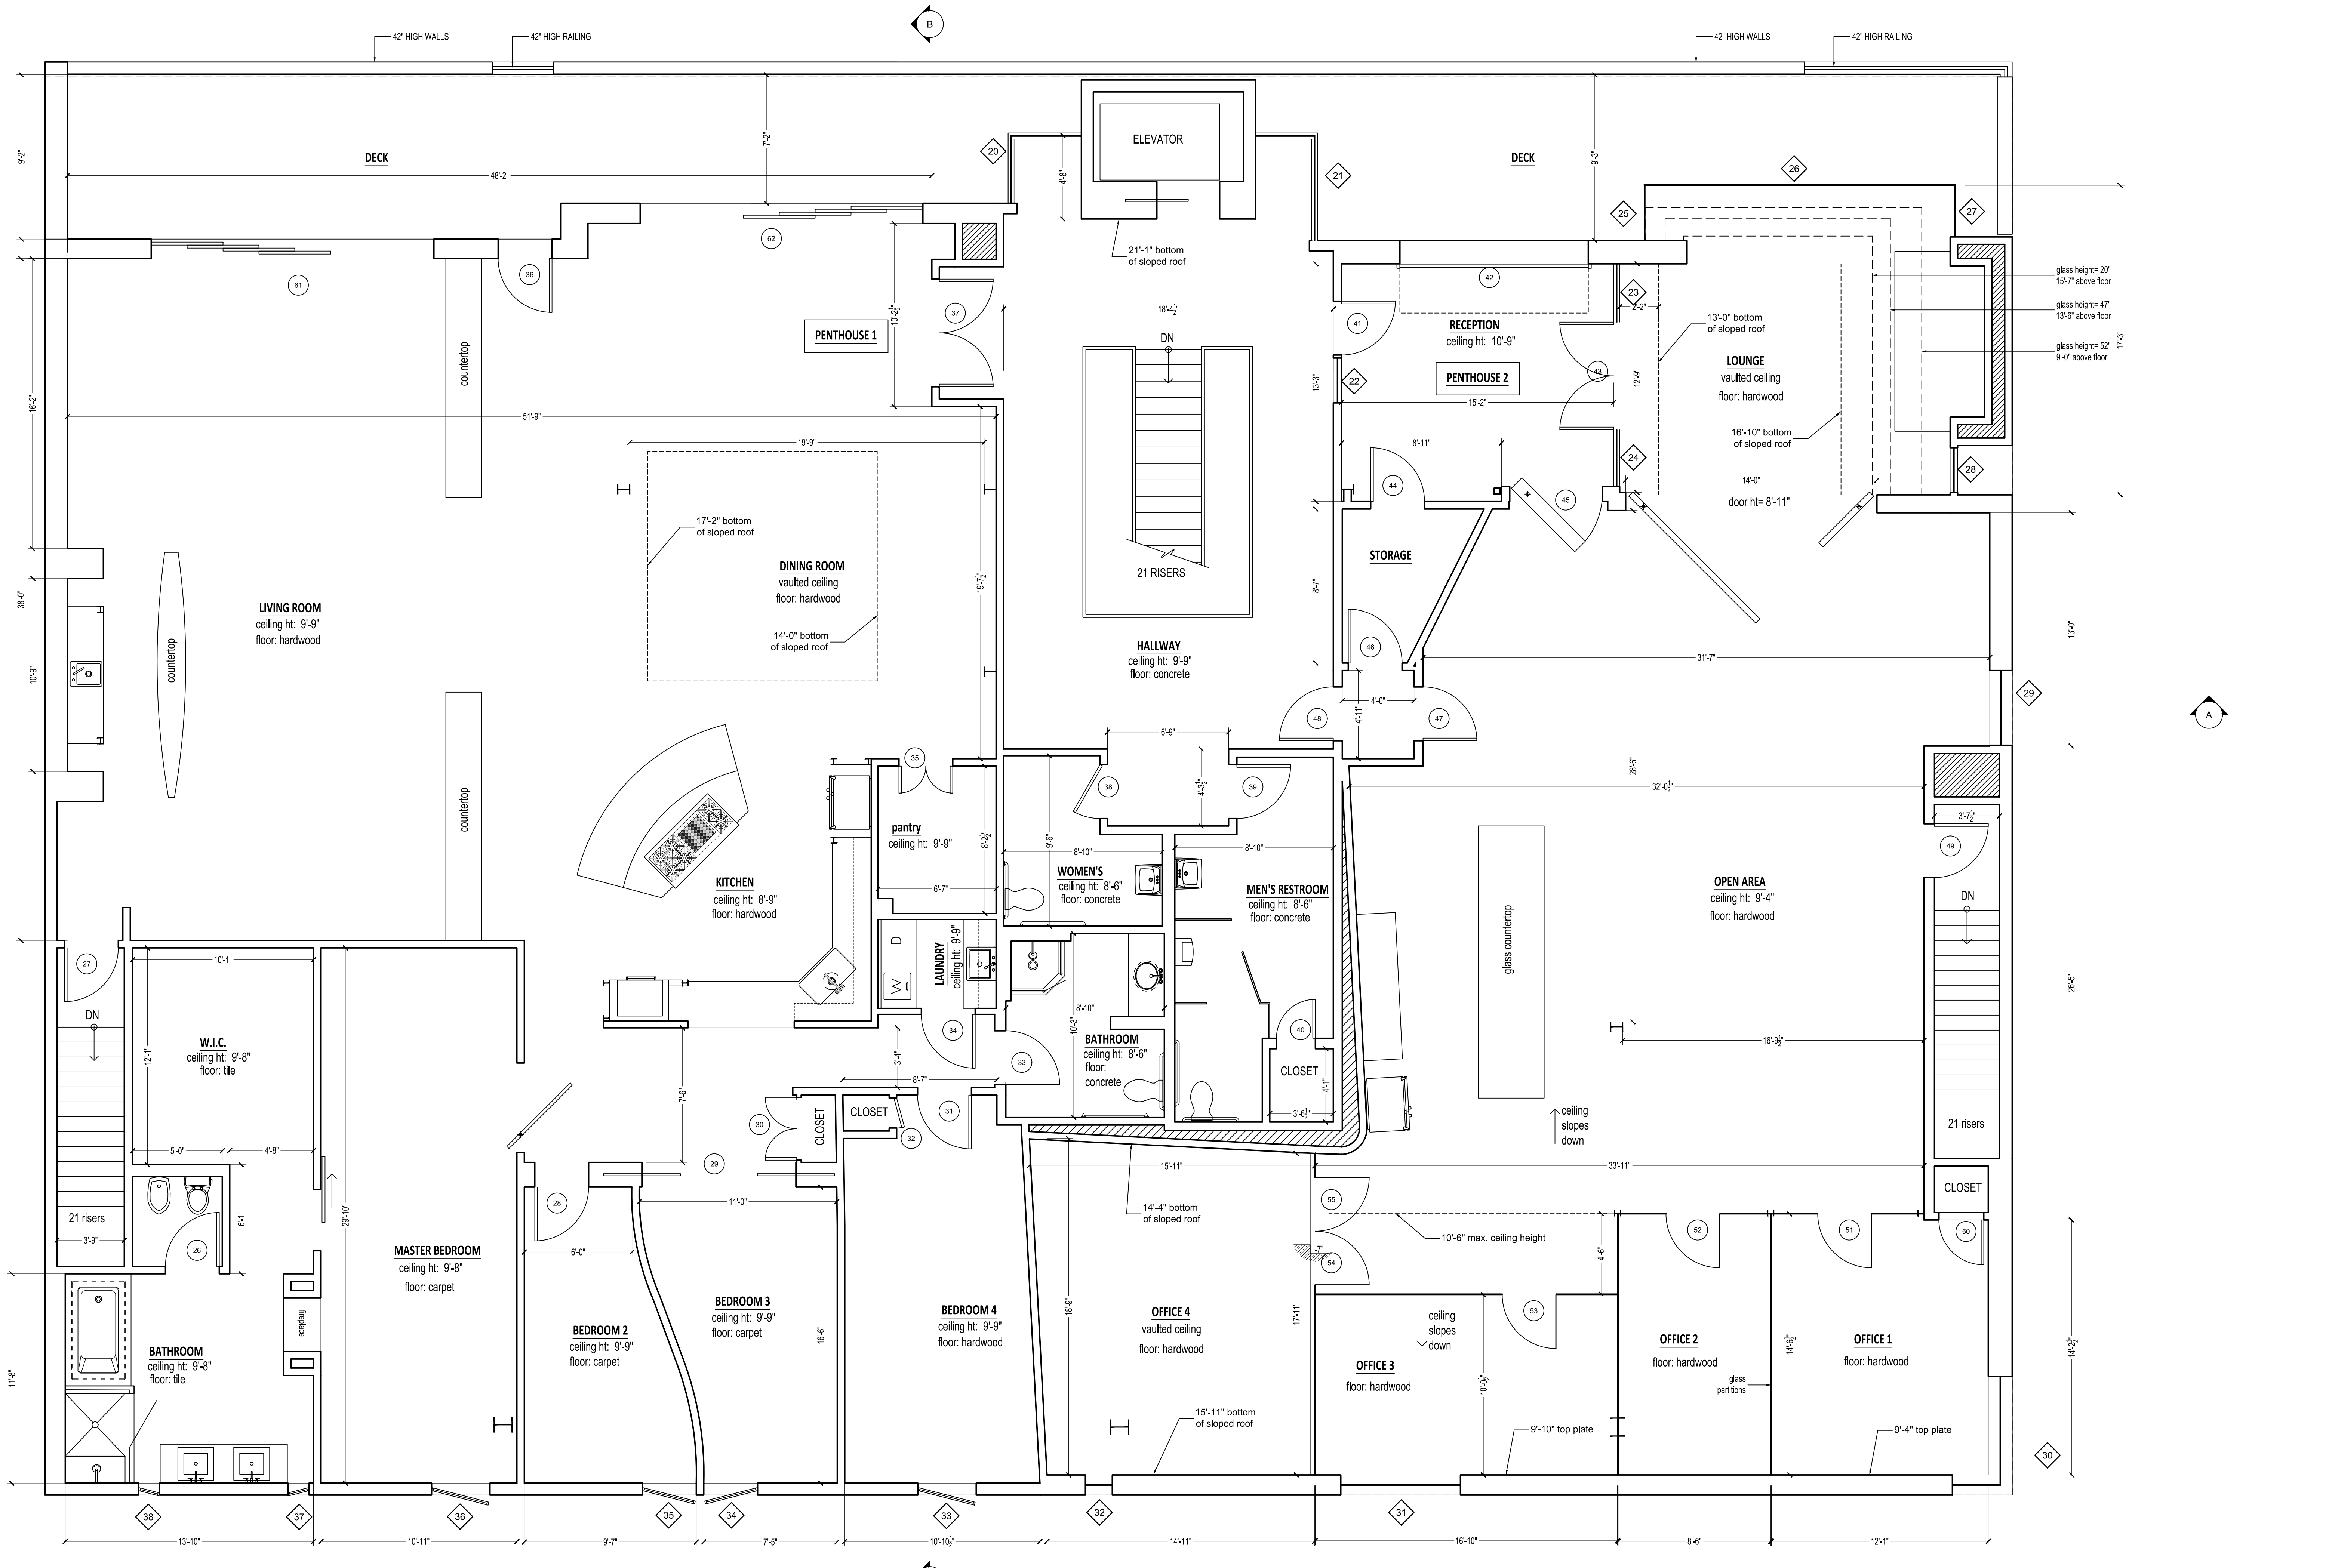

SECOND FLOOR PLAN

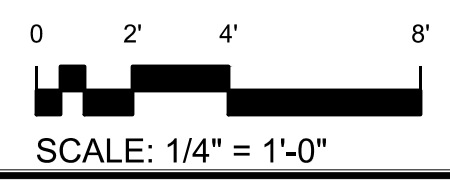

REVISIONS	BY
<b>AS-BUILT</b> LOS ANGELES	
Sheet content : <b>SECOND FLOOR PLAN</b>	
Project : <b>1410 ABBOT KINNEY BLVD LOS ANGELES CA 90291</b>	
Owner:	
Date	
Scale	
Drawn	
Job	
Sheet	<b>A-3</b>

REVISIONS	BY

**AS-BUILT**  
LOS ANGELES

Sheet content :  
**BASEMENT FLOOR PLAN**

Project :  
1410 ABBOT KINNEY BLVD  
LOS ANGELES CA 90291

Owner:

Date

Scale


Drawn

Job

Sheet

**A-4**

08.08.13

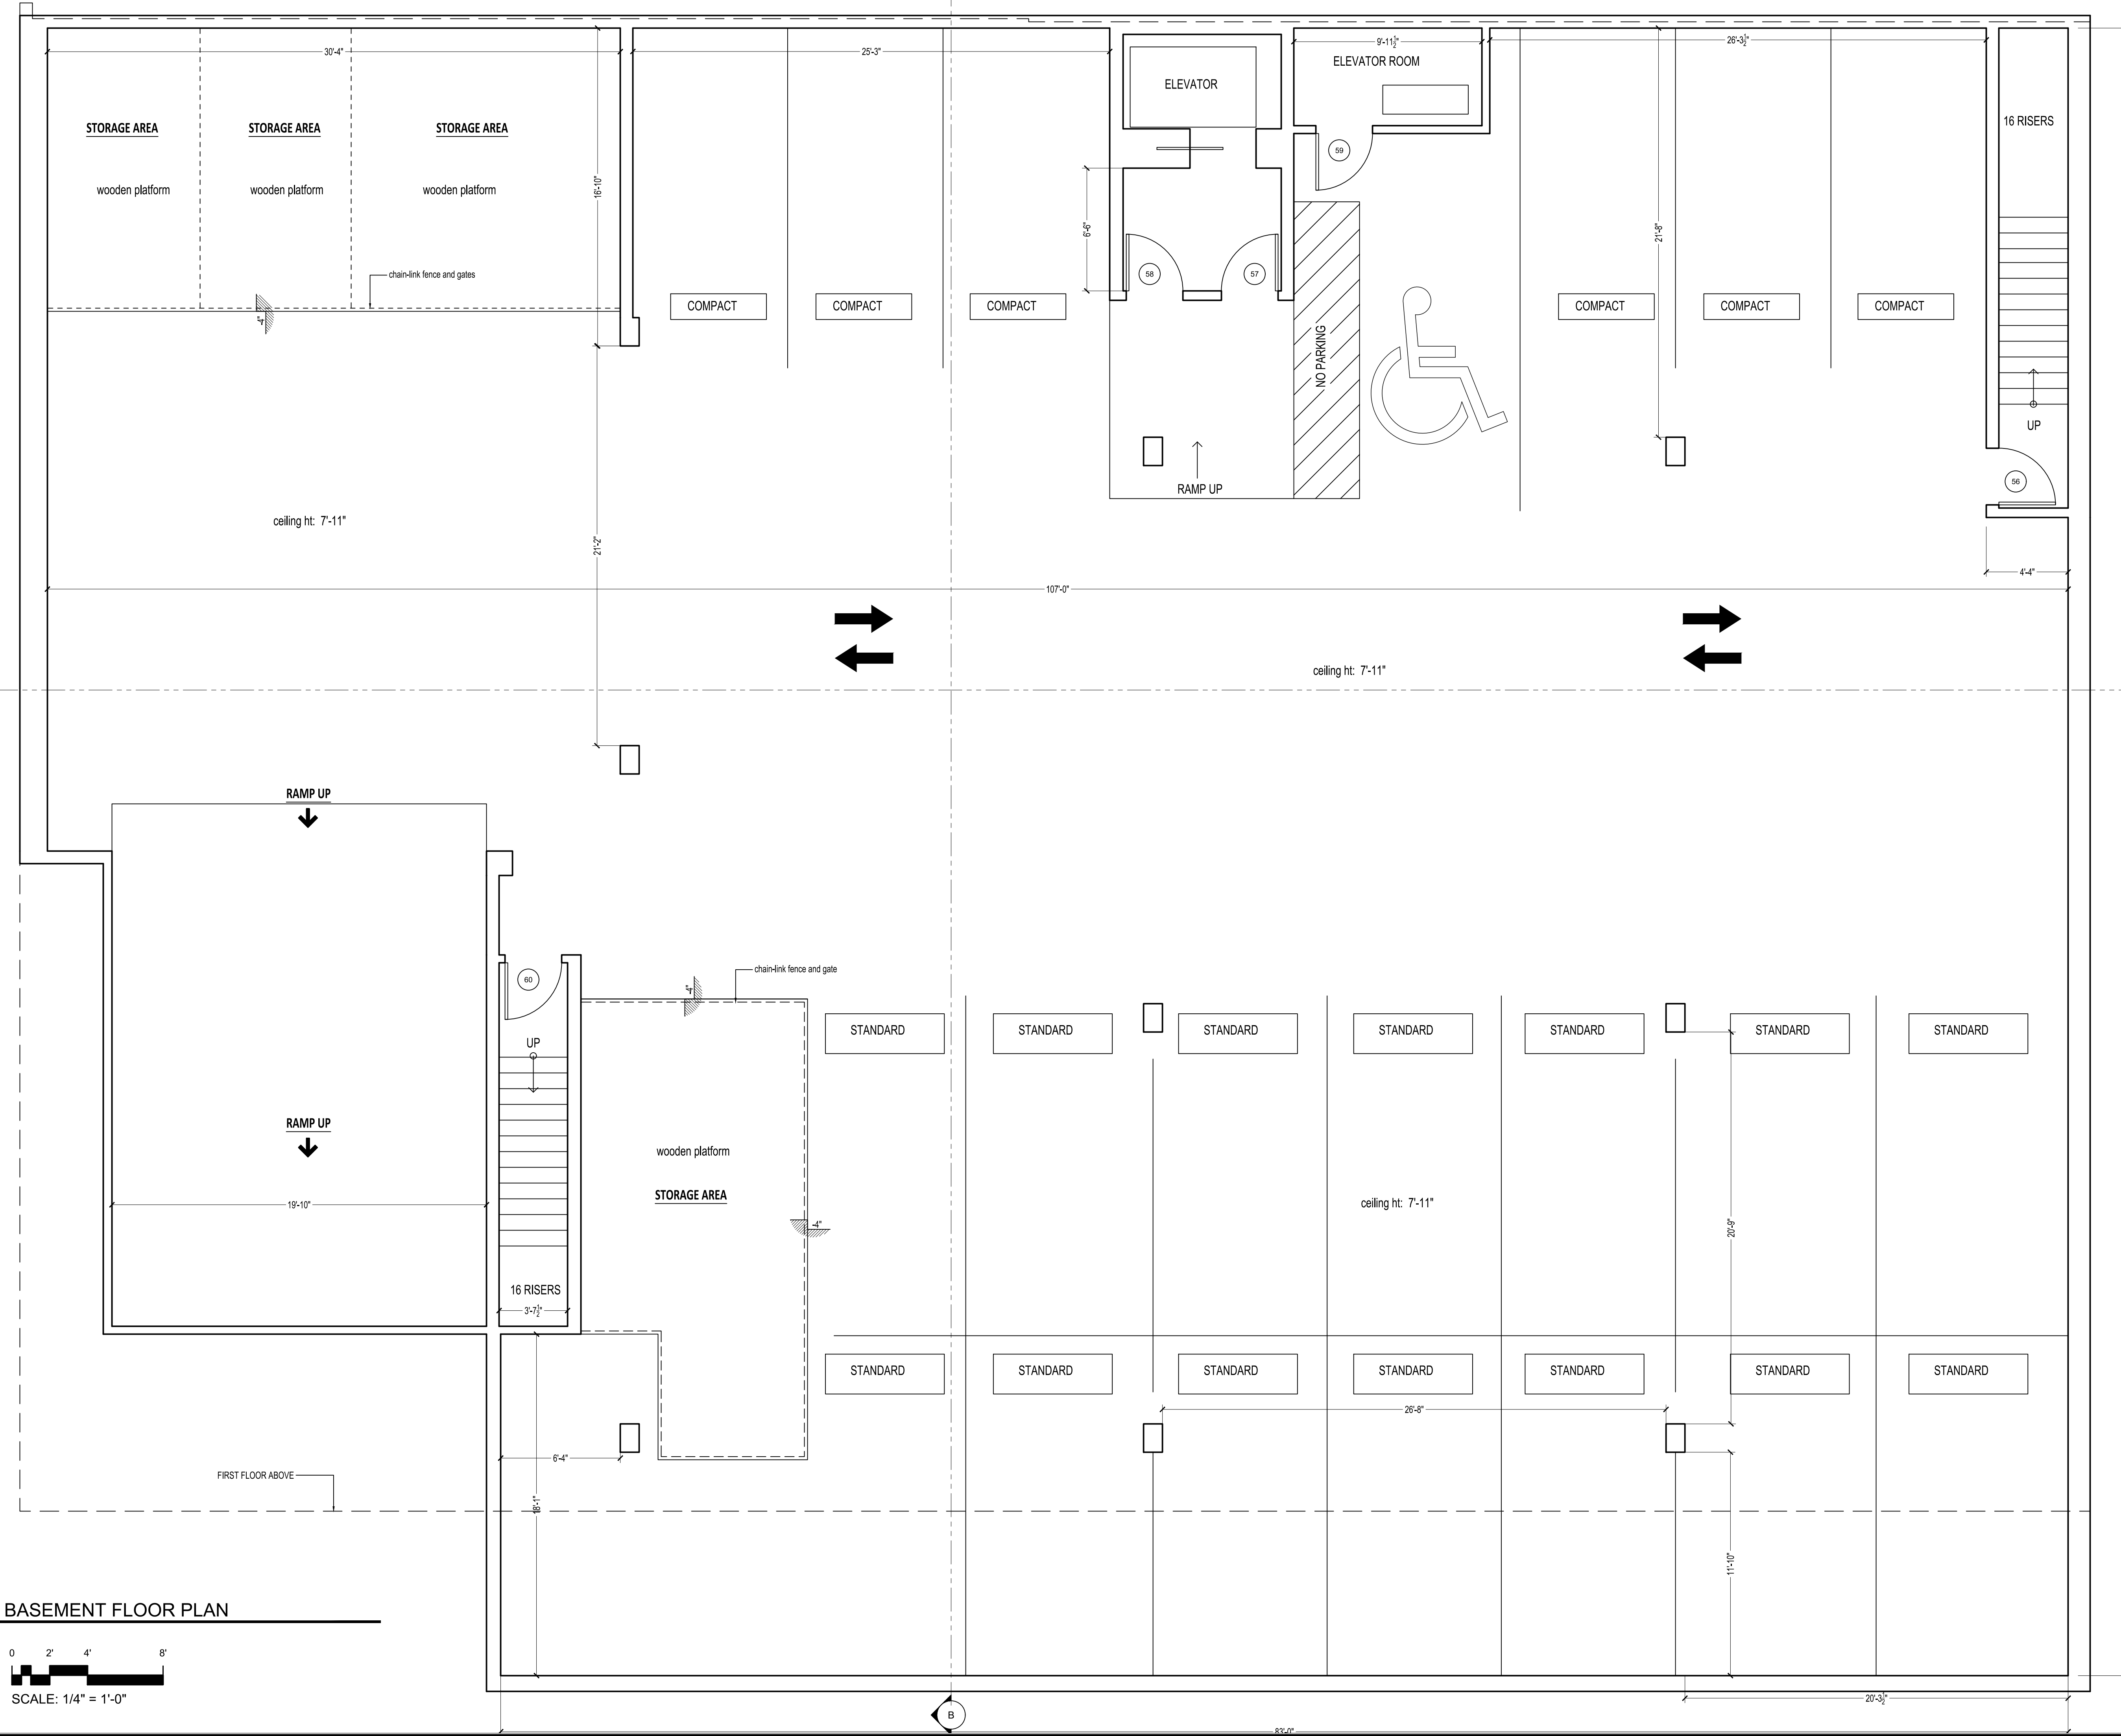


**BASEMENT FLOOR PLAN**

0 2' 4' 8'  
SCALE: 1/4" = 1'-0"






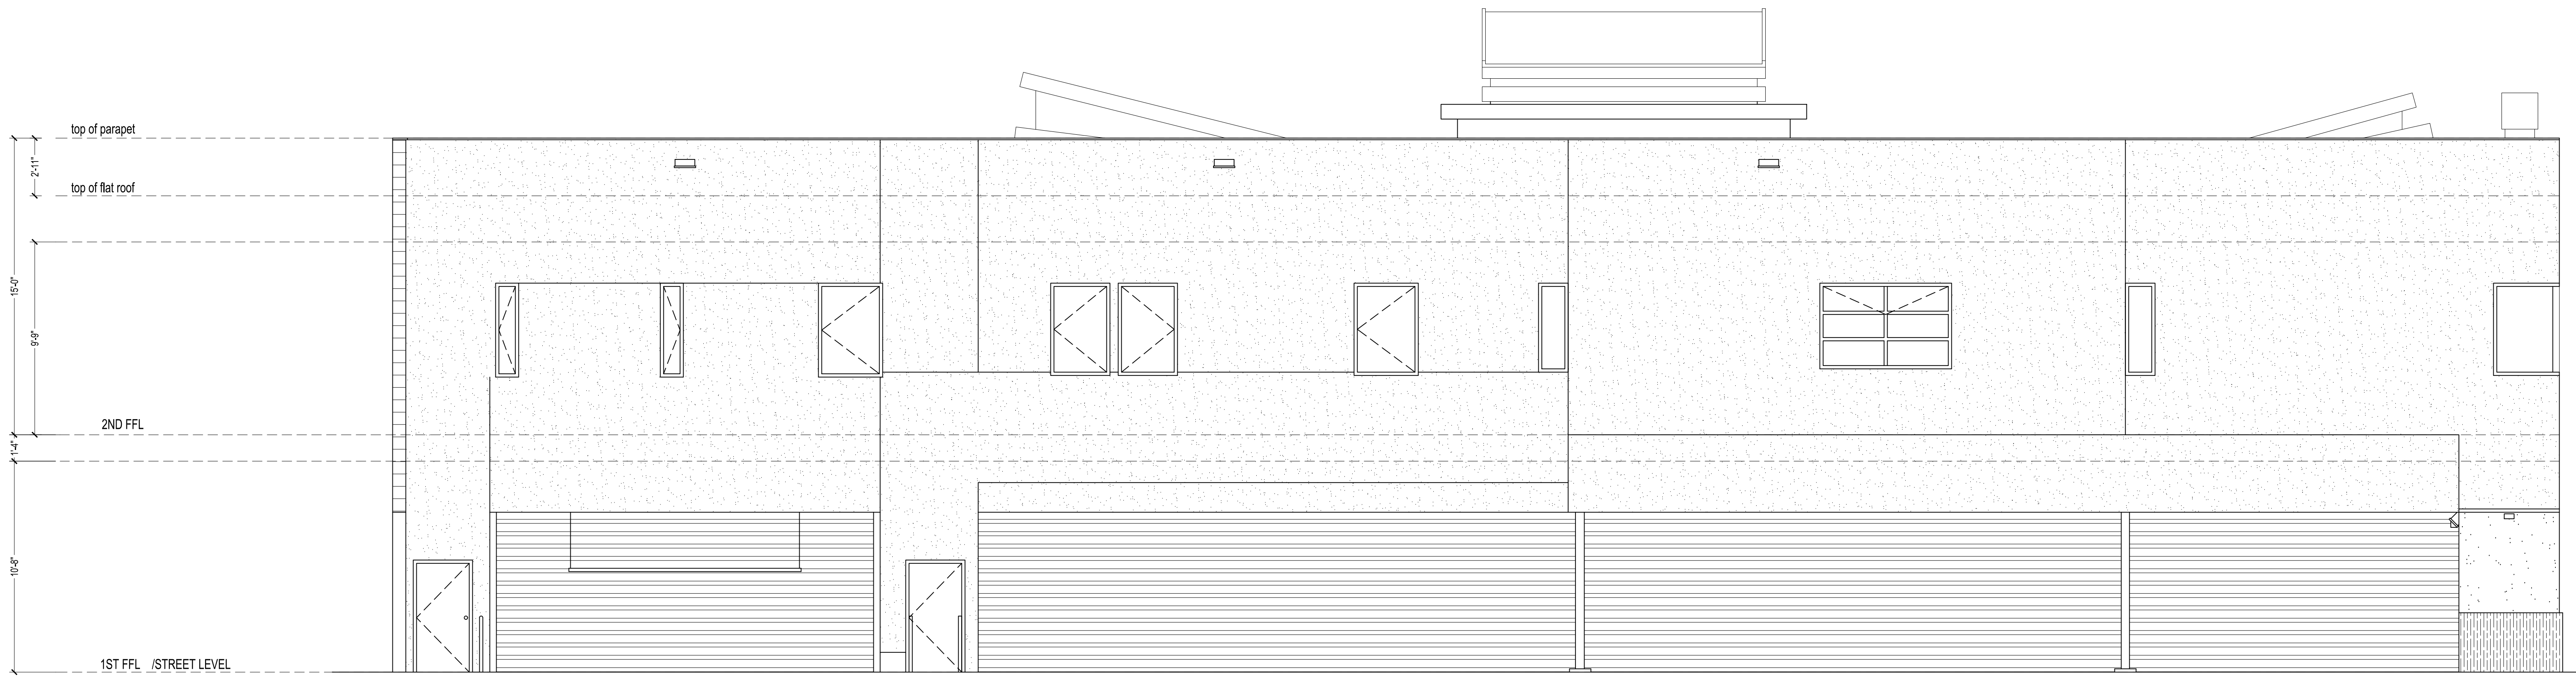

3 S.W. ELEVATION

SCALE: 1/4" = 1'-0"

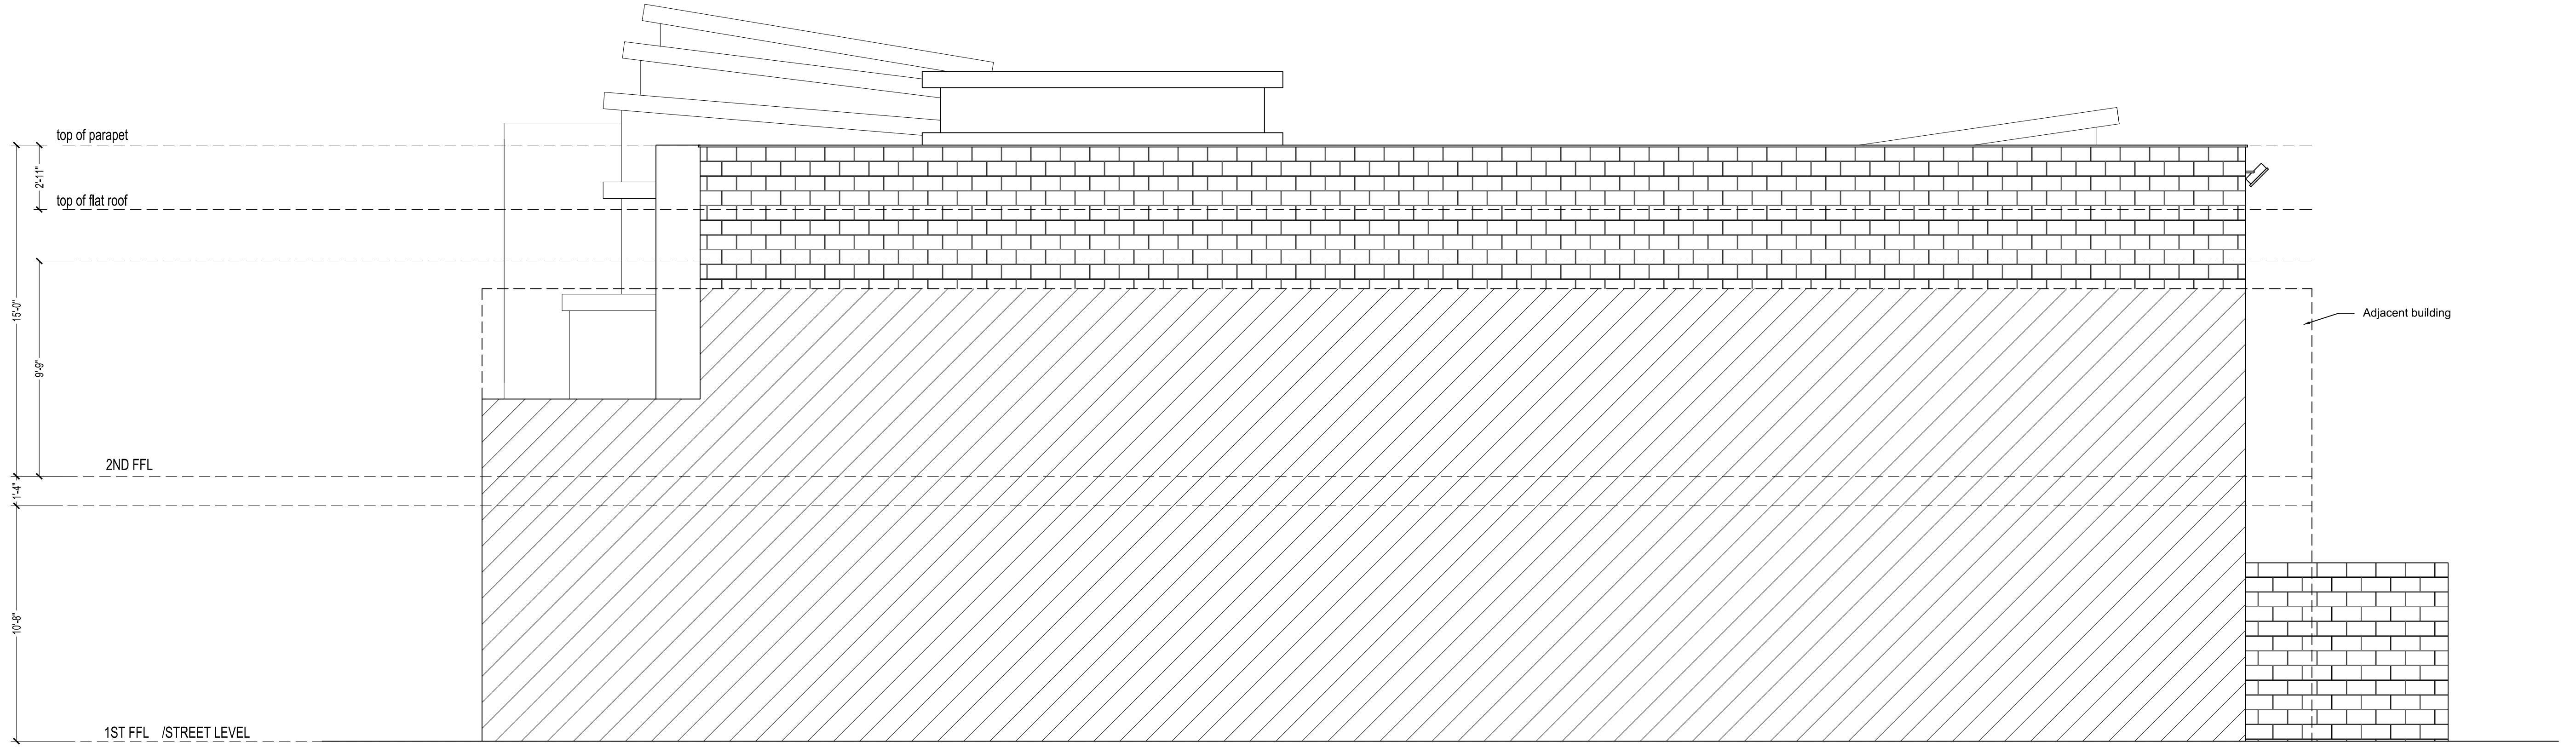

4 N.W. ELEVATION

SCALE: 1/4" = 1'-0"

REVISIONS	BY

**AS-BUILT**  
LOS ANGELES

Sheet content :  
ELEVATIONS


Project :  
1410 ABBOT KINNEY BLVD  
LOS ANGELES CA 90291

Owner:  
Date  
Scale  
Drawn  
Job  
Sheet

**A-6**



SECTION A-A

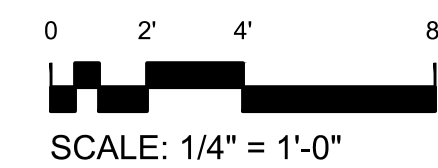

REVISIONS	BY

**AS-BUILT**  
LOS ANGELES

Sheet content :  
ROOF PLAN

Project :  
1410 ABBOT KINNEY BLVD  
LOS ANGELES CA 90291

Owner:

Date

Scale


Drawn

Job

Sheet

**A-9**

08.26.13

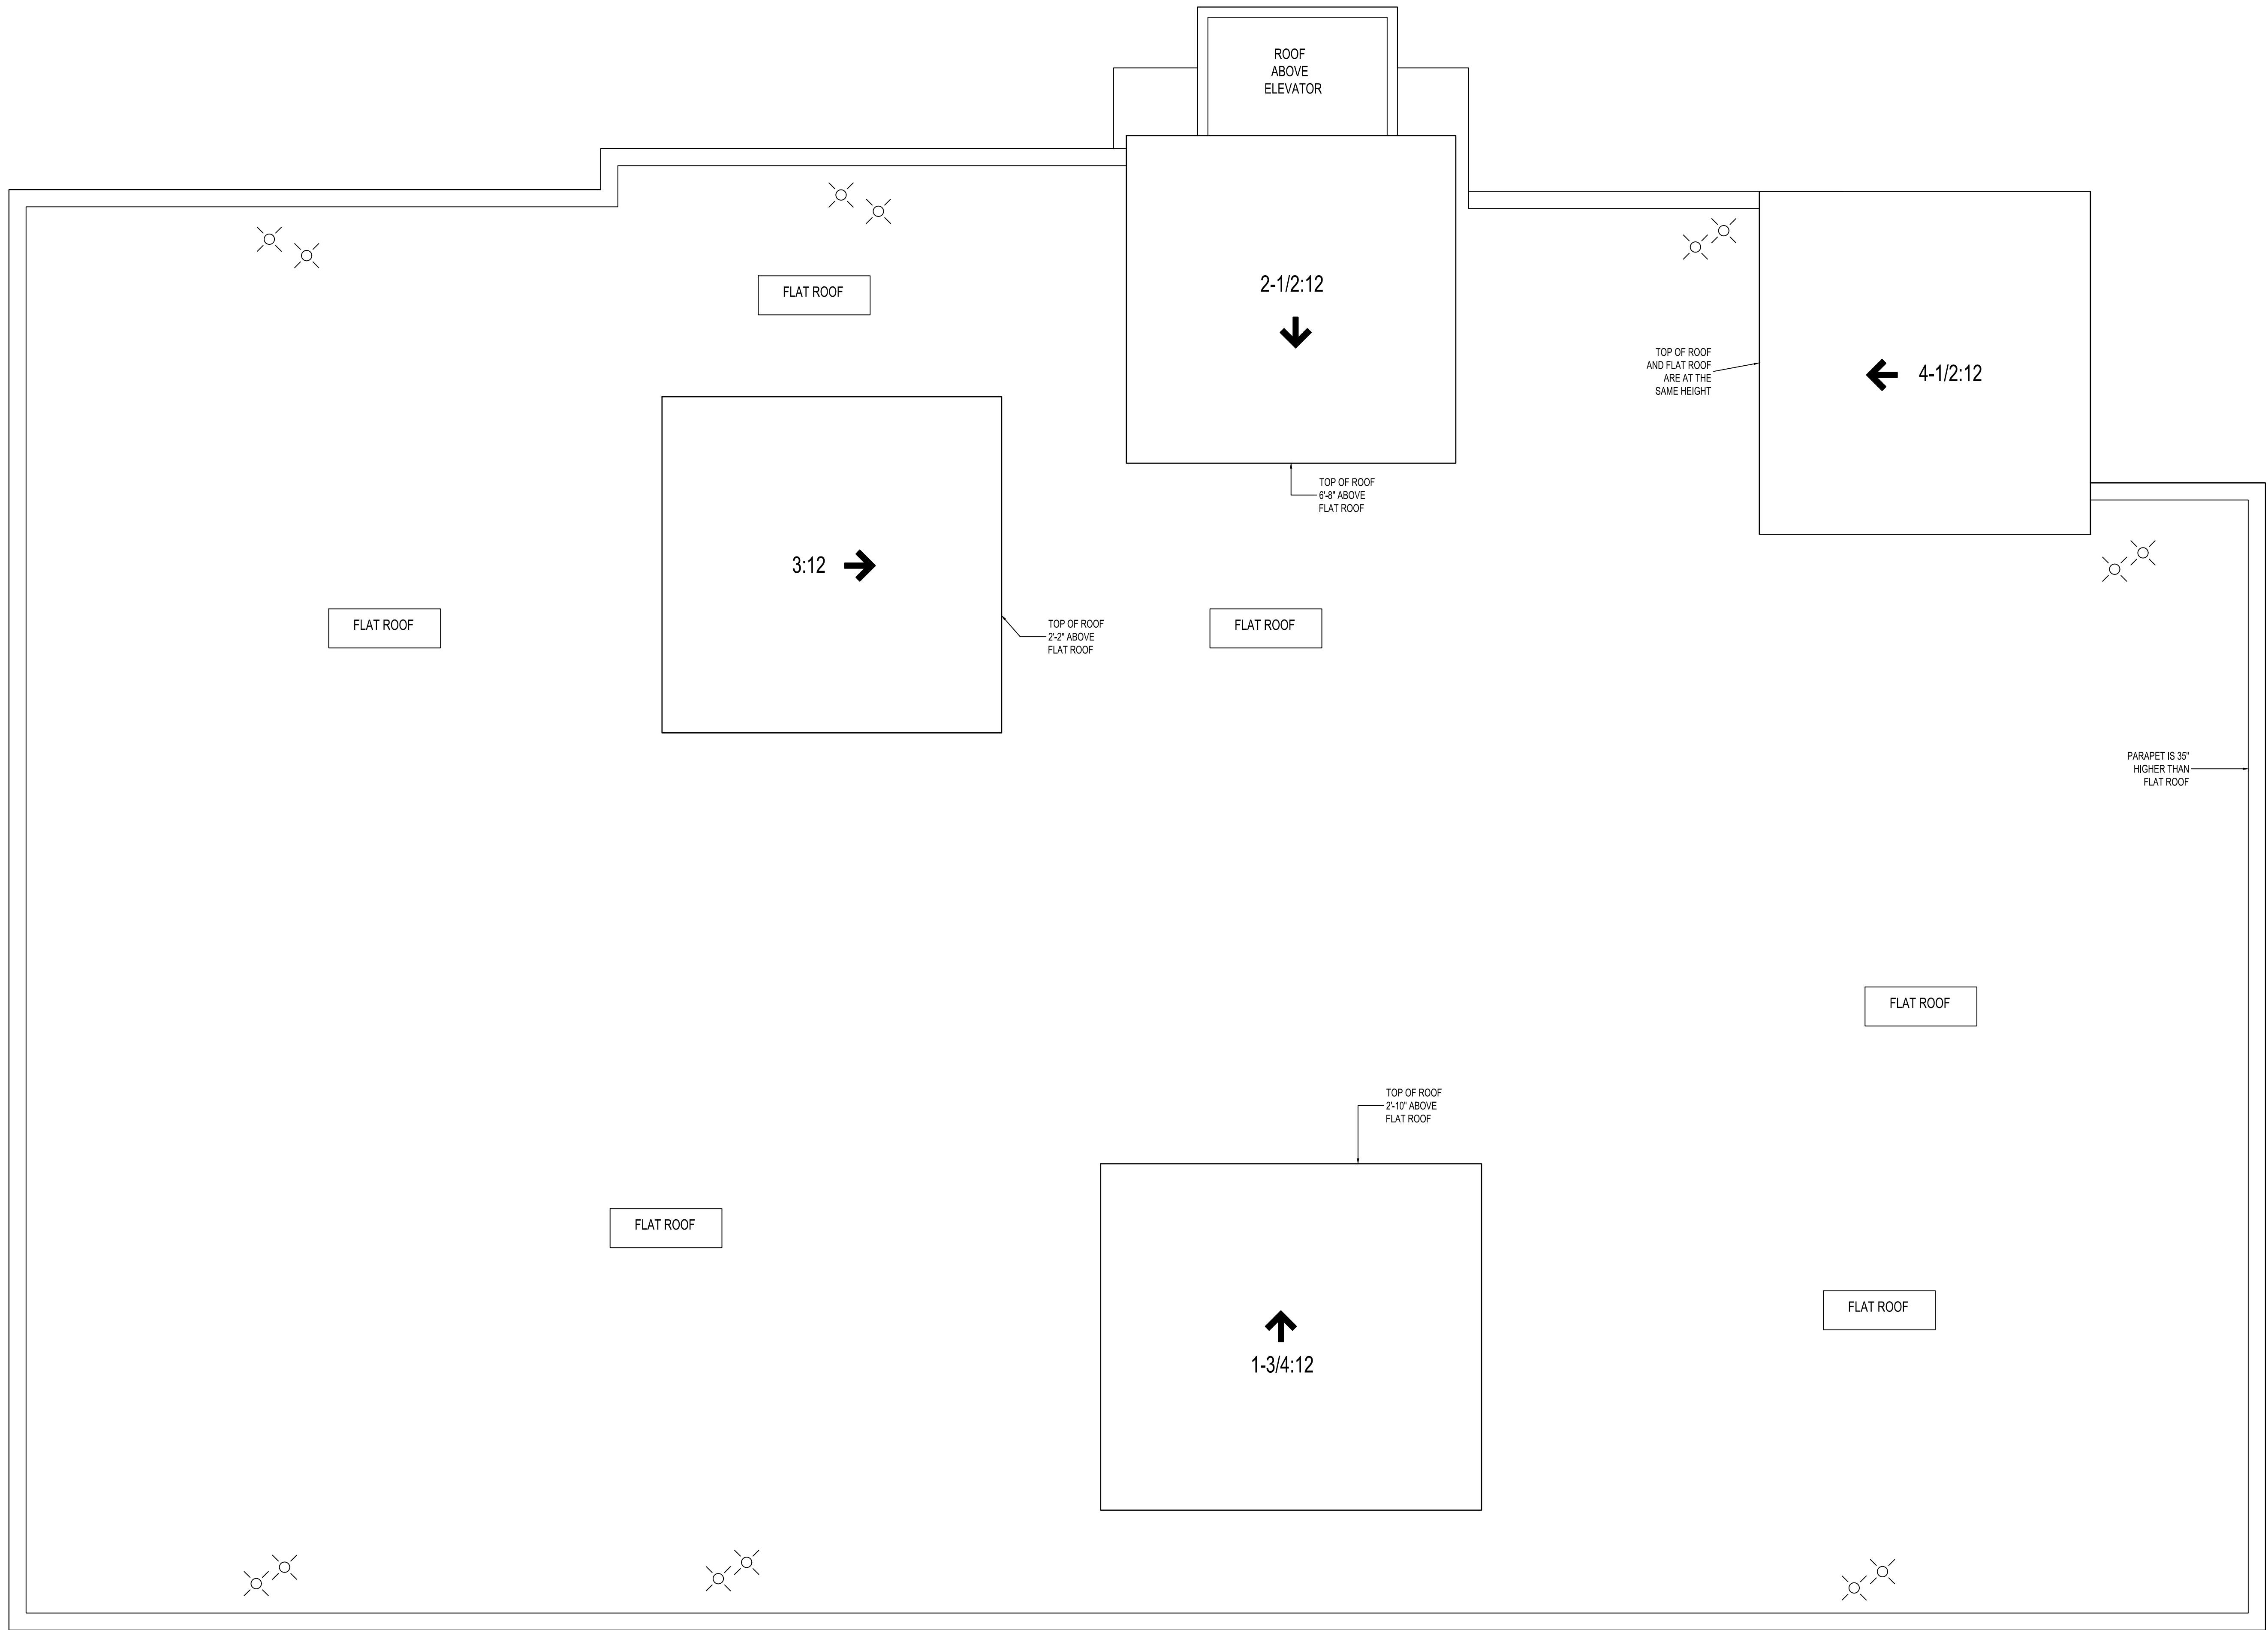

**ROOF PLAN**



SCALE: 1/4" = 1'-0"