

REVISIONS	BY

**AS-BUILT**  
LOS ANGELES

FLOOR PLANS

Sheet content:


Project: 2730 La Cuesta Dr  
Los Angeles, CA 90046

Owner:




Date  
Scale  
Drawn  
Job  
Sheet

**A-2**



08.06.13

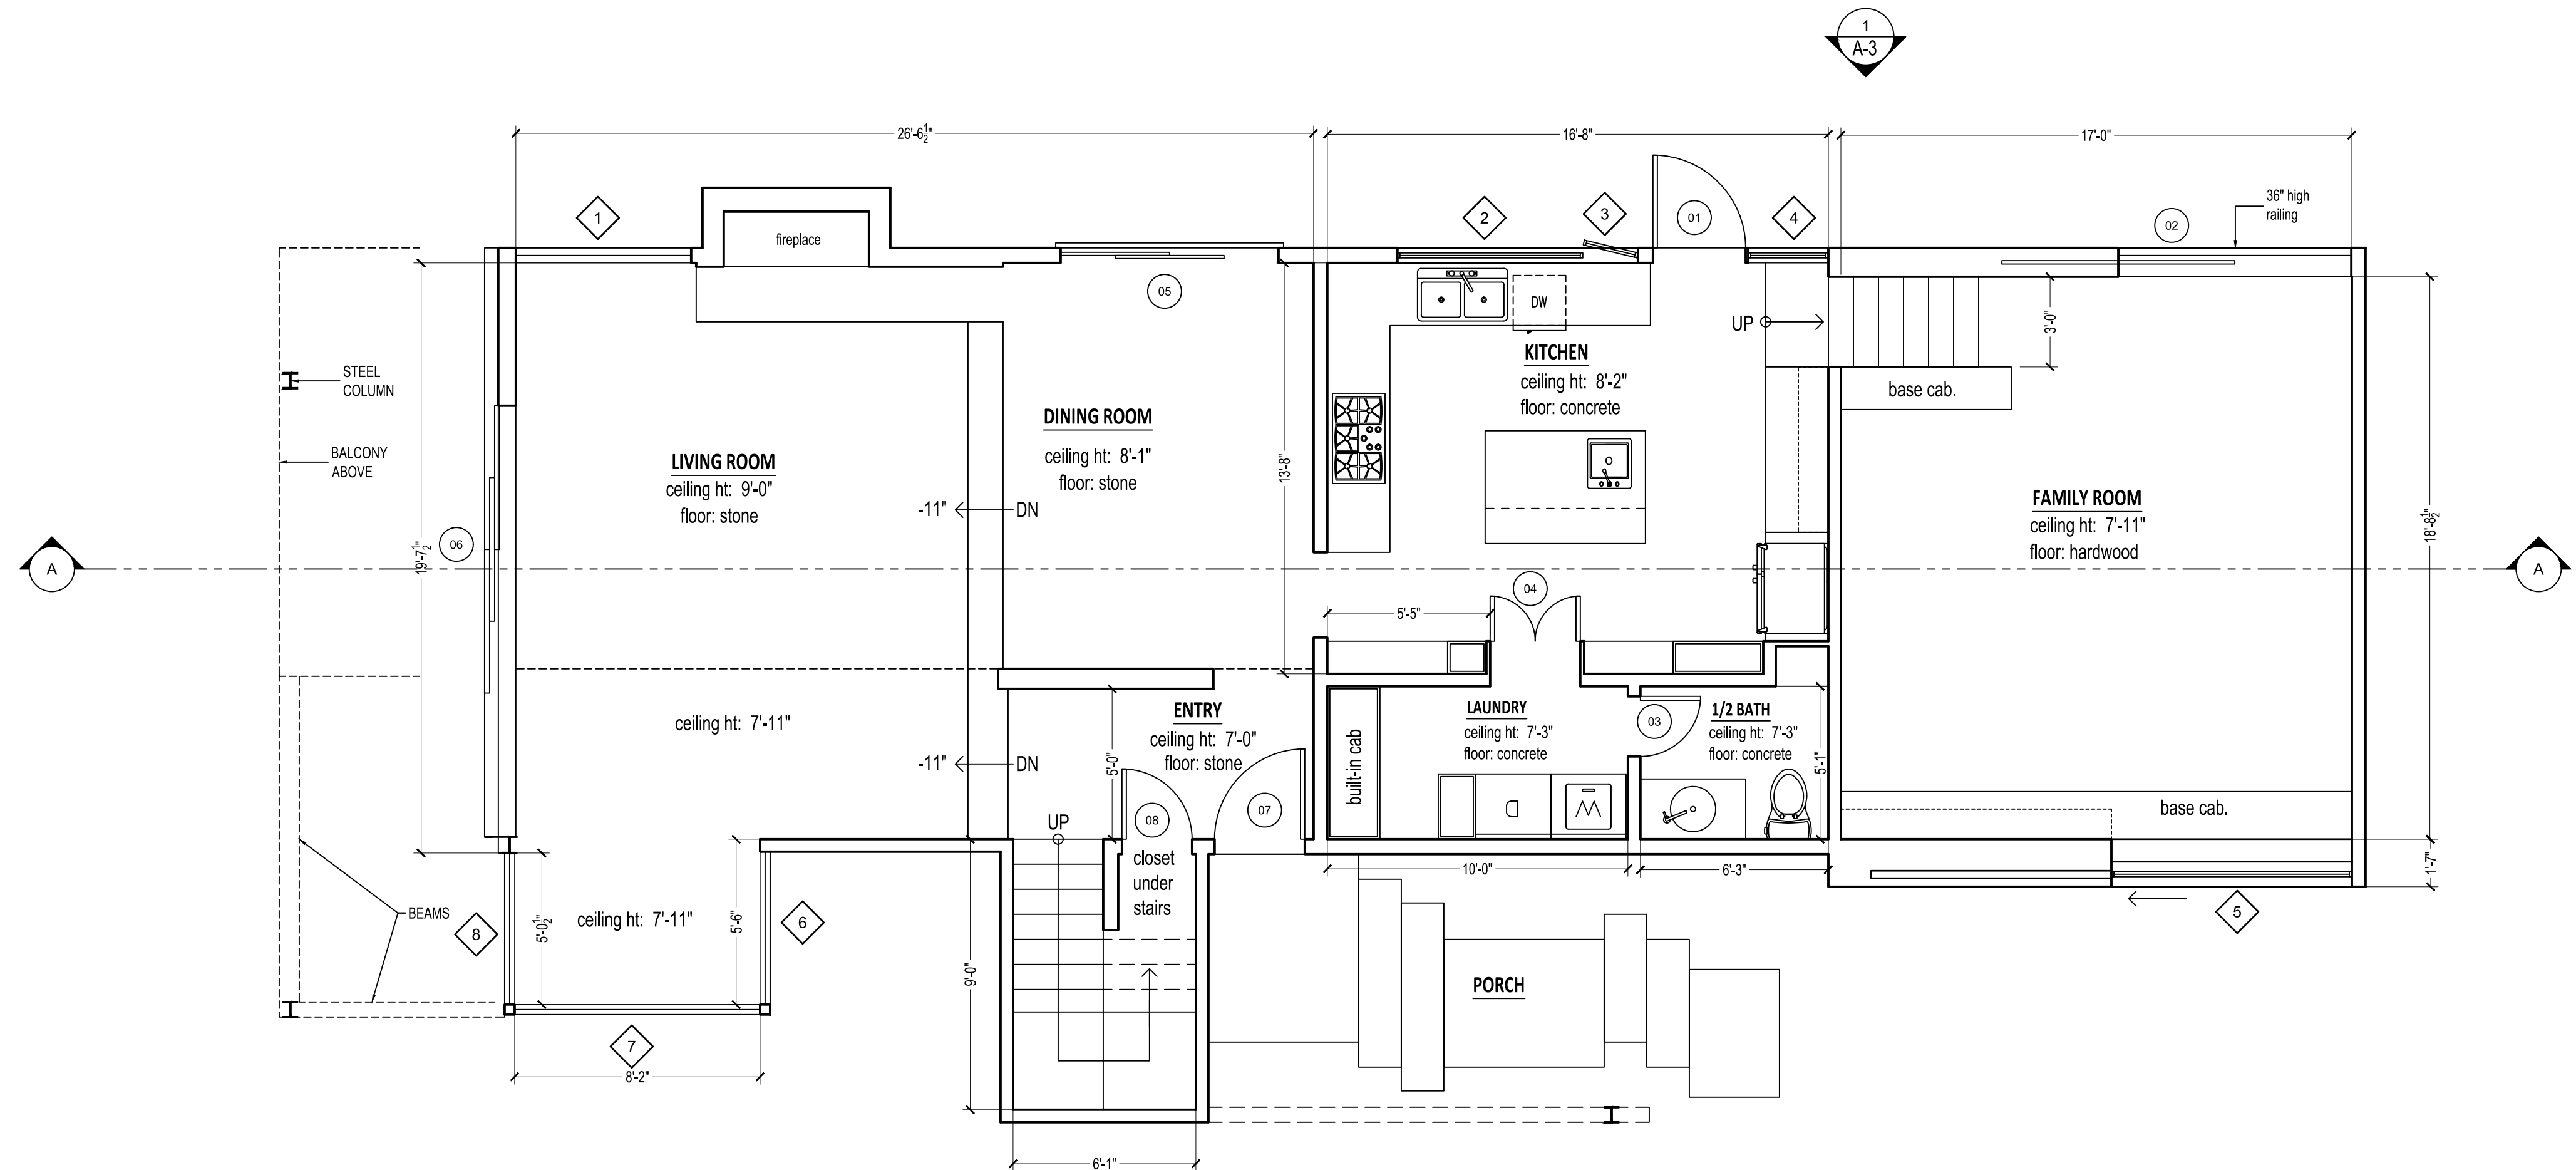



FIRST FLOOR PLAN

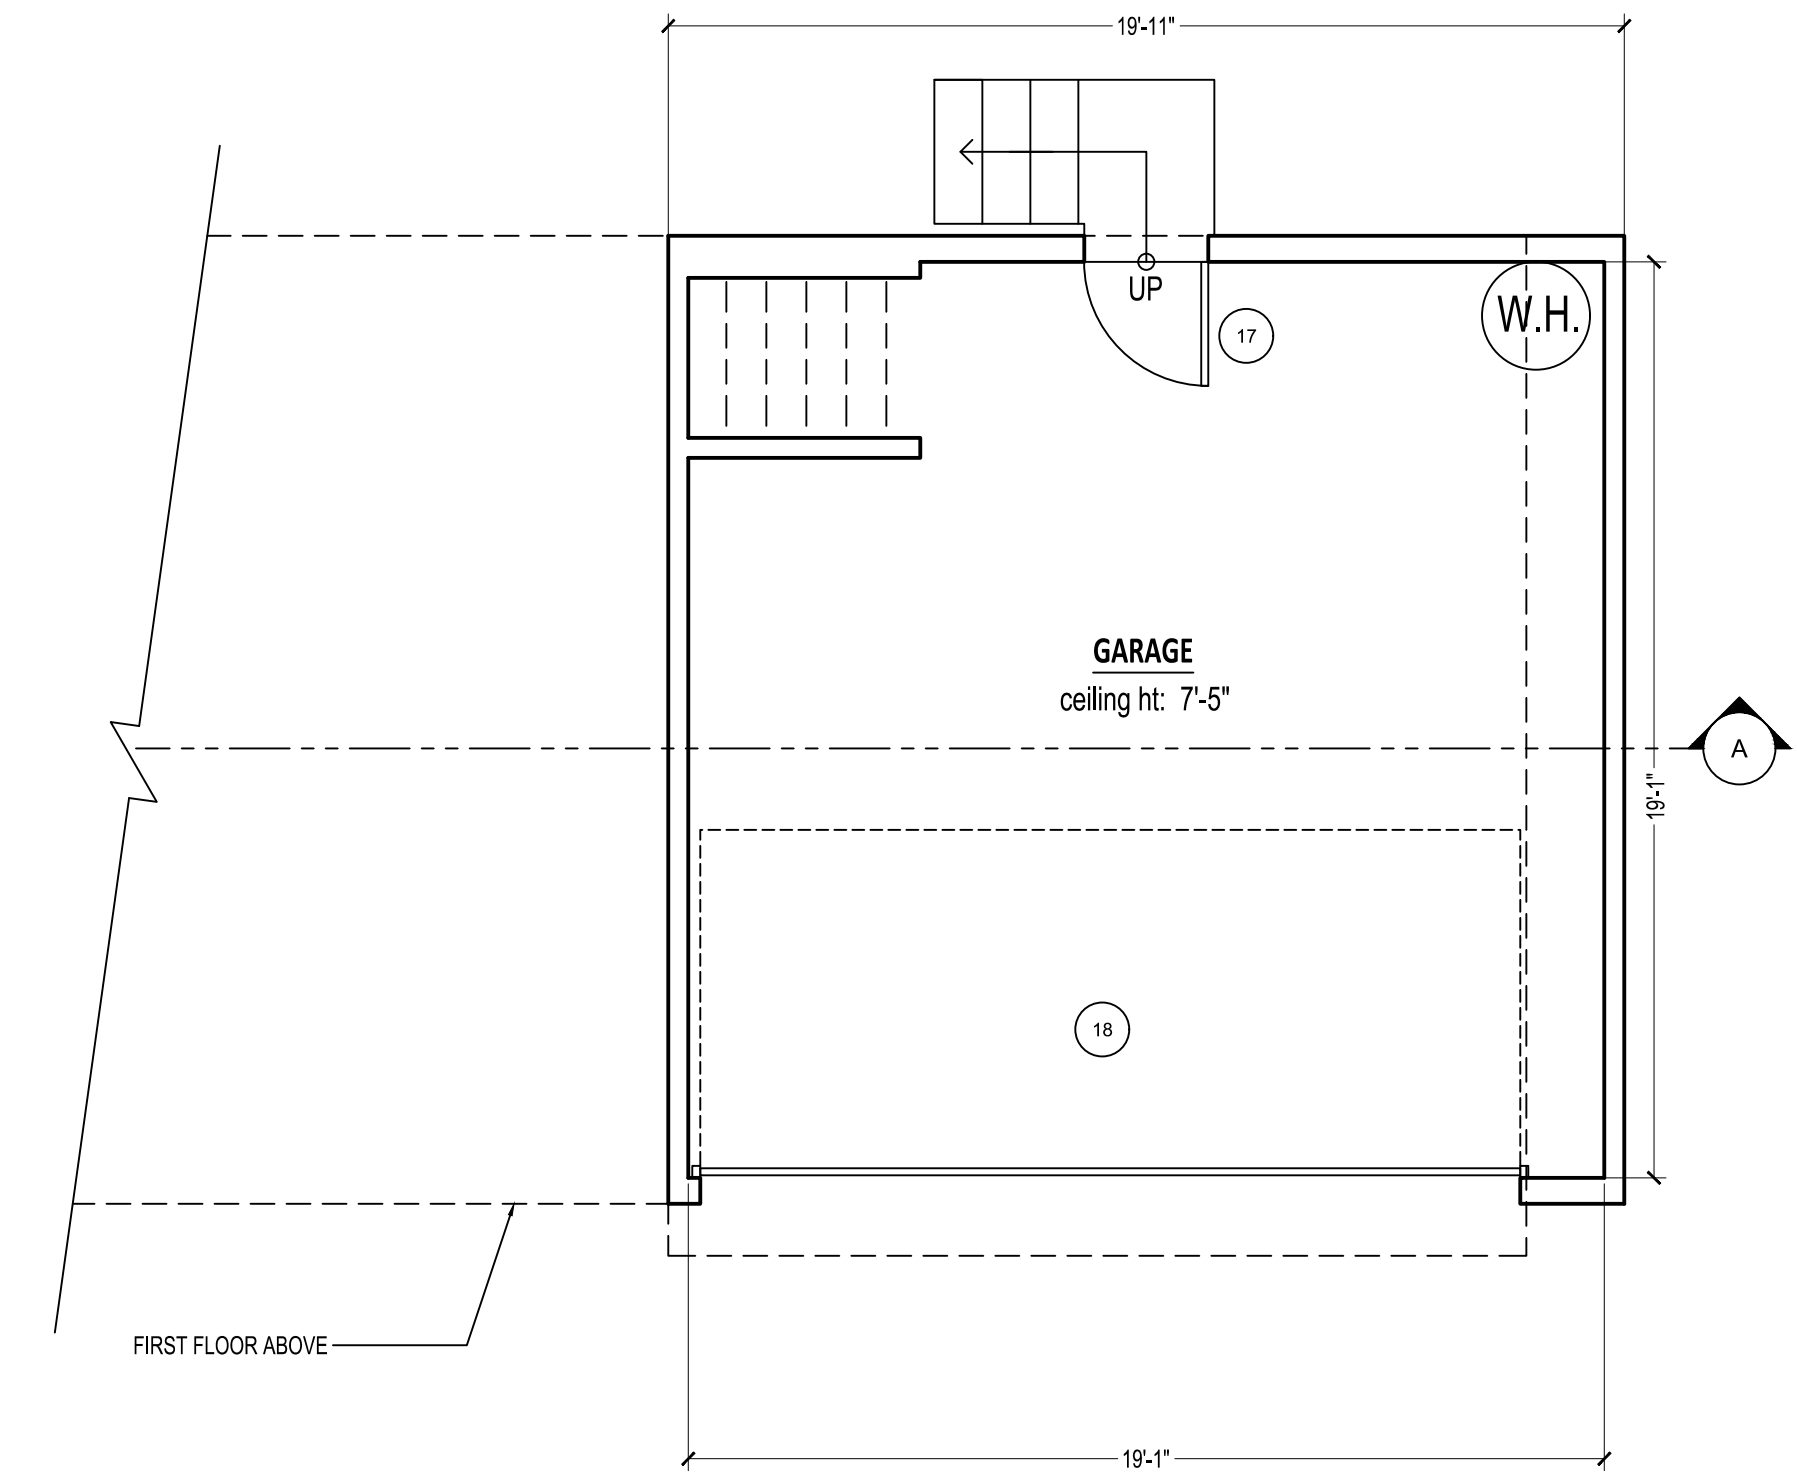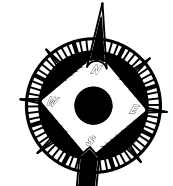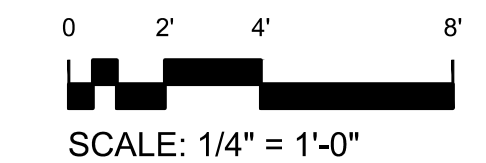

LOWER FLOOR/GARAGE FLOOR PLAN

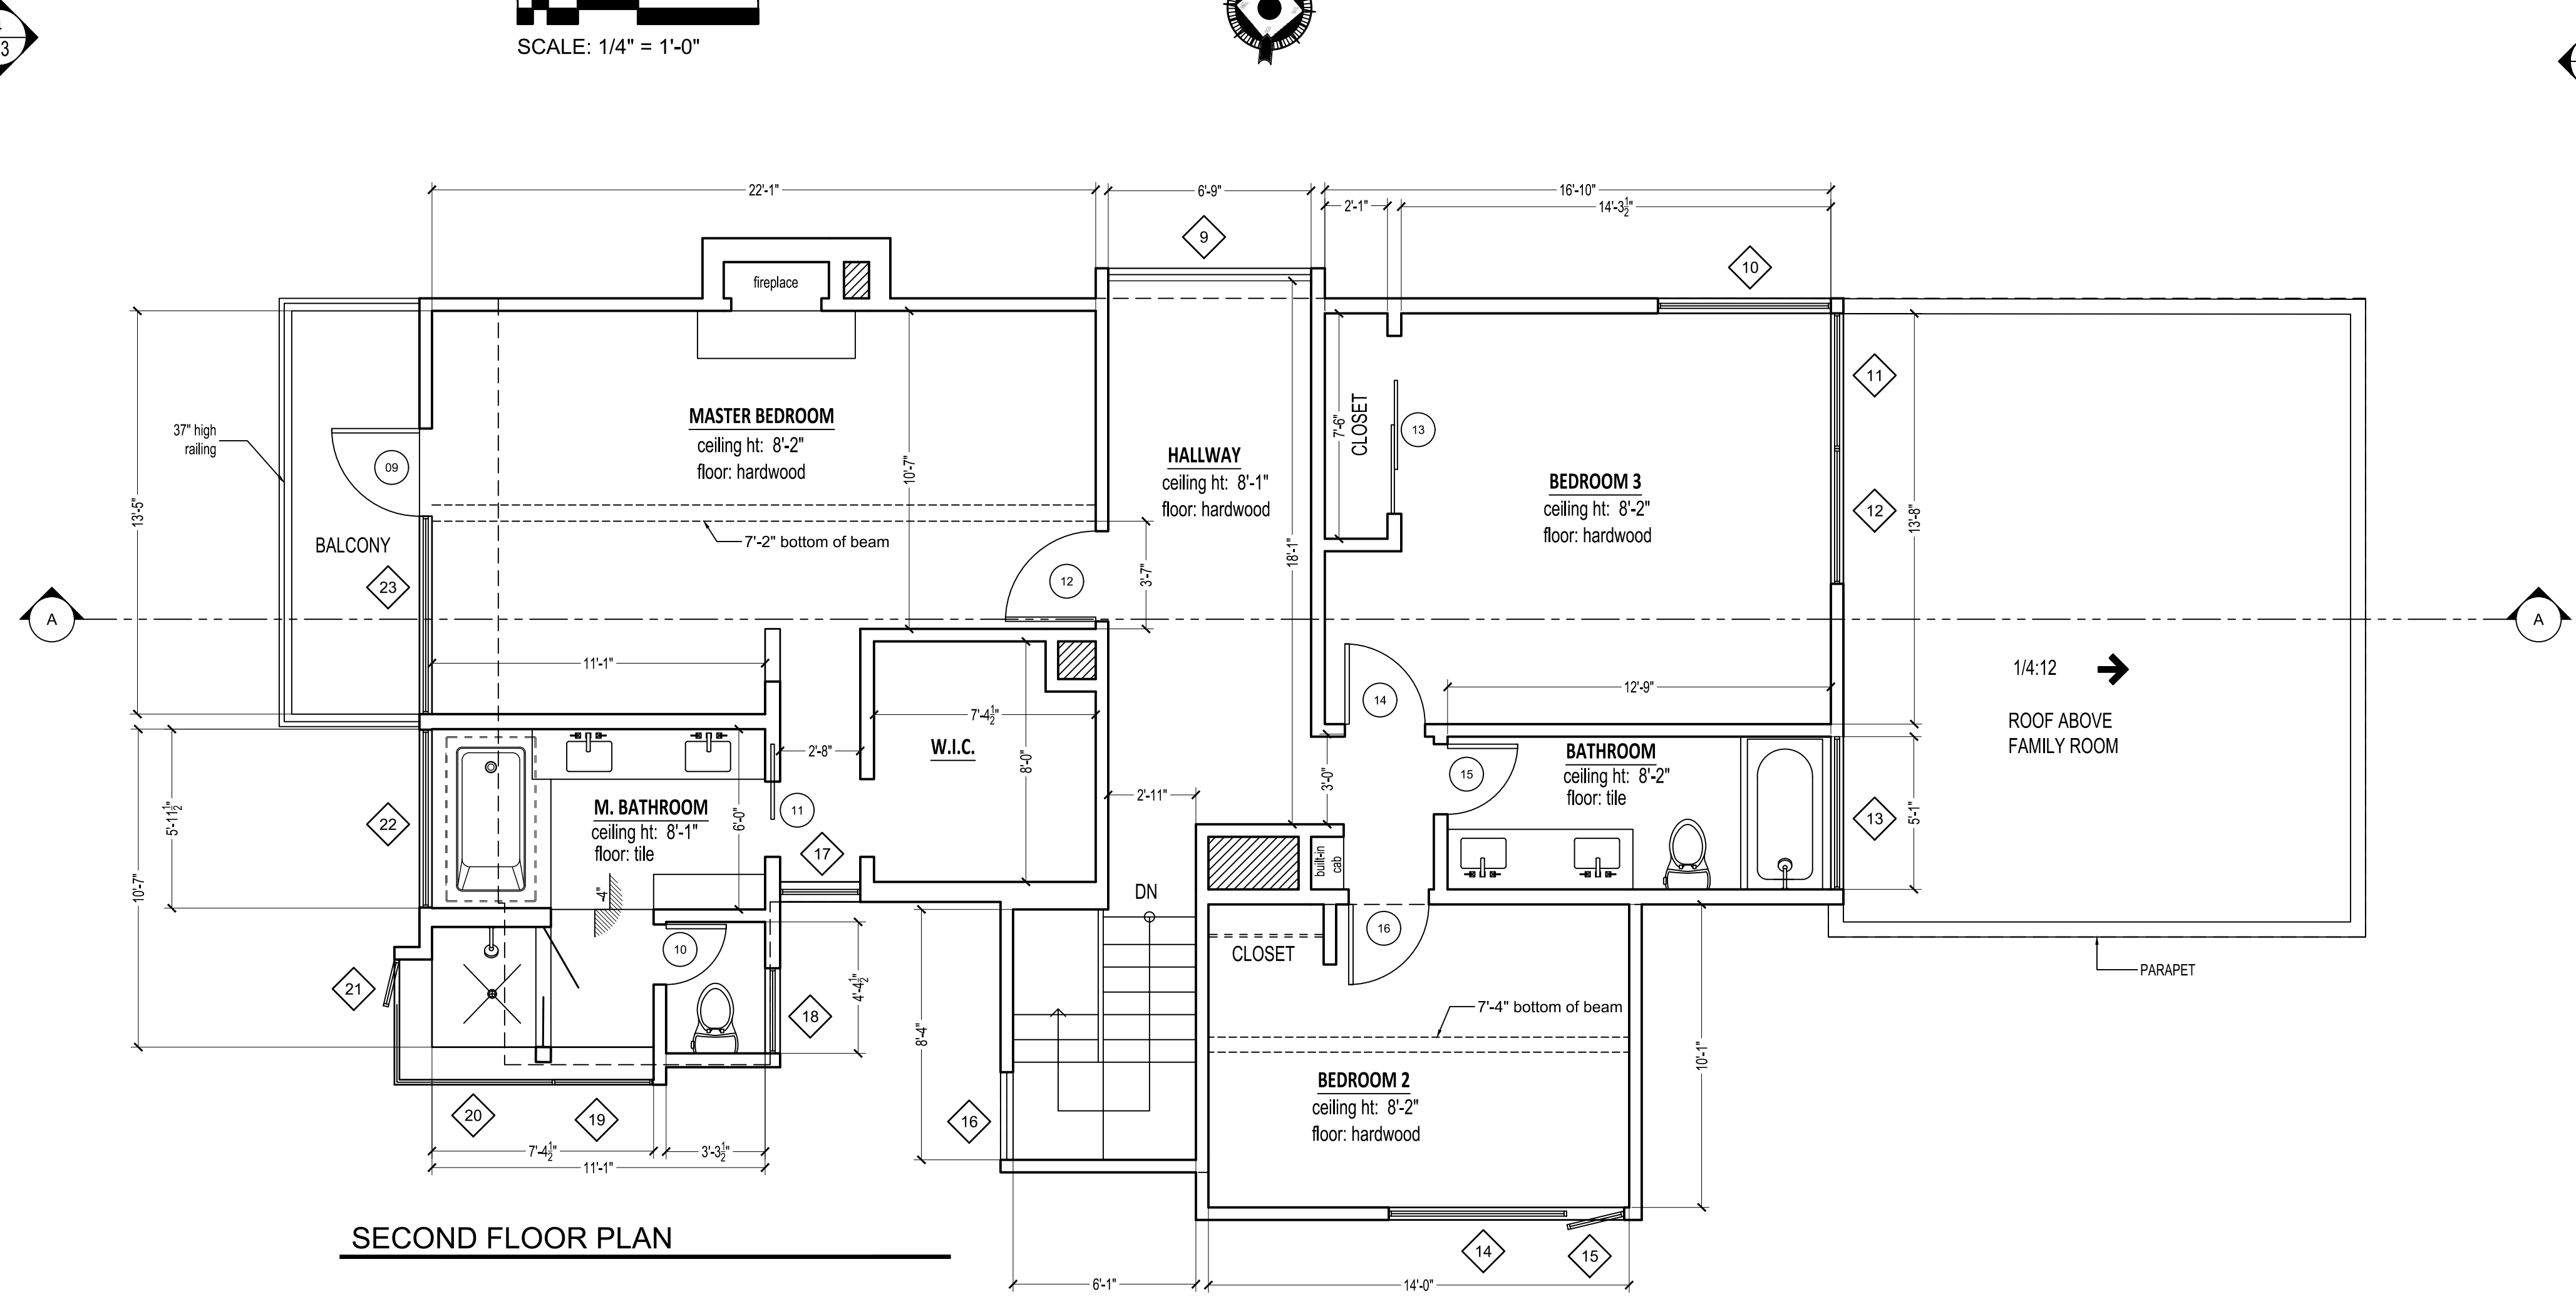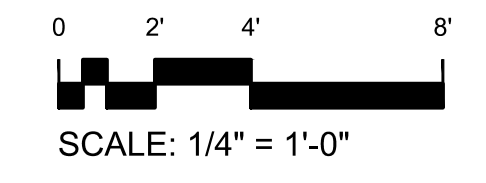

SECOND FLOOR PLAN

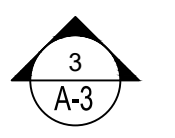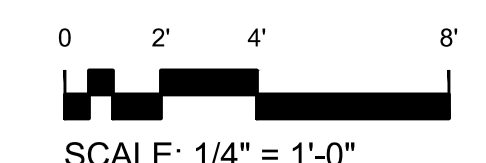

DOOR SCHEDULE				
MARK	DOOR SIZE		Type	NOTES
	WD	HGT		
1	3'-1"	7'-11"	FRENCH	---
2	7'-9"	7'-11"	POCKET	---
3	2'-0"	6'-8"	SWING	---
4	3'-0"	6'-8"	SWING DOUBLE	---
5	7'-3"	6'-8"	SLIDING DOUBLE	---
6	14'-4"	7'-10"	SLIDING TRIPLE	---
7	3'-0"	6'-8"	SWING	---
8	2'-4"	6'-8"	SWING	---
9	2'-11"	7'-0"	FRENCH	---
10	2'-0"	6'-8"	SWING	---
11	2'-8"	7'-0"	POCKET	---
12	3'-0"	6'-8"	SWING	---
13	5'-11"	6'-8"	SLIDING - DOUBLE	---
14	2'-8"	6'-8"	SWING	---
15	2'-4"	6'-8"	SWING	---
16	2'-8"	6'-8"	SWING	---
17	2'-7"	6'-8"	SWING	---
18	17'-1"	7'-0"	GARAGE DOOR	---

WINDOW SCHEDULE					
MARK	SIZE		TYPE	Head Height	NOTES
	Width	HEIGHT			
1	5'-10"	7'-10"	FIXED	6'-8"	---
2	6'-2"	3'-10"	FIXED	7'-11"	---
3	1'-10"	3'-10"	CASEMENT	7'-11"	---
4	2'-8"	7'-11"	FIXED	7'-11"	---
5	8'-0"	2'-8"	POCKET	6'-8"	---
6	5'-1"	7'-11"	FIXED	7'-11"	---
7	8'-2"	7'-11"	FIXED	7'-11"	---
8	5'-0 1/2"	7'-11"	FIXED	7'-11"	---
9	6'-9"	8'-1"	FIXED	8'-1"	---
10	5'-9"	4'-8"	AWNING	8'-1"	---
11	4'-8"	2'-4"	AWNING	8'-1"	---
12	4'-8"	2'-4"	AWNING	8'-1"	---
13	5'-1"	2'-4"	AWNING	8'-2"	---
14	5'-11"	4'-6"	FIXED	8'-1"	---
15	1'-11"	4'-6"	CASEMENT	8'-1"	---
16	2'-11"	8'-10"	FIXED	7'-8"	---
17	7'-8"	6'-0"	FIXED/AWNING	7'-7"	---
18	2'-10"	2'-10"	AWNING	7'-9"	---
19	3'-4"	2'-9"	AWNING	8'-1"	---
20	2'-8" x 5'-3"	2'-9"	FIXED	7'-9"	---
21	1'-7"	2'-9"	CASEMENT	8'-1"	---
22	5'-11"	6'-3"	FIXED/AWNING	8'-1"	---
23	6'-7"	5'-3"	FIXED/AWNING	7'-0"	---


REVISIONS	BY

**AS-BUILT**  
LOS ANGELES


Sheet content :  
**ELEVATIONS**

Project :  
2730 La Cuesta Dr  
Los Angeles, CA 90046


Owner:  
Date  
Scale  
Drawn  
Job  
Sheet  
**A-3**

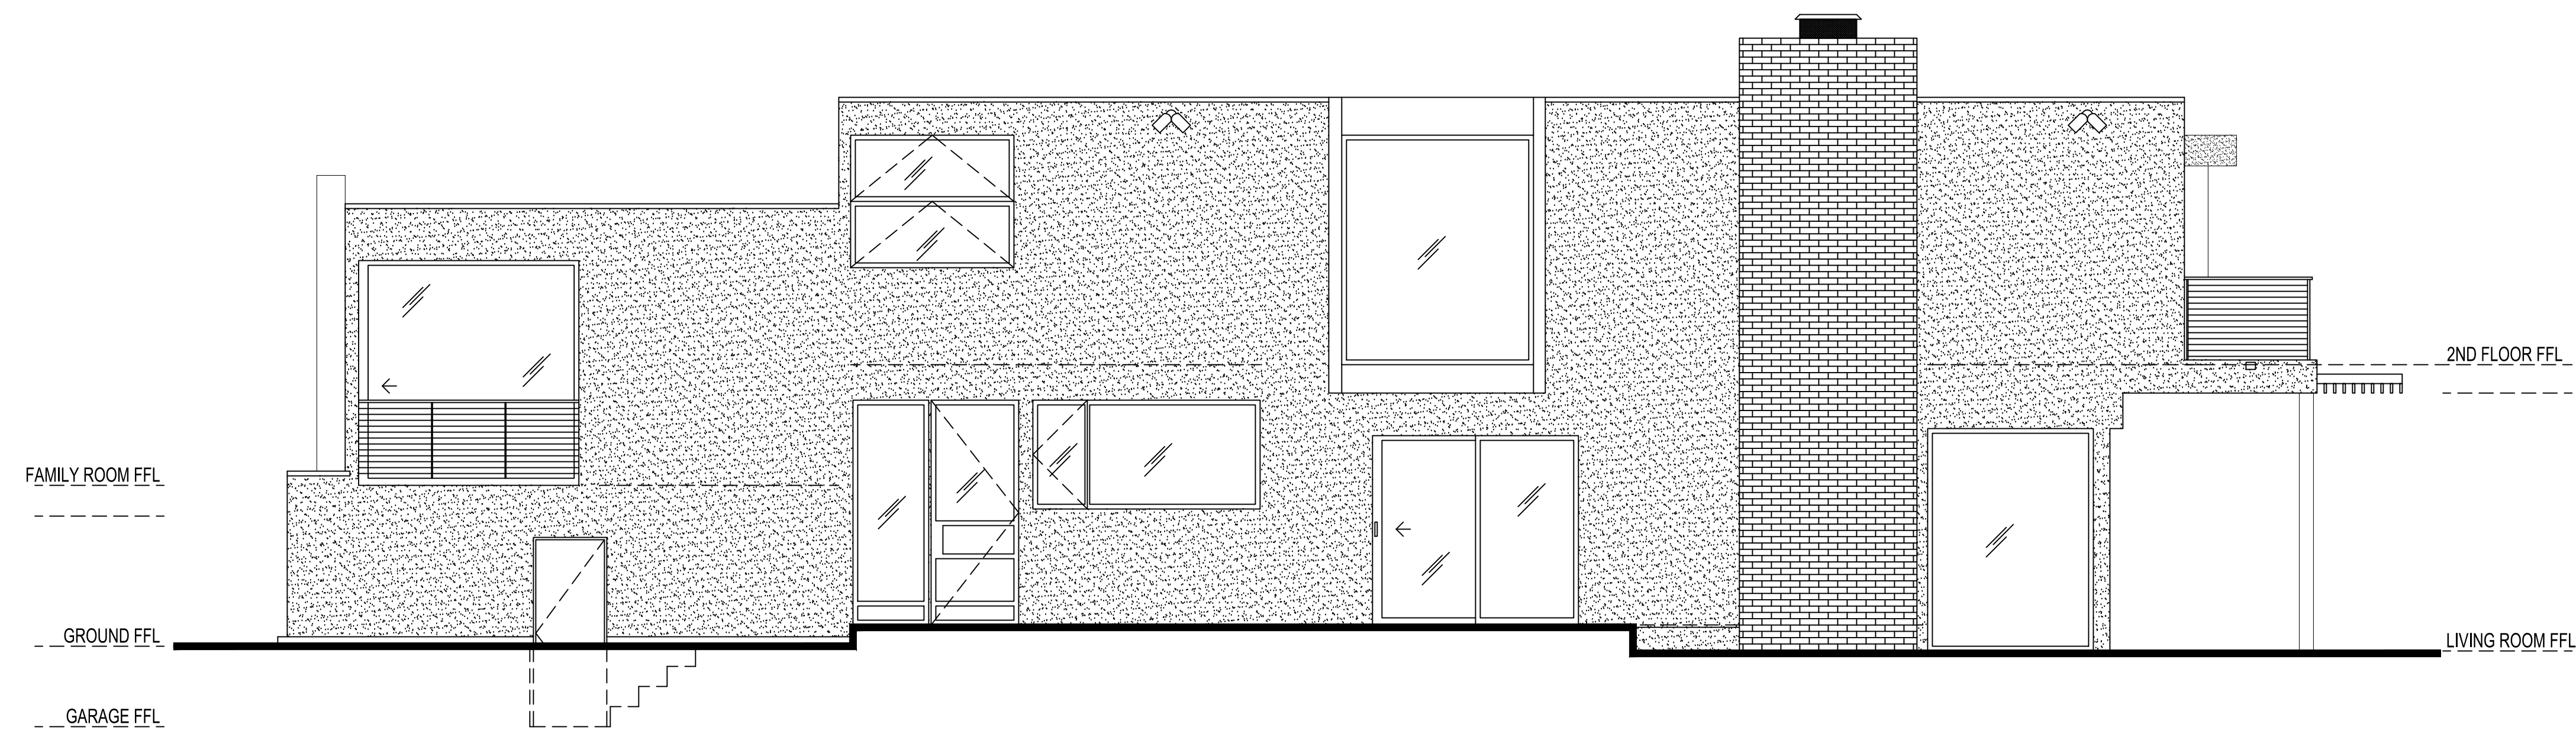


1 **N. ELEVATION**  
0 2' 4' 8'  
SCALE: 1/4" = 1'-0"

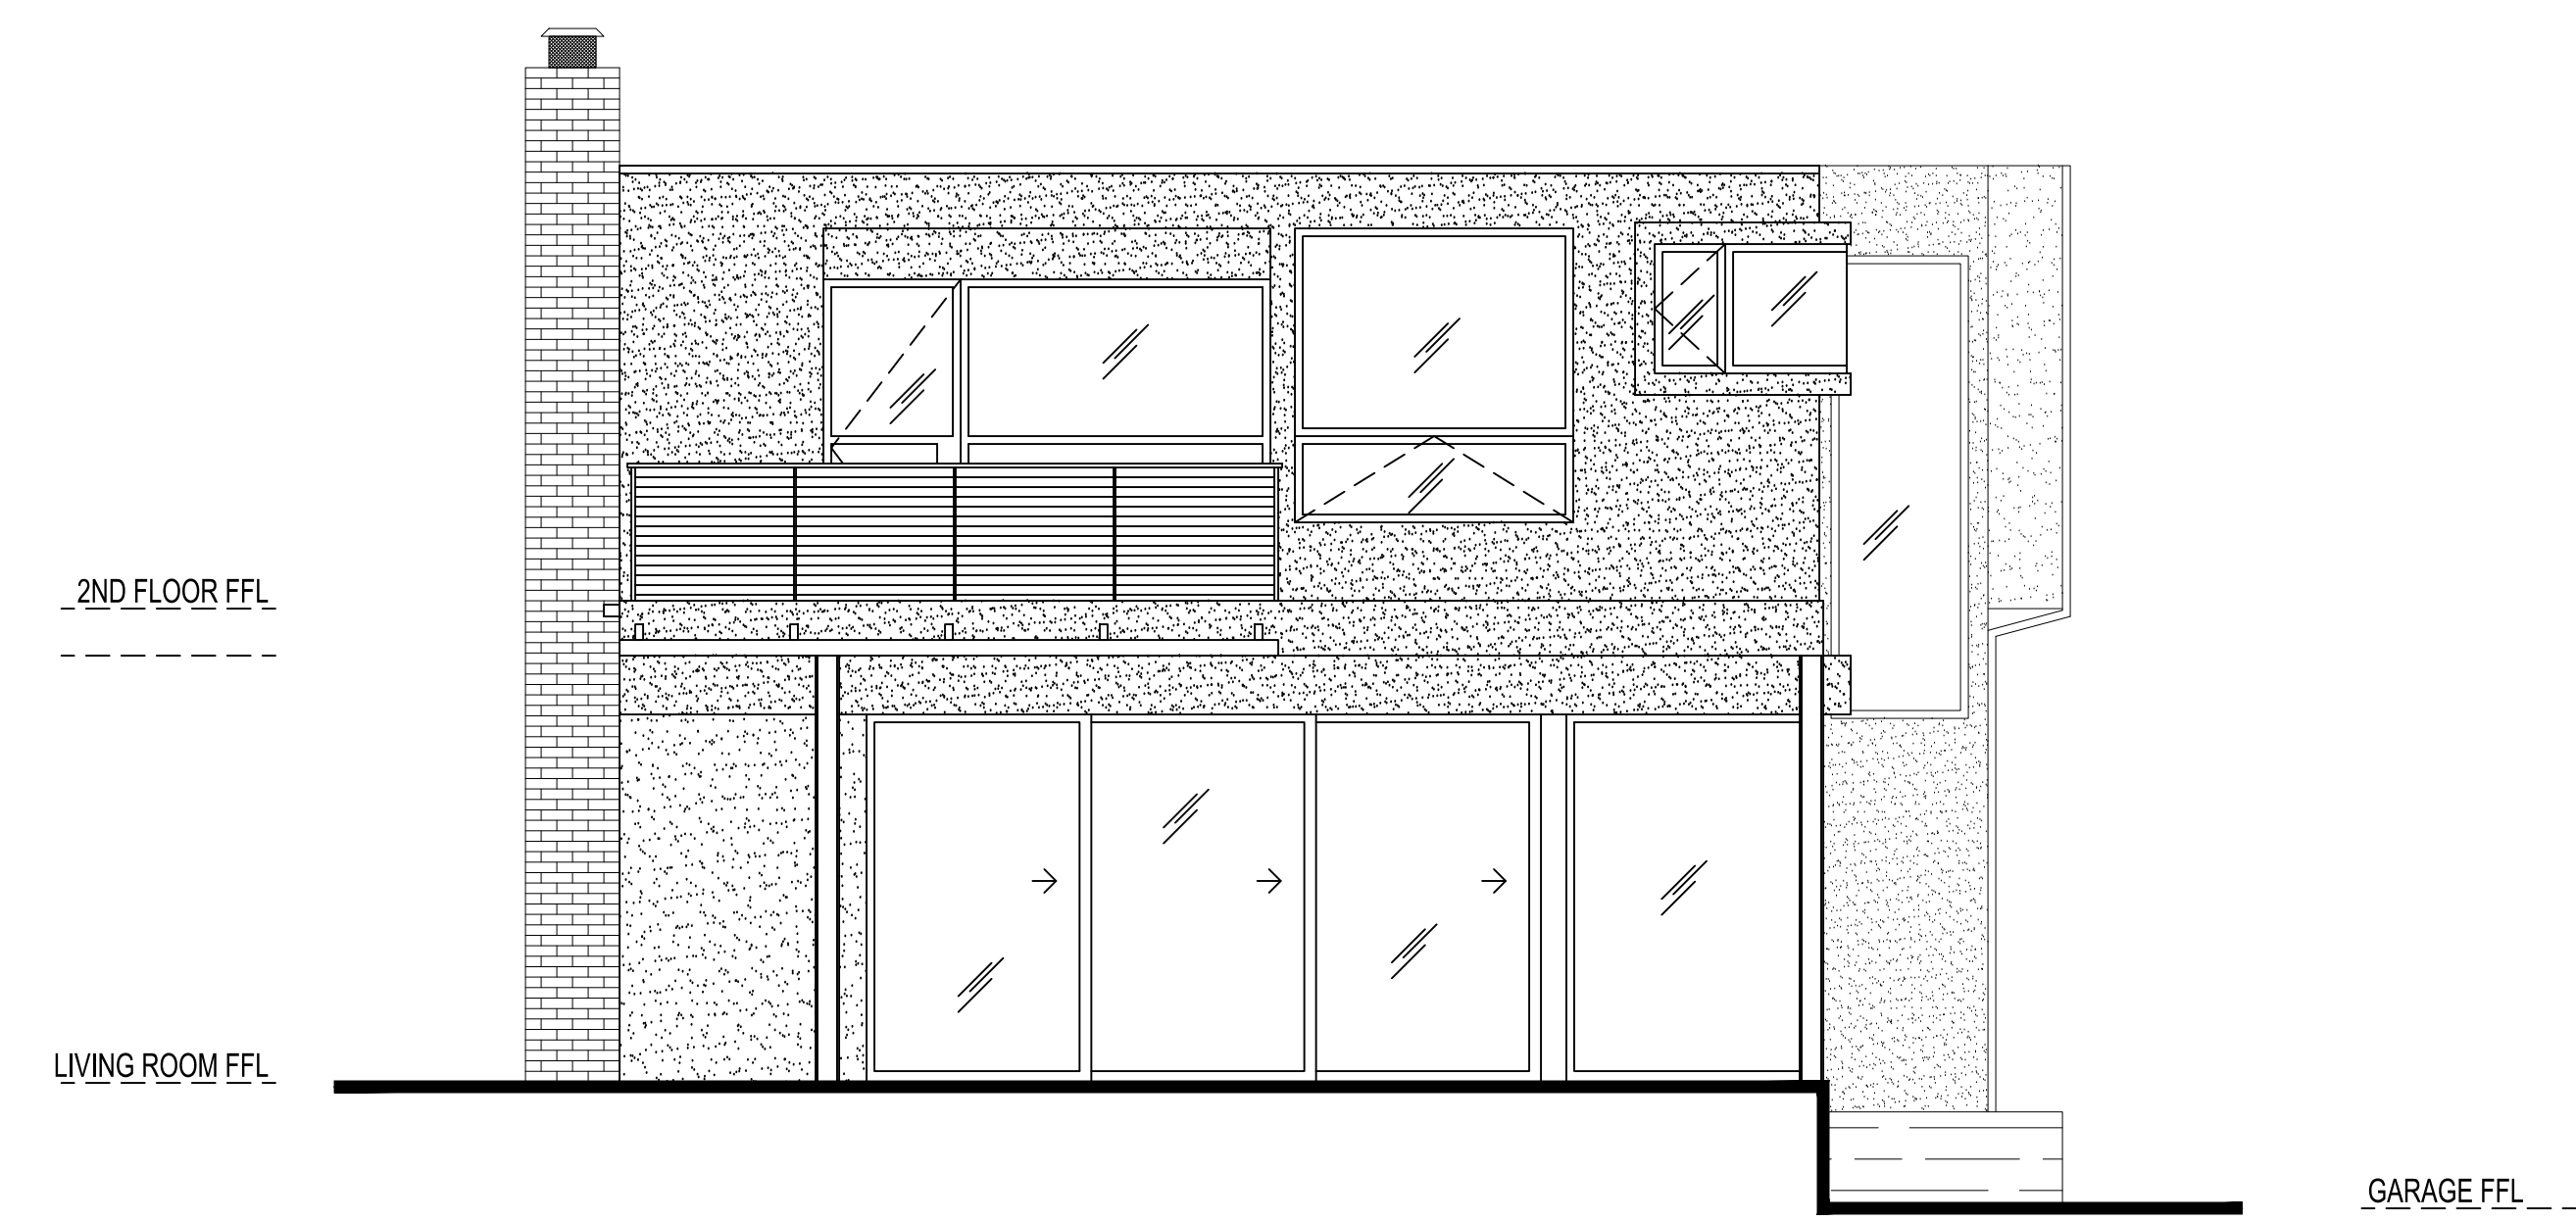


4 **W. ELEVATION**  
0 2' 4' 8'  
SCALE: 1/4" = 1'-0"

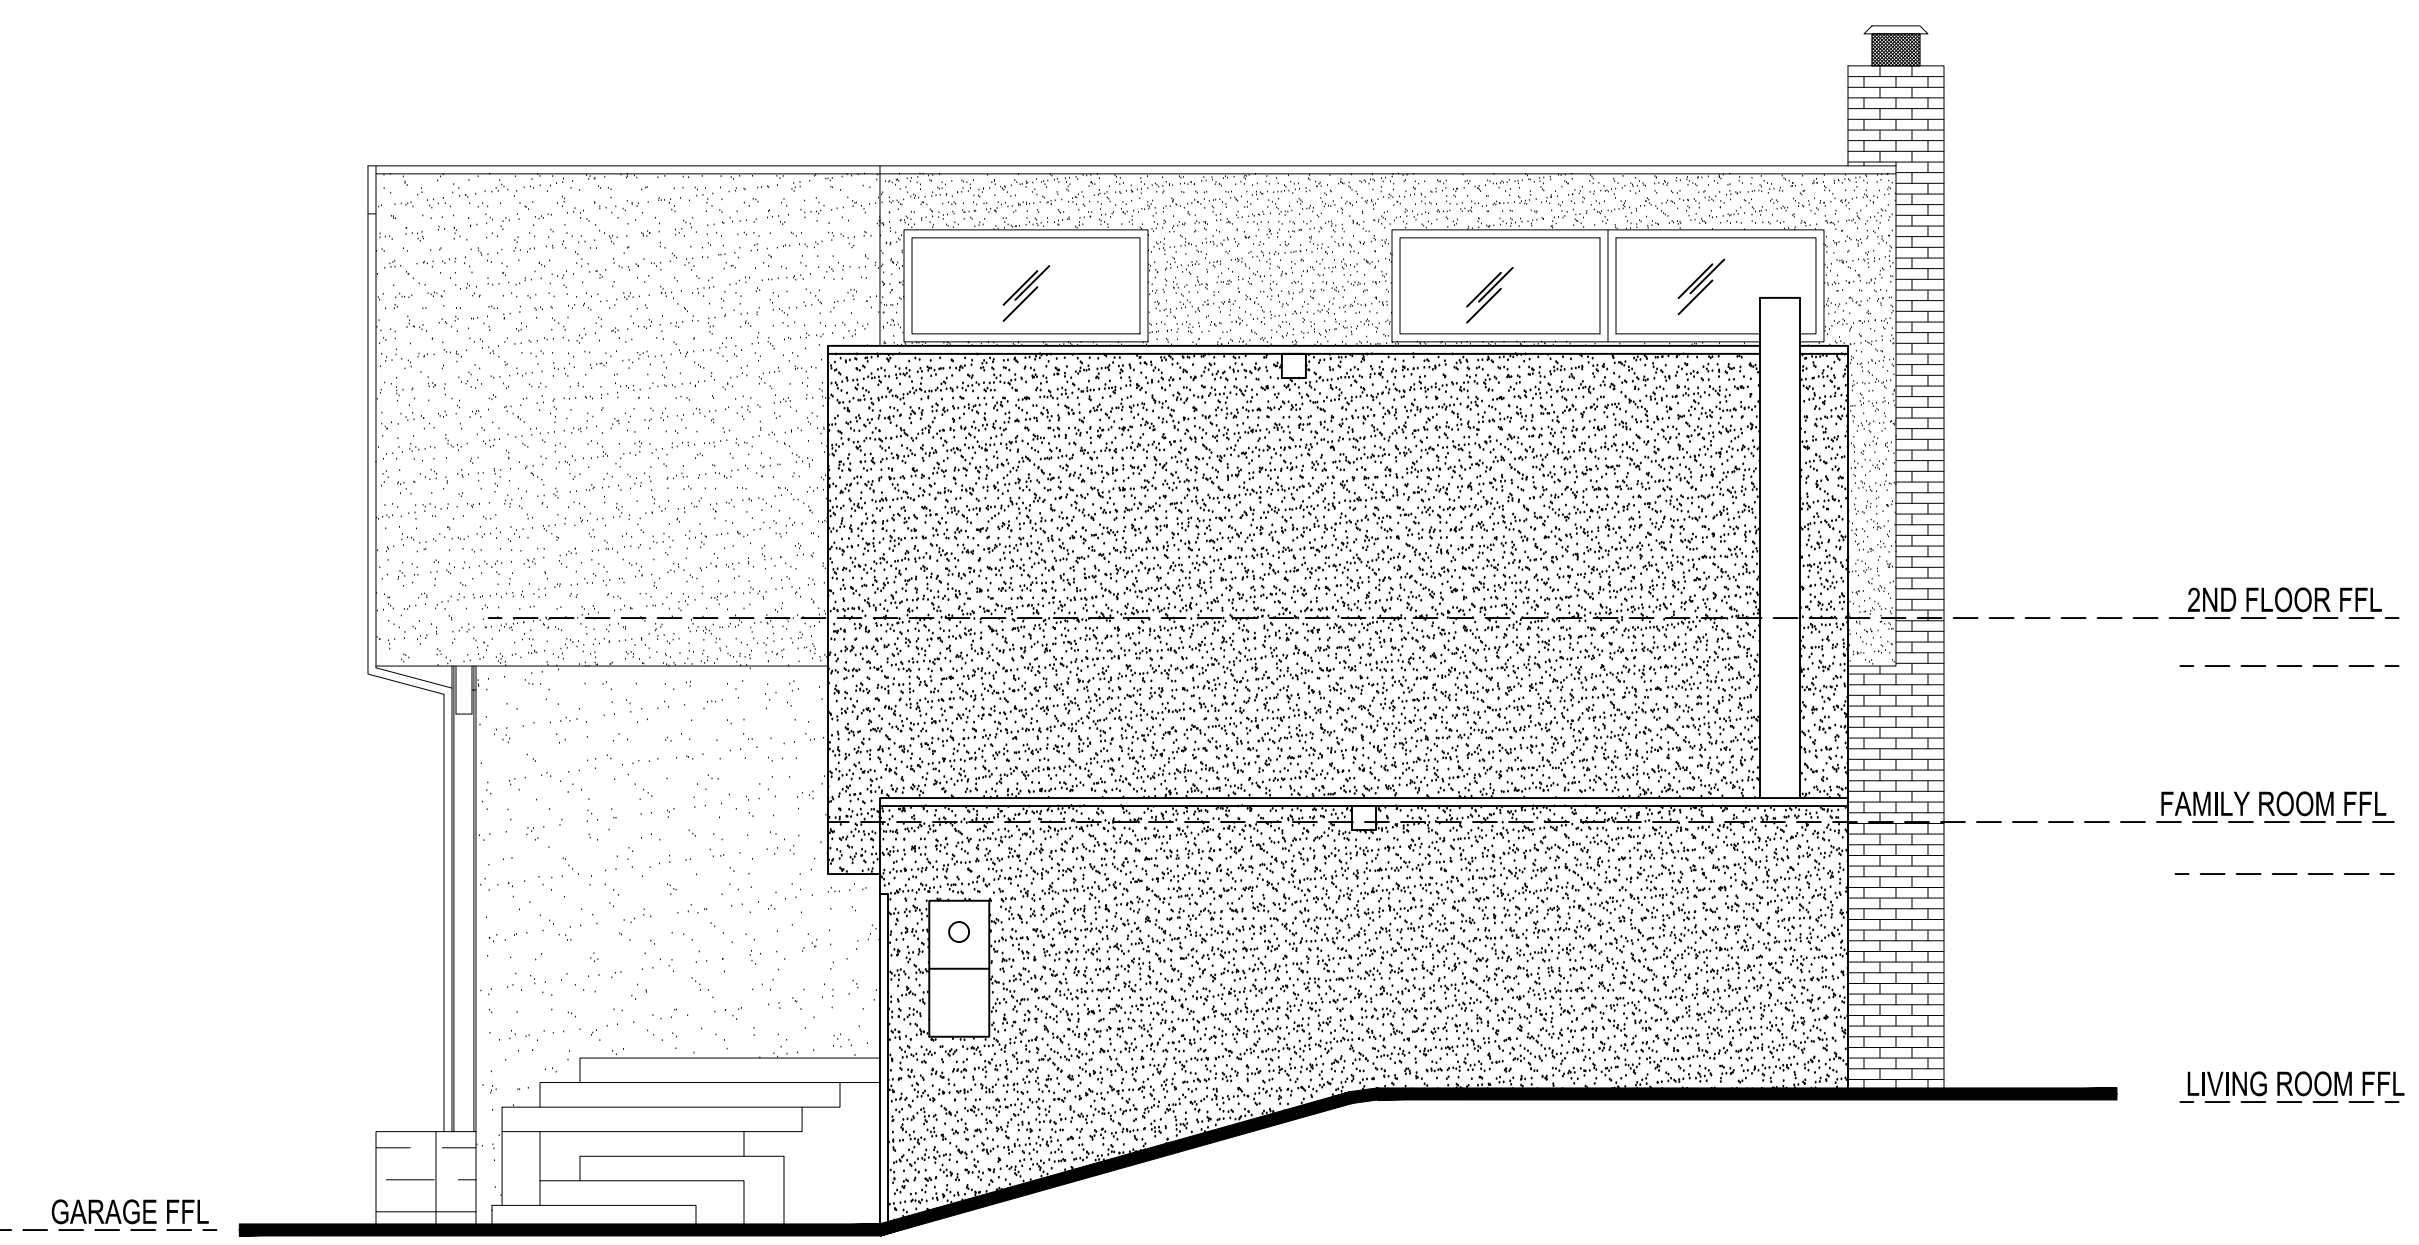



2 **E. ELEVATION**  
0 2' 4' 8'  
SCALE: 1/4" = 1'-0"

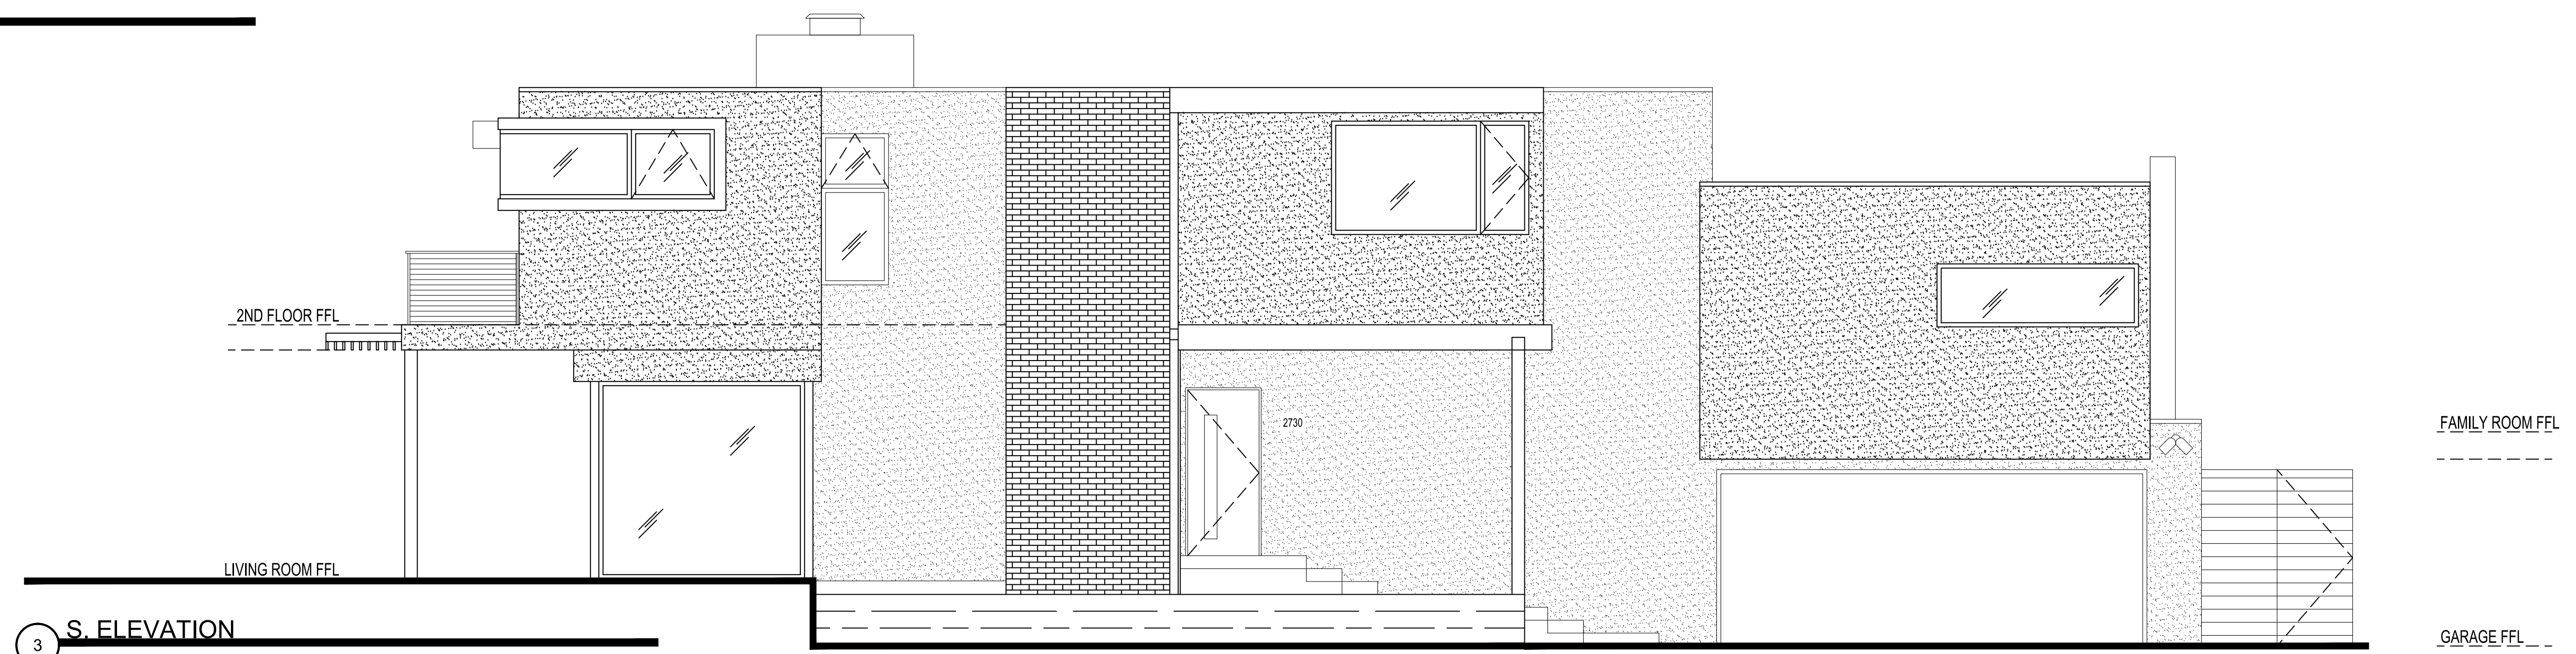


3 **S. ELEVATION**  
0 2' 4' 8'  
SCALE: 1/4" = 1'-0"

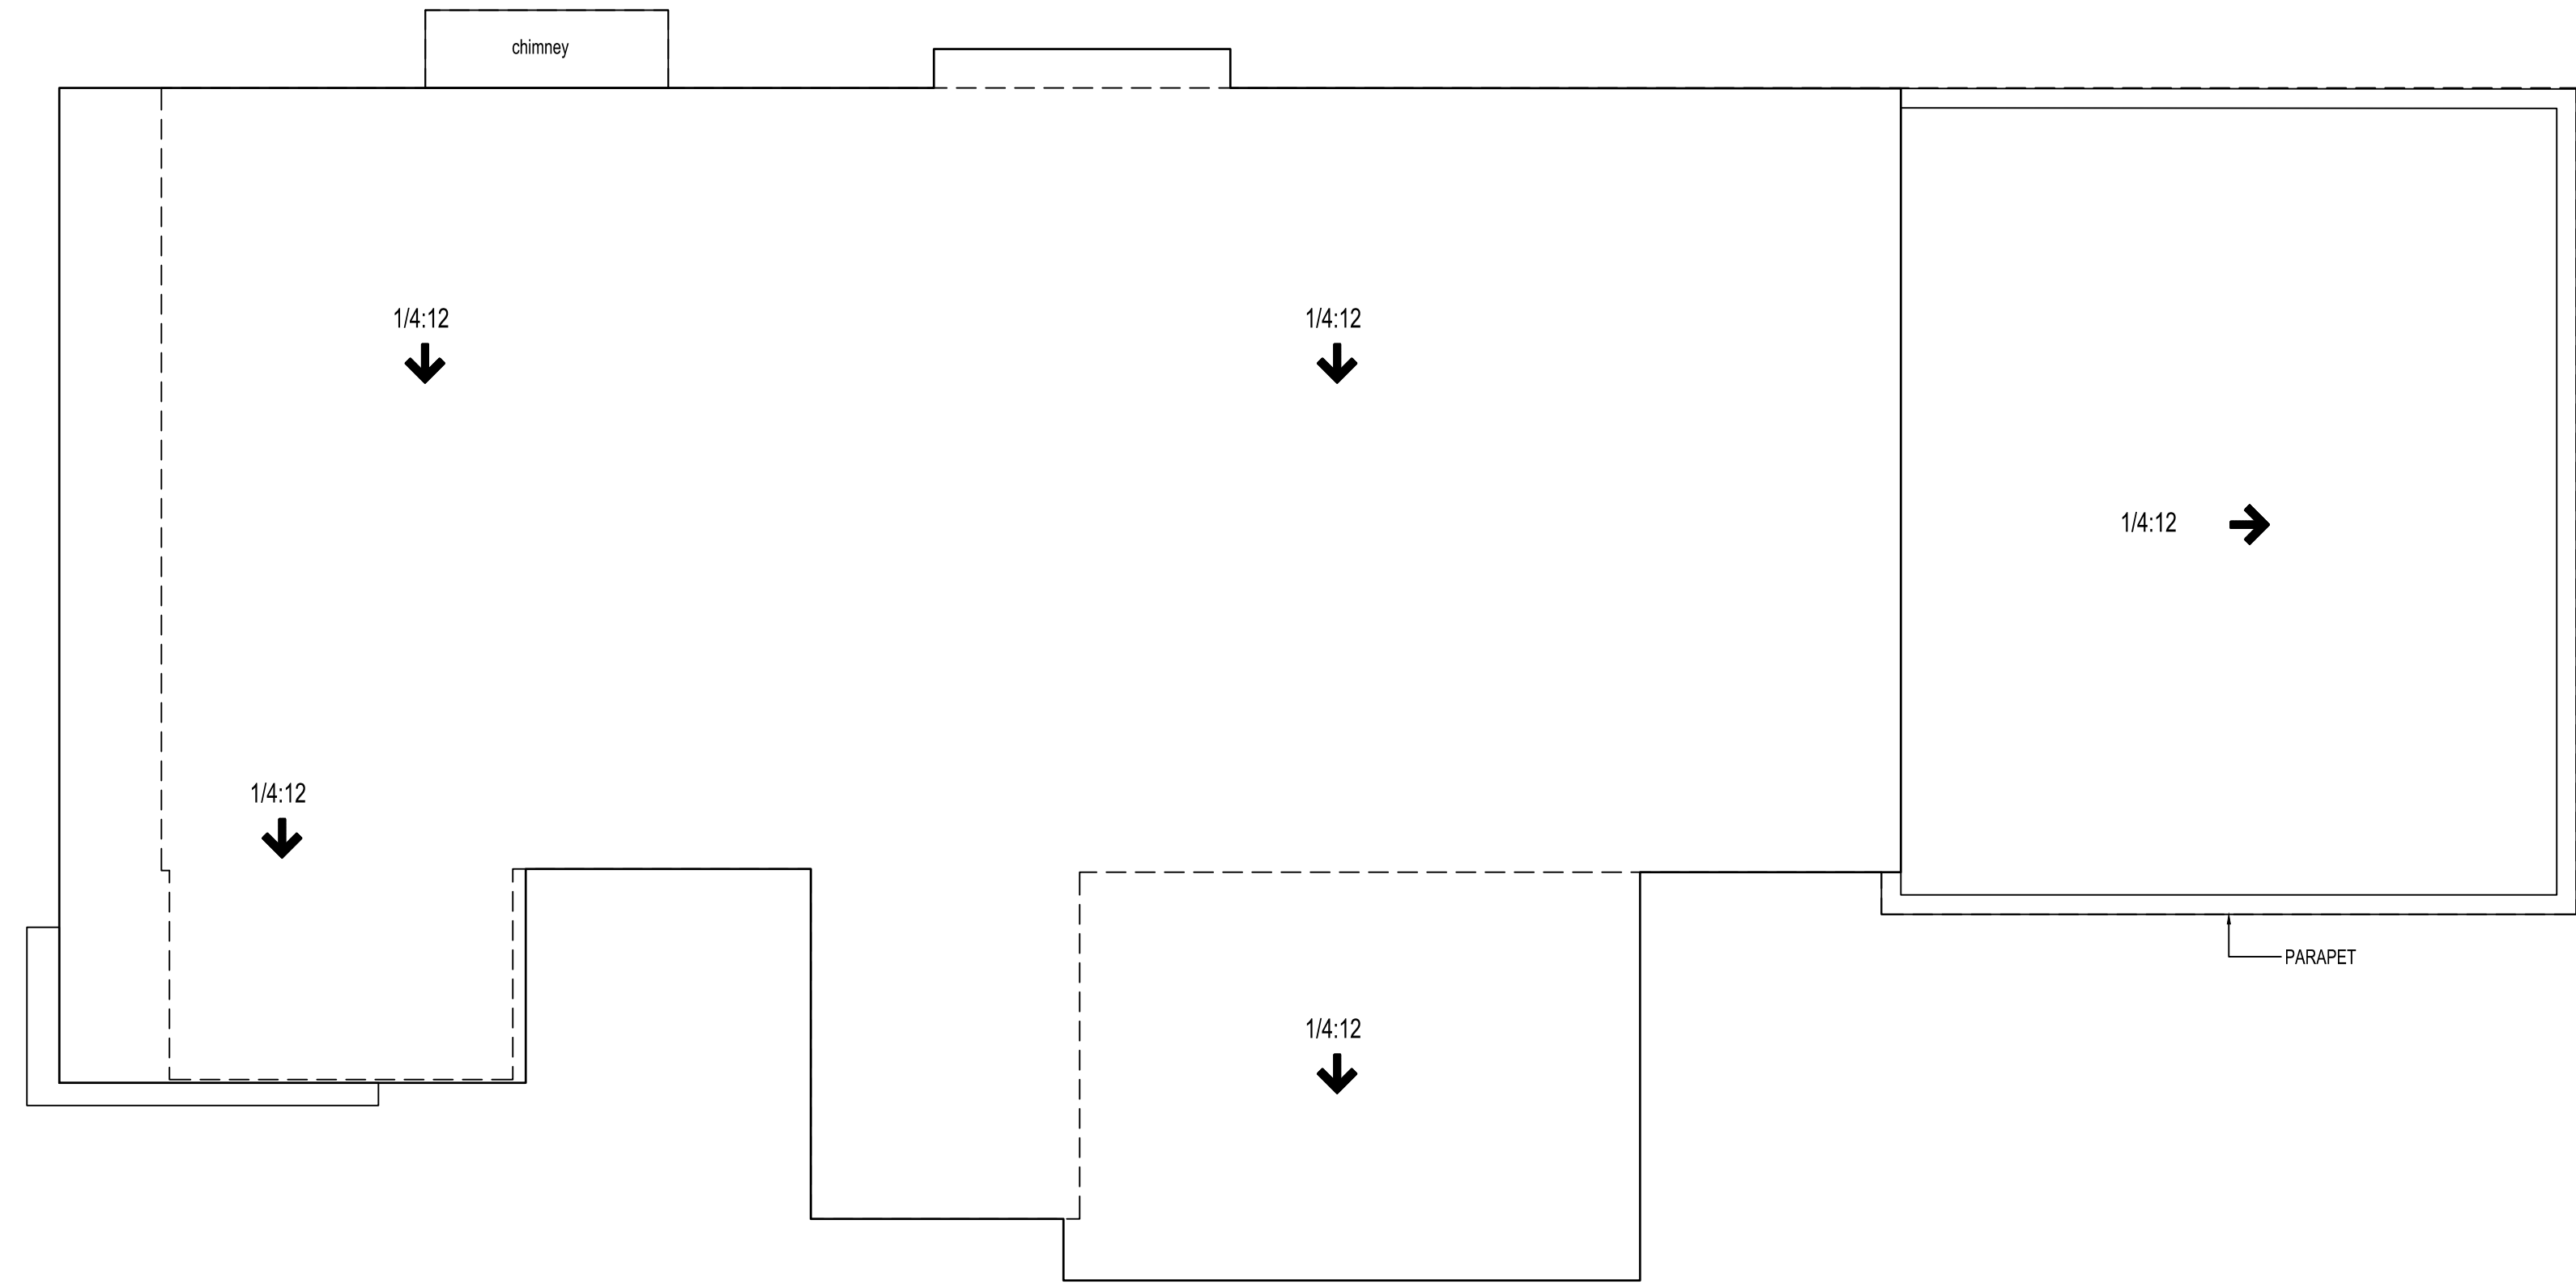

ROOF PLAN

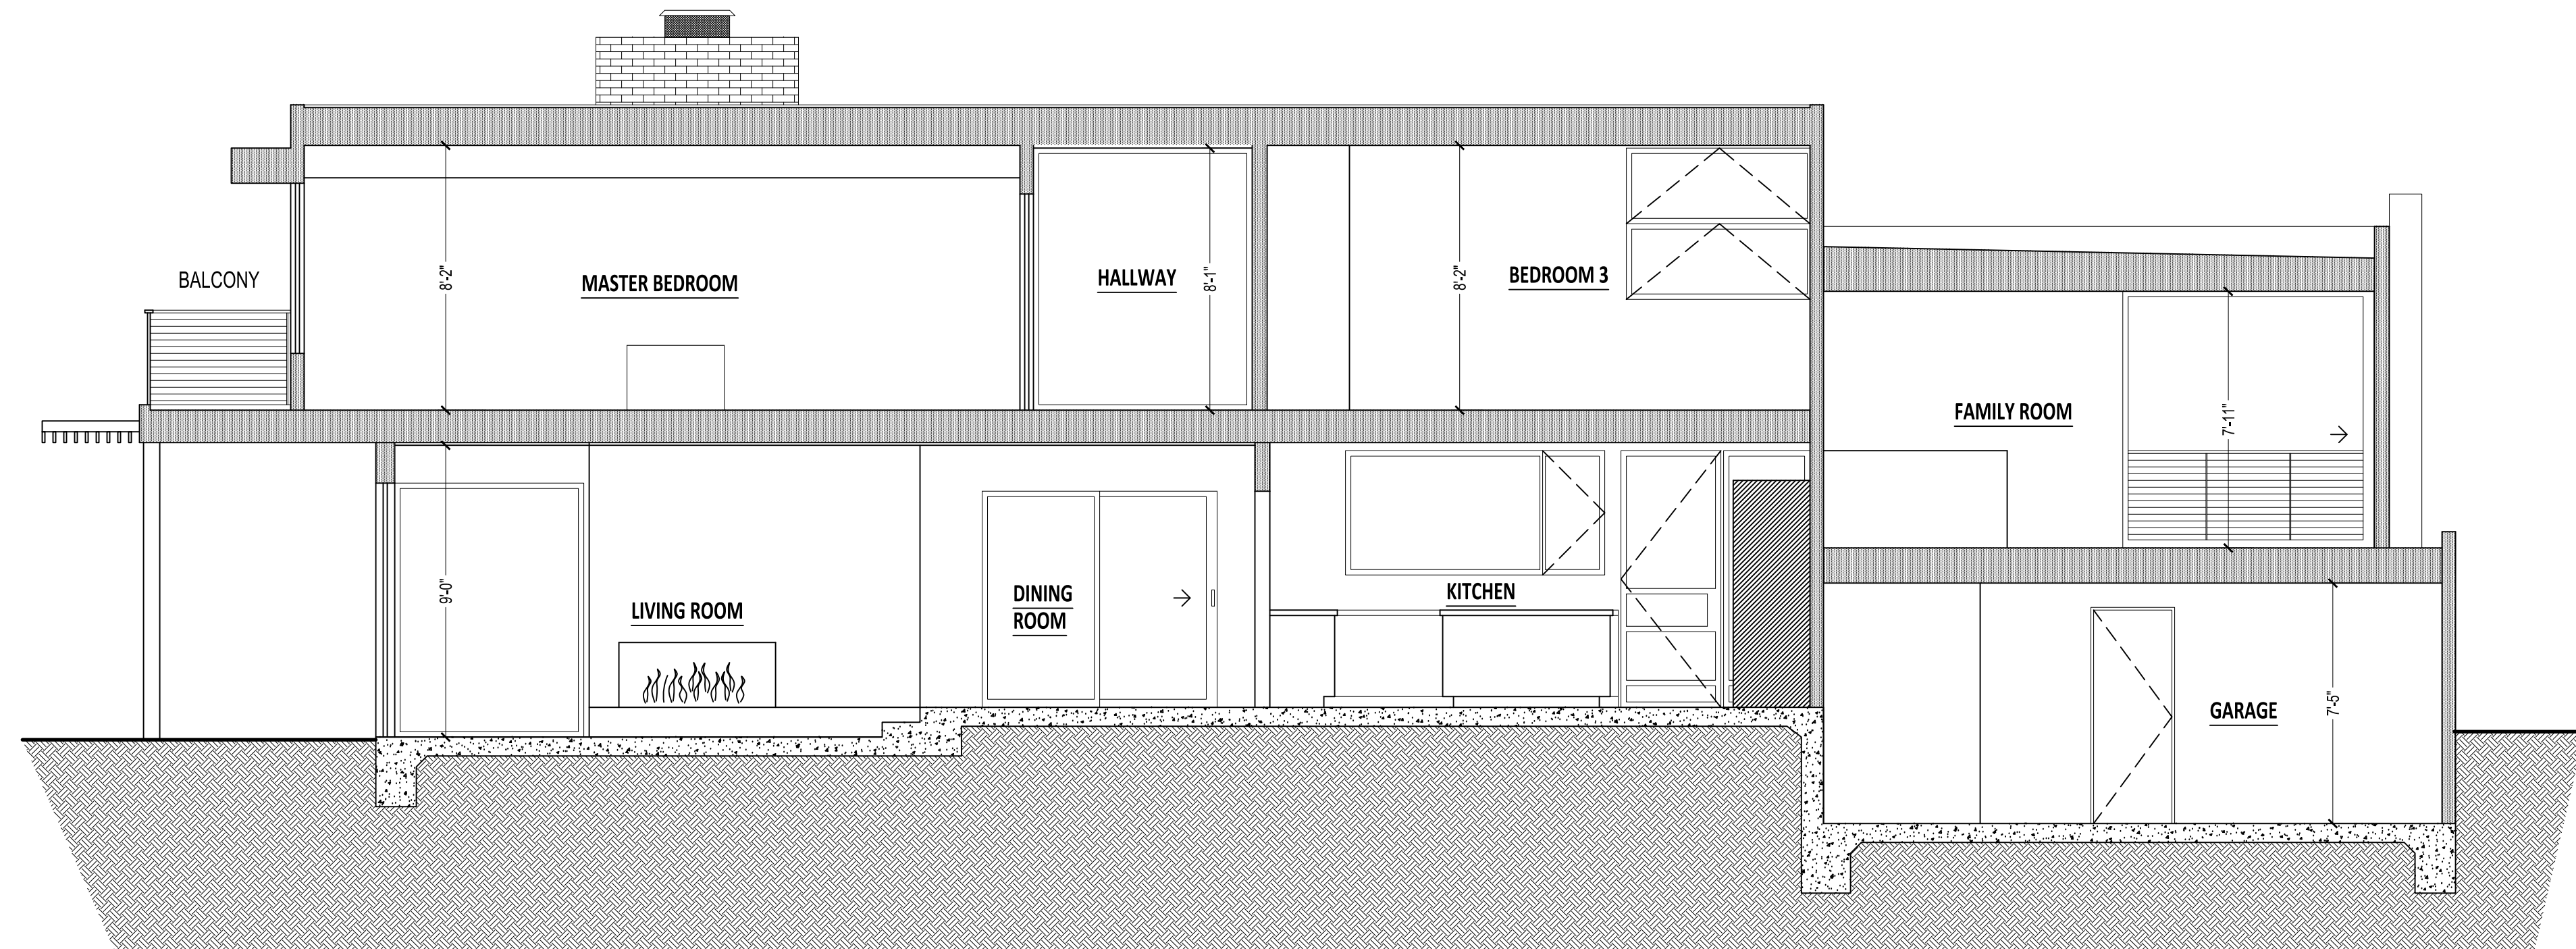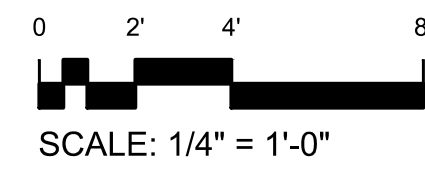

SECTION A-A

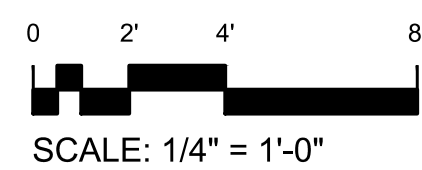

REVISIONS BY

**AS-BUILT**  
LOS ANGELES

Sheet content :  
ROOF PLAN  
SECTION

Project :  
2730 La Cuesta Dr  
Los Angeles, CA 90046

Owner:  
Date  
Scale  
Drawn  
Job  
Sheet

**A-4**

08.08.13