

REVISIONS	BY

AS-BUILT
LOS ANGELES

Sheet content :
PLOT PLAN

Project :
908 26TH ST
SANTA MONICA CA 90403


Owner:

Date
Scale
Drawn
Job
Sheet



A-1

08.26.13

26TH STREET

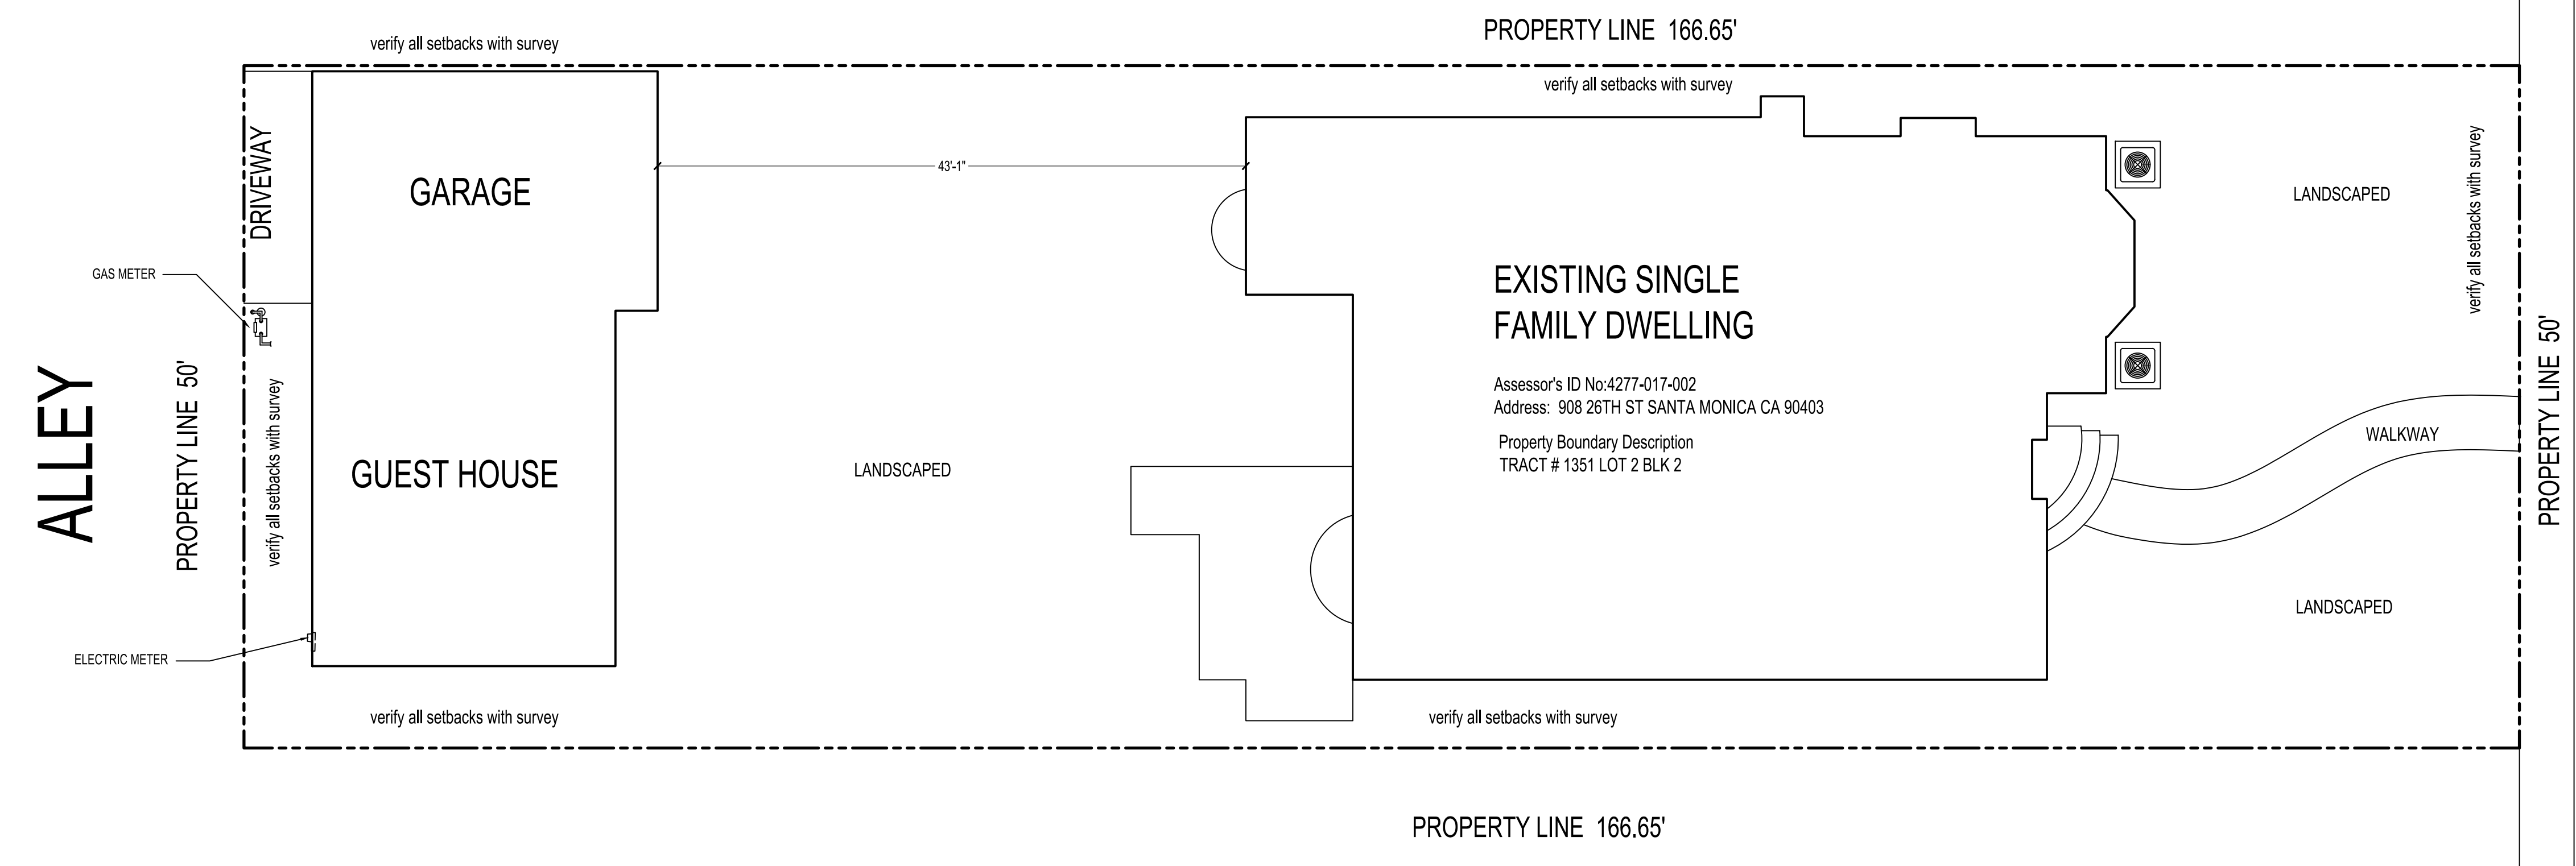


PLOT PLAN

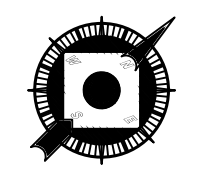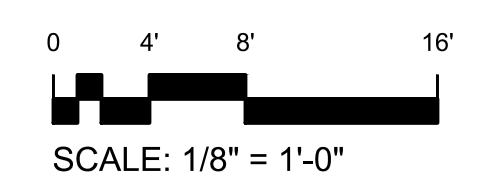

DOOR SCHEDULE				
MARK	DOOR SIZE		Type	NOTES
	WD	HGT		
1	2'-10"	6'-8"	FRENCH	---
2	5'-0"	6'-8"	BI-FOLD DOUBLE	---
3	2'-4"	6'-8"	SWING	---
4	6'-0"	6'-8"	BI-FOLD DOUBLE	---
5	4'-0"	6'-8"	BI-FOLD DOUBLE	---
6	5'-0"	6'-8"	BI-FOLD DOUBLE	---
7	3'-0"	6'-8"	SWING	---
8	2'-8"	6'-8"	SWING	---
9	2'-8"	6'-8"	SWING	---
10	2'-4"	6'-8"	SWING	---
11	5'-4"	6'-8"	FRENCH DOUBLE	---
12	2'-6"	6'-8"	SWING	---
13	2'-4"	6'-8"	SWING	---
14	2'-0"	6'-8"	SWING	---
15	3'-0"	6'-8"	SWING	---
16	2'-0"	6'-8"	SWING	---
17	2'-0"	6'-8"	SWING	---
18	5'-4"	6'-8"	FRENCH DOUBLE	---
19	2'-0"	6'-8"	SWING	---
20	2'-6"	6'-8"	SWING	---
21	2'-4"	6'-8"	SWING	---
22	4'-7"	6'-8"	SWING DOUBLE	---
23	2'-6"	6'-8"	SWING	---
24	3'-0"	6'-8"	SWING DOUBLE	---
25	2'-6"	6'-8"	SWING	---

WINDOW SCHEDULE					
MARK	SIZE		TYPE	Head Height	NOTES
	Width	HEIGHT			
1	2'-6"	3'-10"	CASEMENT	6'-8"	---
2	2'-6"	3'-10"	CASEMENT	6'-8"	---
3	2'-6"	3'-10"	CASEMENT	6'-8"	---
4	2'-4"	4'-10"	CASEMENT	6'-8"	---
5	2'-4"	4'-10"	CASEMENT	6'-8"	---
6	1'-10"	4'-10"	CASEMENT	6'-8"	---
7	4'-10"	4'-10"	FIXED	6'-8"	---
8	1'-10"	4'-10"	CASEMENT	6'-8"	---
9	5'-10"	4'-4"	XOX CASEMENT	6'-8"	---
10	5'-10"	4'-4"	XOX CASEMENT	6'-8"	---
11	3'-11"	2'-11"	SLIDING	6'-8"	---
12	2'-10"	3'-10"	DOUBLE CASEMENT	6'-8"	---
13	5'-11"	2'-0"	FIXED	7'-6"	---
14	3'-11"	3'-11"	DOUBLE CASEMENT	6'-8"	---
15	1'-11"	3'-10"	CASEMENT	6'-8"	---
16	2'-11"	3'-11"	CASEMENT	6'-8"	---
17	2'-11"	3'-11"	CASEMENT	6'-8"	---
18	3'-10"	1'-8"	AWNING	7'-6"	---
19	3'-10"	1'-8"	AWNING	7'-6"	---
20	1'-11"	2'-11"	CASEMENT	6'-8"	---
21	2'-4"	2'-10"	CASEMENT	6'-8"	---
22	5'-11"	2'-10"	XOX CASEMENT	6'-8"	---
23	2'-10"	3'-4"	CASEMENT	6'-8"	---
24	2'-4"	2'-10"	CASEMENT	6'-8"	---
25	2'-4"	2'-10"	CASEMENT	6'-8"	---
26	1'-8"	3'-9"	GLASS BLOCKS	6'-8"	---
27	2'-6"	1'-6"	SINGLE HUNG	6'-8"	---

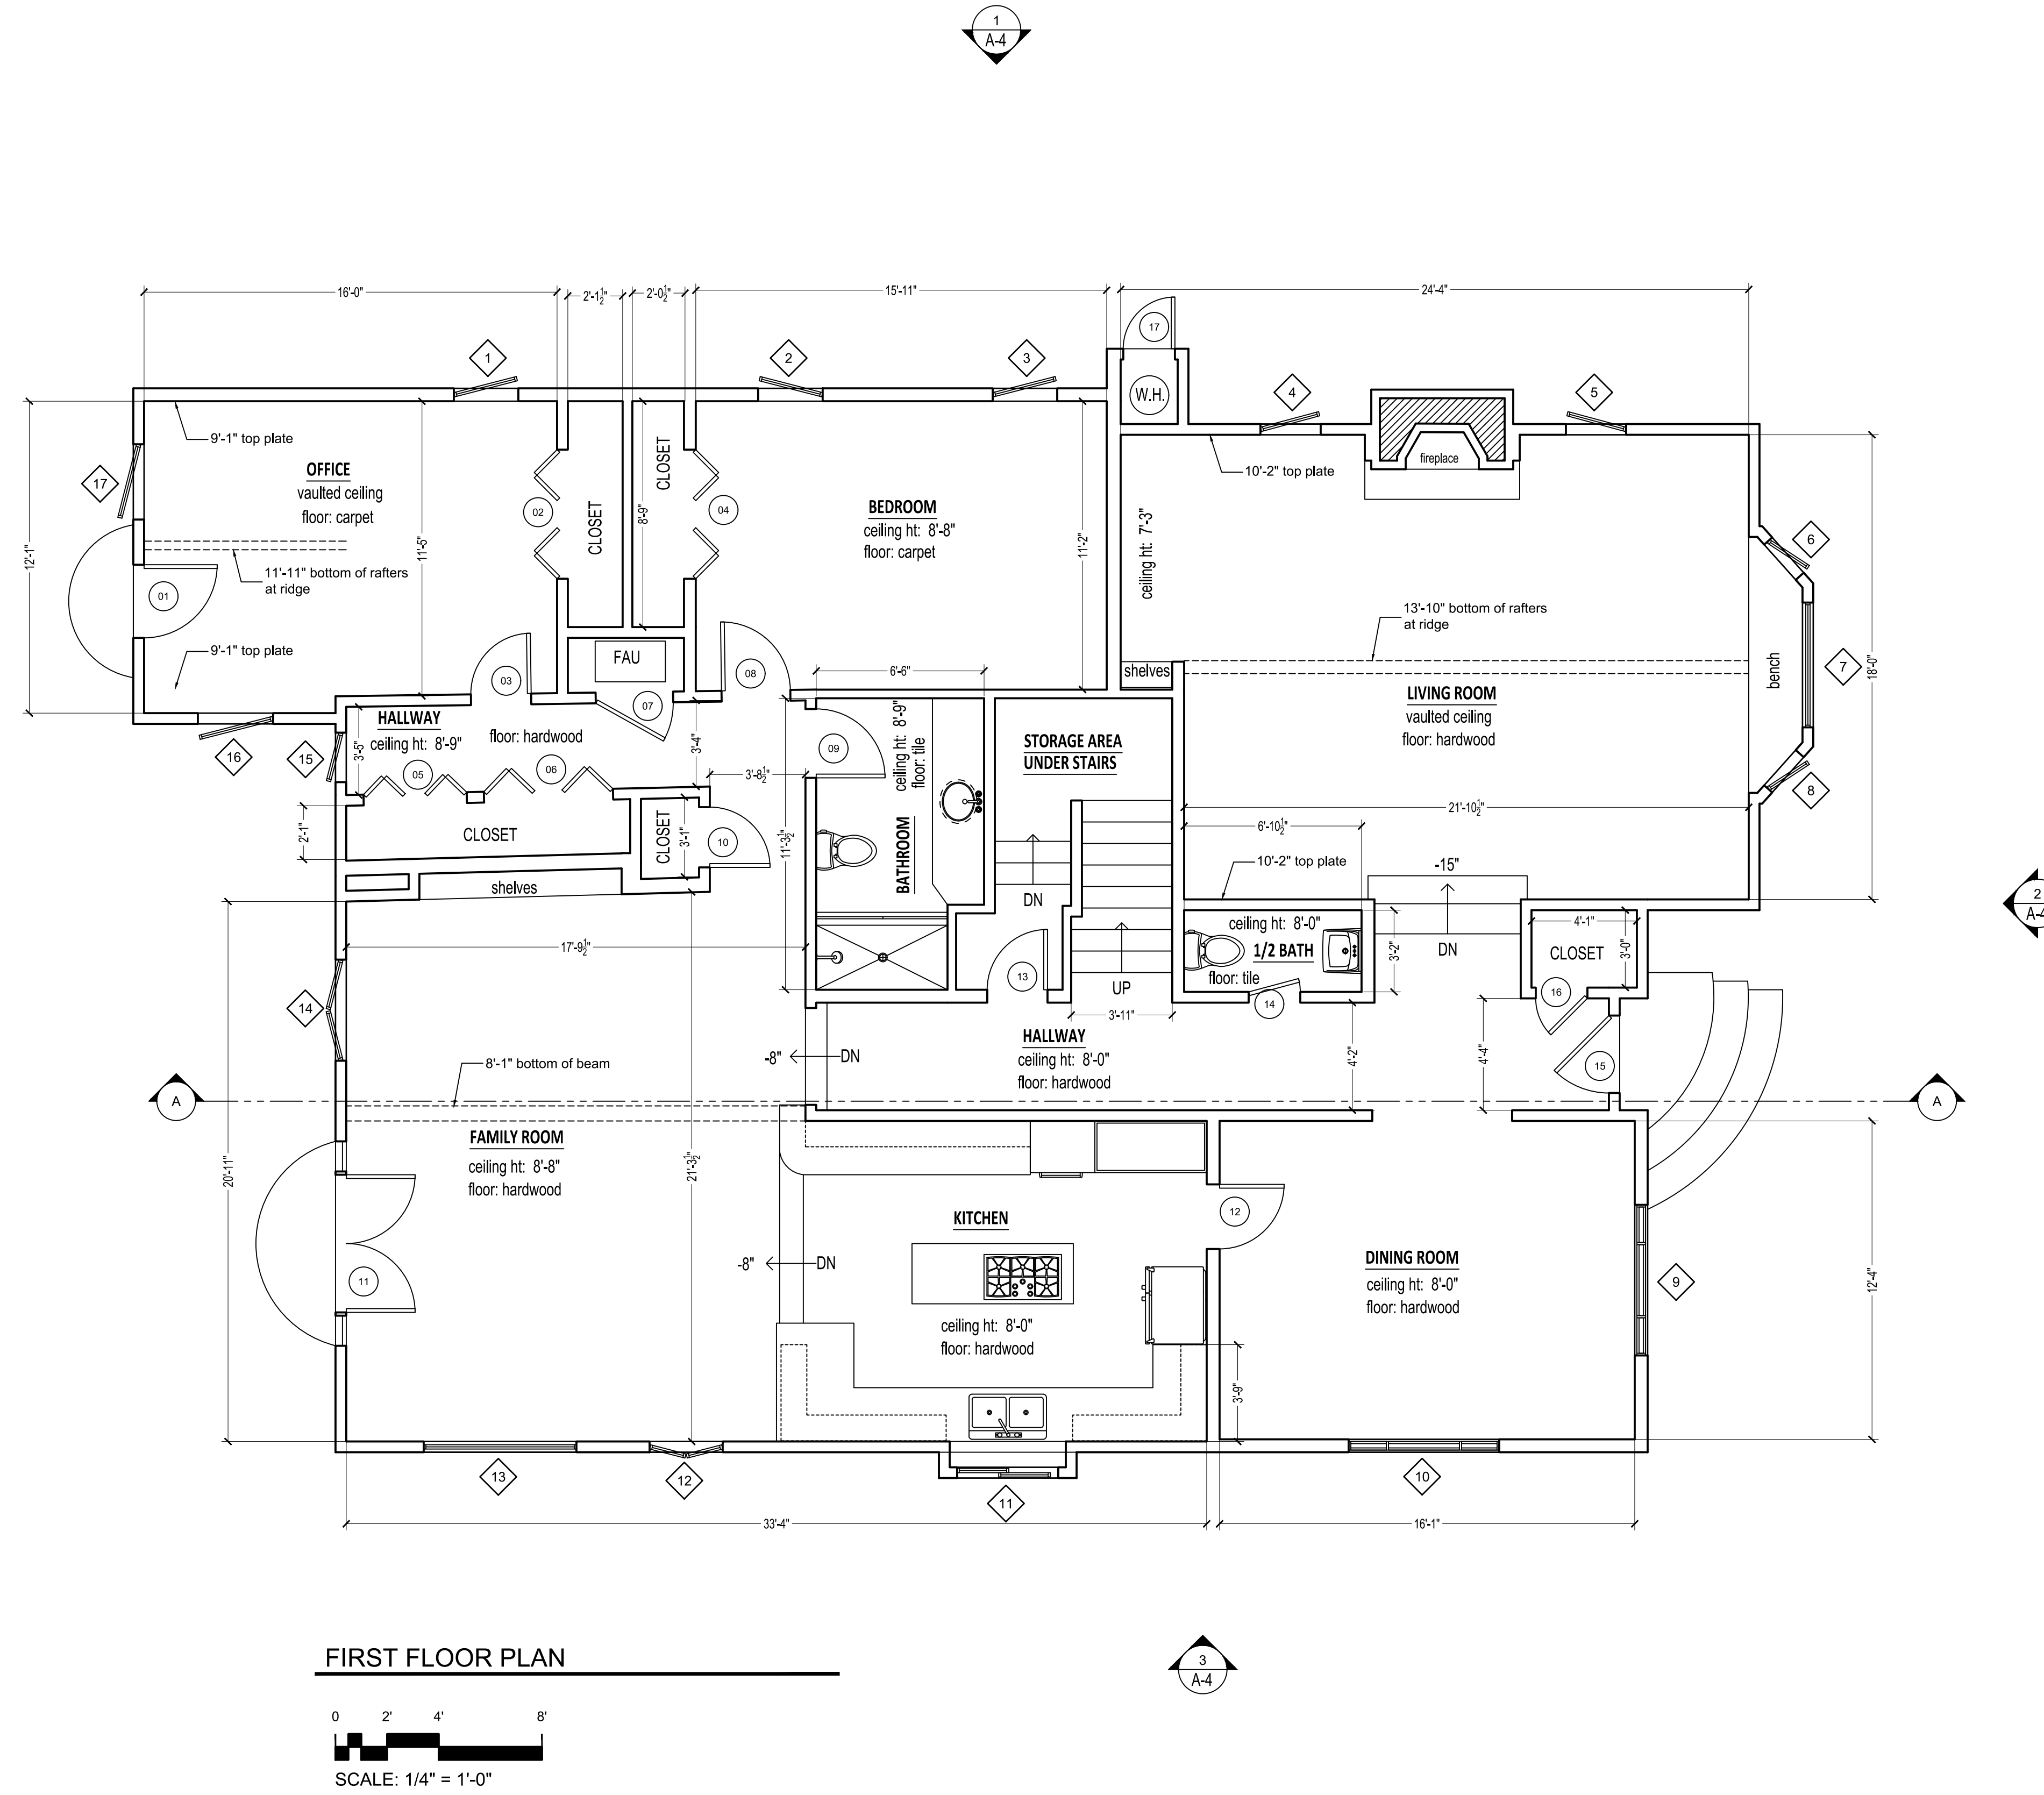

REVISIONS	BY

AS-BUILT
LOS ANGELES

Sheet content : **FLOOR PLAN**

Project : **908 26TH ST
SANTA MONICA CA 90403**

Owner:

Date

Scale

Drawn

Job

Sheet

A-2

REVISIONS	BY

AS-BUILT
LOS ANGELES


Sheet content :
SECOND FLOOR PLAN

Project :
908 26TH ST
SANTA MONICA CA 90403





Owner:
Date
Scale
Drawn
Job
Sheet


A-3

08.26.13

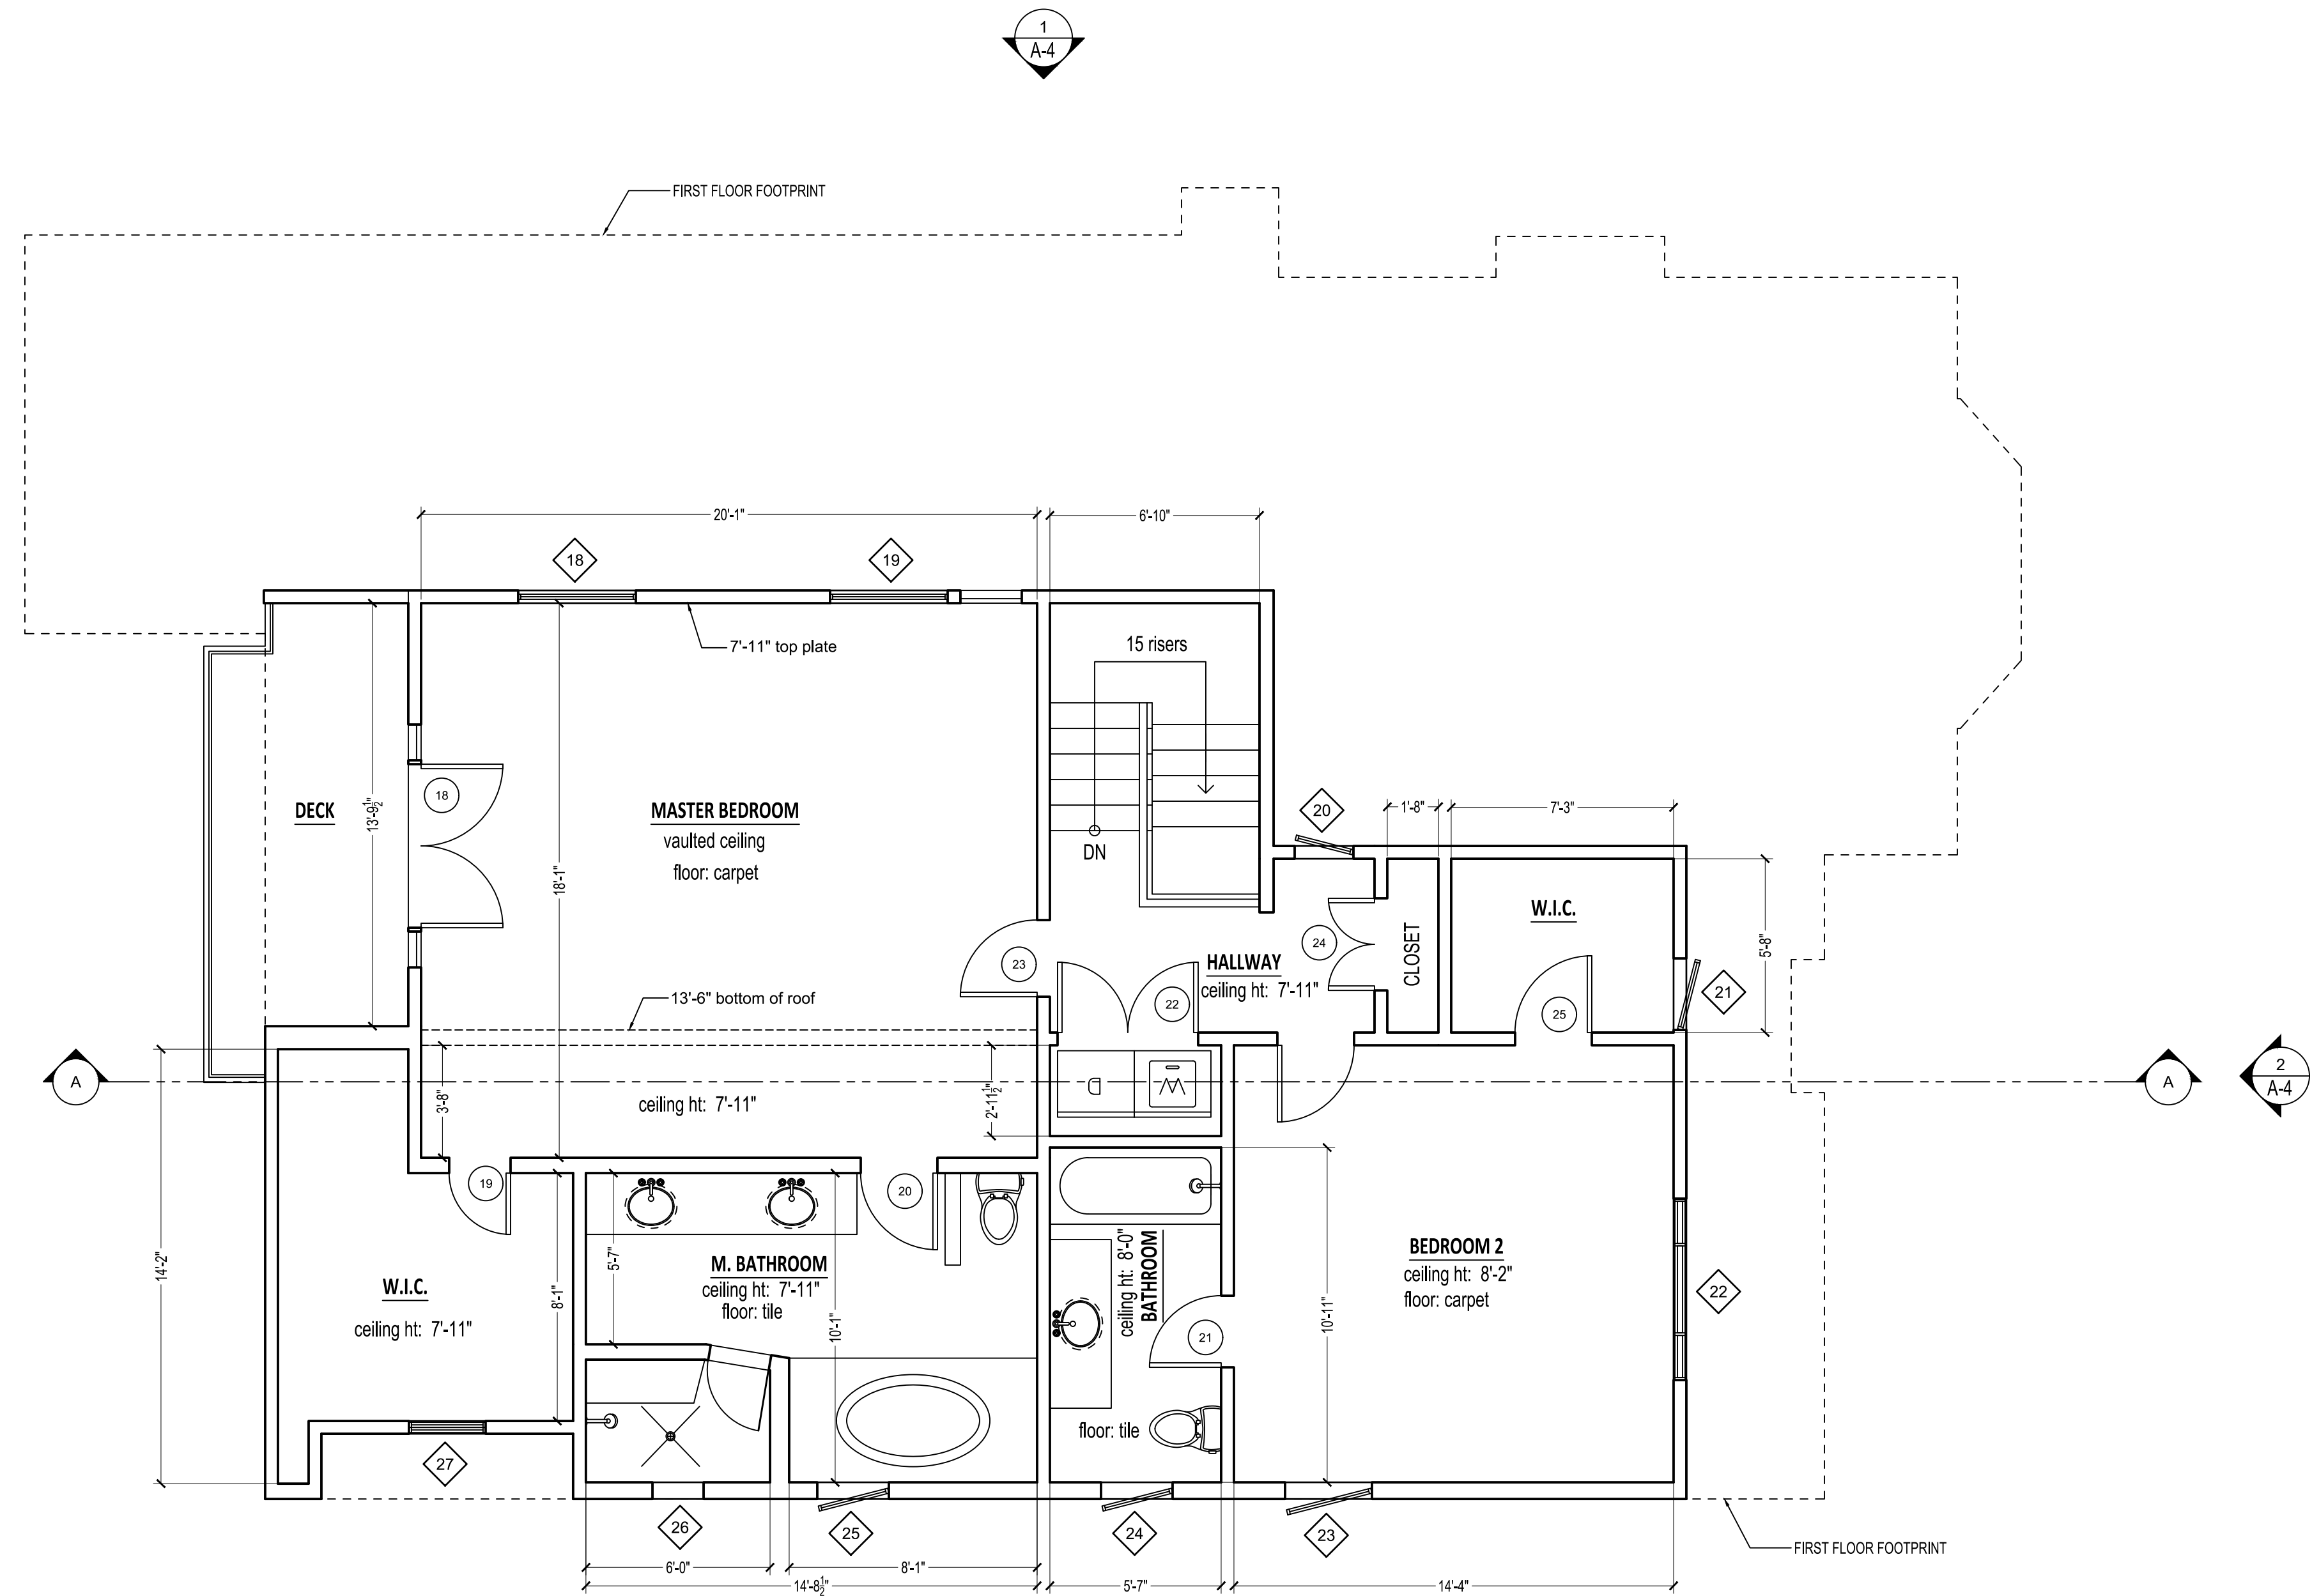


SECOND FLOOR PLAN

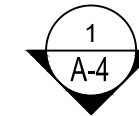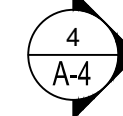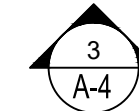
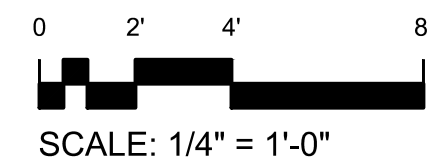


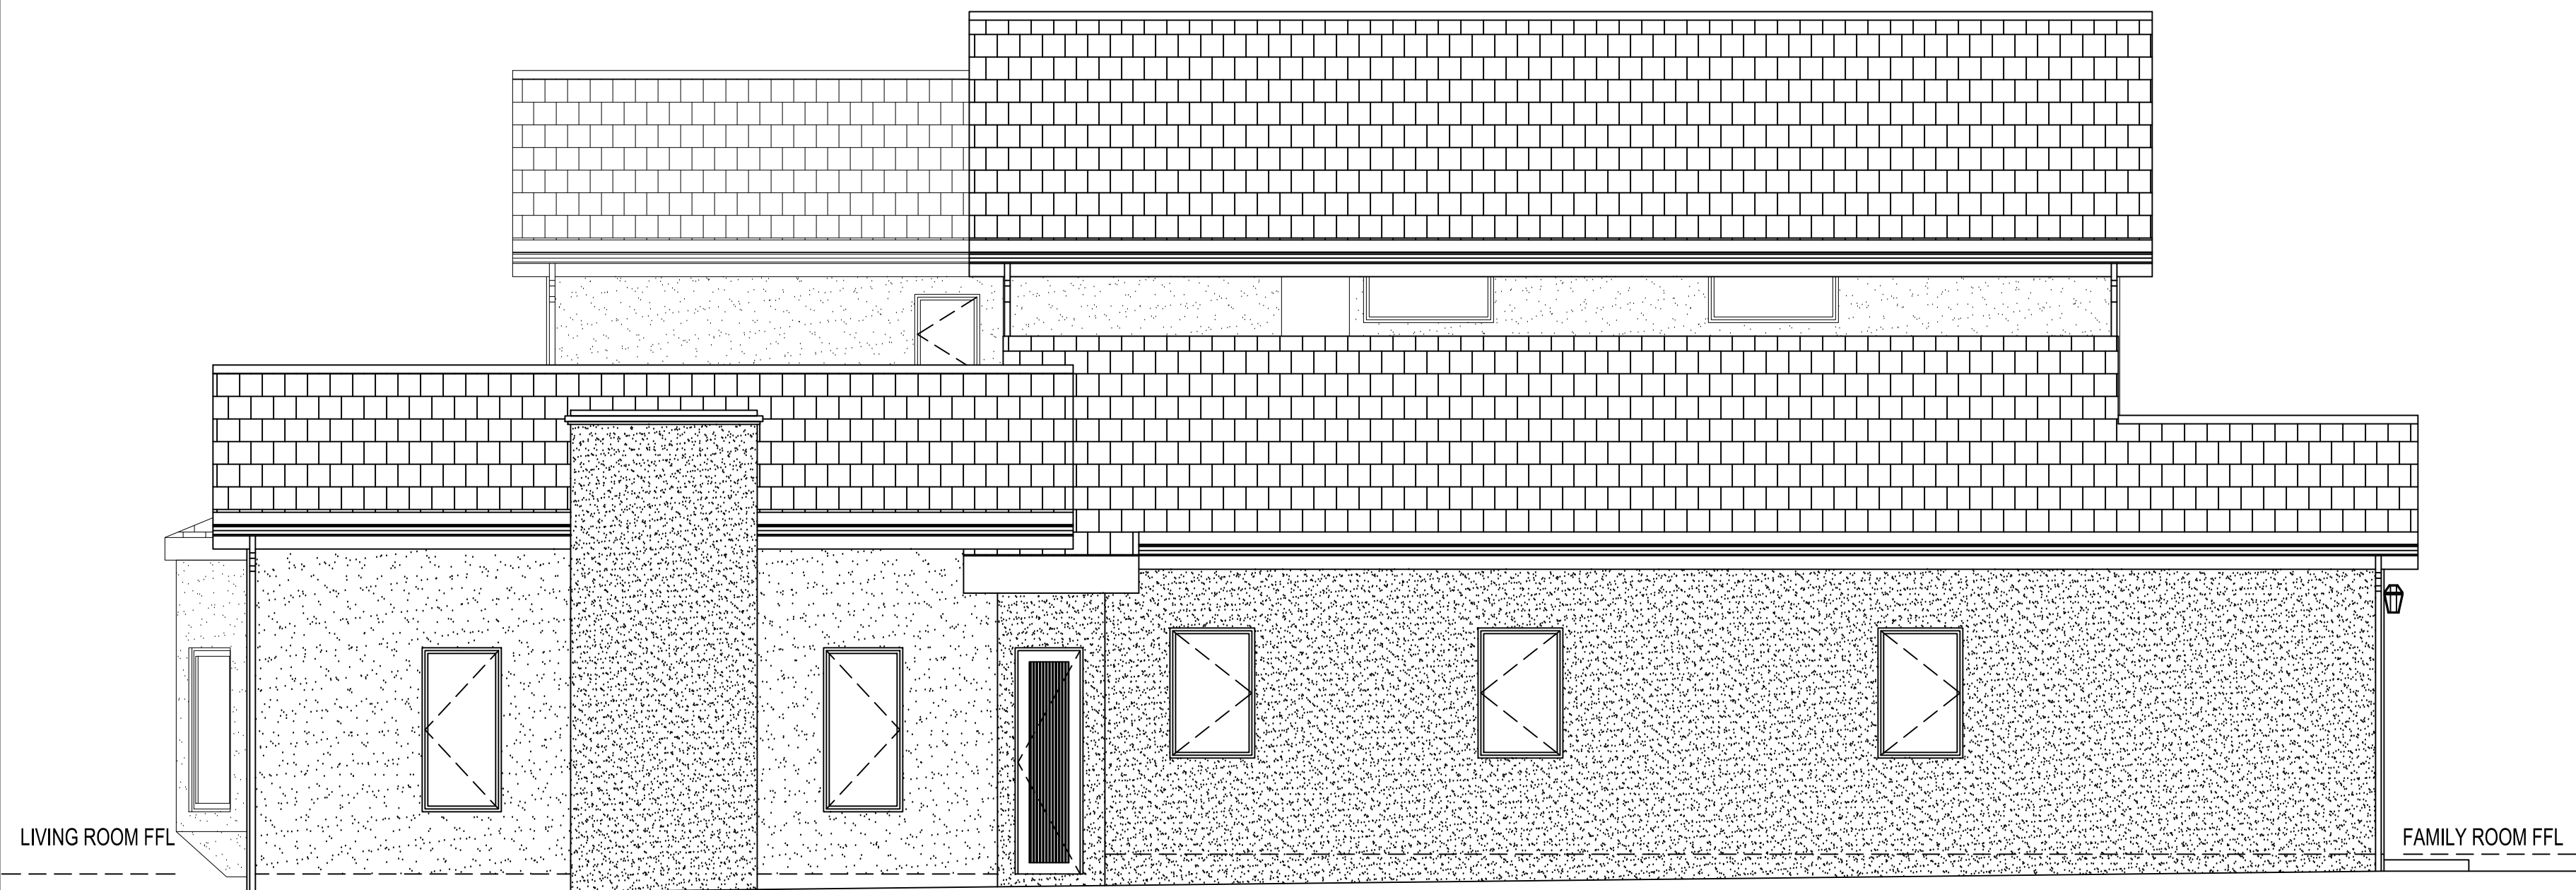


1 N. W. ELEVATION

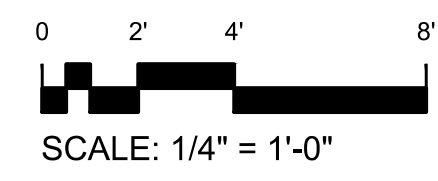


2 N. E. ELEVATION

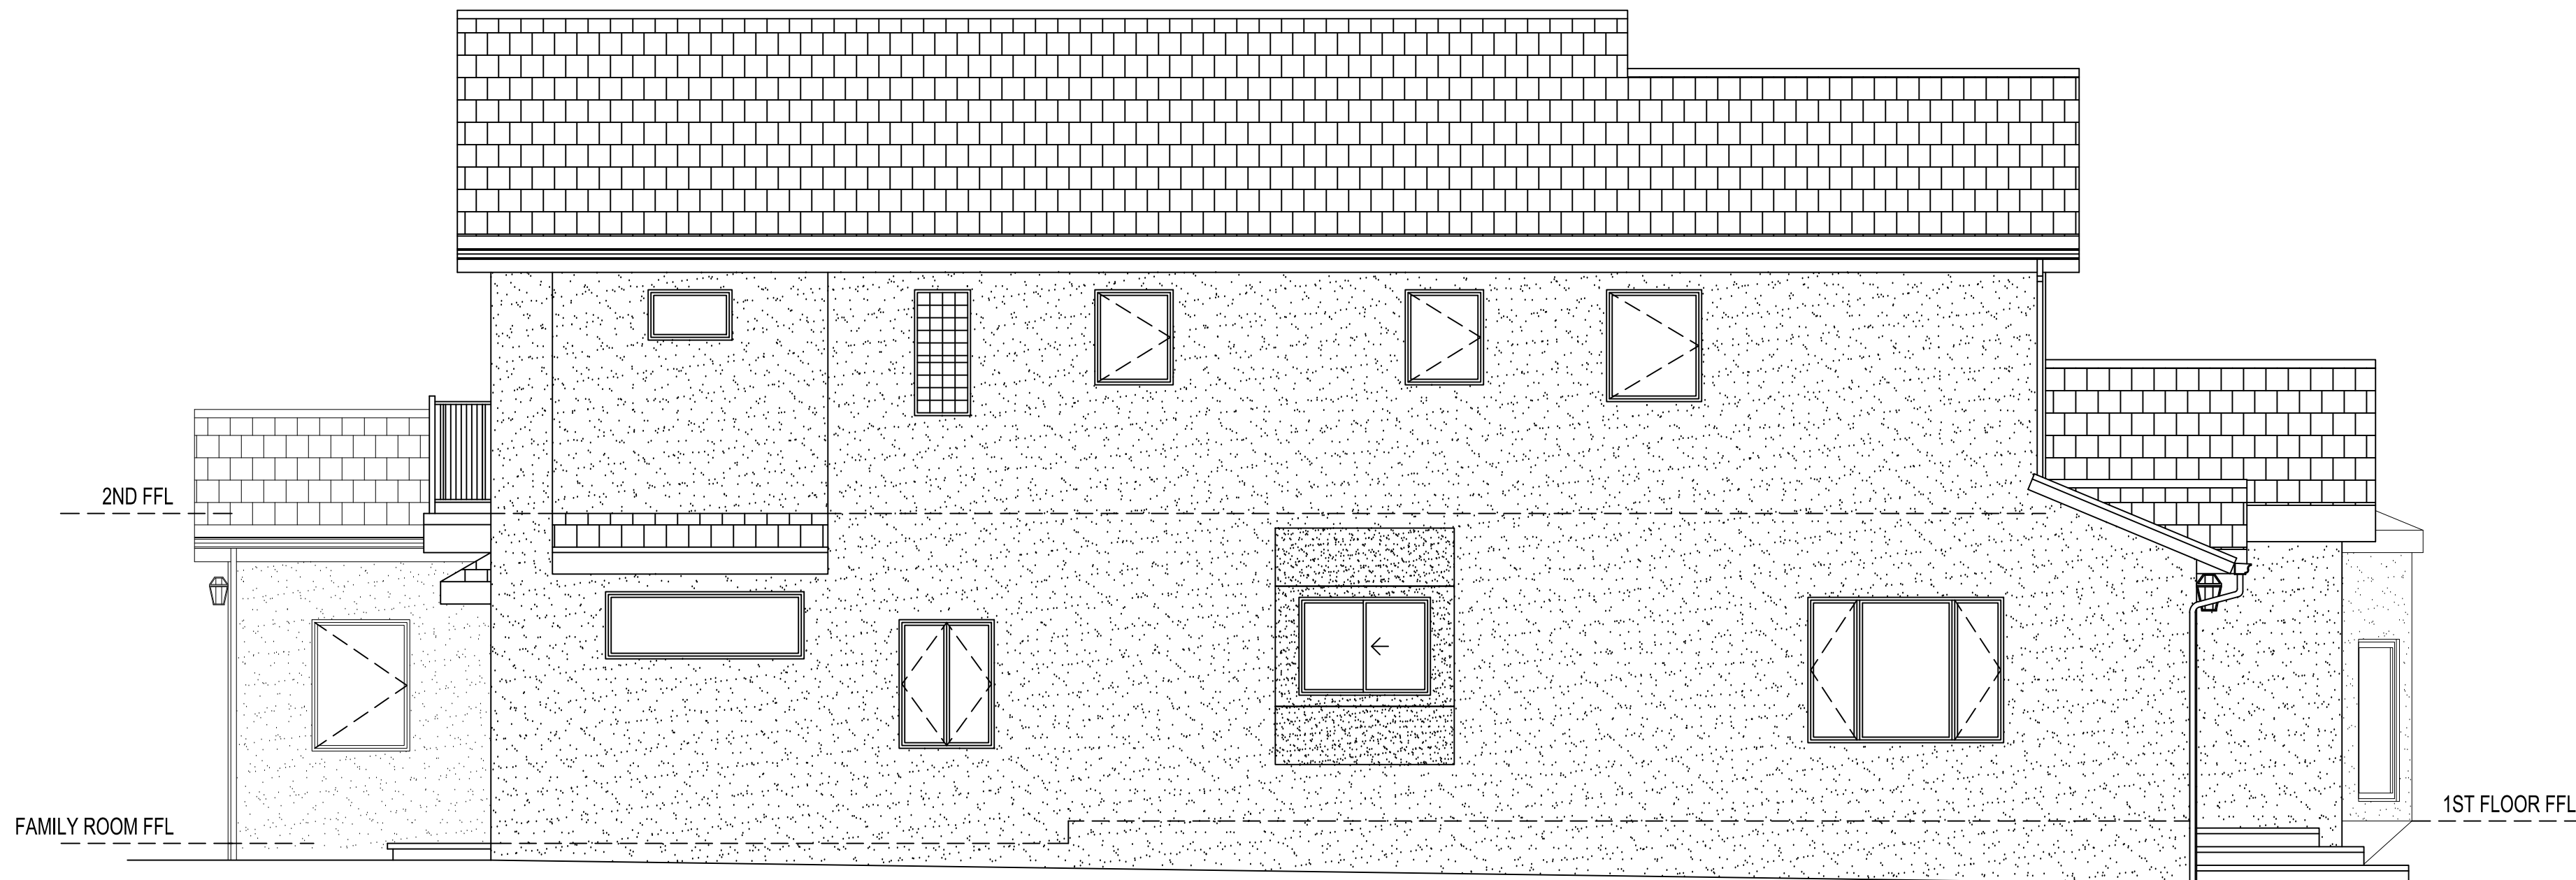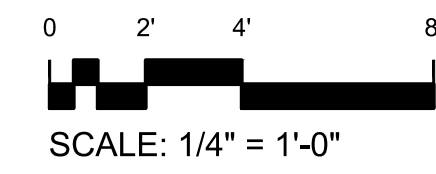


3 S. E. ELEVATION

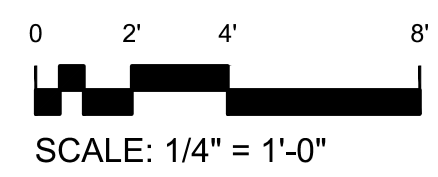


4 S. W. ELEVATION

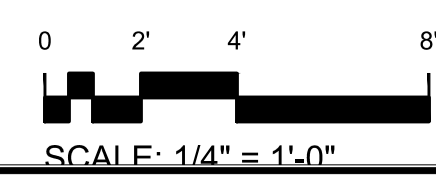


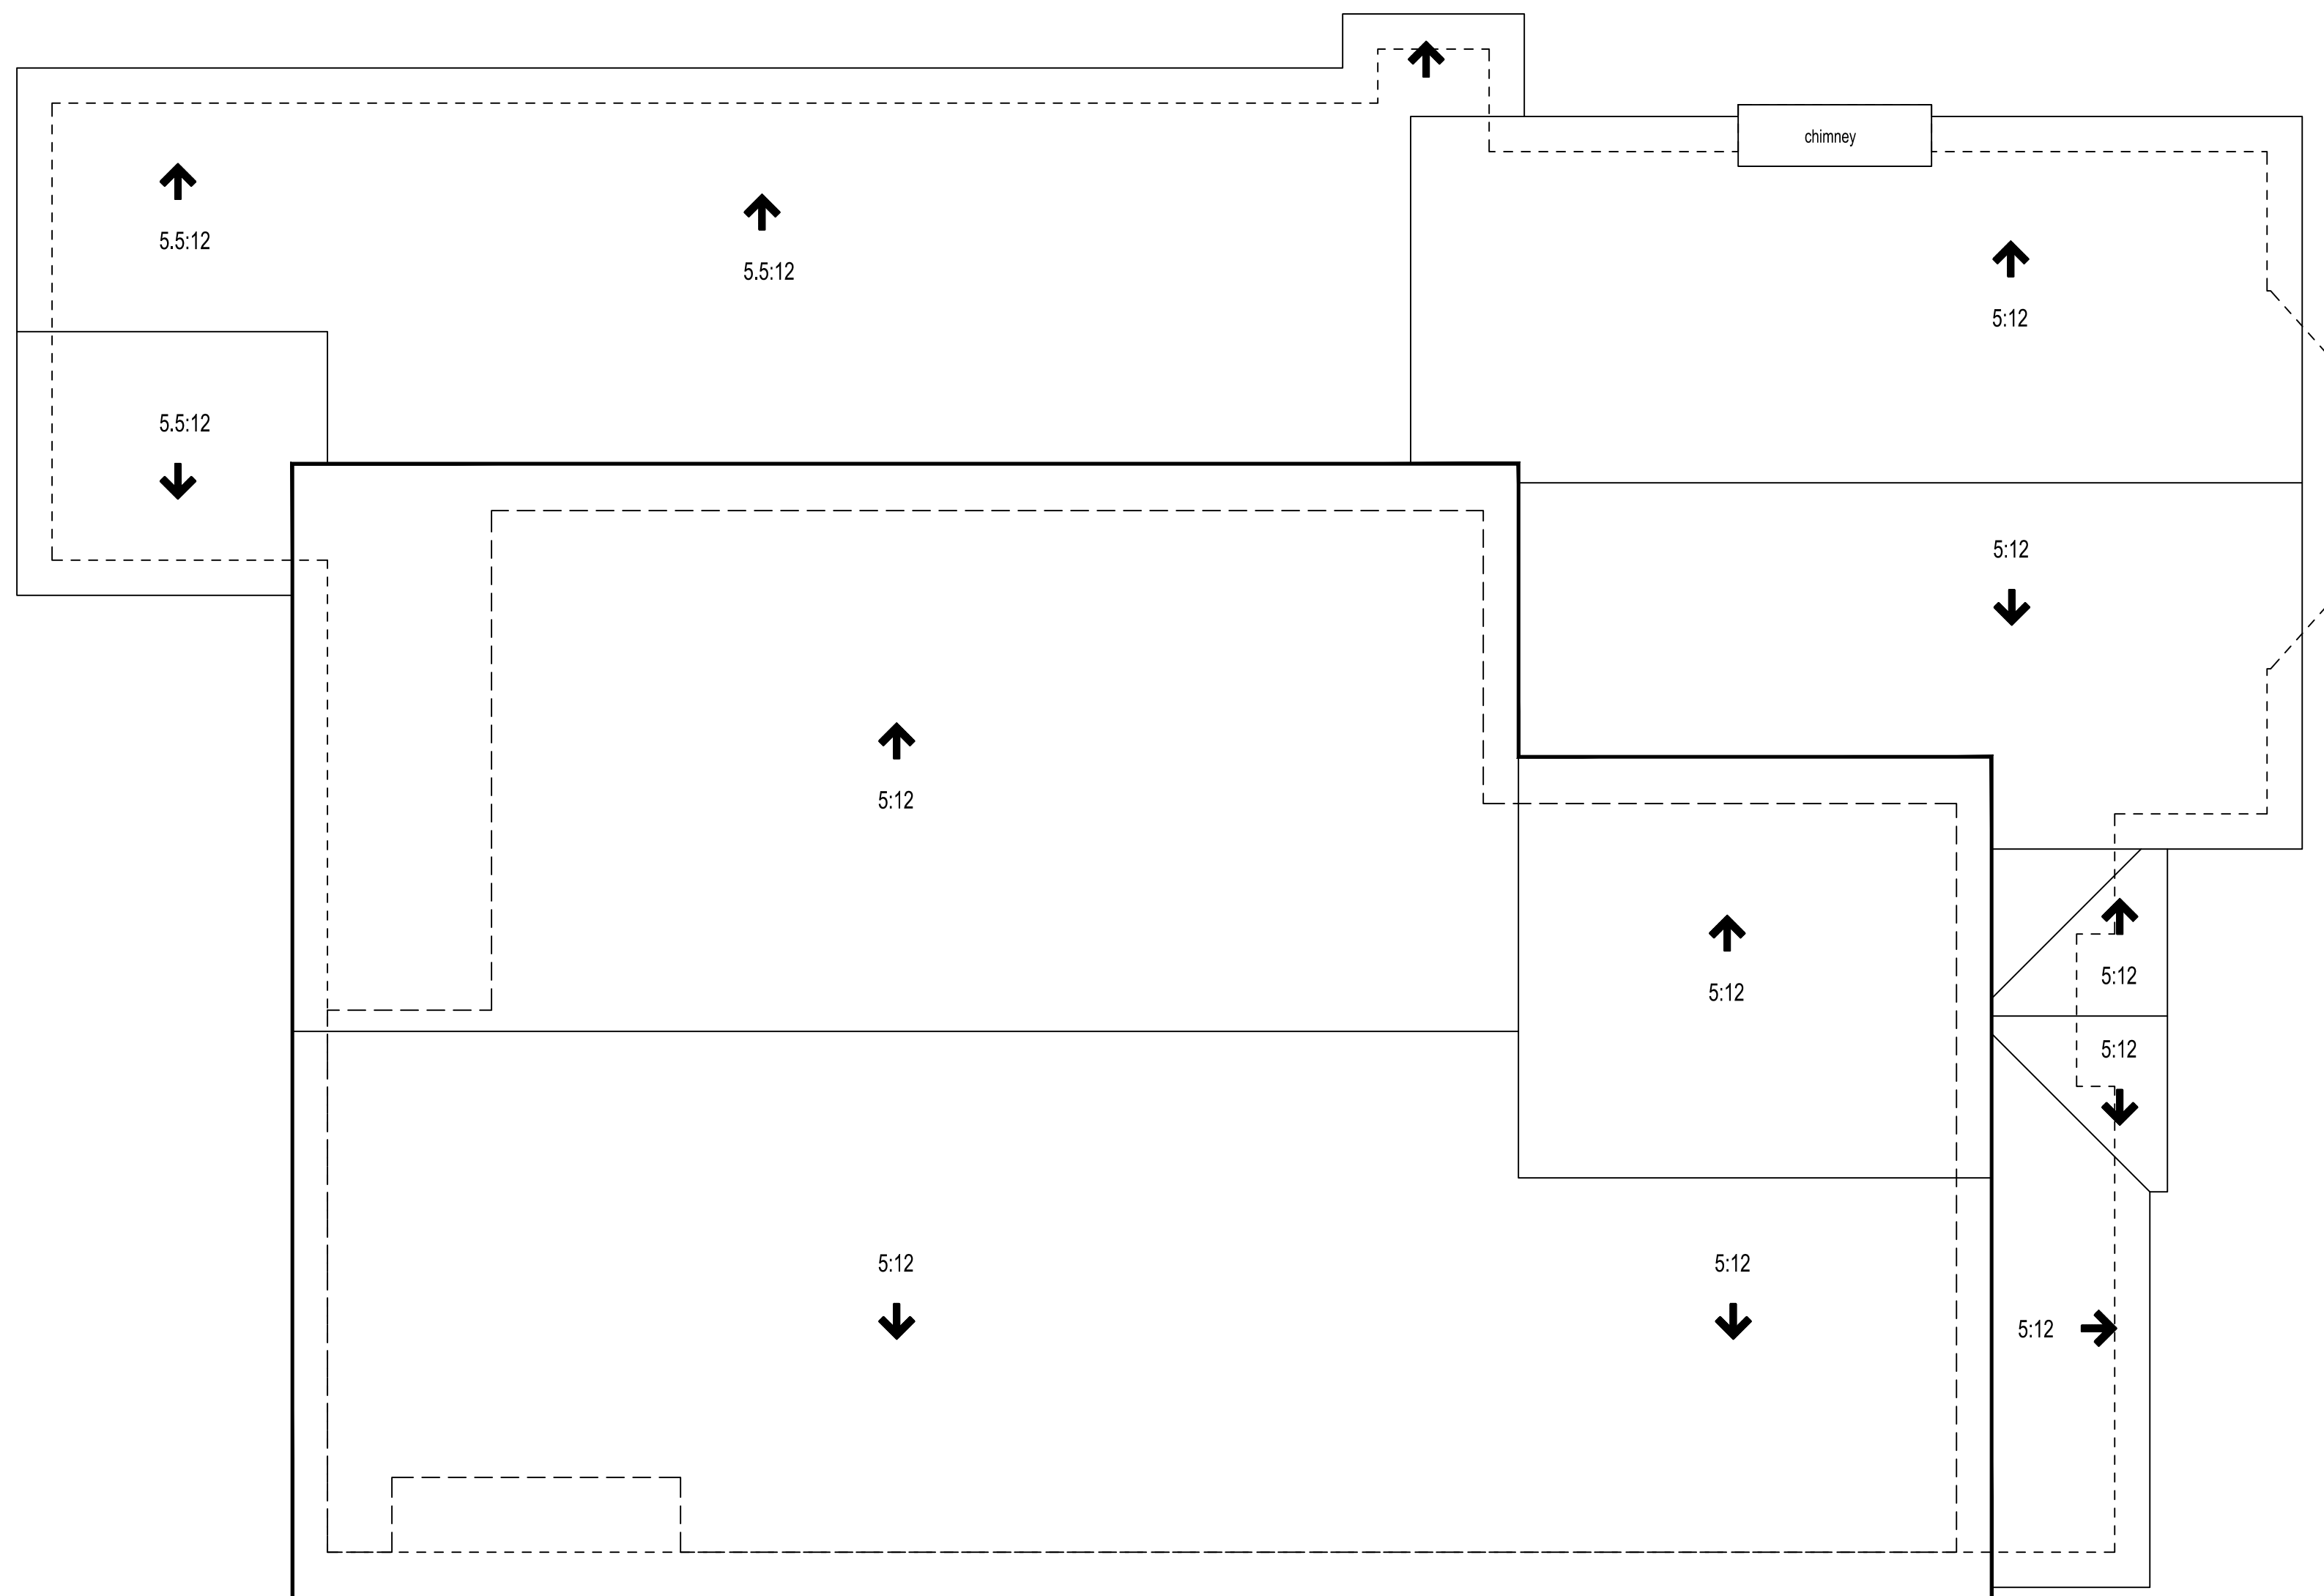

ROOF PLAN

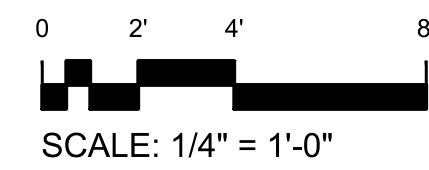

SECTION A-A

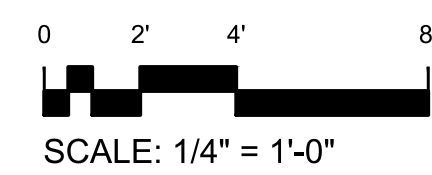


REVISIONS	BY

AS-BUILT
LOS ANGELES



Sheet content :
ROOF PLAN
SECTION A-A

Project :
908 26TH ST
SANTA MONICA CA 90403



Owner:
Date
Scale
Drawn
Job
Sheet
A-5

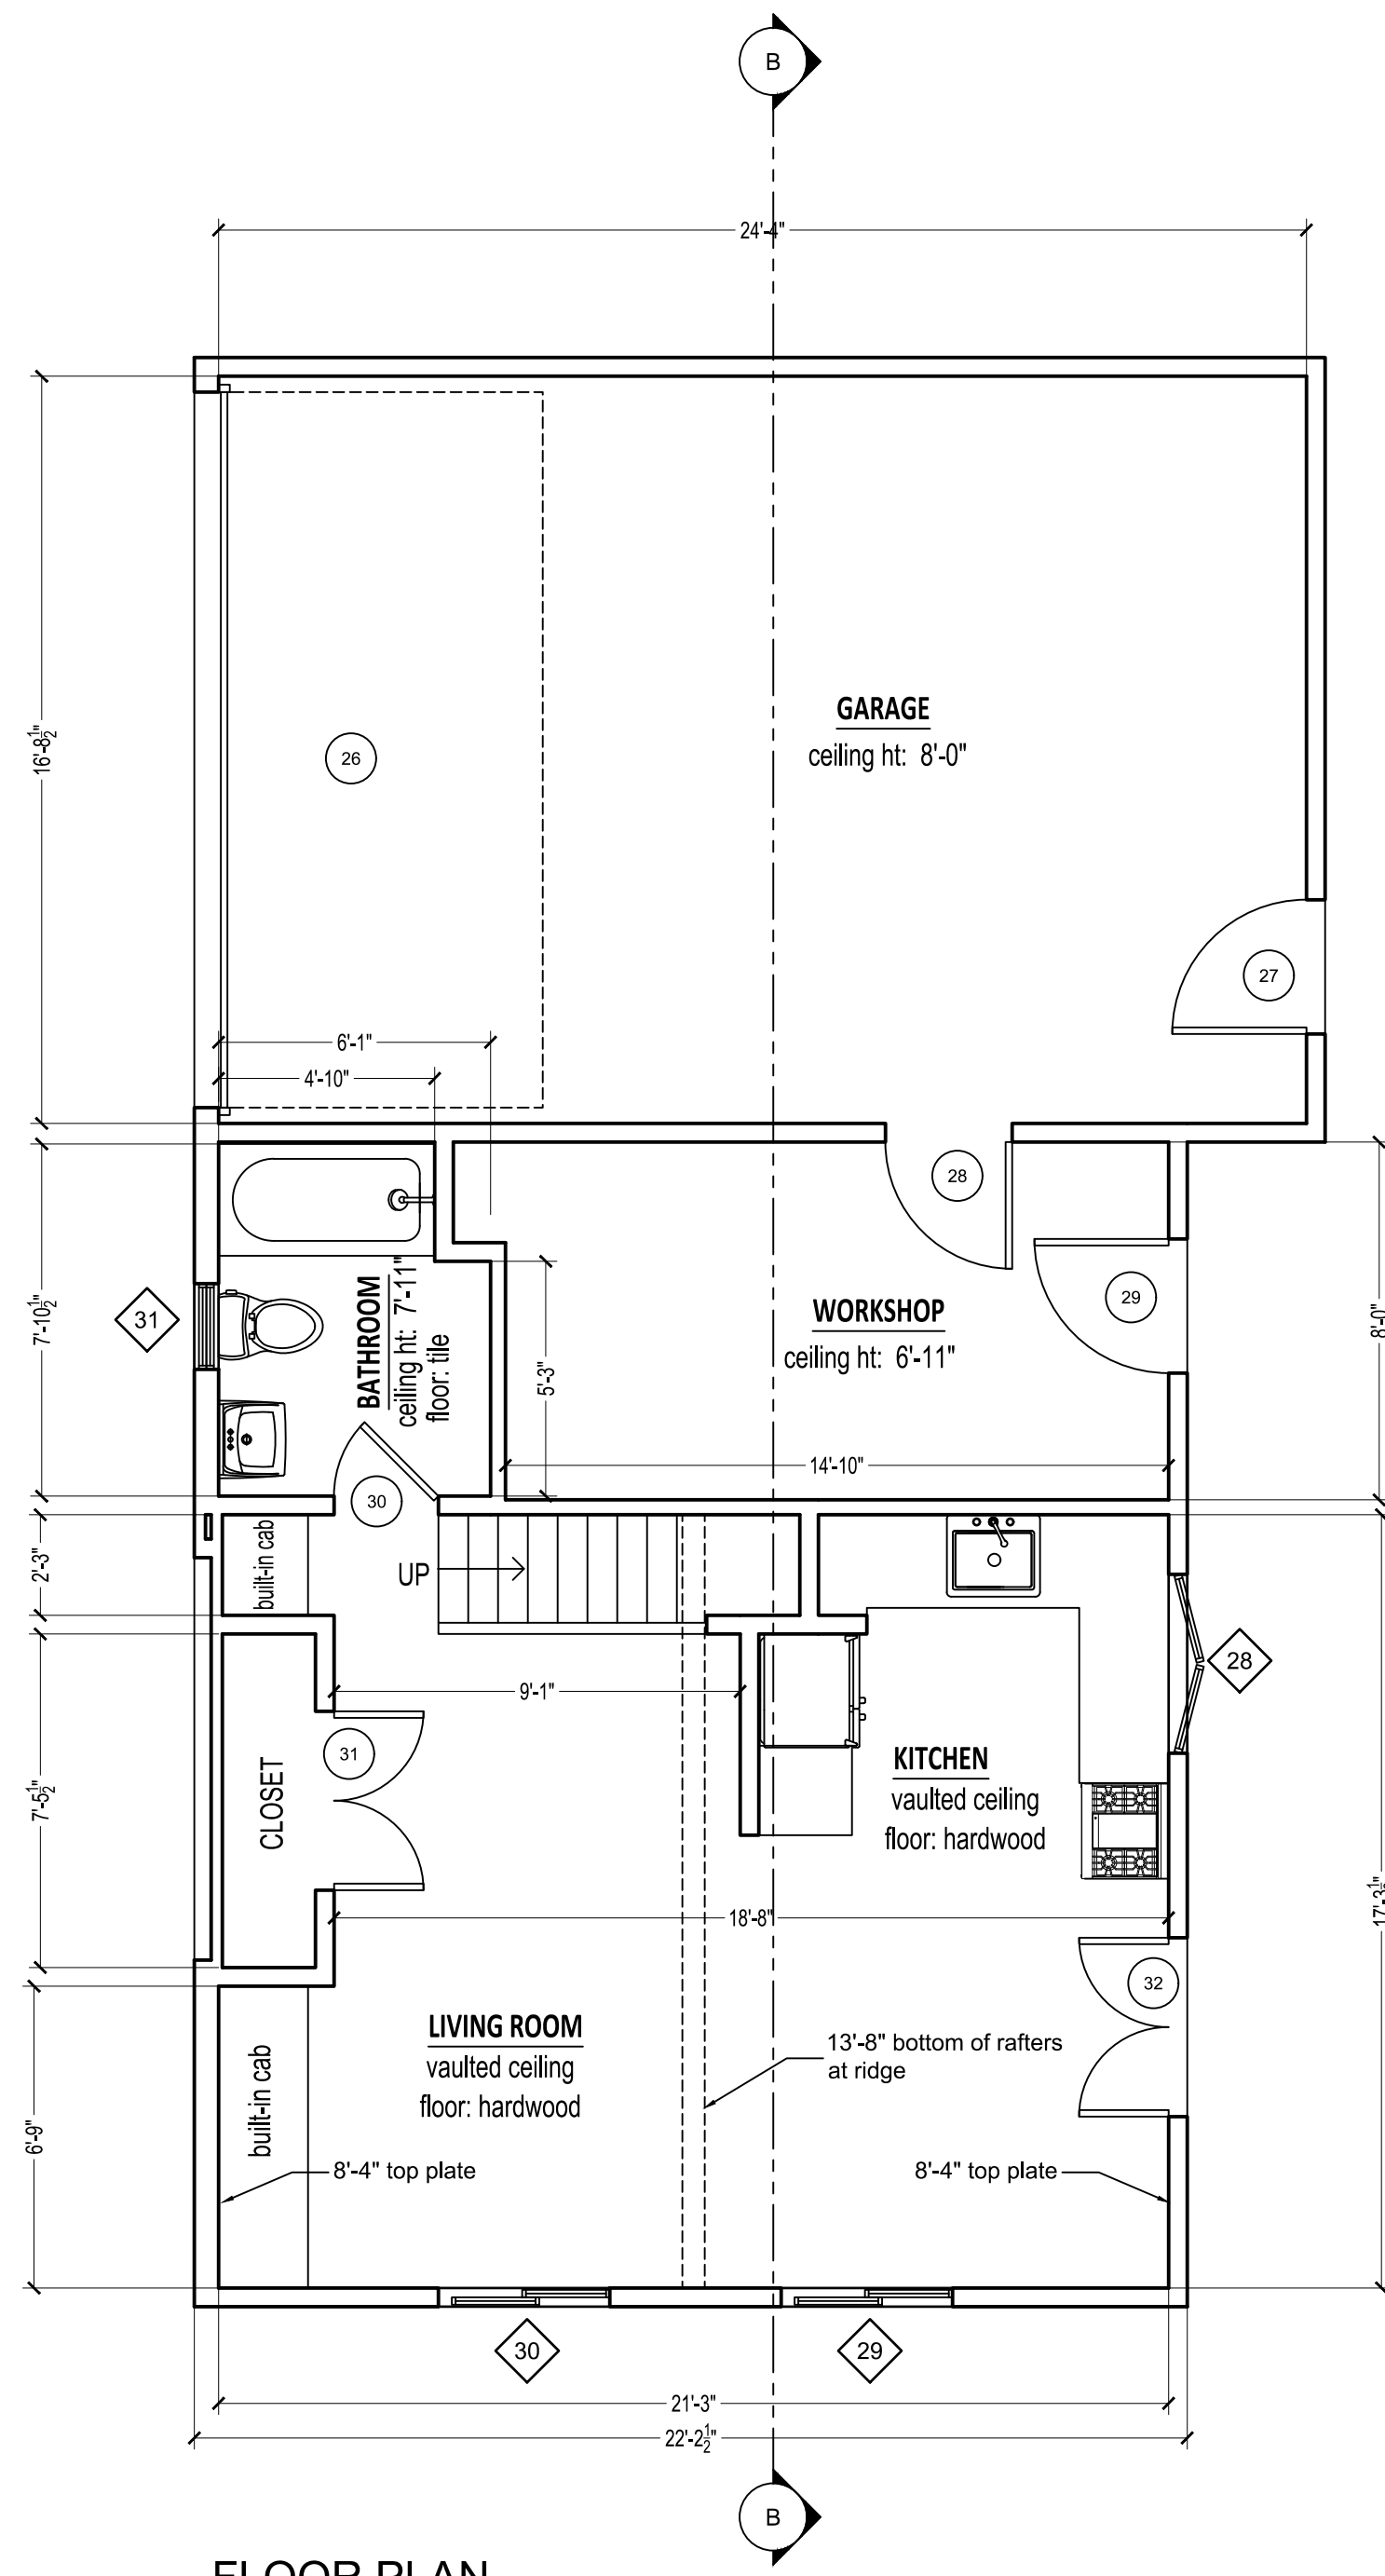


FLOOR PLAN

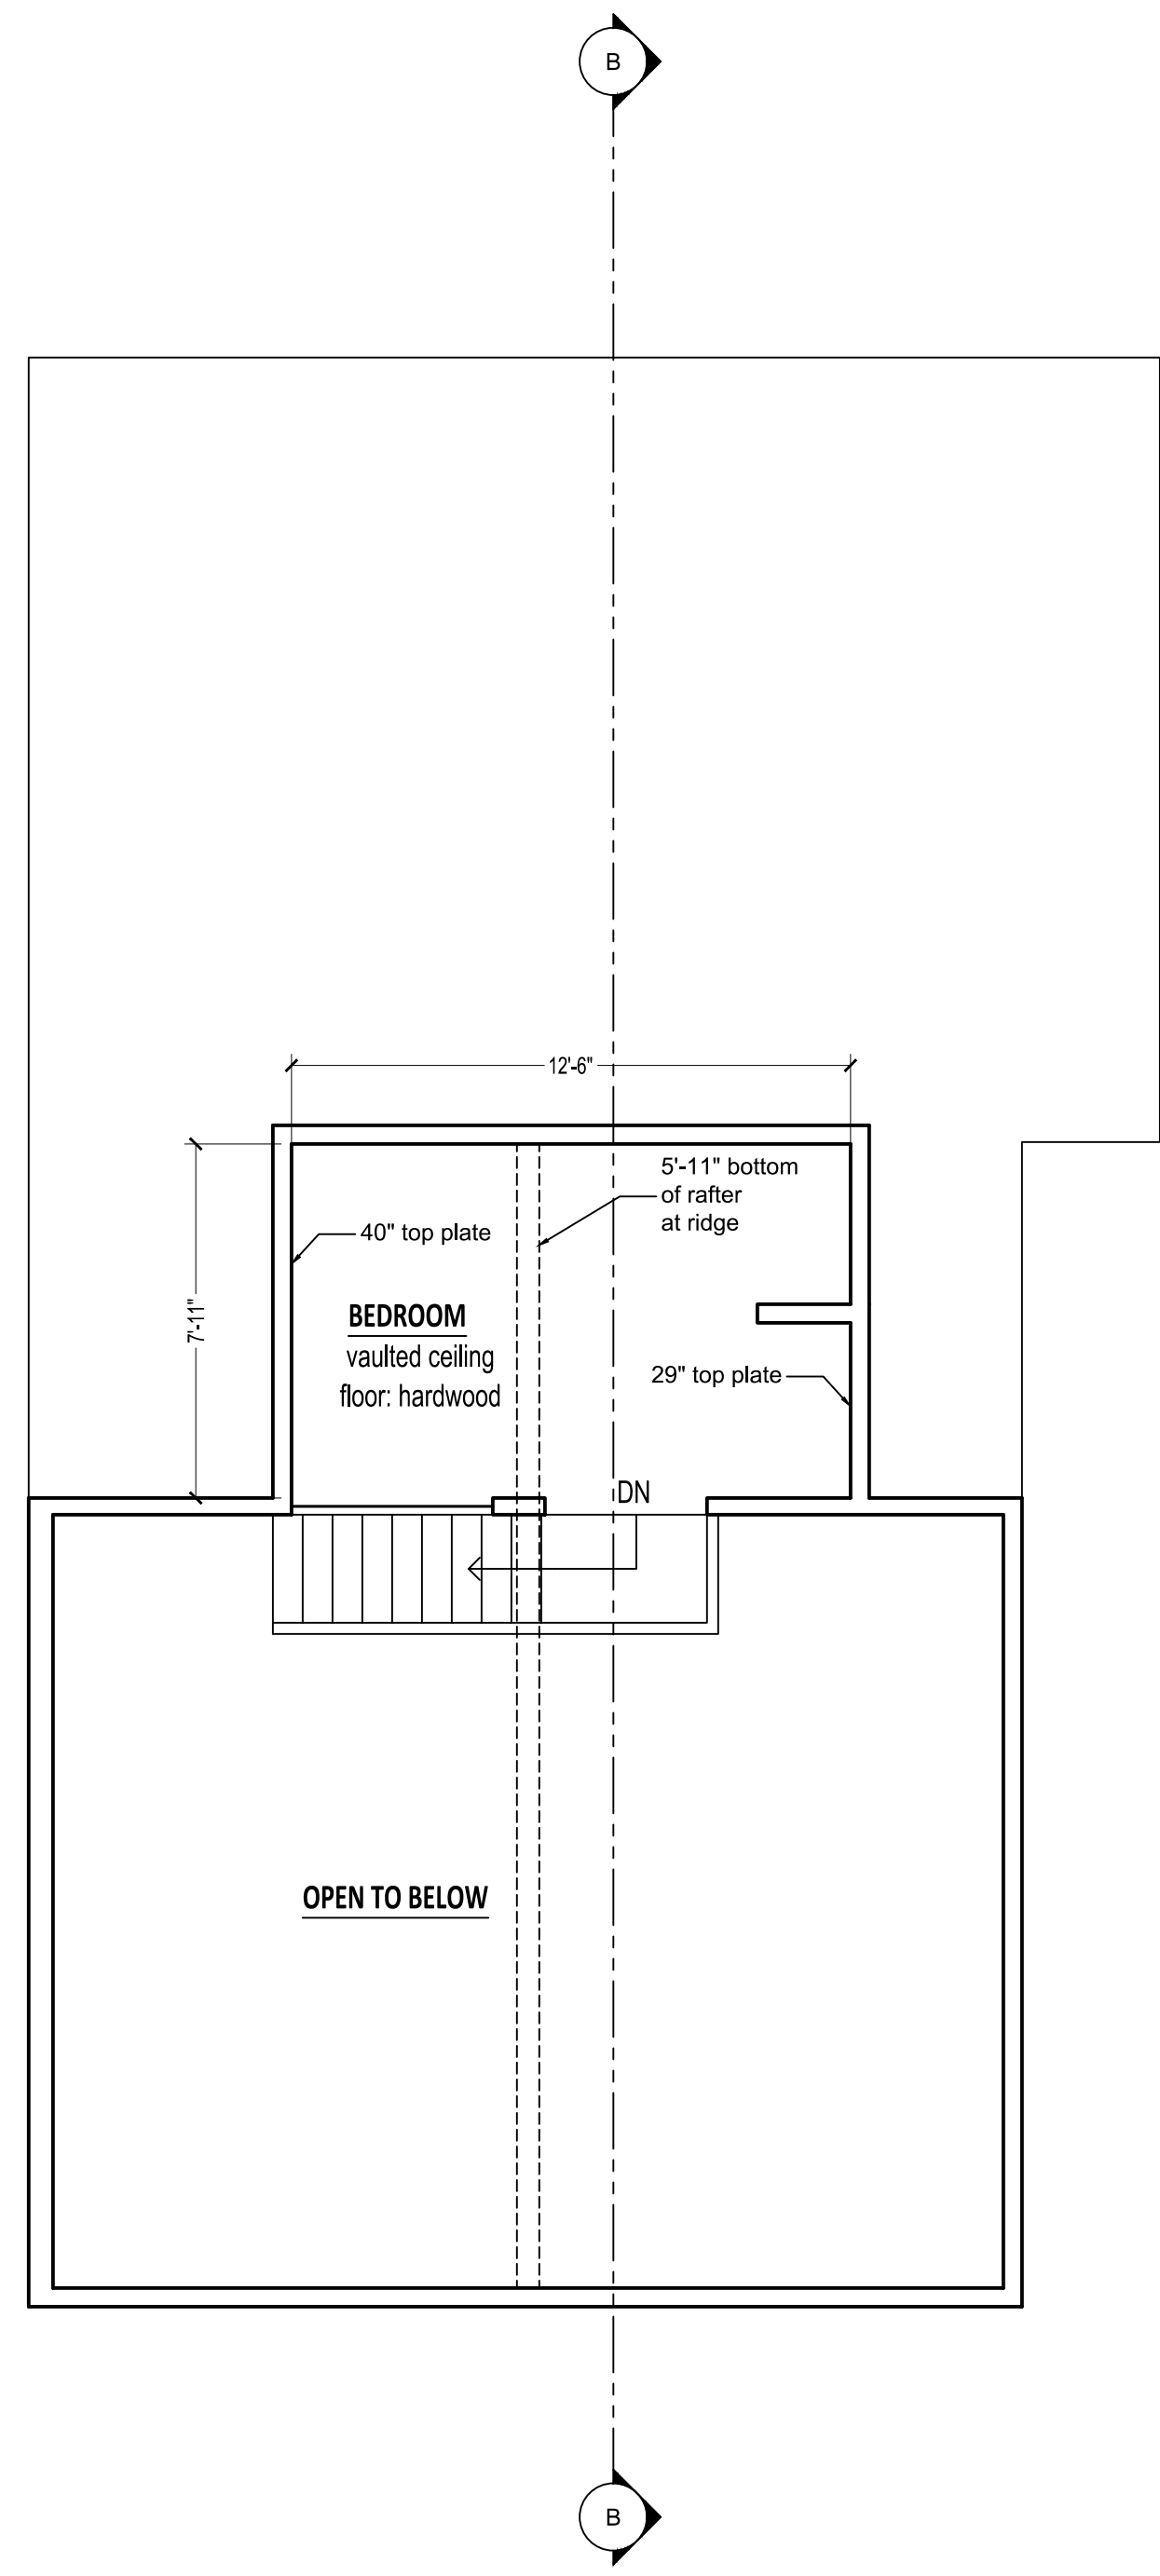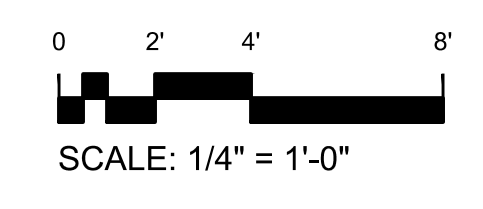

LOFT PLAN

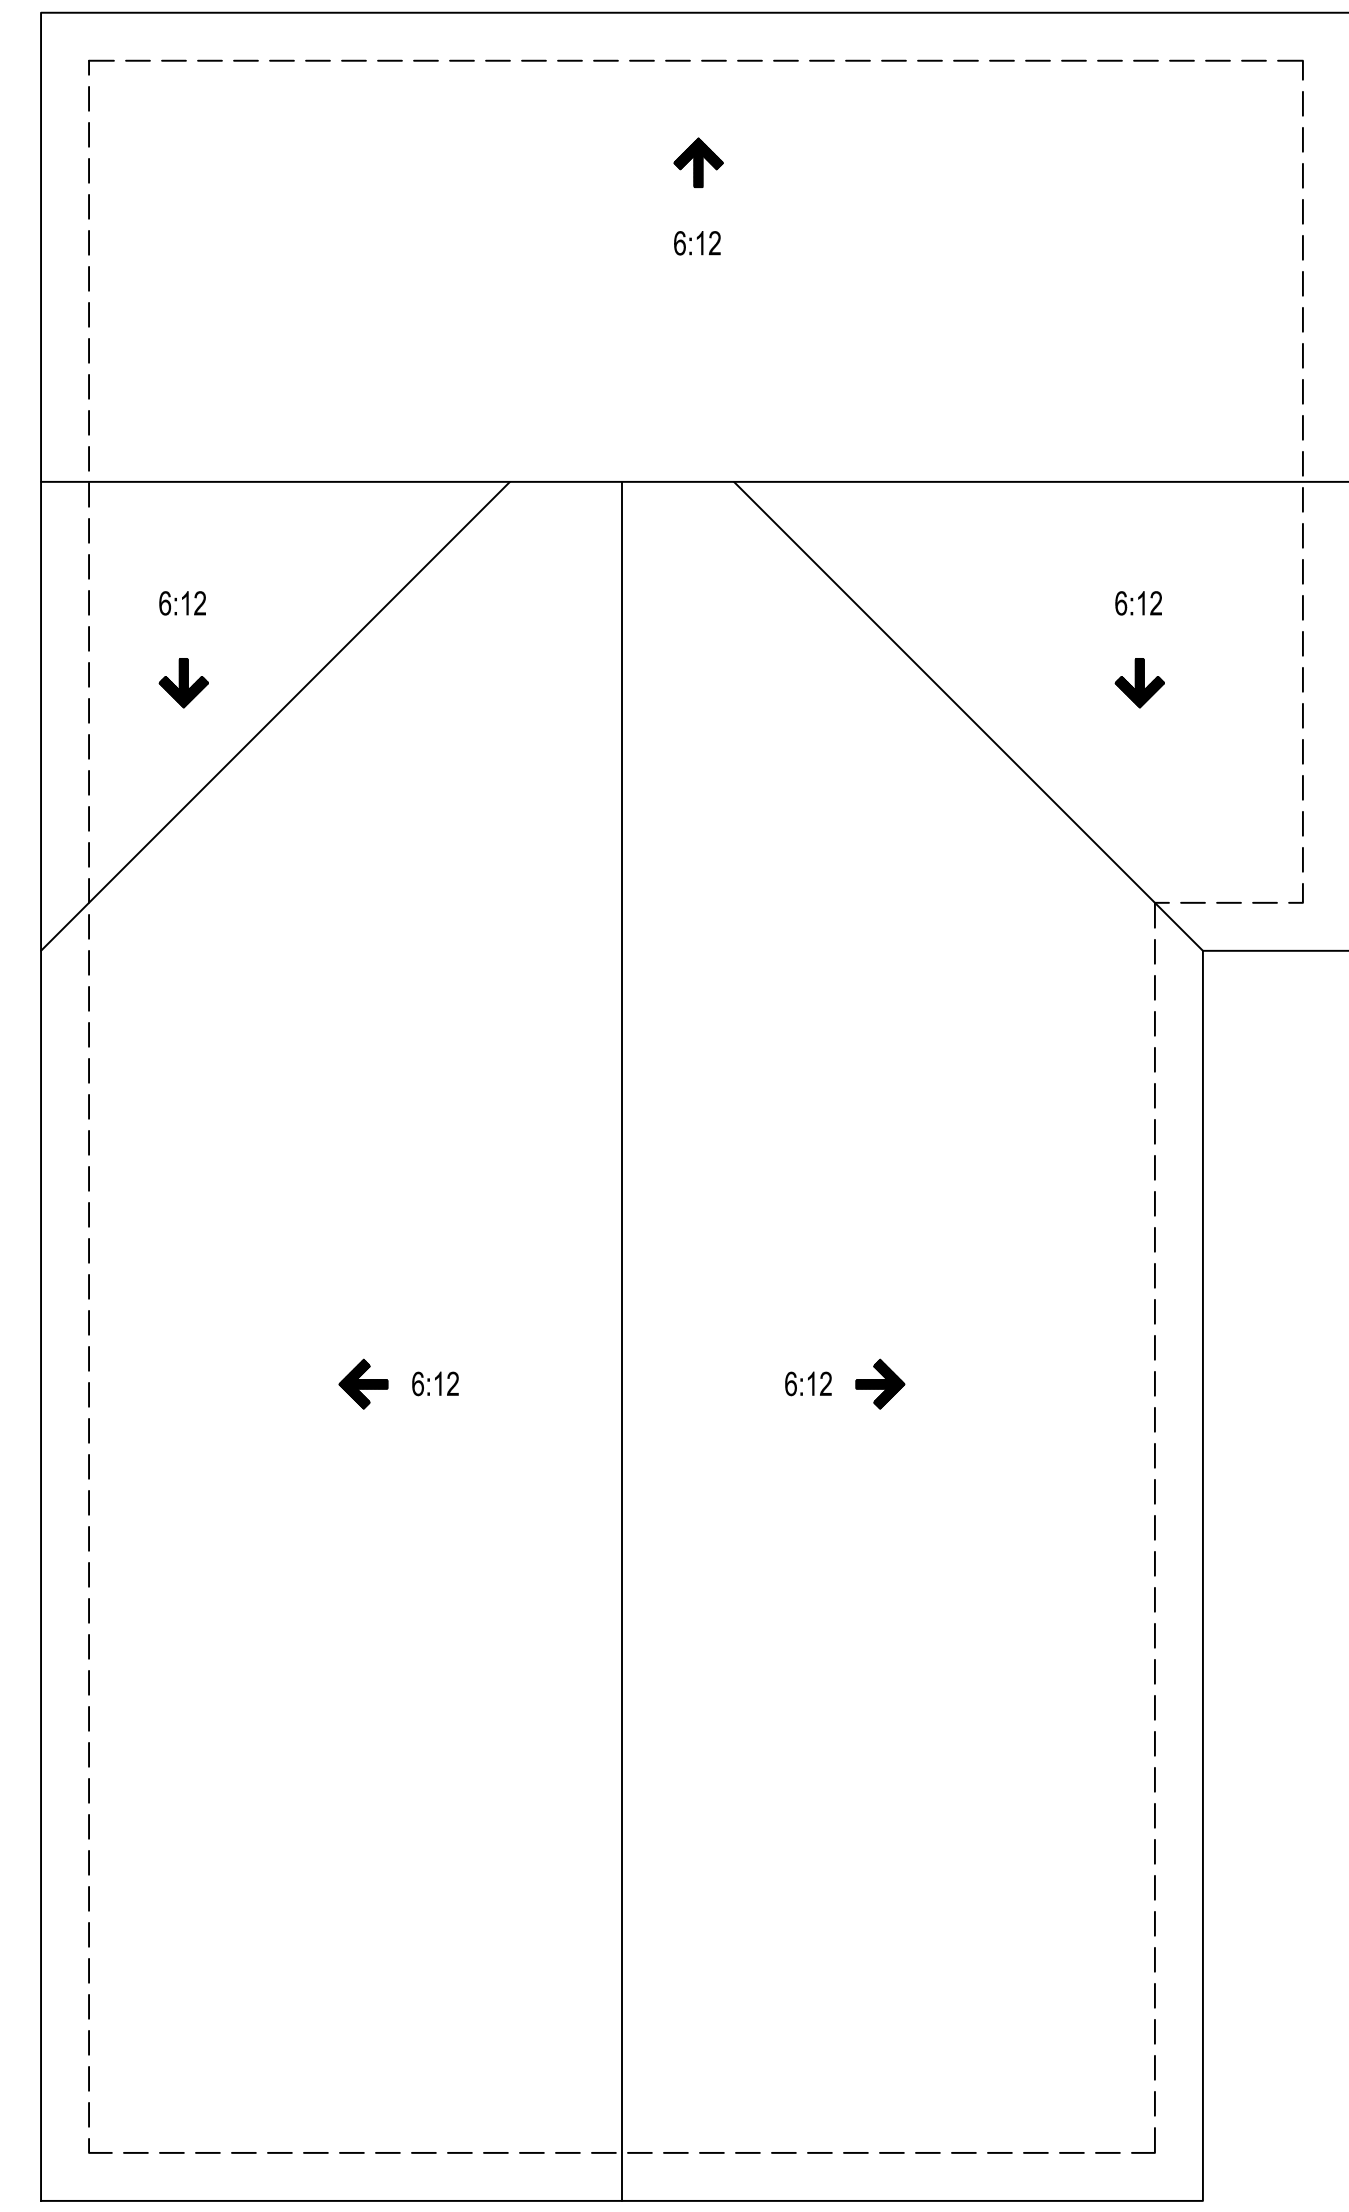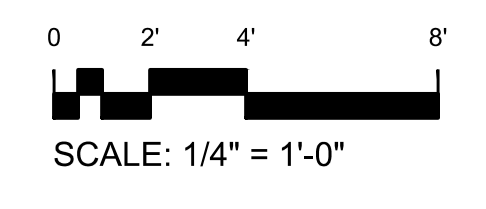


ROOF PLAN

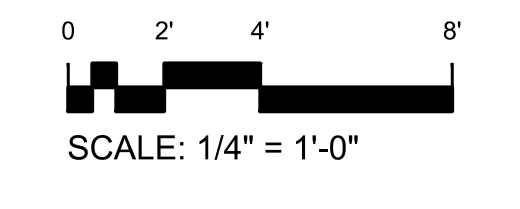



DOOR SCHEDULE				
MARK	DOOR SIZE		Type	NOTES
	WD	HGT		
26	16'-0"	7'-0"	GARAGE DOOR	--
27	3'-0"	6'-8"	FRENCH	--
28	2'-10"	6'-8"	SWING	--
29	3'-0"	6'-8"	FRENCH	--
30	2'-4"	6'-8"	SWING	--
31	4'-0"	6'-8"	SWING DOUBLE	--
32	4'-0"	7'-0"	FRENCH DOUBLE	--

WINDOW SCHEDULE					
MARK	SIZE		TYPE	Head Height	NOTES
	Width	HEIGHT			
28	4'-0"	3'-6"	DOUBLE CASEMENT	6'-8"	--
29	3'-10"	3'-10"	SLIDING	6'-8"	--
30	3'-10"	3'-10"	SLIDING	6'-8"	--
31	1'-11"	3'-11"	SINGLE HUNG	6'-8"	--



REVISIONS	BY
AS-BUILT LOS ANGELES	
Sheet content: GUEST HOUSE/GARAGE PLANS	
Project: 908 26TH ST SANTA MONICA CA 90403	
Owner:	
Date:	
Scale:	
Drawn:	
Job:	
Sheet:	A-6

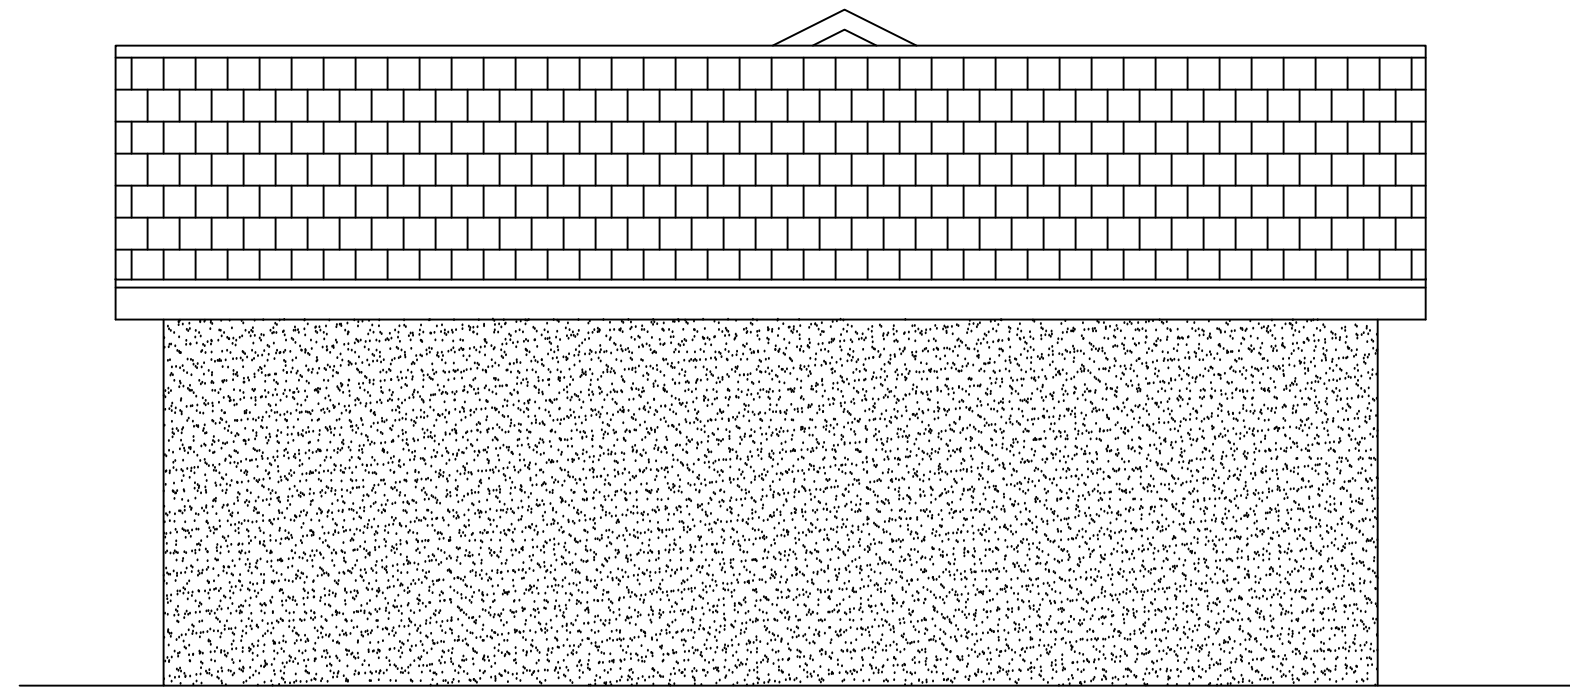



1 N. W. ELEVATION

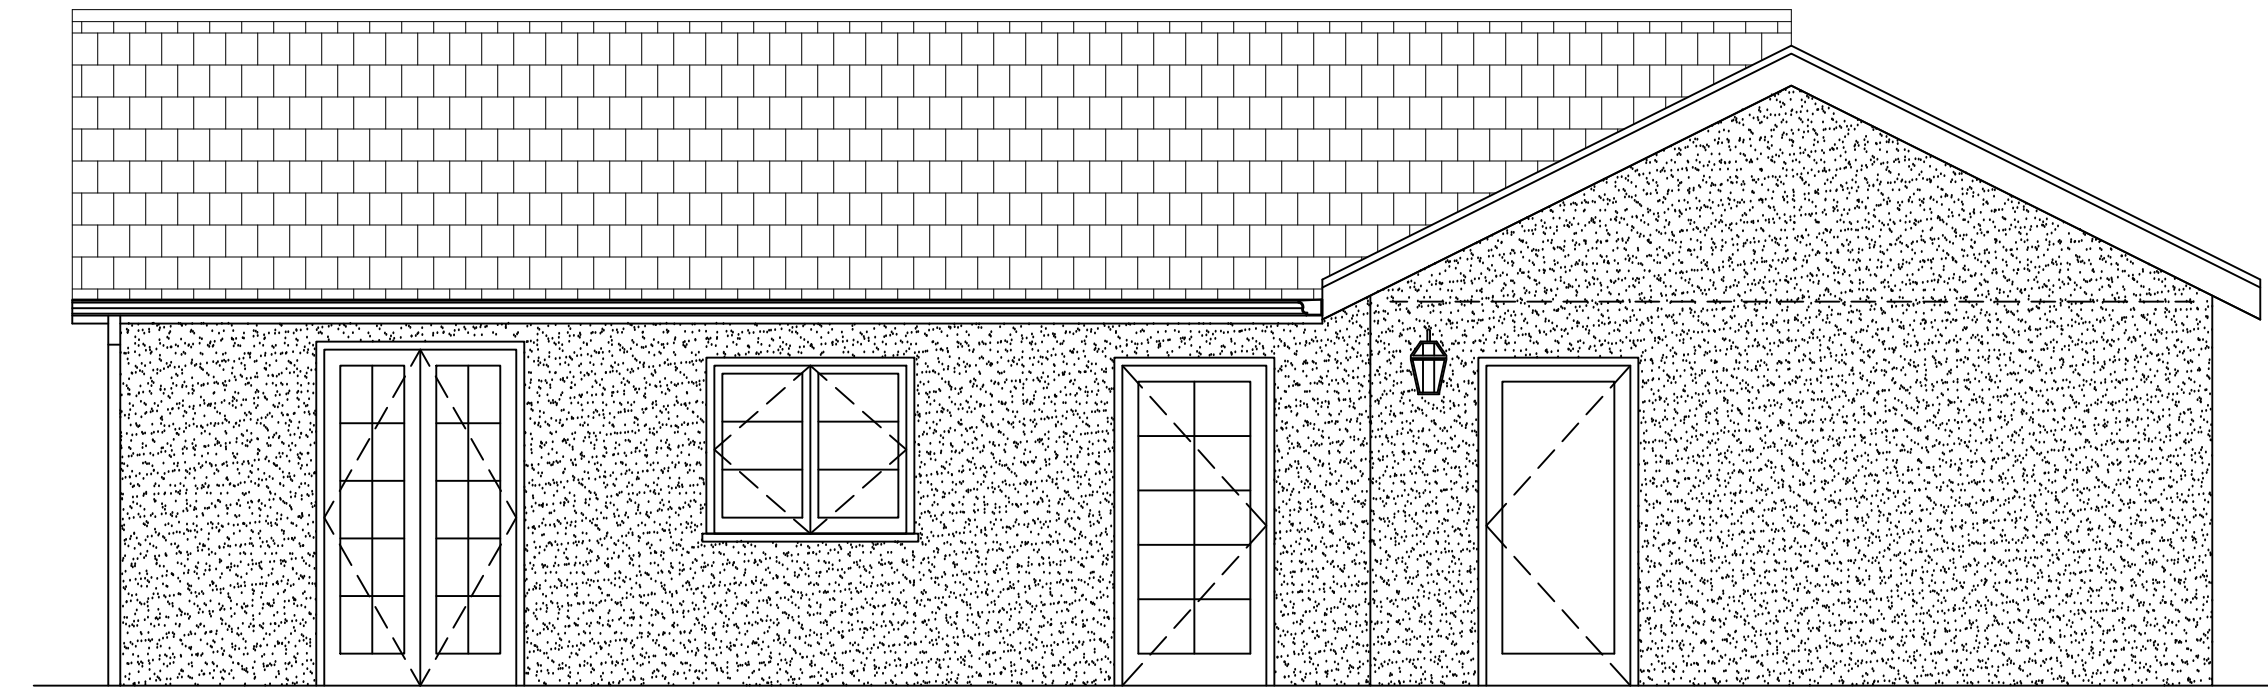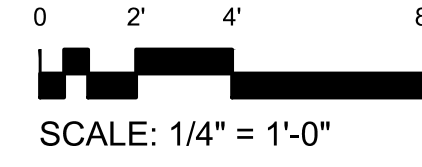



2 N. E. ELEVATION

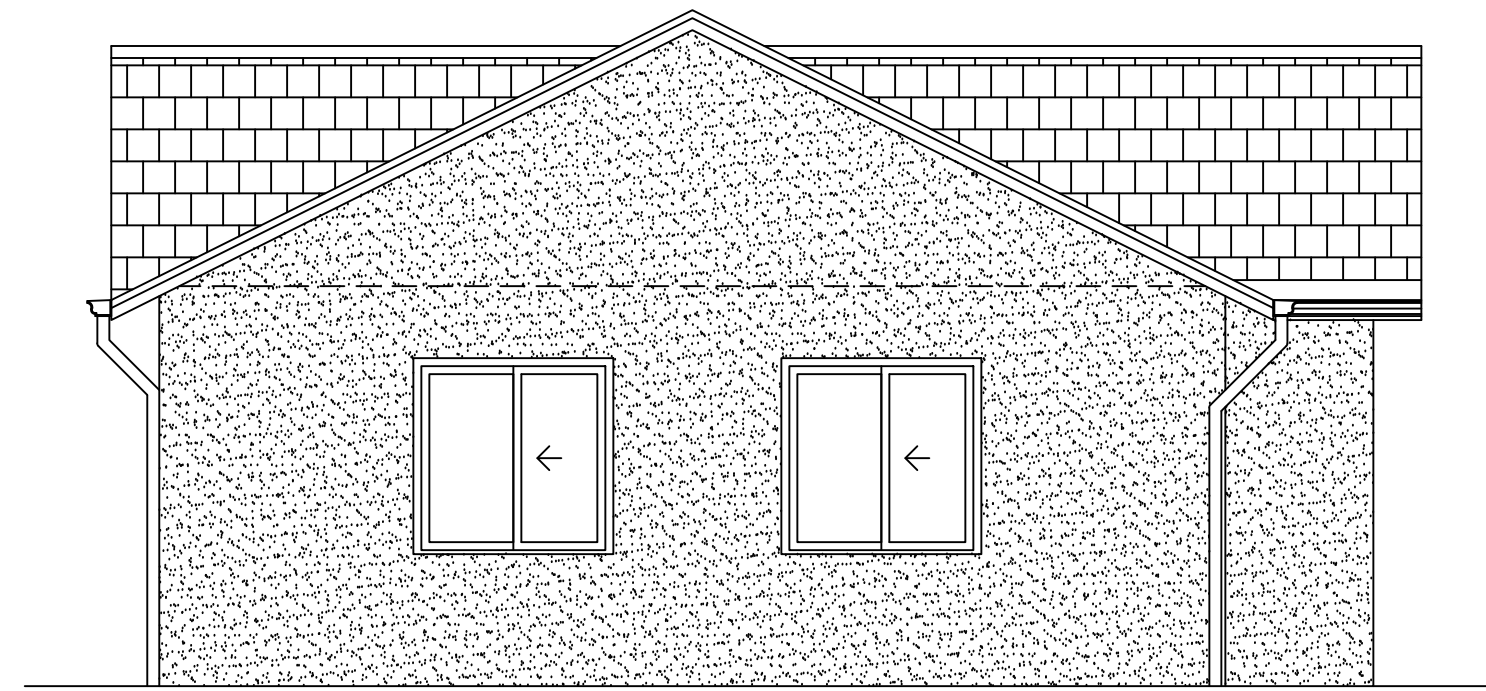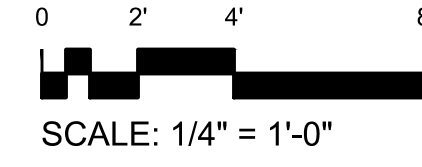


3 S. E. ELEVATION

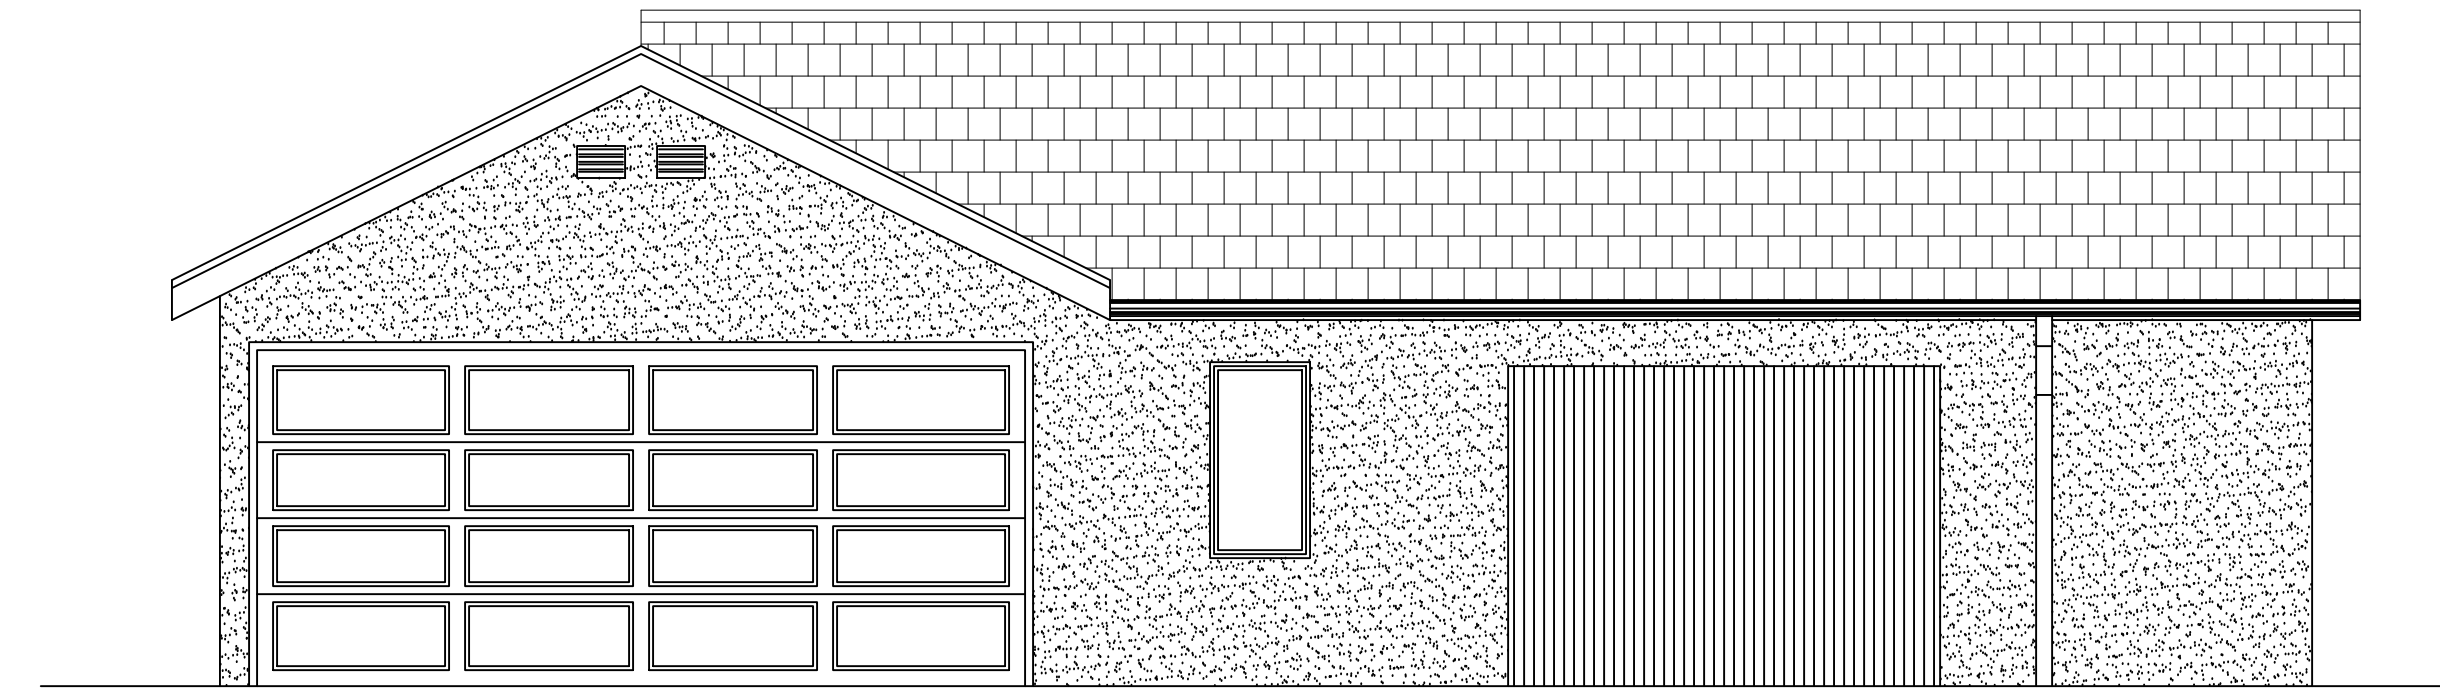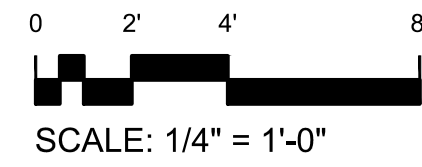

4 S. W. ELEVATION

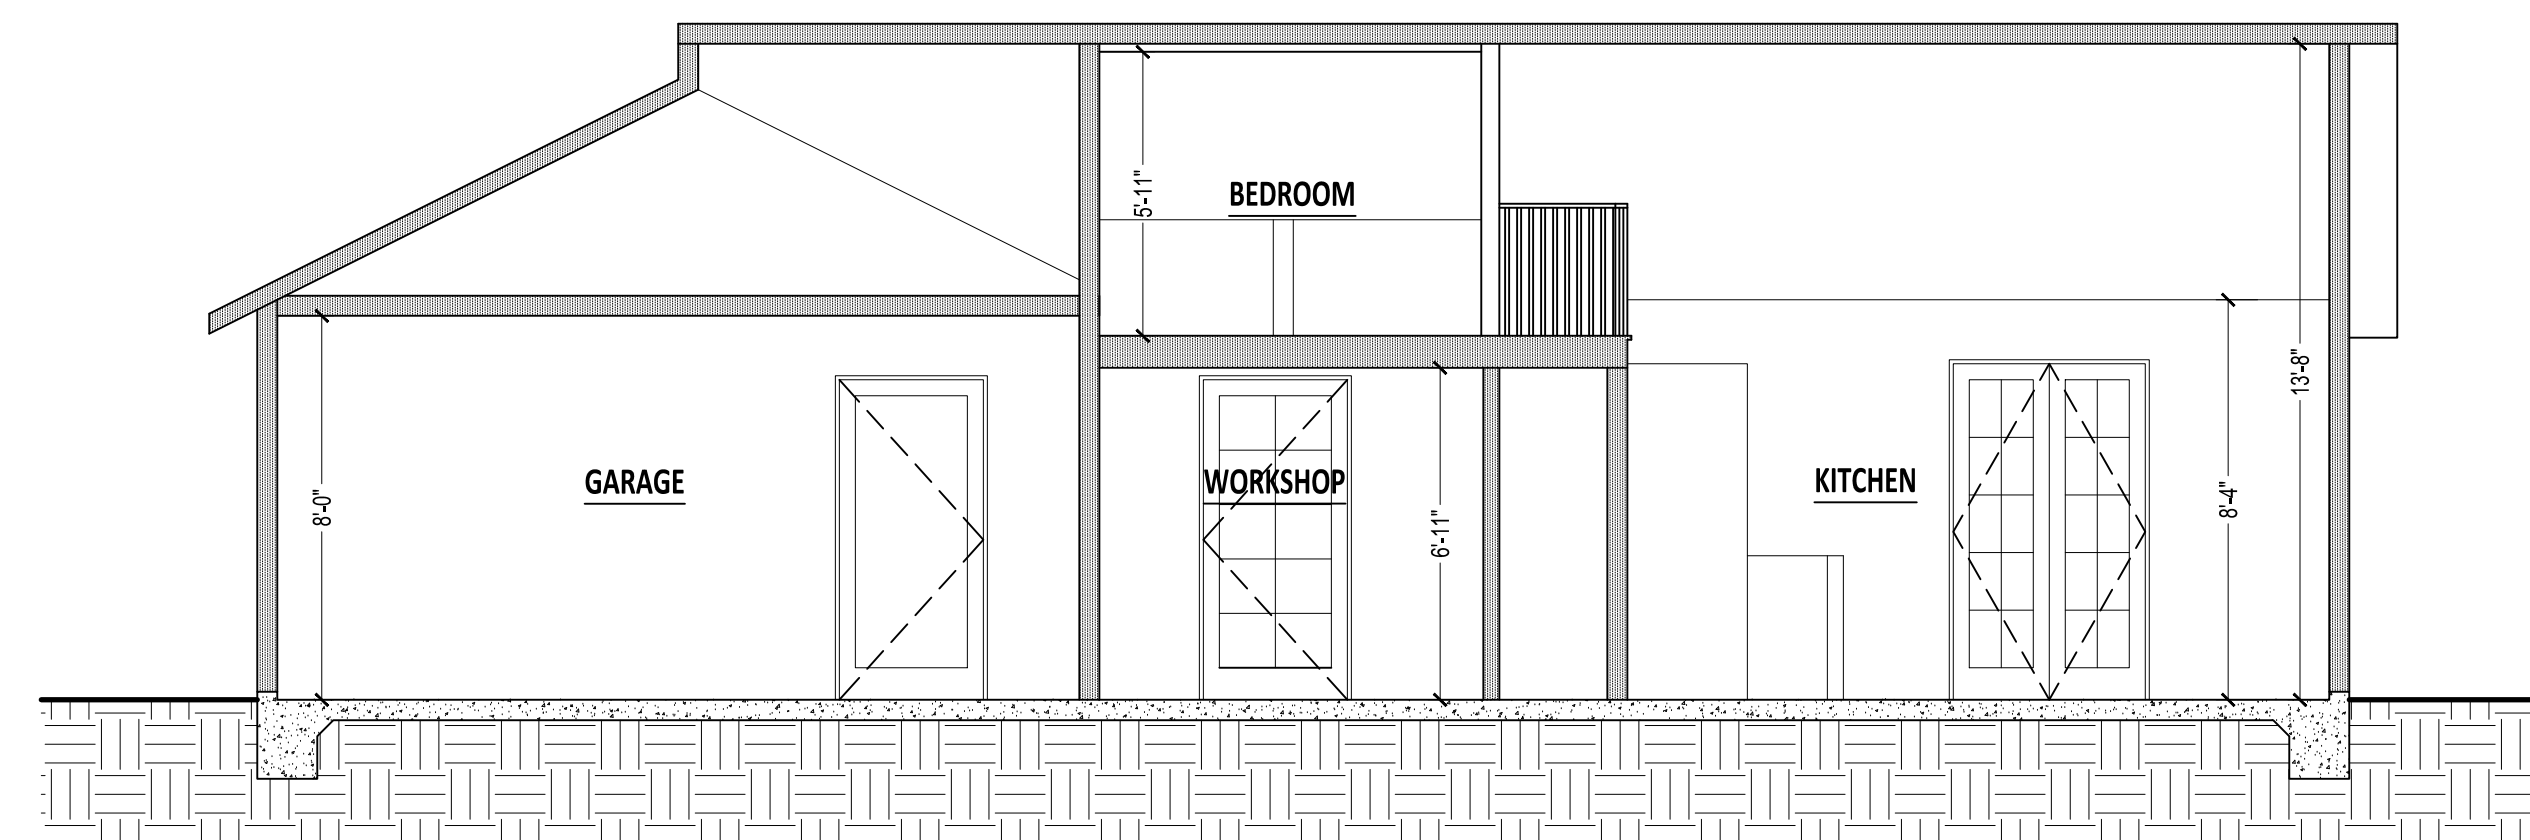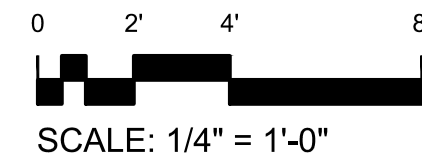

SECTION B-B

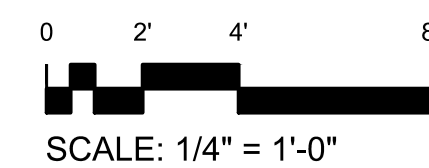

REVISIONS BY

AS-BUILT
LOS ANGELES

Sheet content :
GUEST HOUSE/GARAGE
ELEVATIONS AND SECTION

Project :
908 26TH ST
SANTA MONICA CA 90403

Owner:

Date

Scale





Drawn

Job

Sheet

A-7

08.28.13

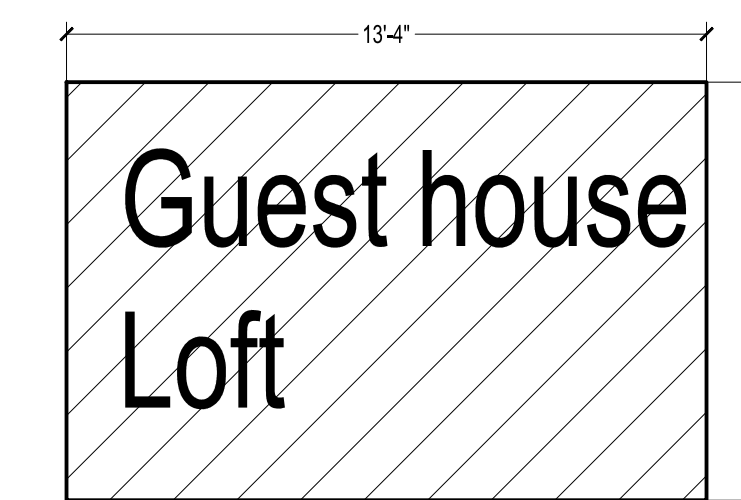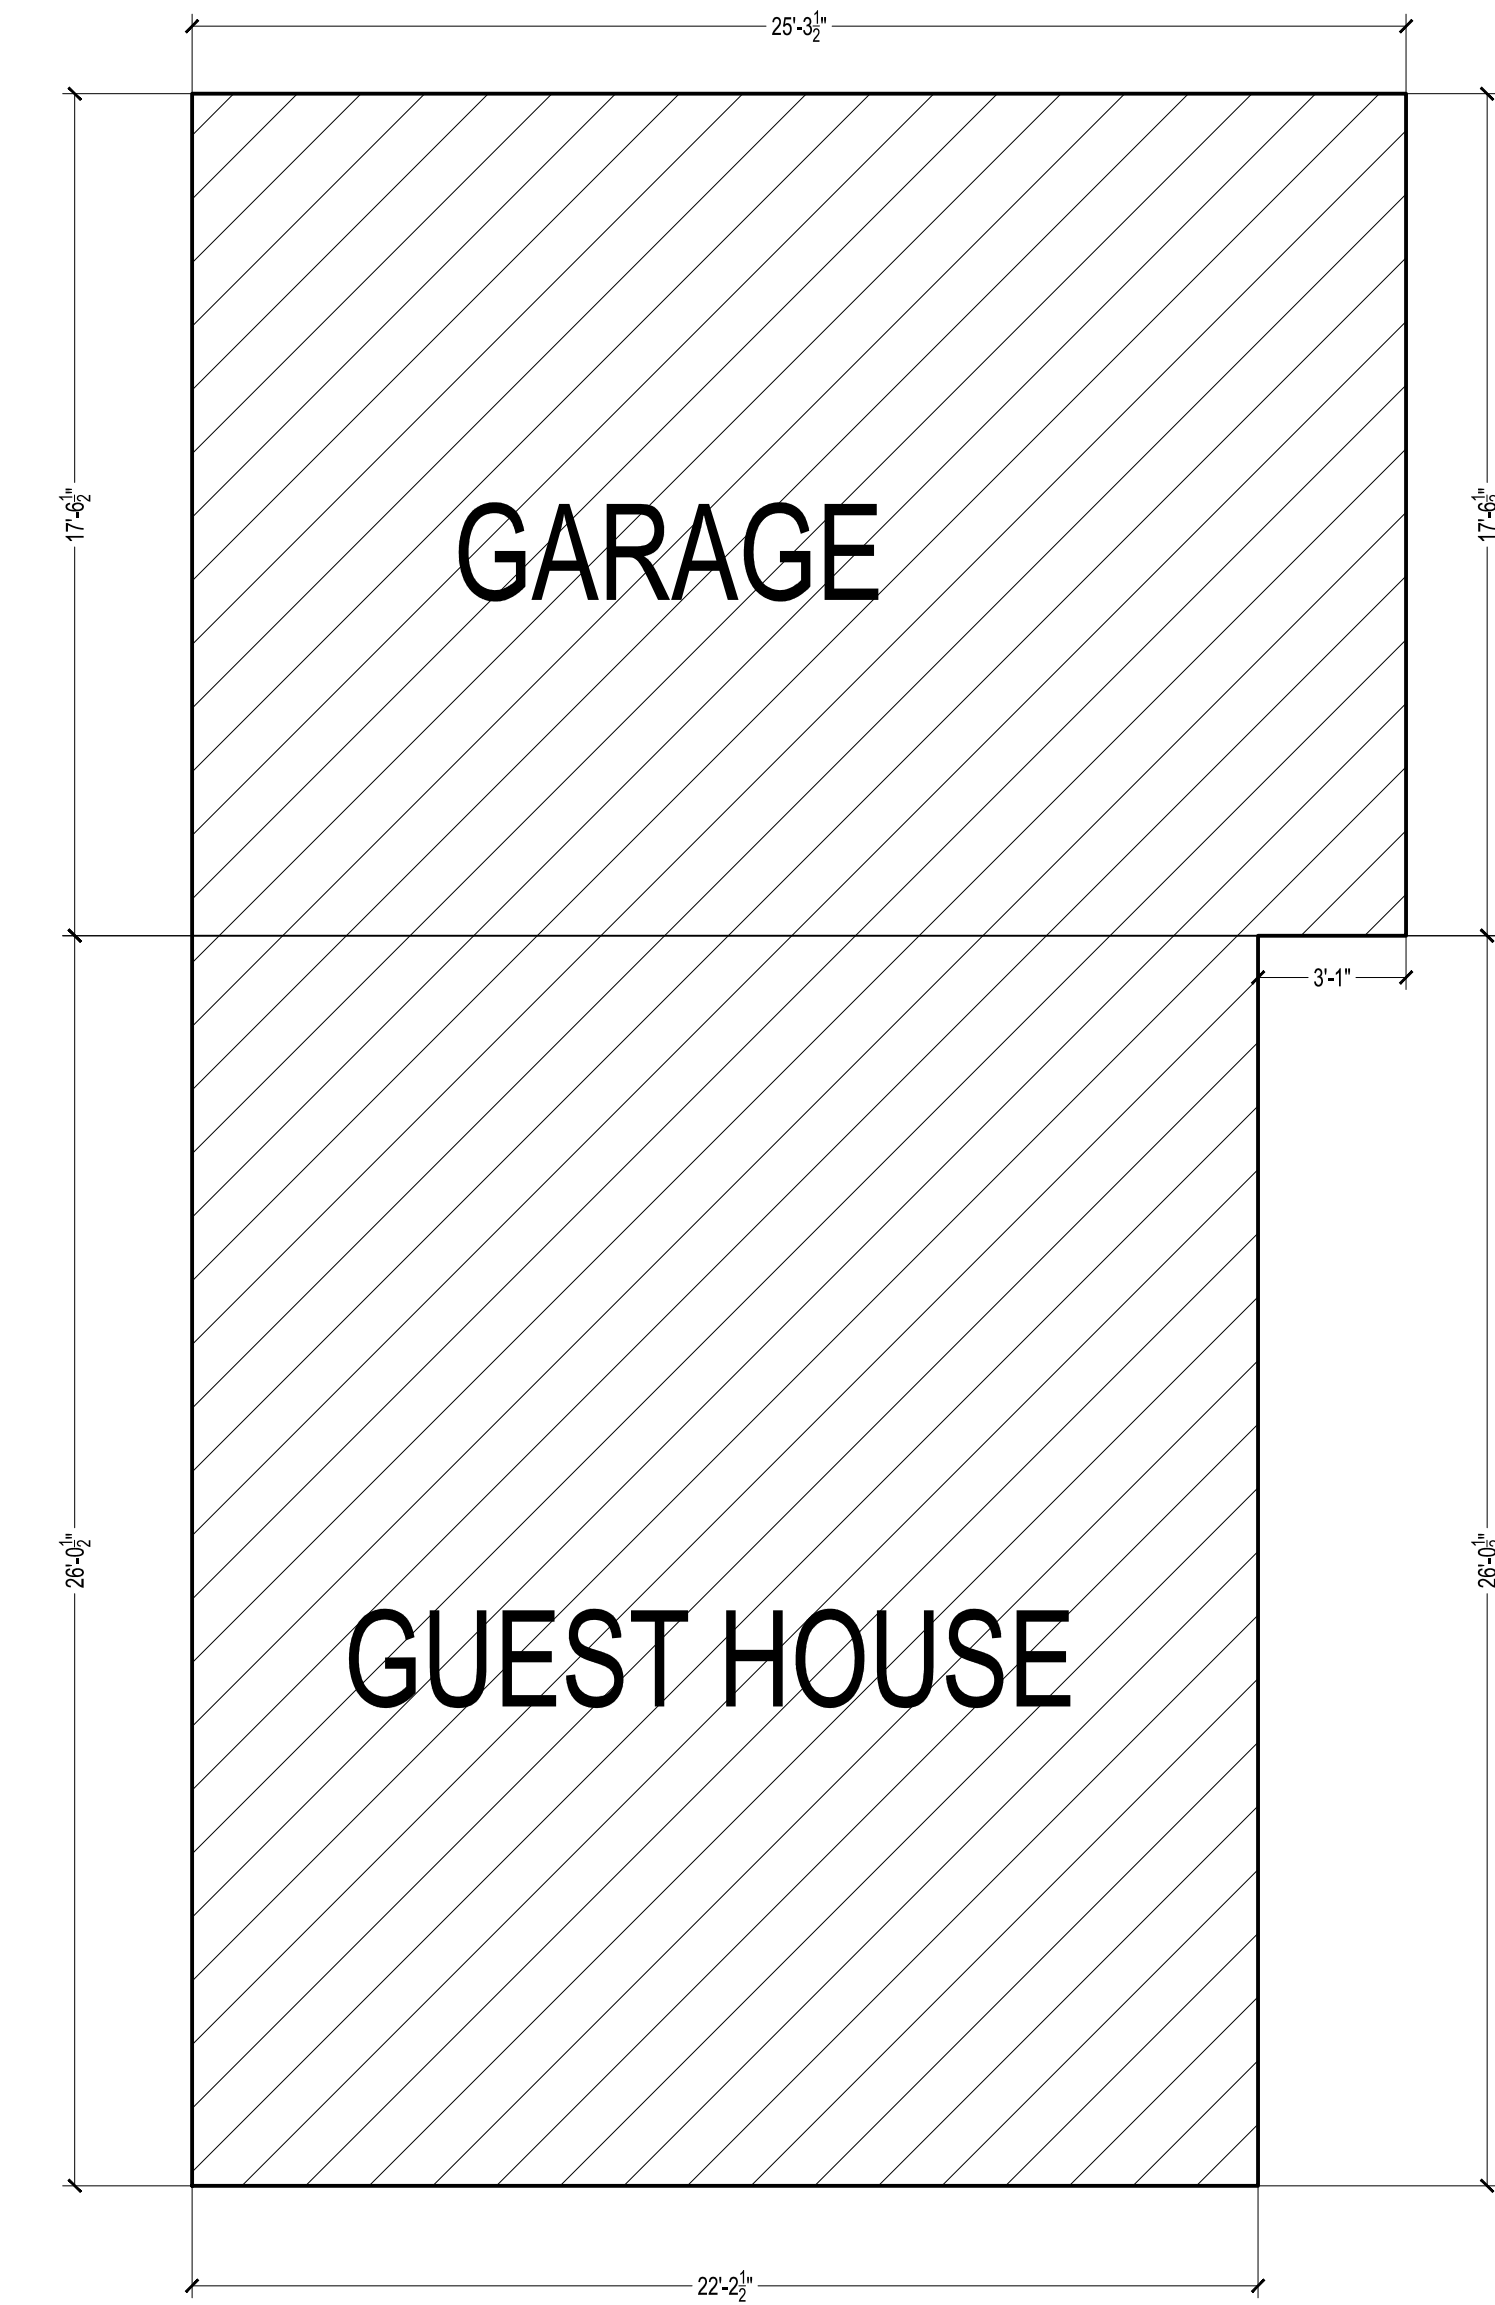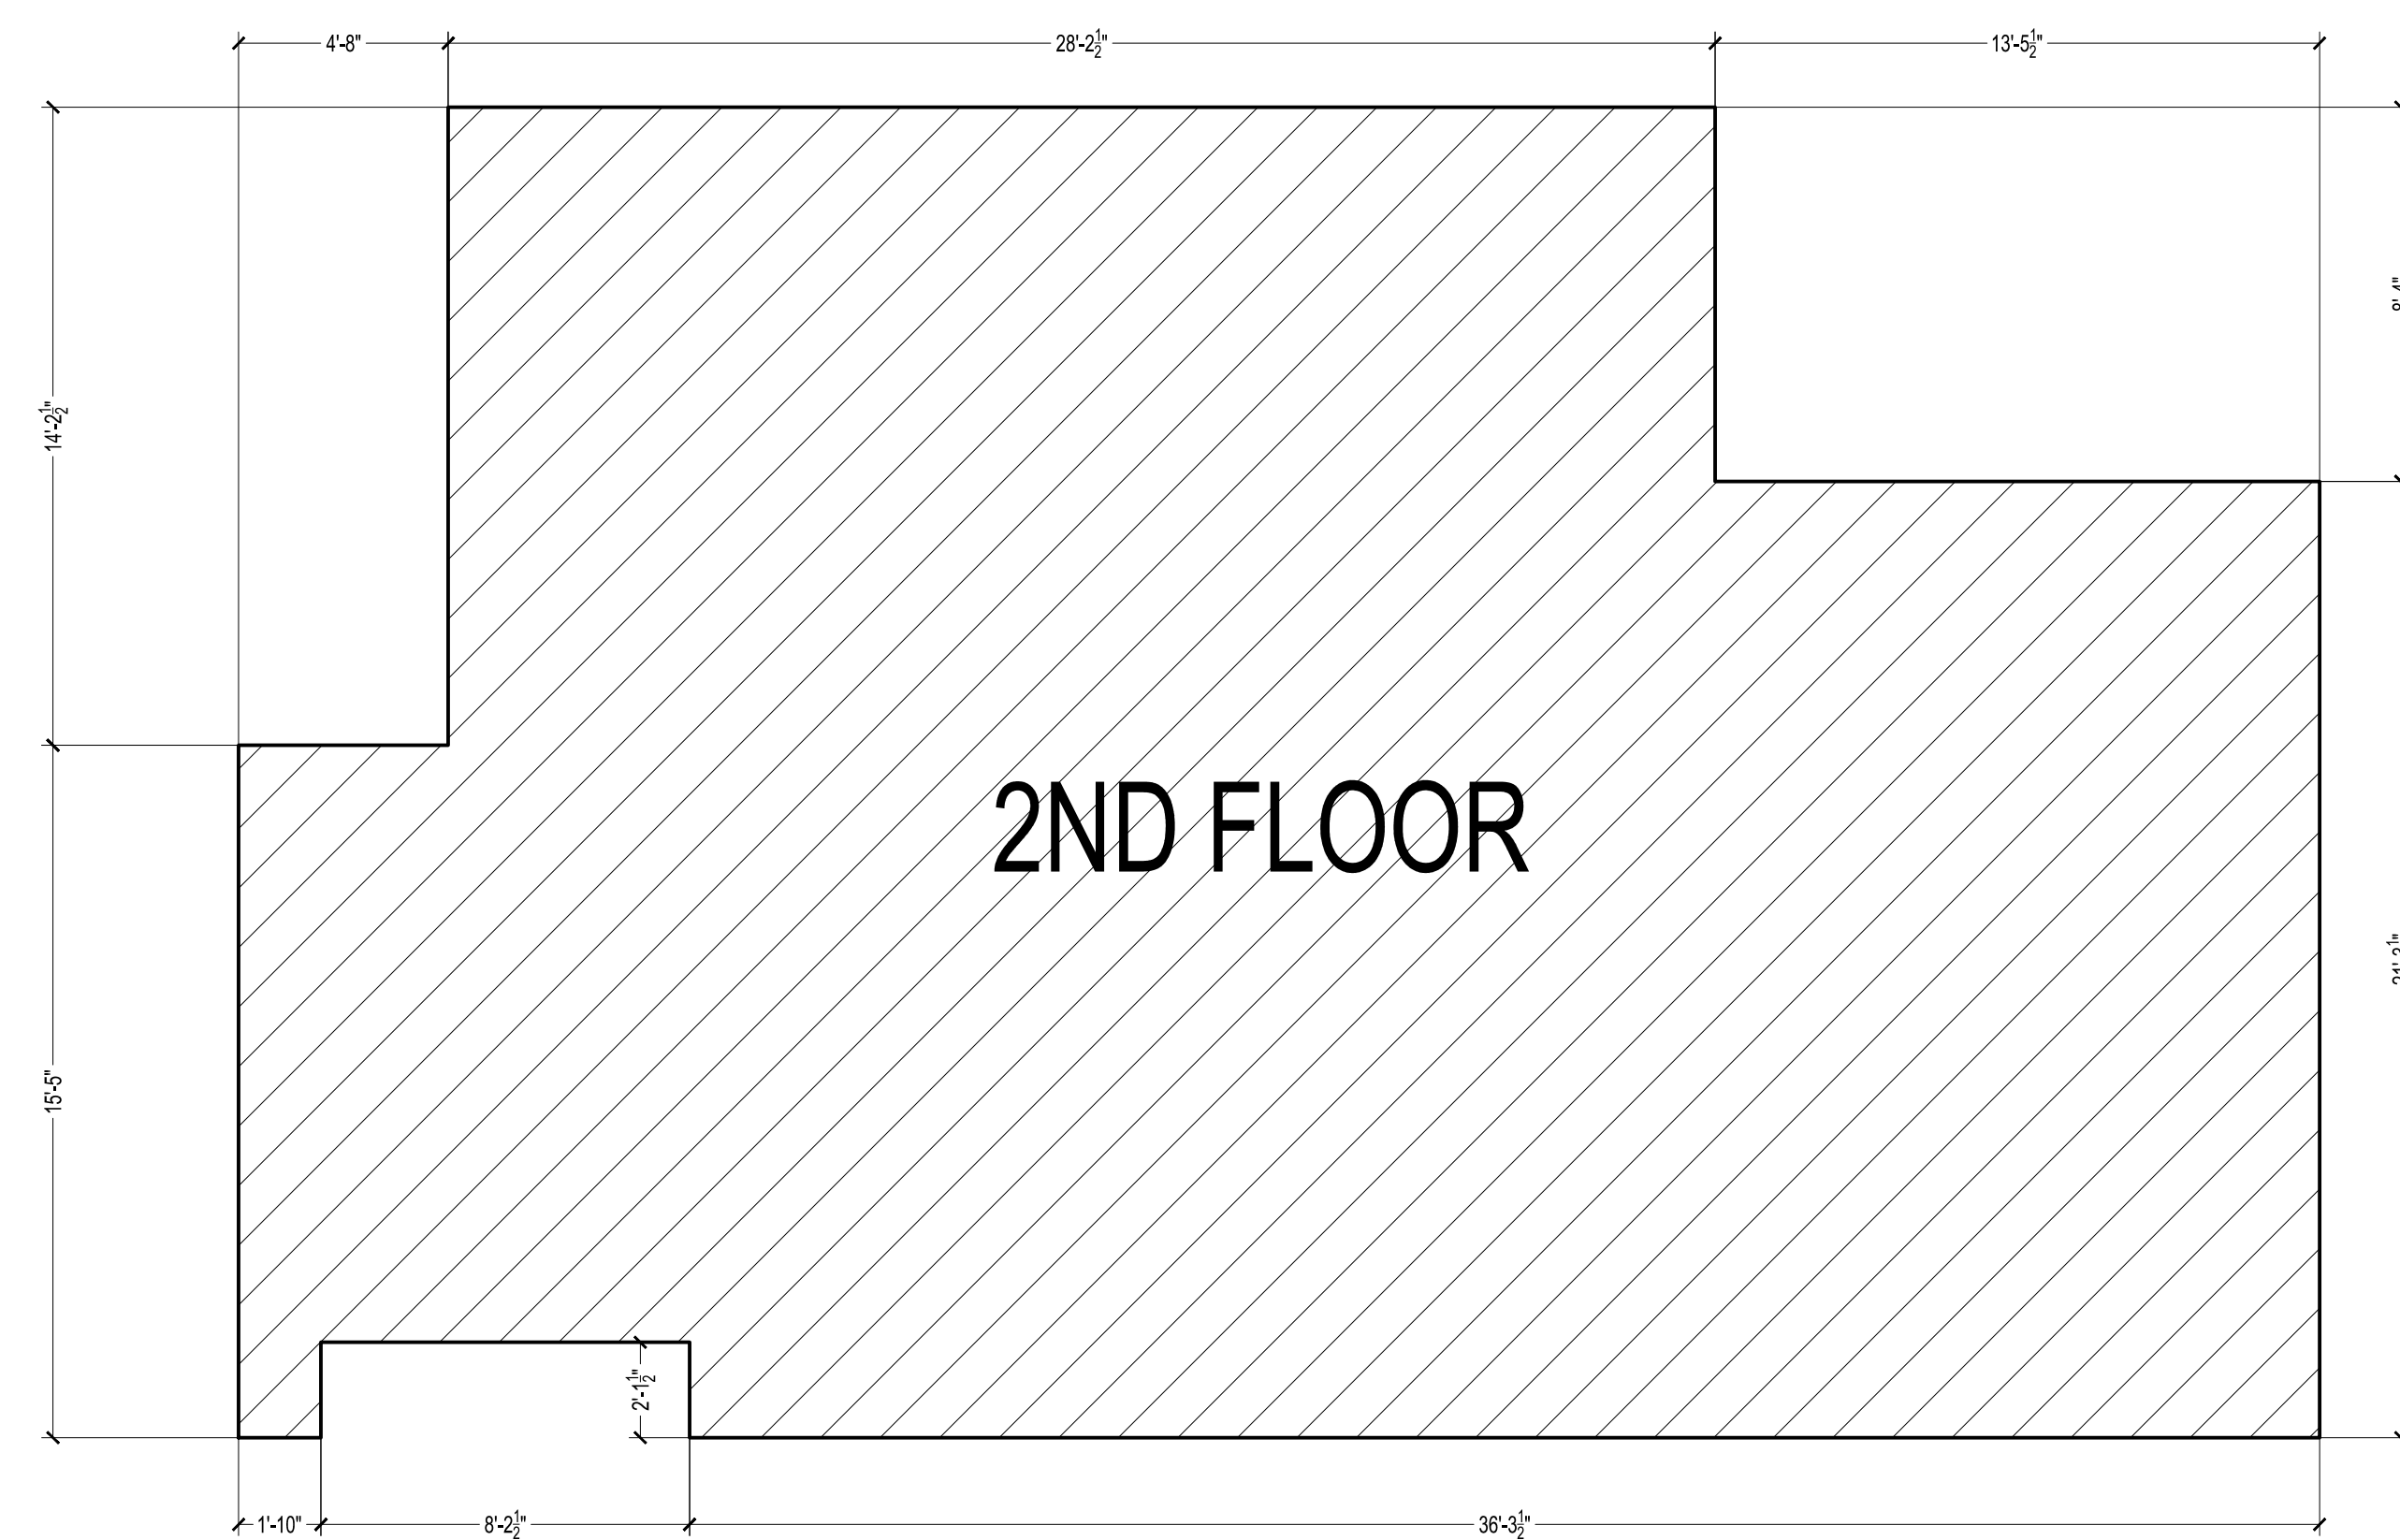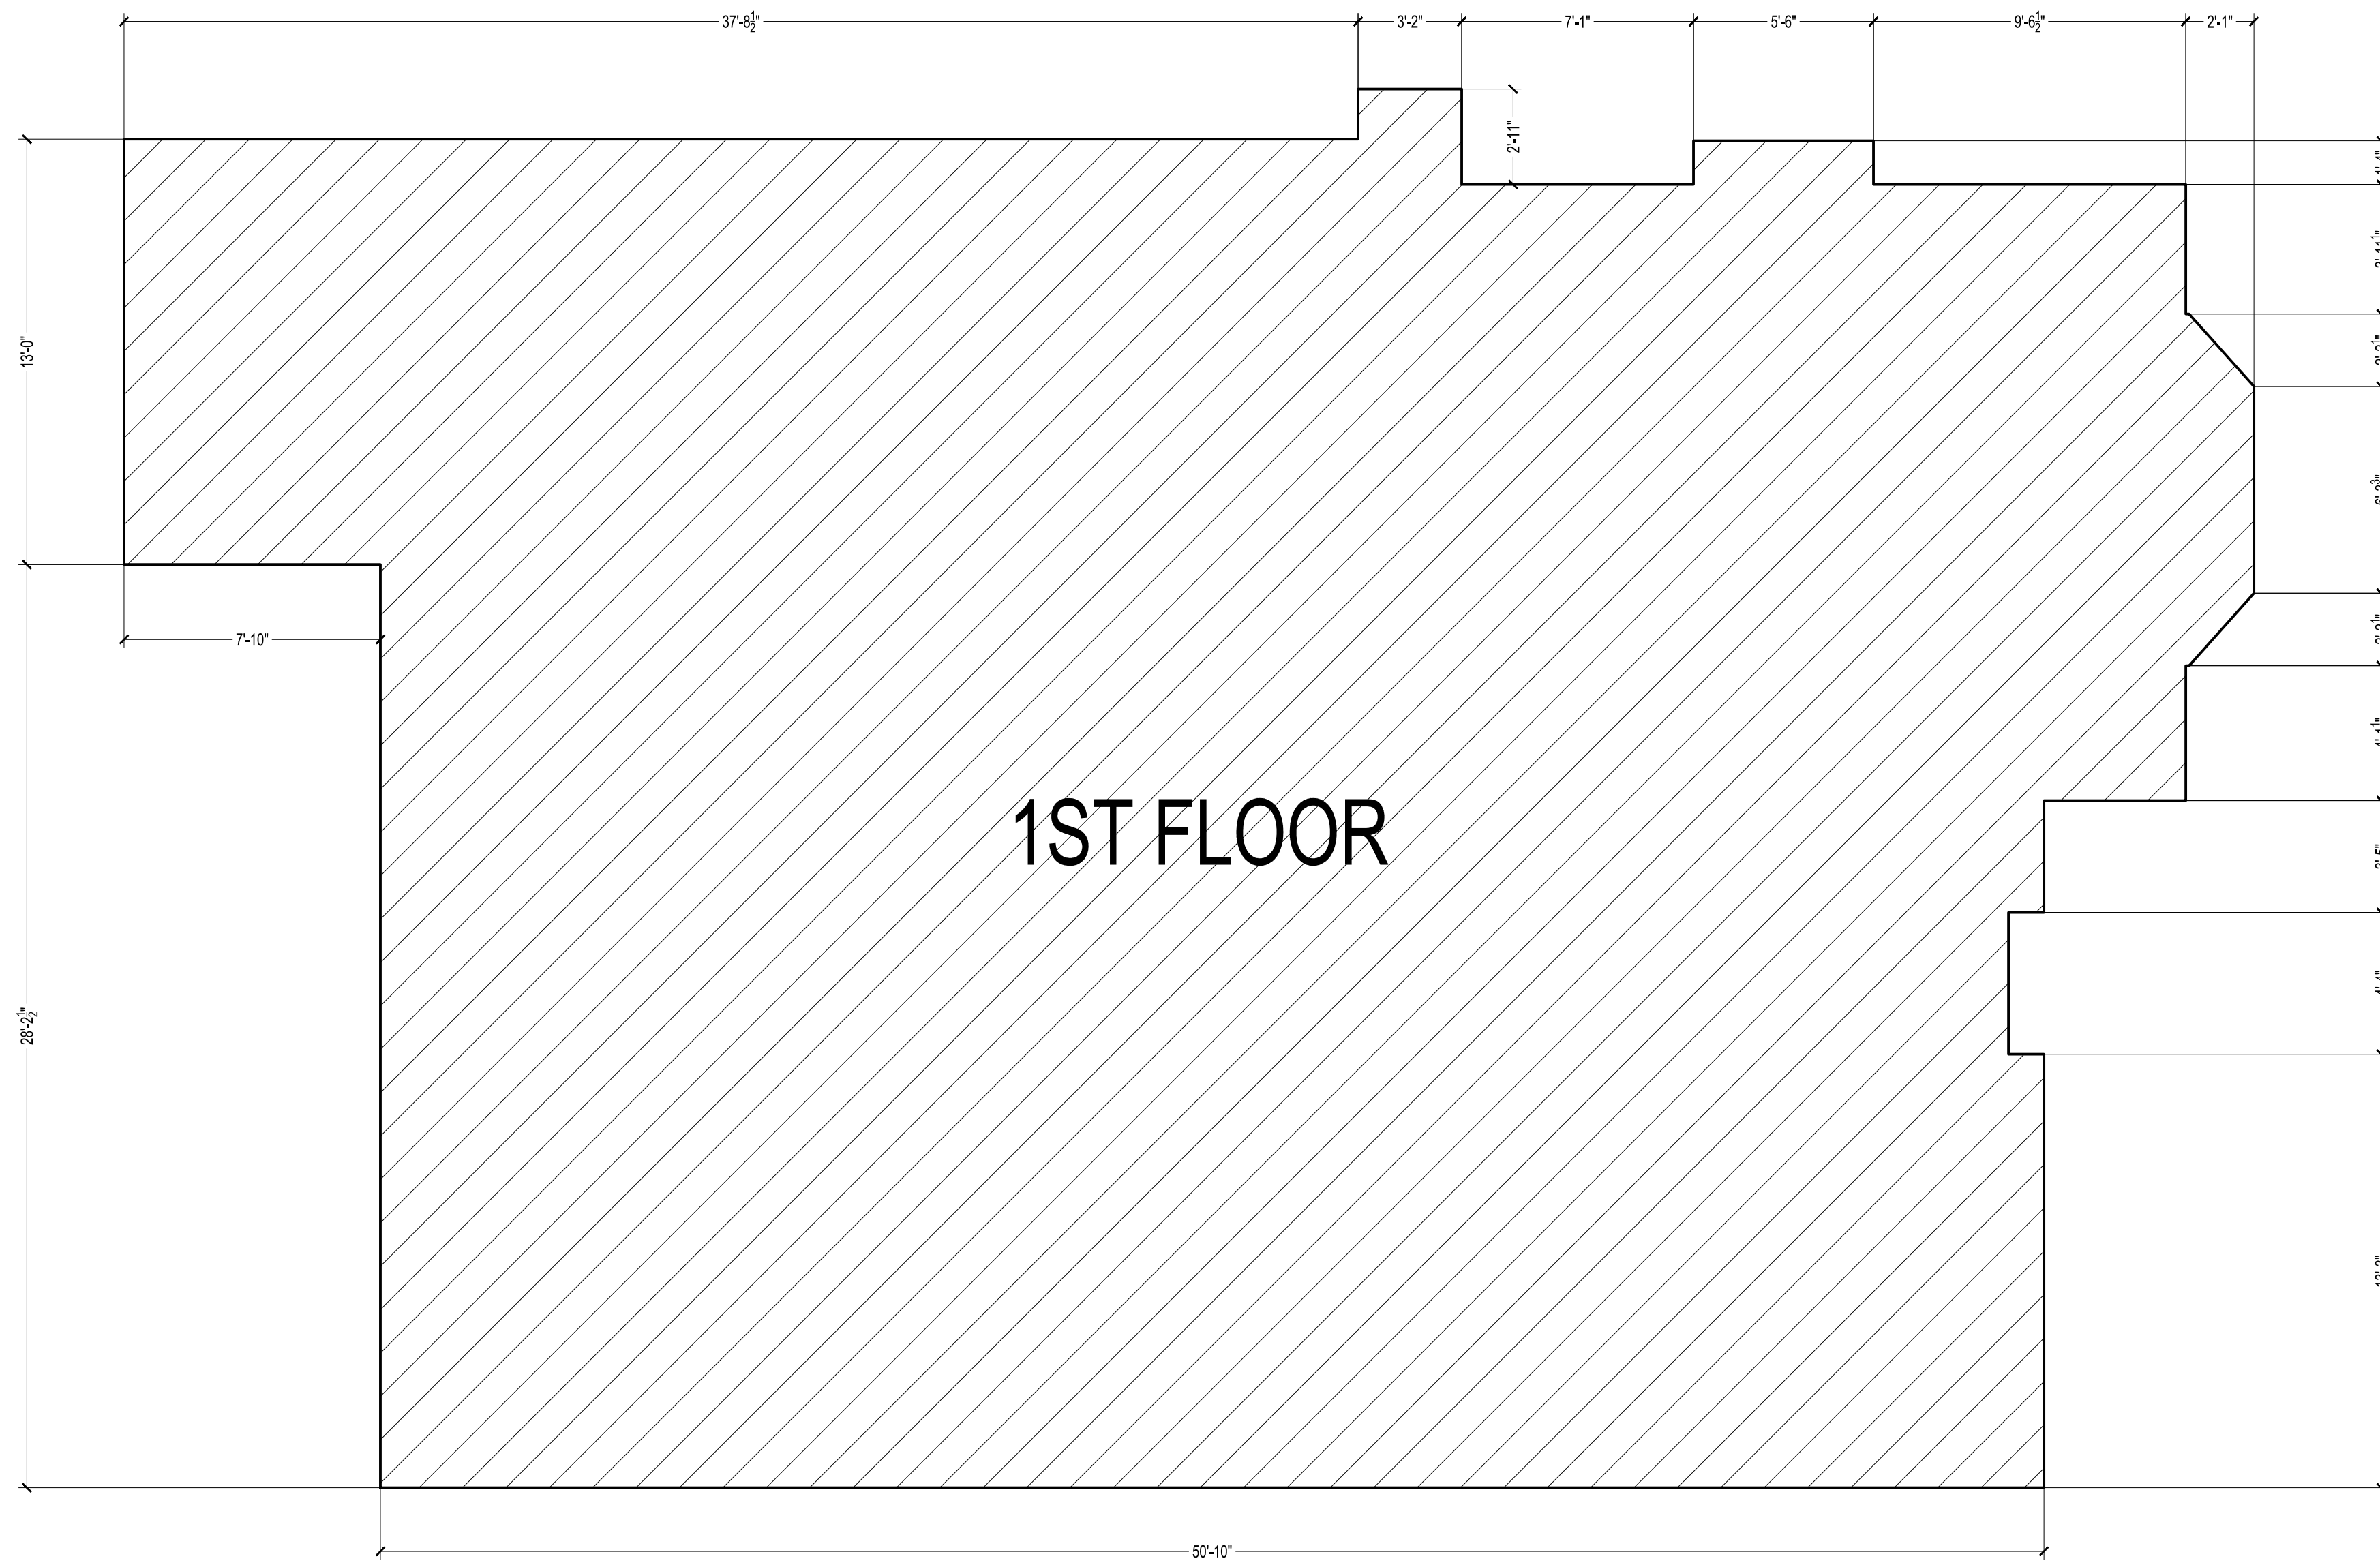

SQUARE FOOTAGE
 FIRST FLOOR: 2279 SF
 SECOND FLOOR: 1177 SF
 GARAGE: 444 SF
 GUEST HOUSE: 694 SF
 TOTAL: 4,594 SF

REVISIONS	BY
AS-BUILT LOS ANGELES	
Sheet content : SQUARE FOOTAGE CALCULATION	
Project : 908 26TH ST SANTA MONICA CA 90403	
Owner:	
Date	
Scale	
Drawn	
Job	
Sheet	
A-8	